


U. S. PUBLIC LAND SURVEY MONUMENT RECORD

I N S T R U C T I O N S : This record shall show the location of the corner and shall include all of the following nine elements (a through i).

- (a) Identify the corner by reference to the U.S. public land survey system.
- = Corner monument restored.

Quarter corner to Sections 26 and 27, T.34N., R.16E.

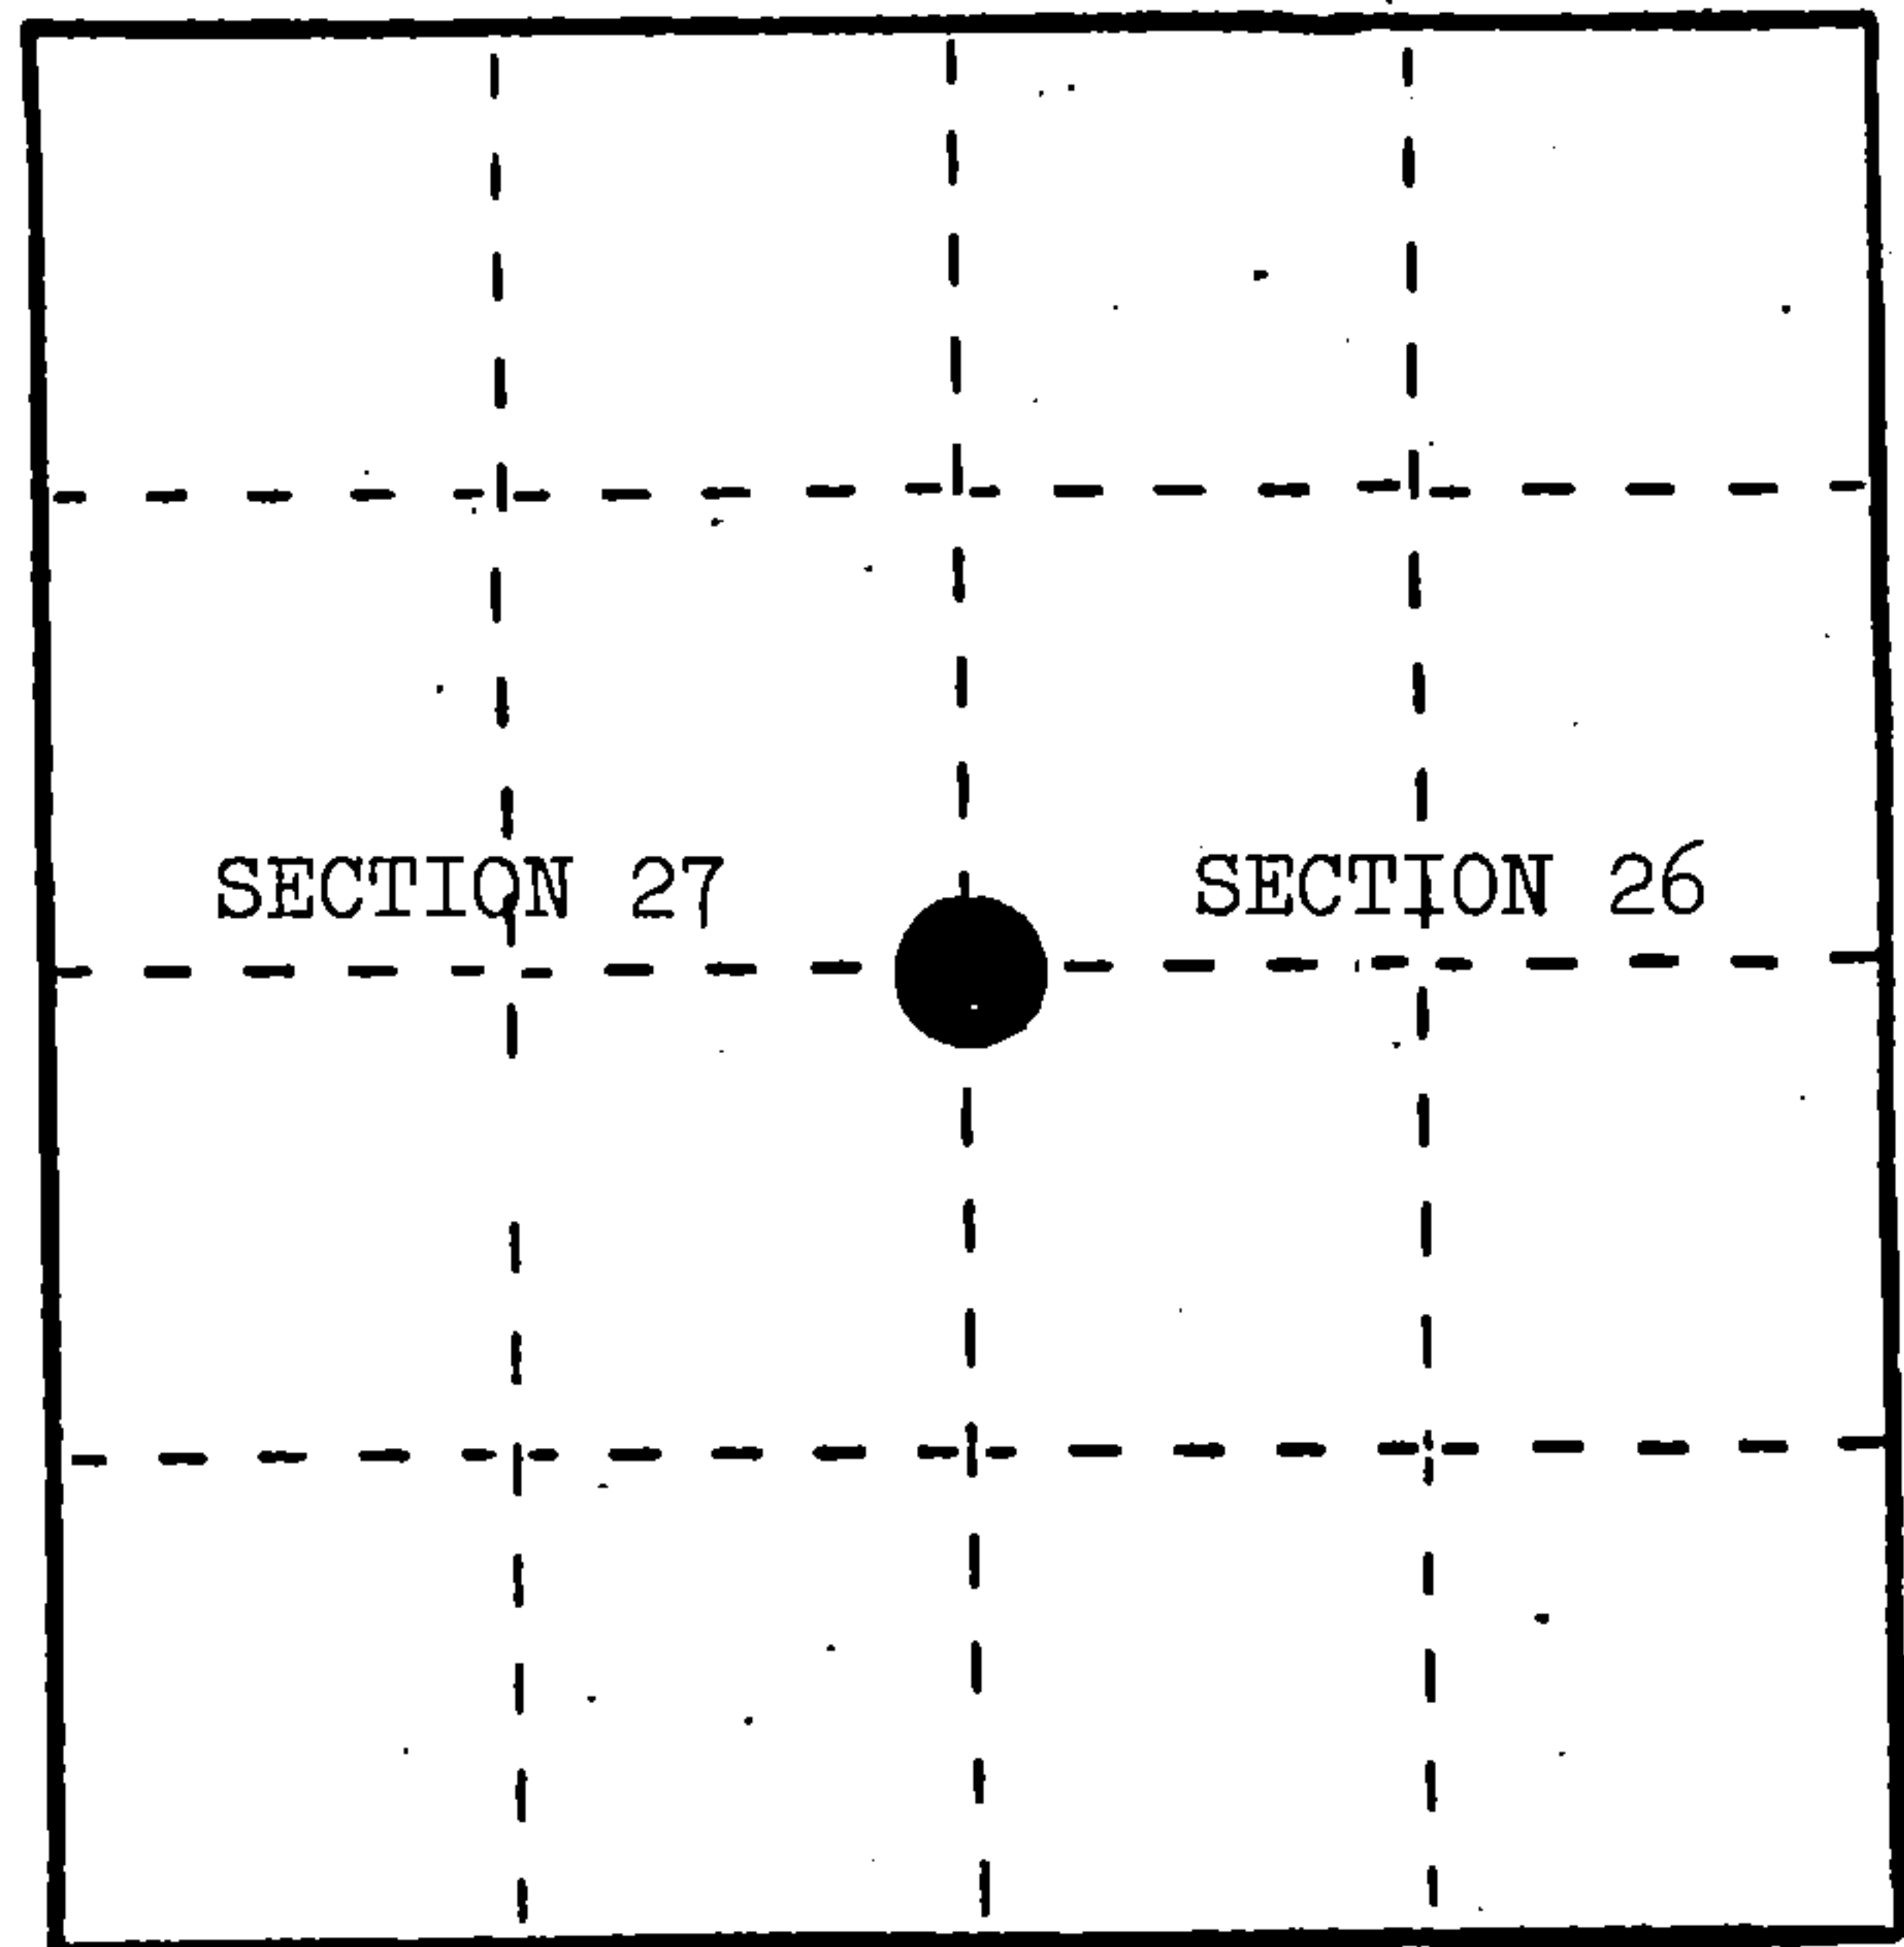

- (b) Describe any record evidence, monument evidence, occupational evidence, testimonial evidence or any other material evidence you considered, and whether the monument was found or placed.


In 1858, James McBride set post with the following BTs: Beech, 12", S.56°W., 35 links; Beech, 8", N.30°E., 18 links.

June 12, 1984, Alan Harrison set proportionate position and conducted search for corner-- found no evidence of corner position.

- (c) In the plan view drawing below, provide reference ties to at least 4 witness monuments, or, if the location is within a municipality, to at least 2 witness monuments. (Witness monuments shall be made of concrete, natural stone, iron or other equally durable material.) Describe witness monuments.

- (d) Show a plan view drawing depicting the relevant monuments and reference ties which is sufficient in detail to enable accurate relocation of the corner monument if the corner monument is disturbed. Indicate north.

1. 2" x 30" aluminum monument stamped to identify the corner.
2. Basswood, 9", S.79°E., 38.28'
3. Sugar, 6", S.17°W., 29.32'
4. Sugar, 10", N.78°W., 21.54'
5. Steel Sign Post, North, 1.25'

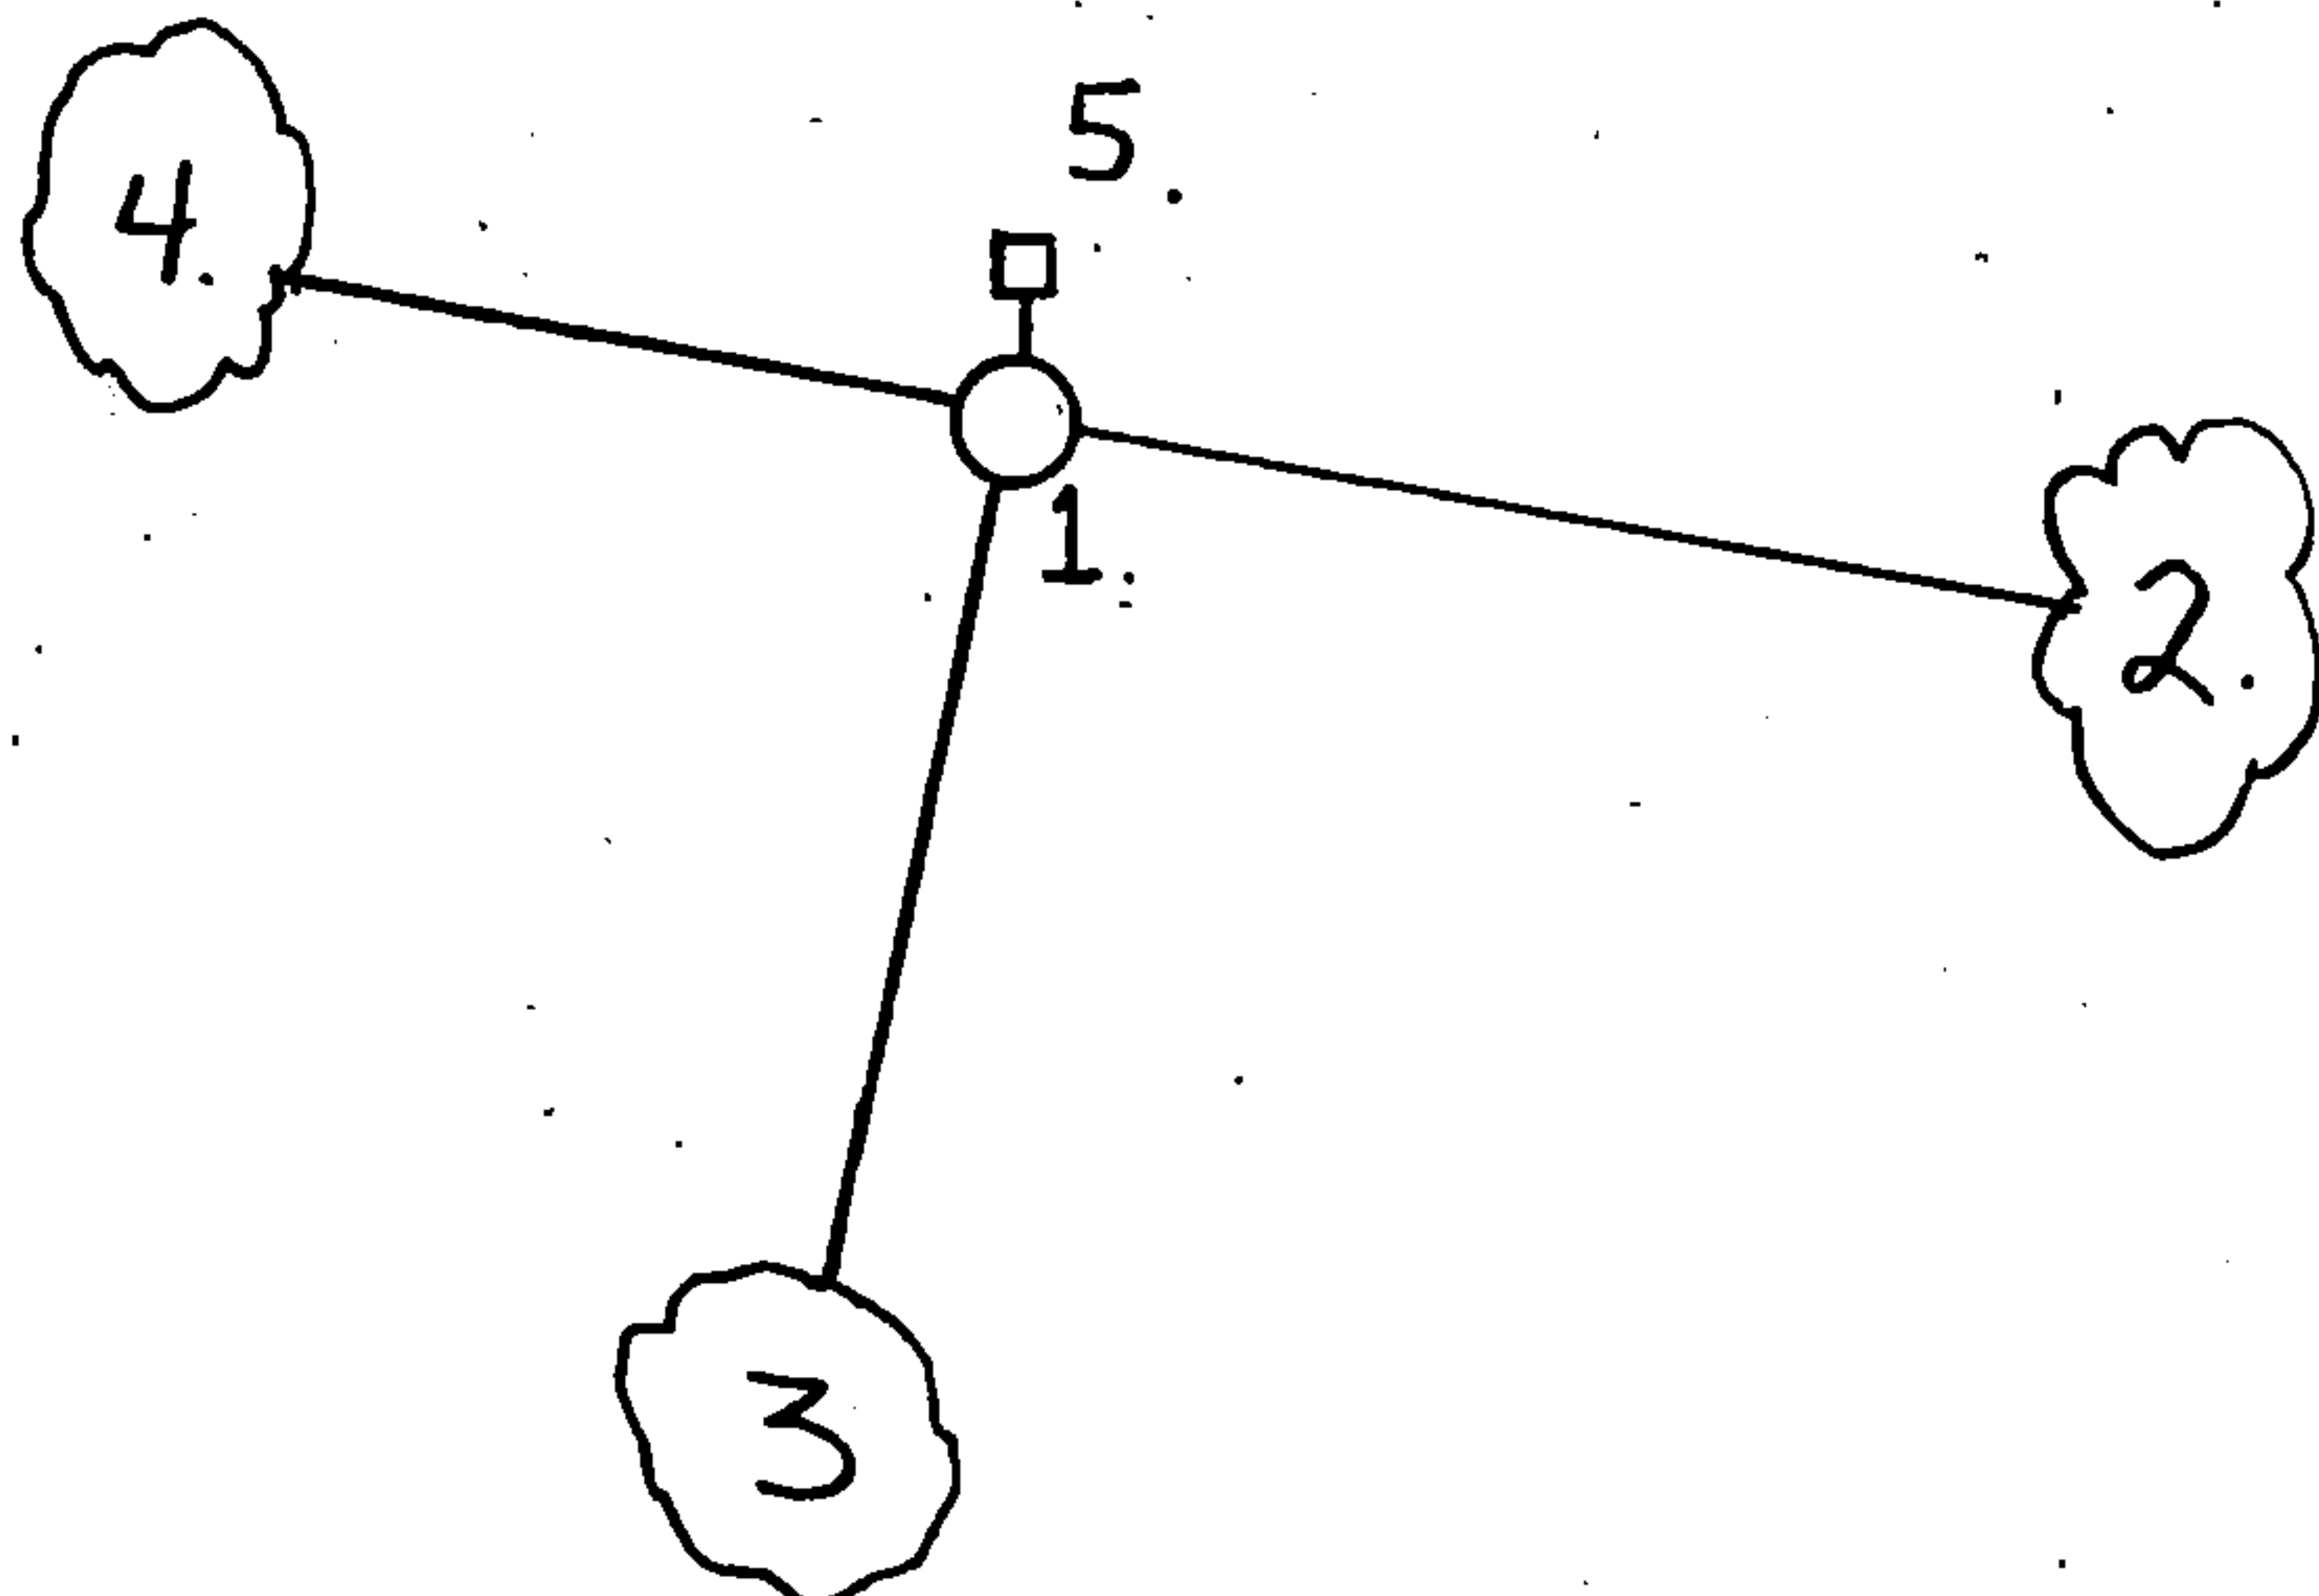

REGISTER'S OFFICE }
 Forest County, Wis. }
 Received for record this...*25th*...day
 of...*January*...A.D., 19*85* at
 ...*8:30* o'clock...*A*...M. and
 recorded in Vol. *CORNER RESTORATIONS*
 on page *17*
Paul Aschenbrenner
 REGISTER

