


CERTIFIED LAND CORNER RESTORATION

D-1 Index No. **D 1**


State of Wisconsin }  
County of Forest } ss.

I, Philip T. Hansen, do hereby certify that on the 11th day of August, 1975, I found evidence of the S-1/16 corner of Sections 1 and 6 Township 35 North, Range 11 and 12 East, Fourth Principal Meridian, as described hereon; and that from this evidence I established a new monument and accessories as described hereon to perpetuate the original location of this corner.

Resident witnesses:

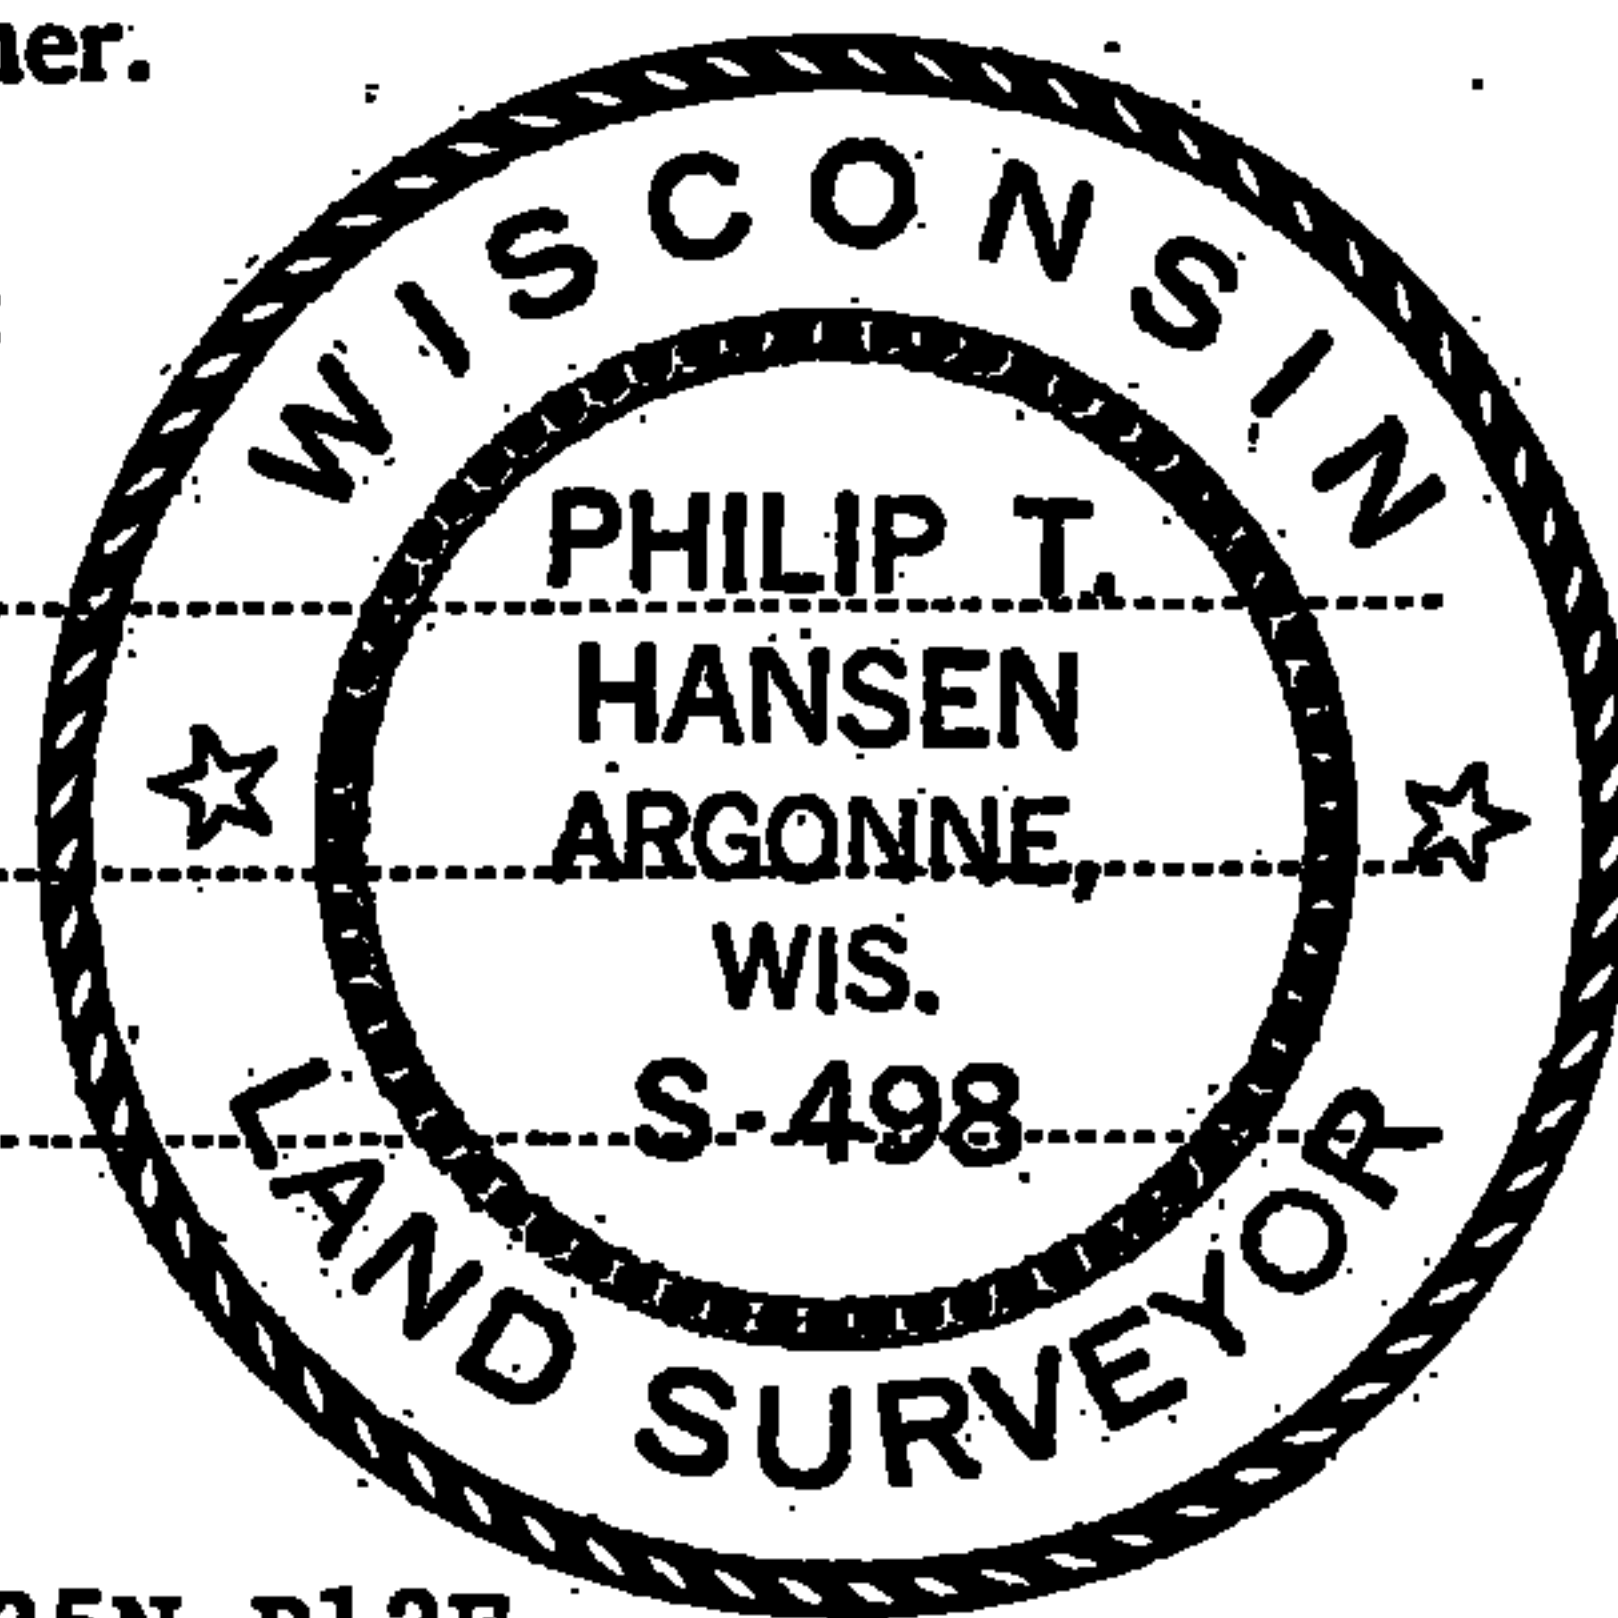

FORM 985 R. G. MILLER CO., MILWAUKEE

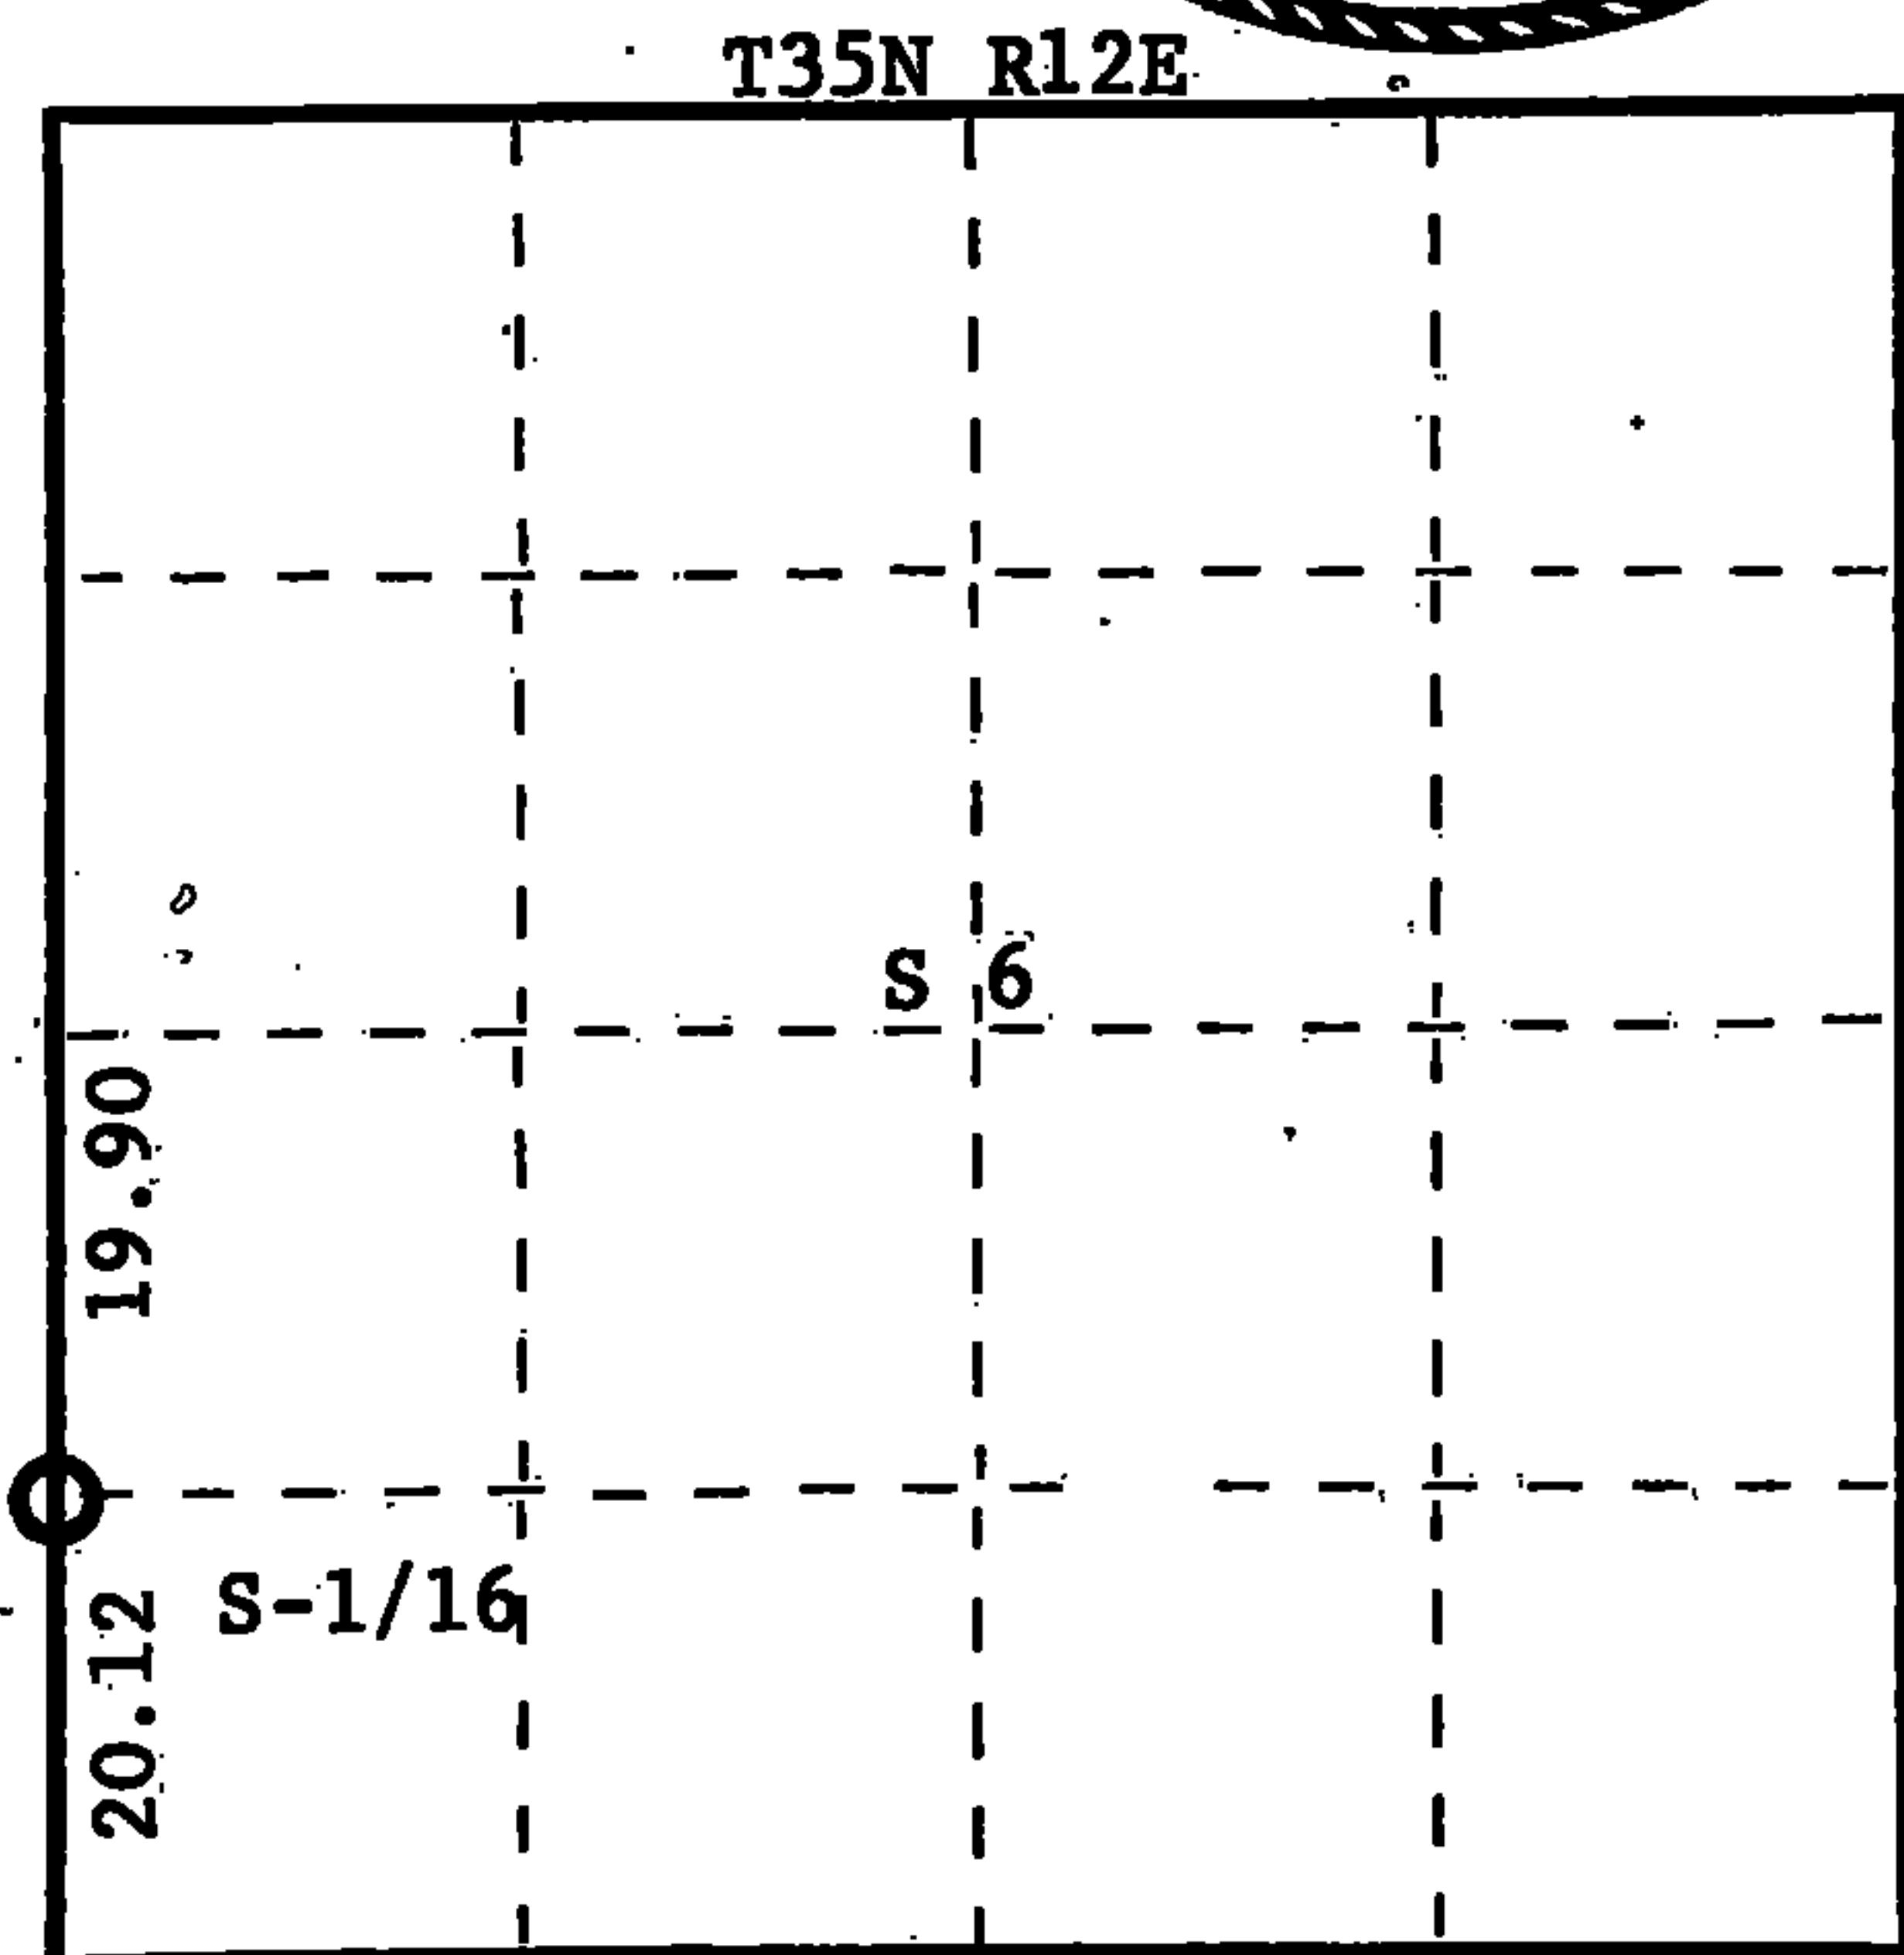

○ = Corner monument restored.

History of original corner establishment:

Corner recovered by H.C. Lawrence, Registered Land Surveyor, in 1946. Recovered wood post in fence line scribed 1/8-1/8, origin unknown. Distance north of SE Corner Section 1 is 20.12 chains. No BT's were found.

Description of corner evidence found:

Recovered cedar stake badly decayed, but scribe marks 1/8 found visible on two sides sitting in the N-S fence line. Recovered old point in ground 1 link south of the fence corner.

Description of monument and accessories I established to perpetuate the original location of this corner:

Replaced old point with 1-1/2" OD iron pipe w/2" brass cap stamped -

NBT's marked: Sugar 10" S80°W 52.2 links-scribed 1/16 BT  
Basswood 10" N25°E 30.1 links-scribed 1/16 BT

S498  
T35N  
R 11 S1 S6 R  
E S-1/16 E  
CPI-1975

Dated at Rhinelander, Wis., this 5th day of September, 1975

Signature: Philip T. Hansen Title: Registered Land Surveyor Registration No. S-498  
(County Surveyor, Registered Land Surveyor, or other duly authorized official)

Office of Register of Deeds, County of Forest, I hereby certify that the within instrument was filed in this office for record on the 6th day of October, 1975 at 4:00 o'clock P.M.

Eugene Stutzman  
(Register of Deeds)  
By \_\_\_\_\_ Deputy

DOCUMENT NUMBER 107919

435 11 01 1098