

CERTIFIED LAND CORNER RESTORATION

Index No. V-1

State of Wisconsin }  
County of Forest } ss.


I Philip T. Hansen, do hereby certify that on the 11th day of November, 1976, I found evidence of the Section corner of S25, 30, 31, 36 Township 35, North, Range 11 & 12 East, Fourth Principal Meridian, as described hereon; and that from this evidence I established a new monument and accessories as described hereon to perpetuate the original location of this corner.

Resident witnesses:


Glen Barker

Jim Claflin

Herb Wagoner

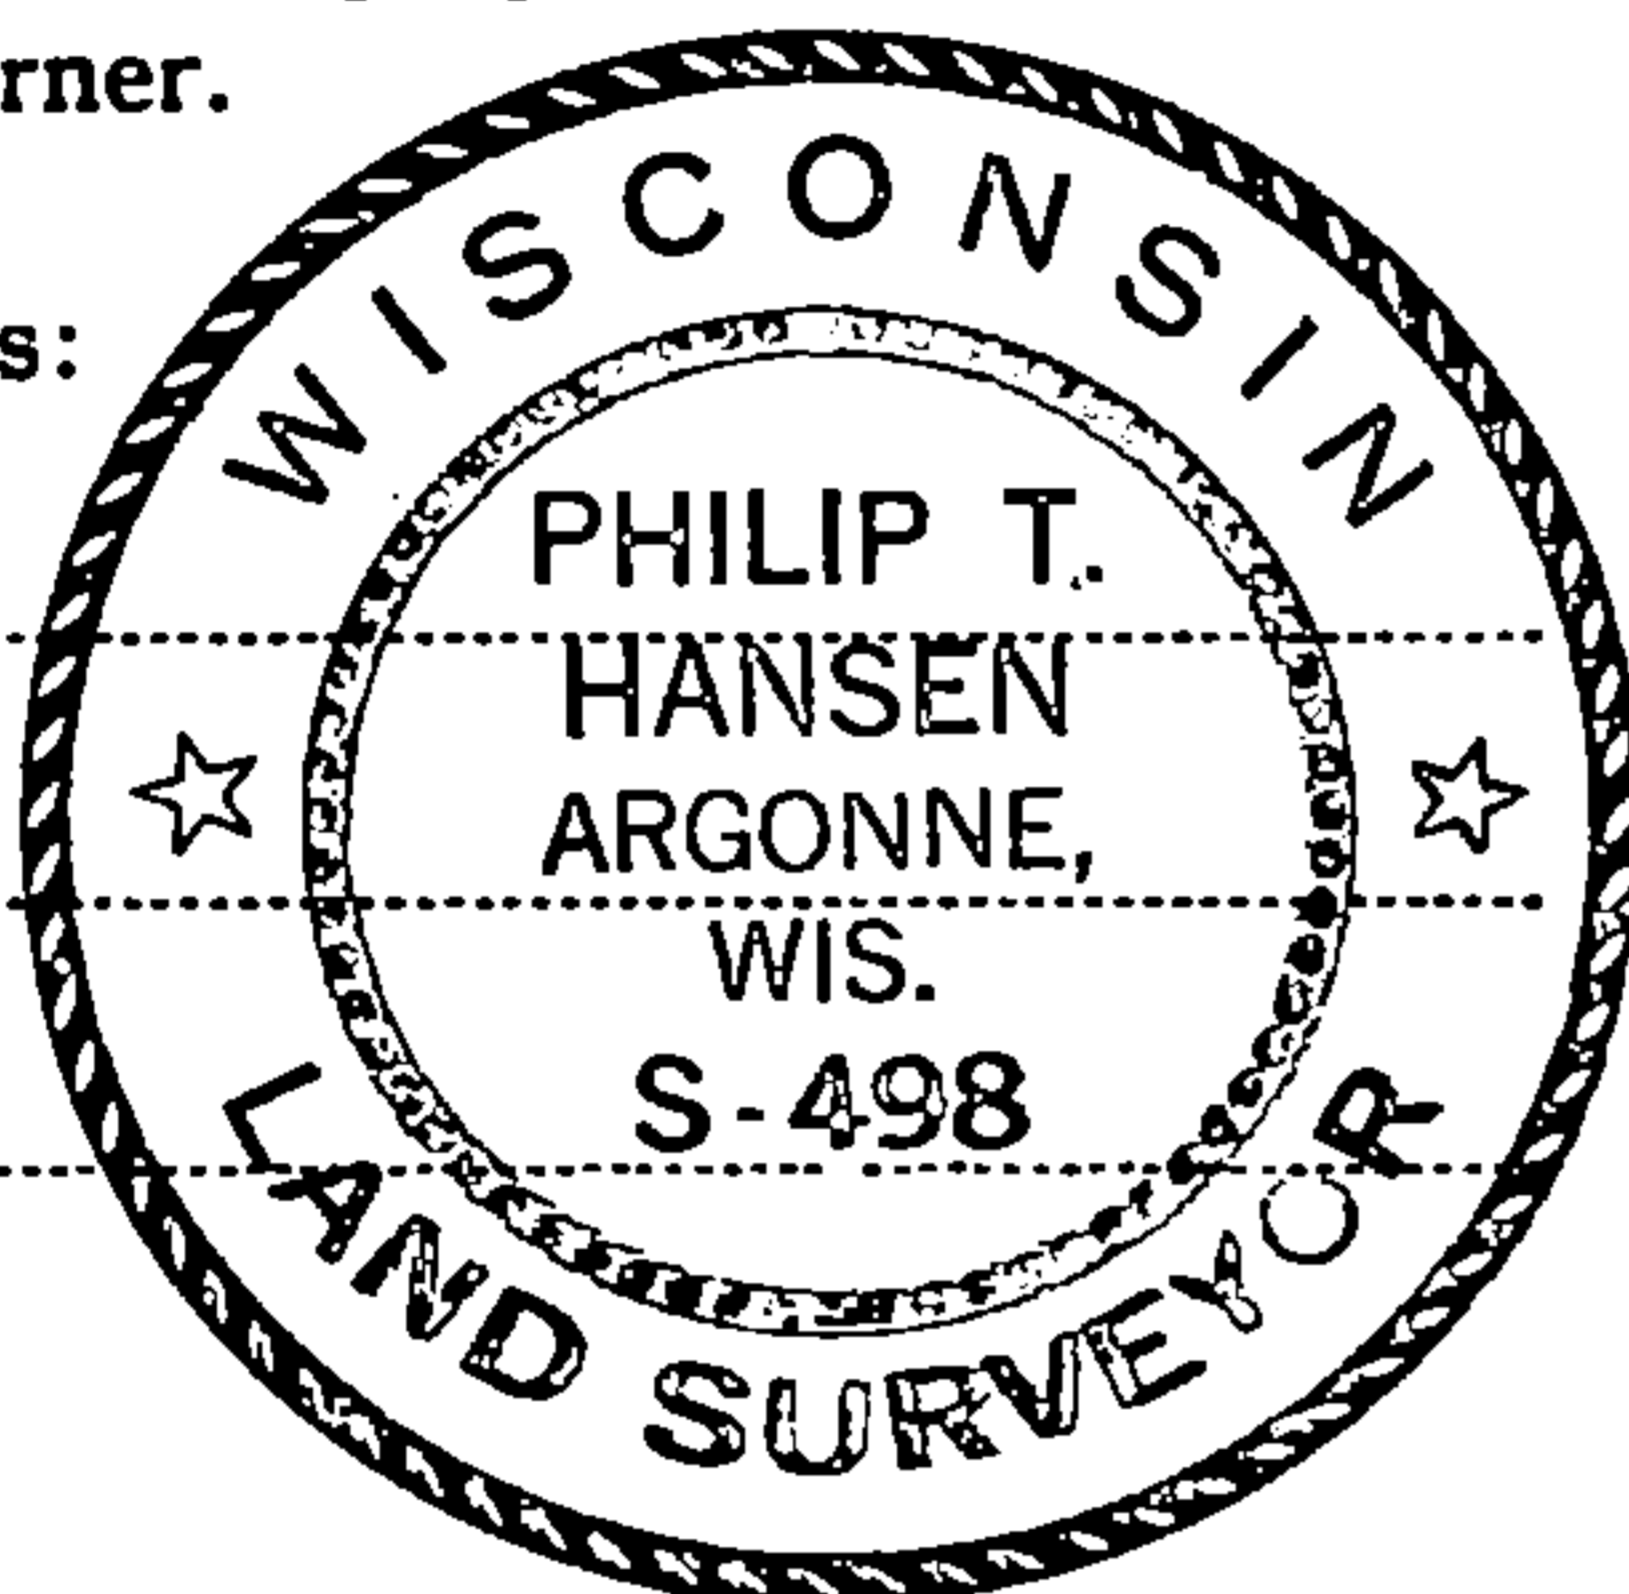

T35N RL2E

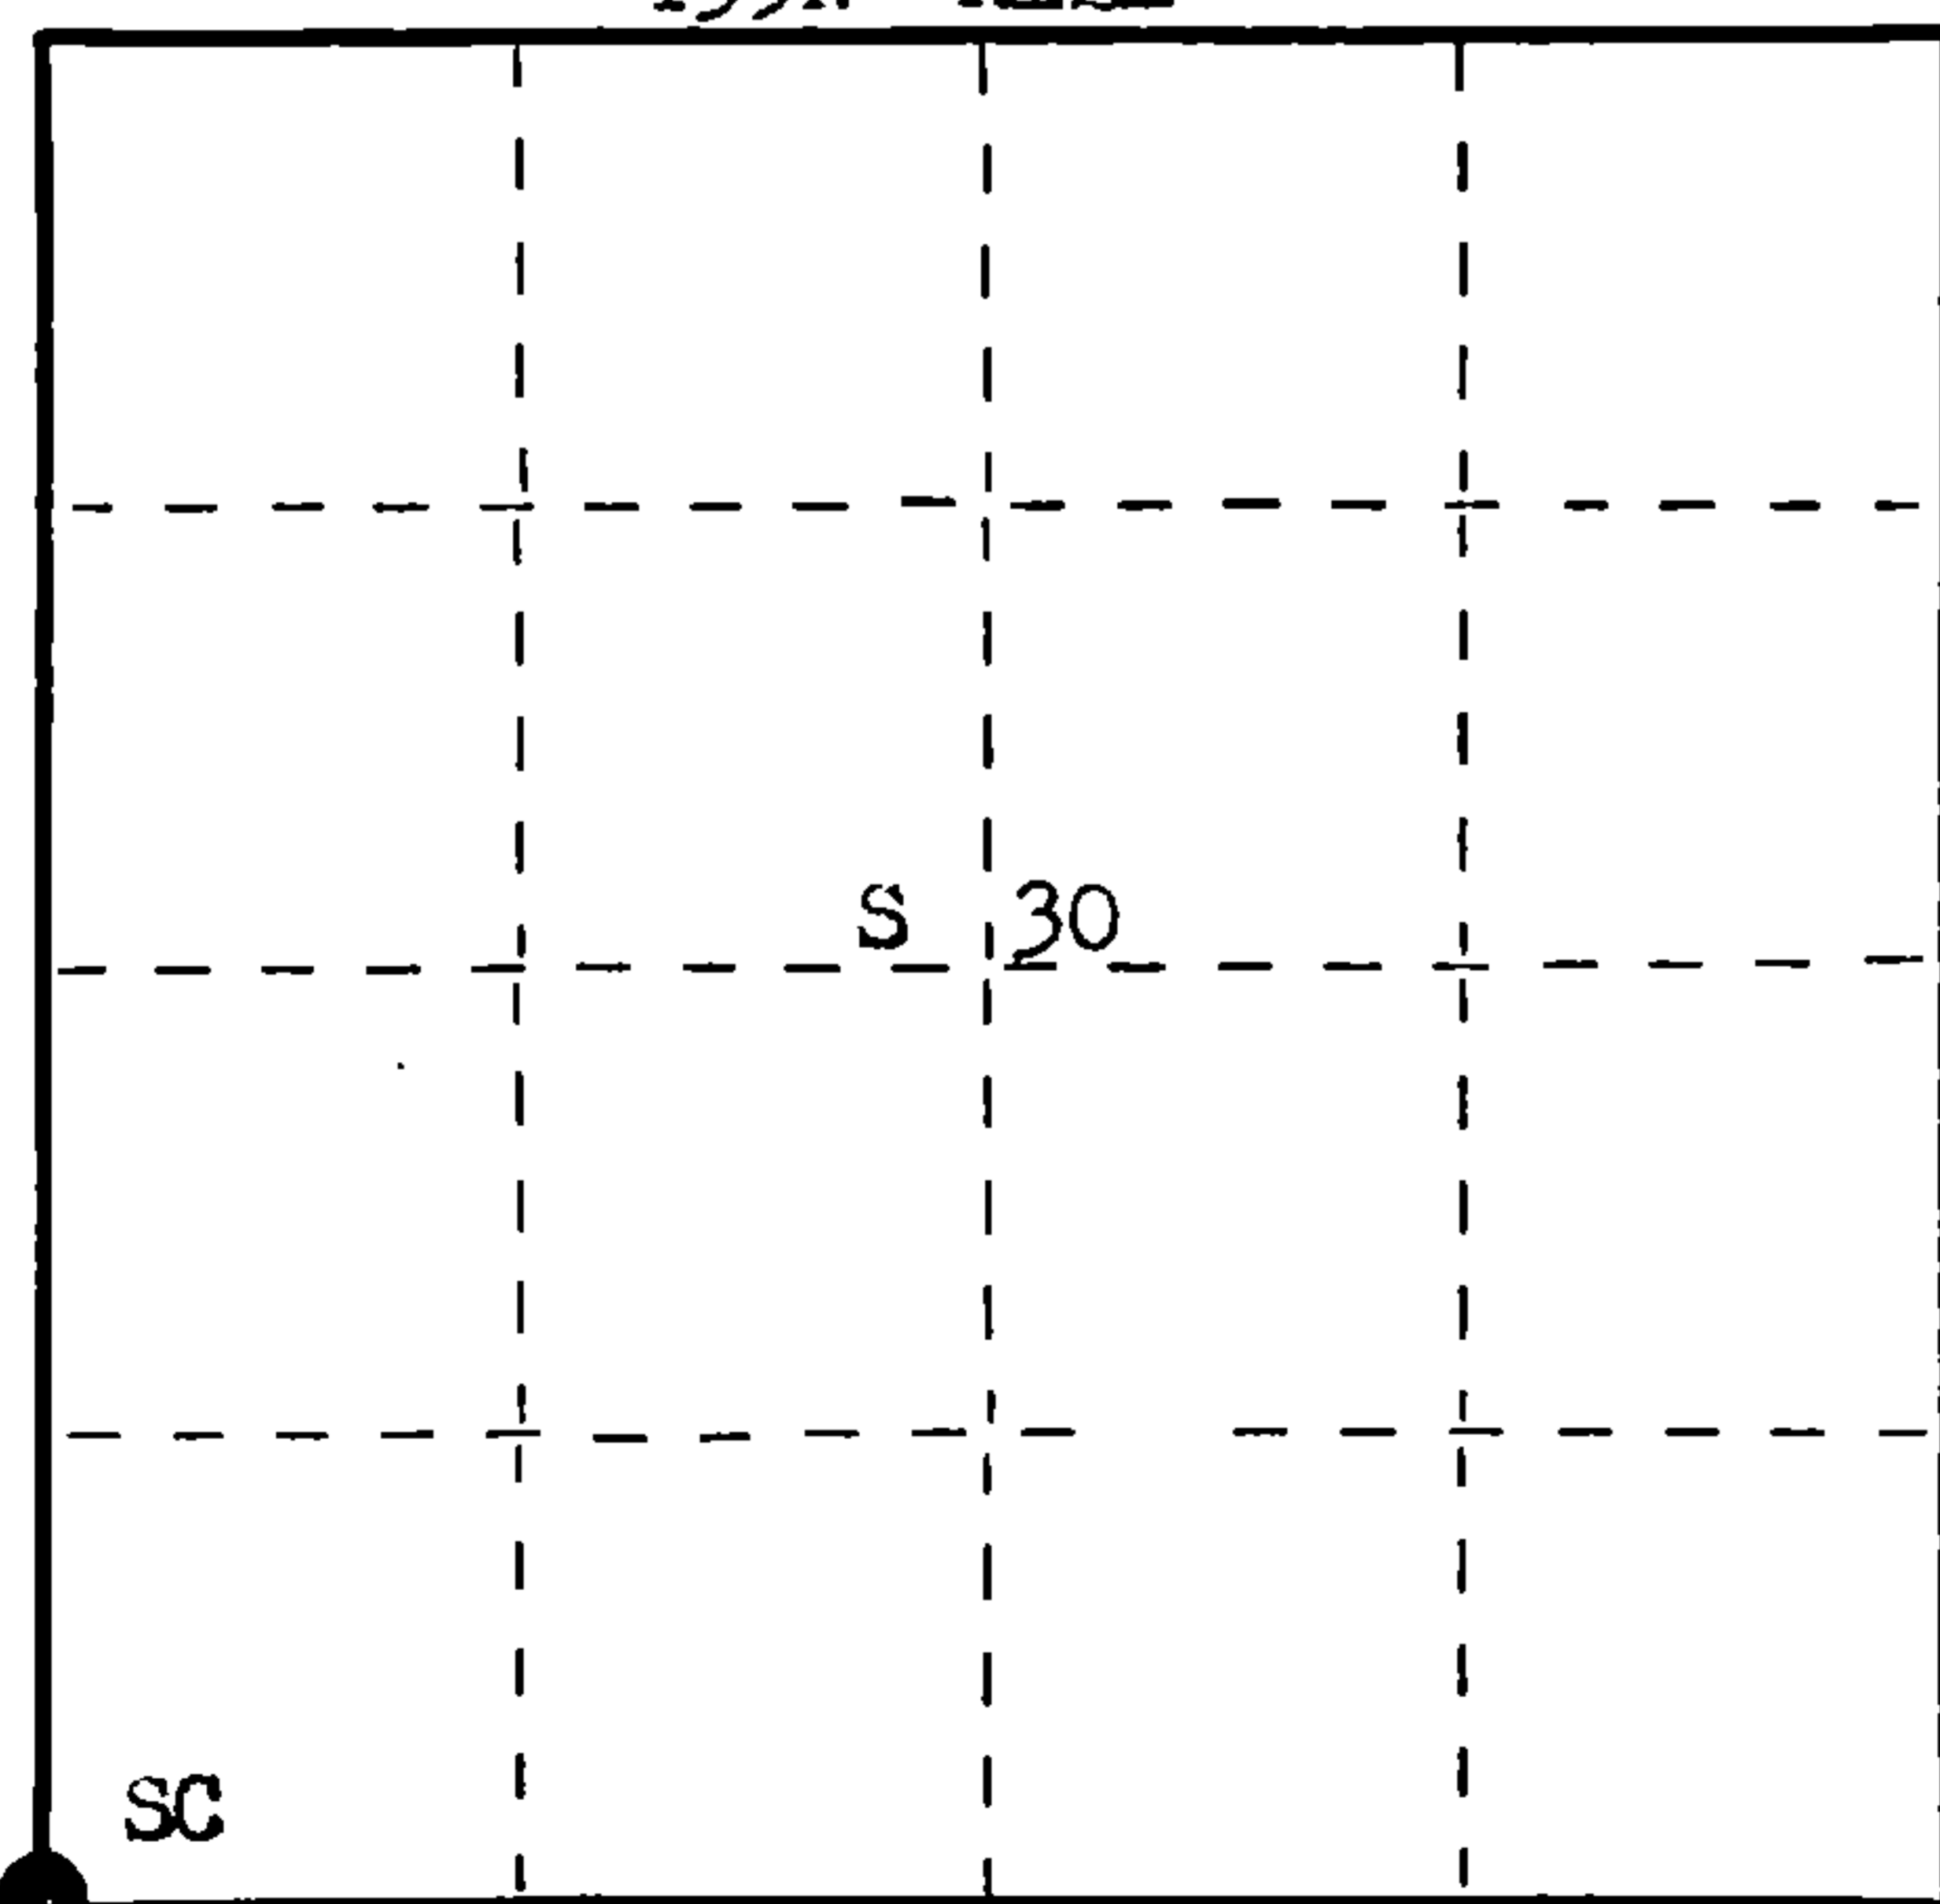

○ = Corner monument restored.

History of original corner establishment:

Original Corner established by Alfred Millard, Deputy Surveyor, in 1857, from which Spruce 10" bears N 85° W 44 links, Cherry 12" bears N 55° E 39 links, White Birch 12" bears S 85° E 10 links, White Birch 11" bears S 28° W 49 links.

H.C. Lawrence, Registered Land Surveyor, recovered a very old post and point of another older post, checked for evidence of OBTs, but found nothing. Set a new 4" cedar post and marked NBTs - Cherry 9" S 65° E 7 links.

White Pine stump 16" N 77° W 50 links.

Description of corner evidence found:

Recovered Lawrence's 4" cedar post, squared and scribed S25 T35N, S36 RL1E, S31 RL2E, S36. A rock cairn had been built around post. Also recovered a very old post laying on rock cairn.

Recovered OBT - Black Cherry 9" (10") S 65° E 7 links, scribed S31 NBT.

White Pine stump 16" N 77° W (N 71° W) 50 links, scribed B0.

Description of monument and accessories I established to perpetuate the original location of this corner.

Replaced Lawrence's post with 2 1/2" Berntsen A-1 Federal Monument, aluminum with magnet in cap and base. Monument projects 12" above ground, cap stamped:

Replaced rock cairn around base of monument.

NBTs - Sugar 6" N 69° E 25.3 links, scribed SC BT.

Sugar 7" N 14° W 34.6 links, scribed SC BT.

Maple 5" S 80° W 49 links, scribed SC BT.

R T35N R  
11 25 | 30 12  
E 36 | 31 E  
S498-1976

Dated at Rhineland, Wis., this 23rd day of November, 1976

Signature Philip T. Hansen Title Registered Land Surveyor Registration No. S-498  
(County Surveyor, Registered Land Surveyor, or other duly authorized official)

Office of Register of Deeds, County of Forest, I hereby certify that the within instrument was filed in this office for record on the 2nd day of December, 1976 at 3:00 o'clock P. M.

Eugene Staszny  
(Register of Deeds)

DOCUMENT NUMBER **110660**

By..... Deputy

FORM 985

43511250000