

CERTIFIED LAND CORNER RESTORATION

Index No. Y-1

State of Wisconsin }
County of Forest } ss.



I, Philip T. Hansen, do hereby certify that on the 30th day of November, 19 76, I found evidence of the S 1/16 corner of Section 31 and 36 Township 35, North, Range 12 East, Fourth, Principal Meridian, as described hereon; and that from this evidence I established a new monument and accessories as described hereon to perpetuate the original location of this corner.

Resident witnesses:

Glen Barker

Jim Claflin

Herb Wagoner

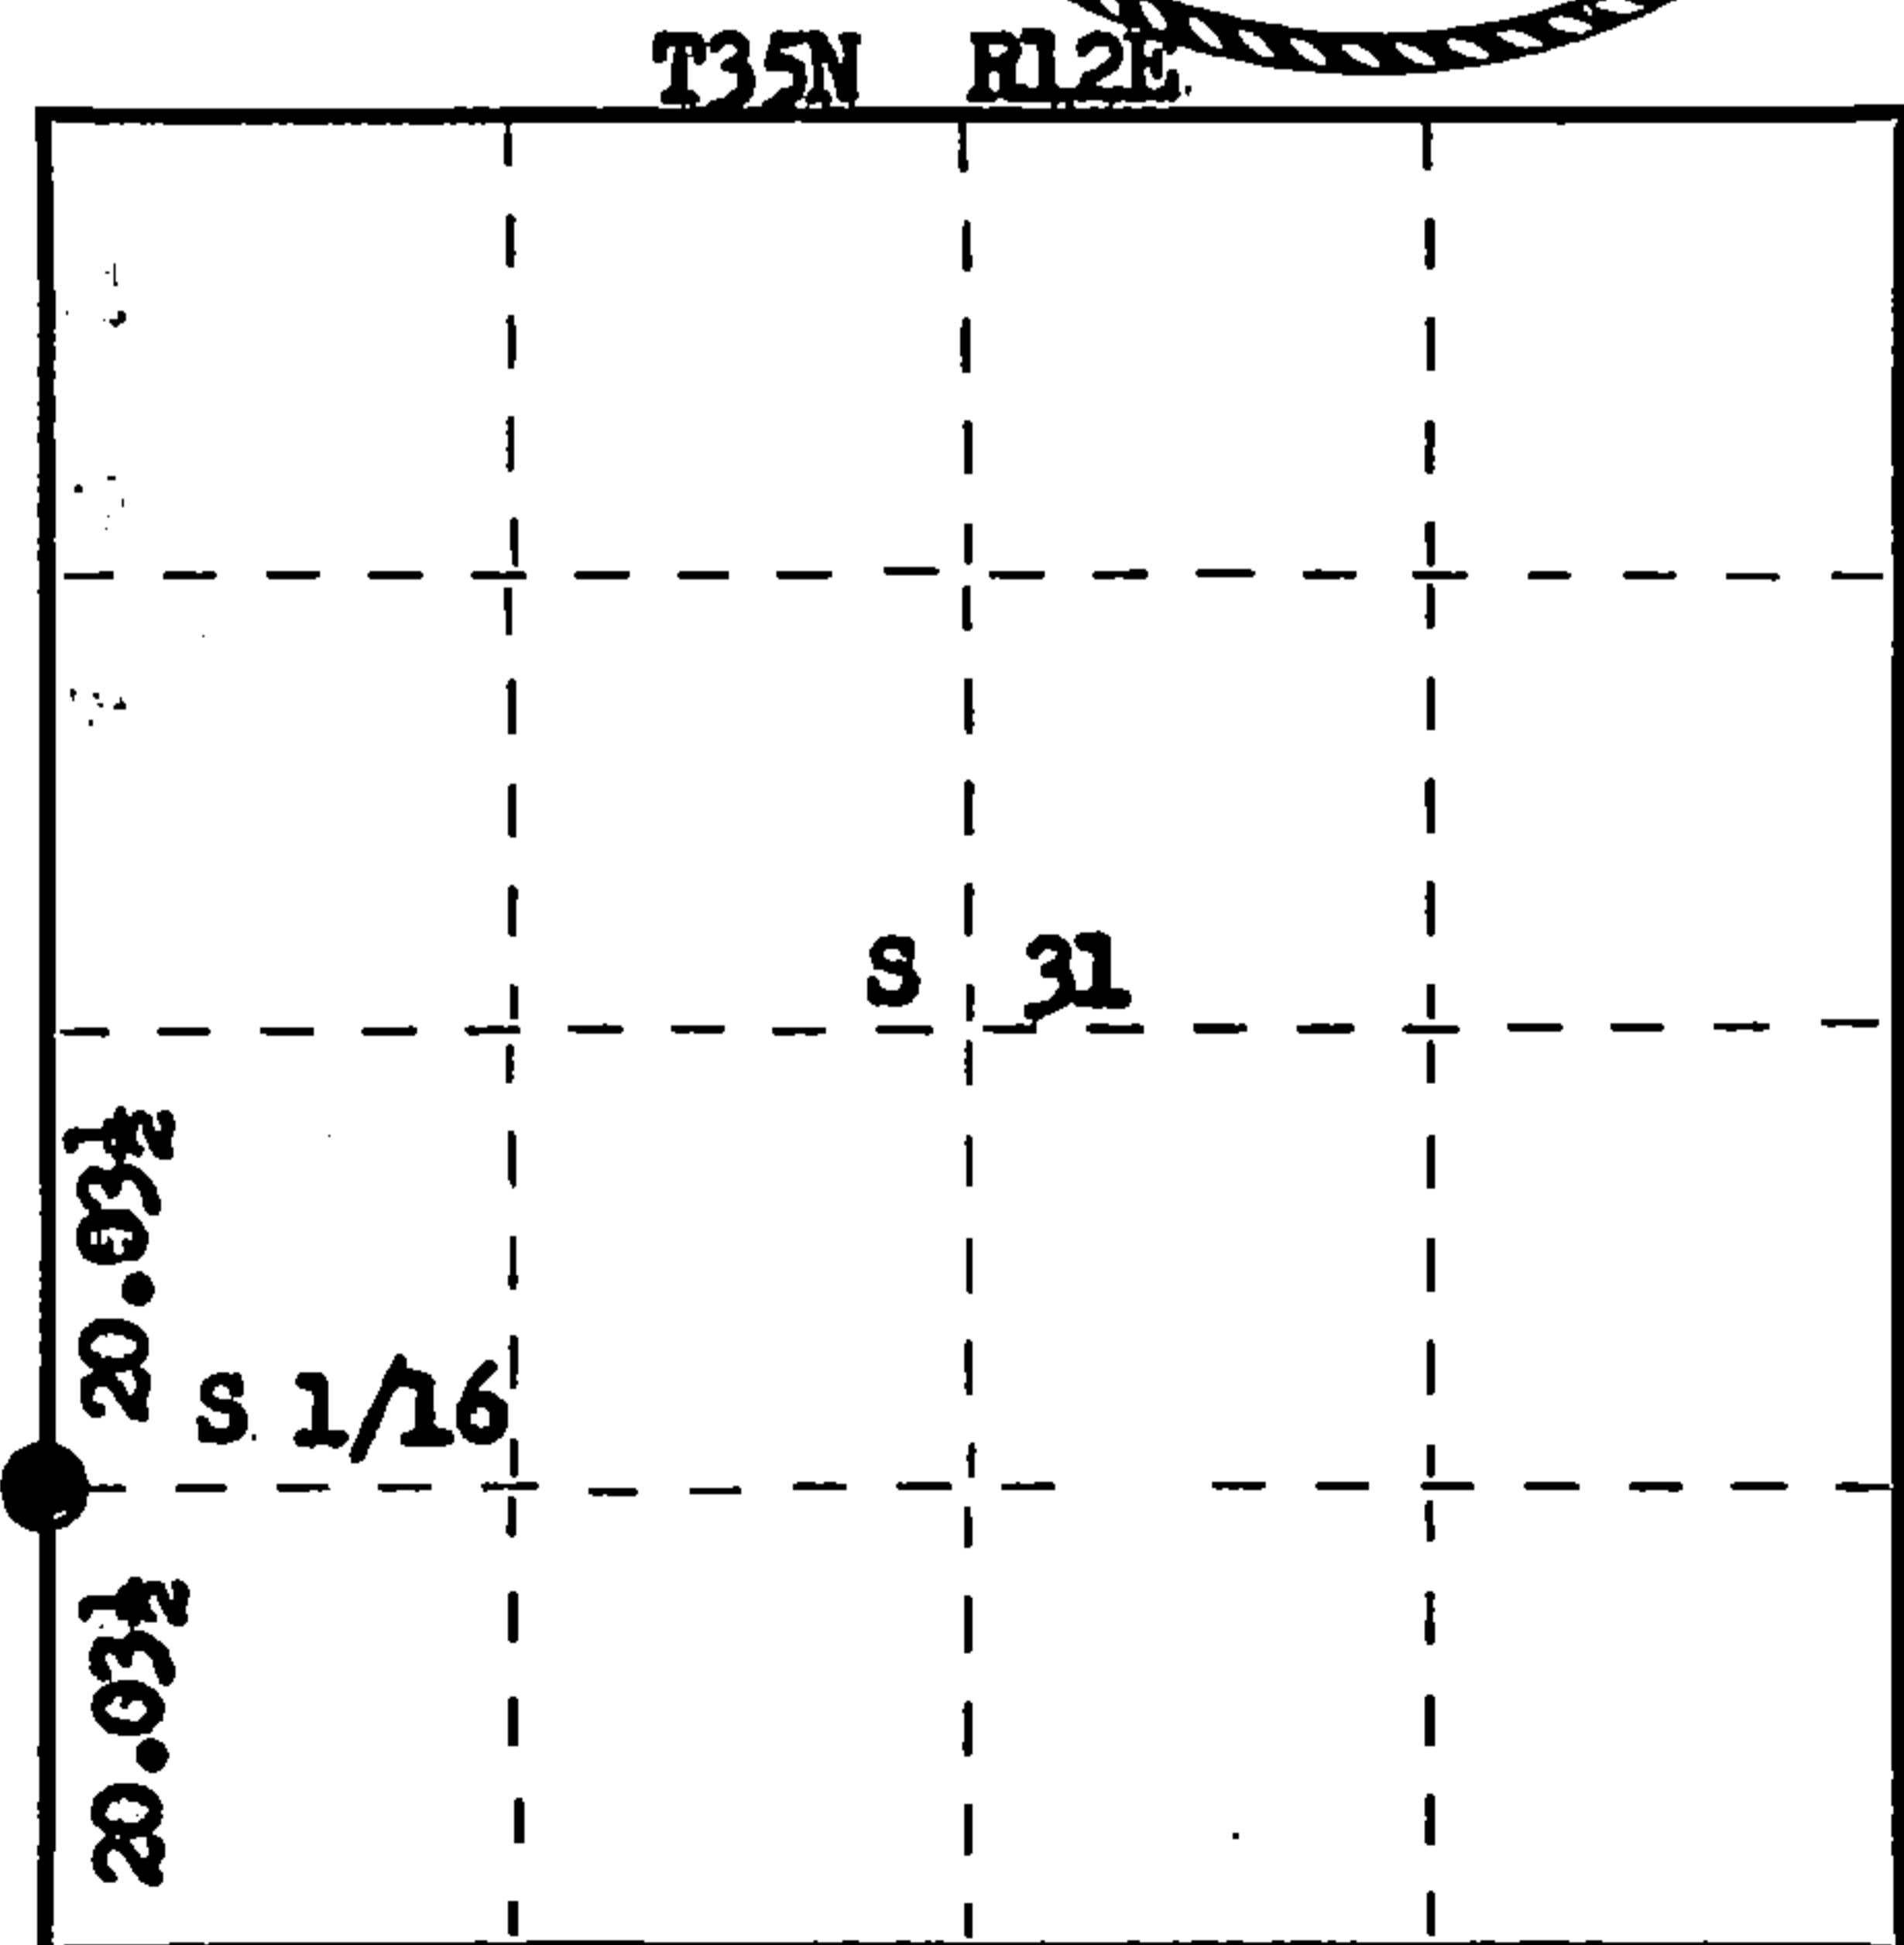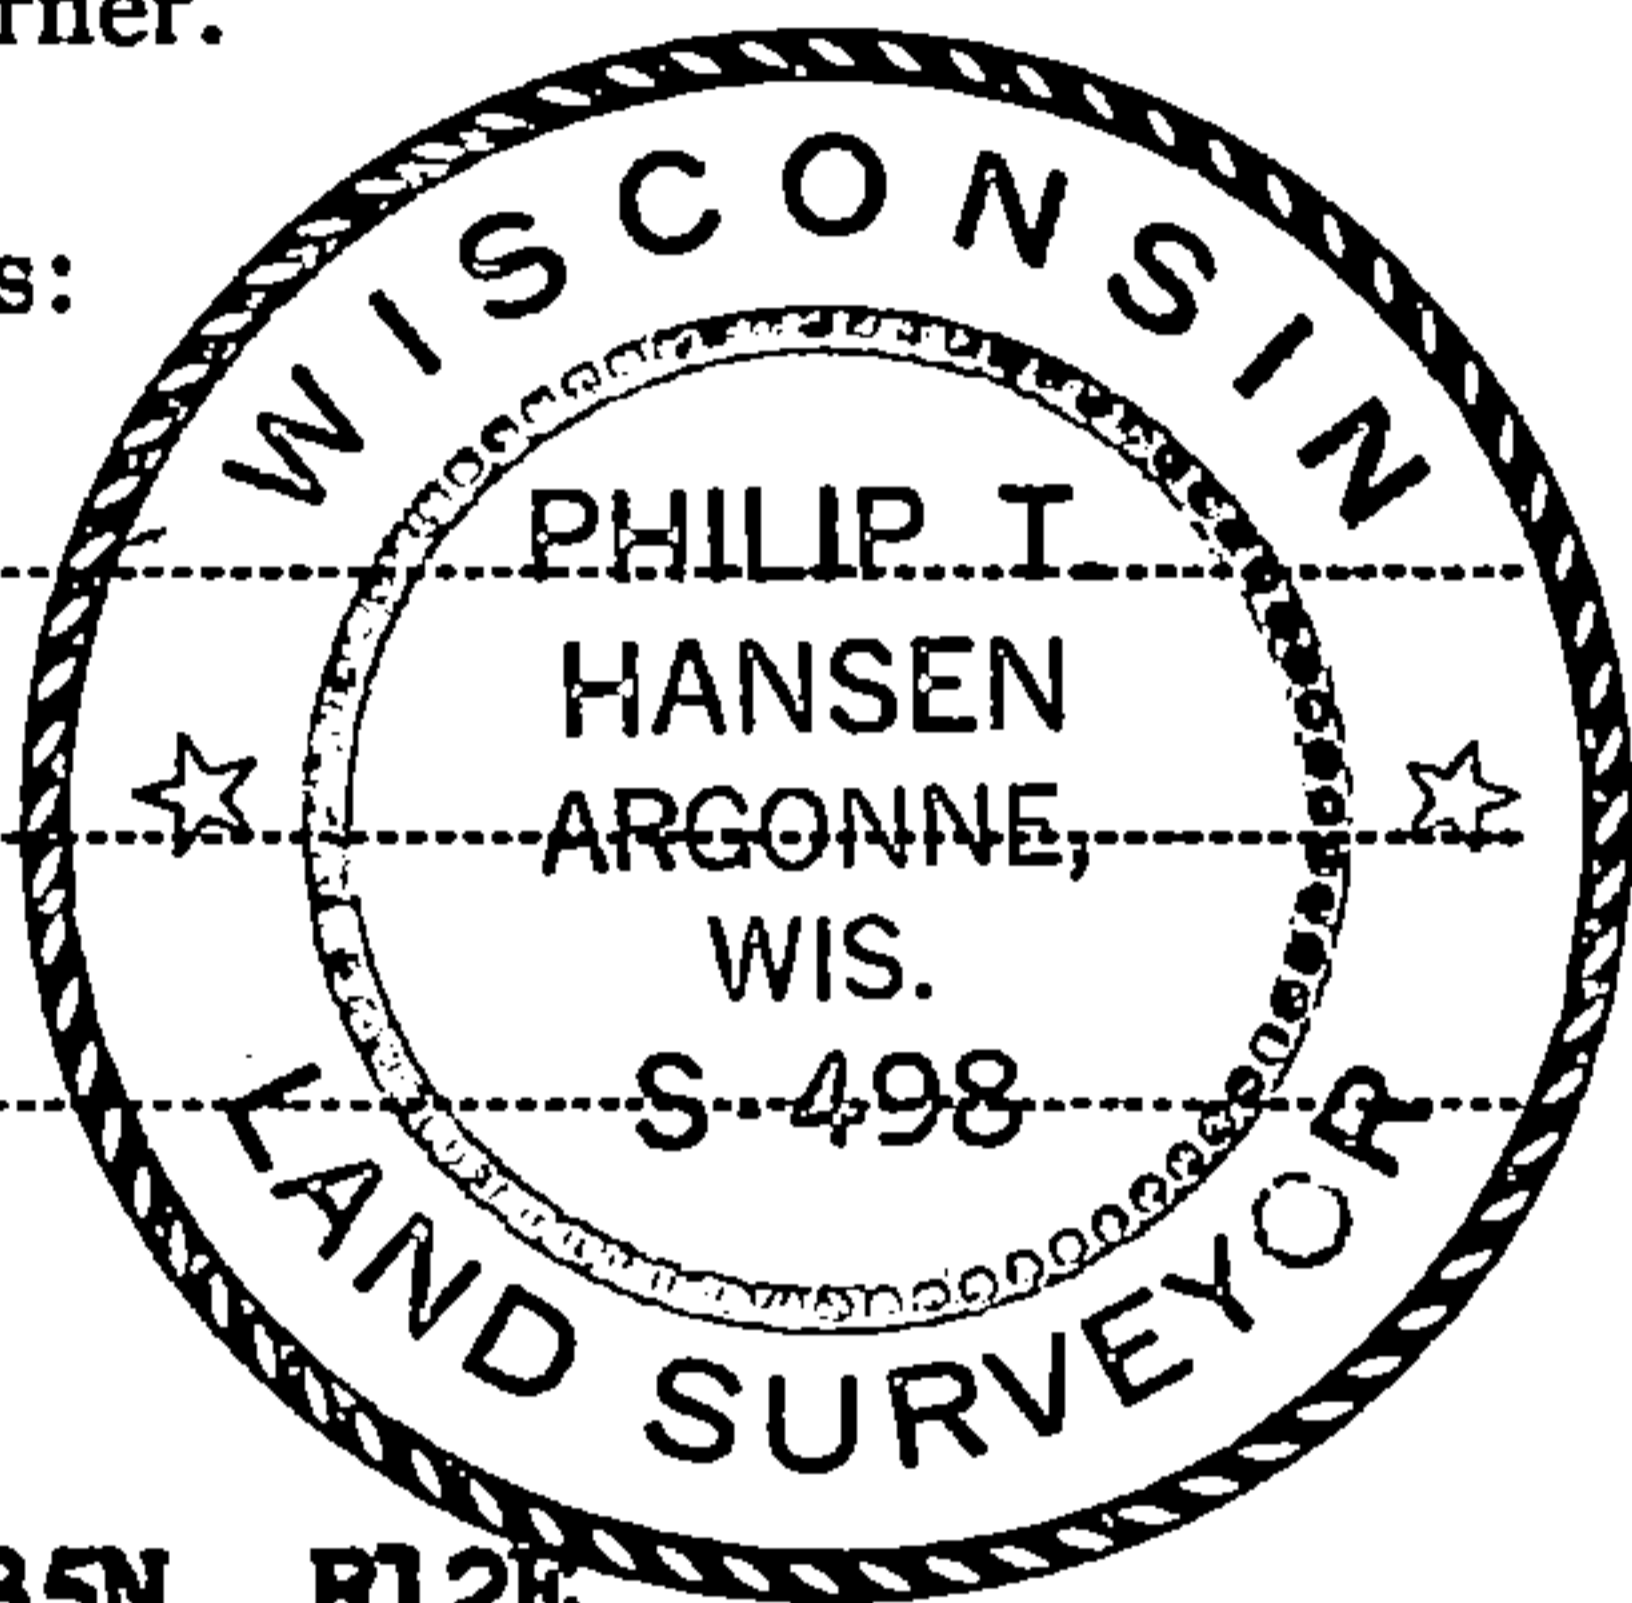

○ = Corner monument restored.

History of original corner establishment:

Corner established by H.C. Lawrence, Registered Land Surveyor, in 1959. Ran random line S 3° 00' E from recovered Section Corner 25, 30, 31 and 36 80.14 chains to close out 47 links east of Township Corner. Set 6" cedar post for south 1/16 at 60.10 chains, equidistant between 1/4 corner and Township Corner, 35 links west. Marked cedar stump 12" S 20° E 7 1/2 links and Cedar 10" N 80° E 33 links.

Description of corner evidence found:

Recovered 6" cedar post, squared and scribed S 1/16 S31 R12E, S 1/16 S36 R11E in fair condition. Also an old cedar stake scribed 1/8S laying beside it. Recovered OBTs - Cedar stump 12" S 20° E (S 12° E) 7.5 links, scribed S 1/16 B0. Cedar 10" S 80° E 33 links, scribed S 1/16 S31 BT.

Description of monument and accessories I established to perpetuate the original location of this corner.

Replaced 6" cedar post with 1 1/2" OD iron pipe with 2" brass cap, stamped: Monument projects 2' above ground. NBT - Cedar 8" N 60° W 49.5 links, scribed 1/16 BT.

S498
R T35N R
11 36 | 31 12
E E
CPL-1976

Dated at Rhineland, Wis., this 13th day of December, 19 76

Signature Philip T. Hansen Title Registered Land Surveyor Registration No. S-498
(County Surveyor, Registered Land Surveyor, or other duly authorized official)

Office of Register of Deeds, County of Forest, I hereby certify that the within instrument was filed in this office for record on the 21st day of January, 19 77 at 4:00 o'clock P.M.

Eugene Stegny
(Register of Deeds)
By _____ Deputy

DOCUMENT NUMBER **110881**

FORM 985 H. C. MILLER CO., MILWAUKEE

43511361000