

CERTIFIED LAND CORNER RESTORATION

Index No. W-1

State of Wisconsin }
County of Forest } ss.


I Philip T. Hansen, do hereby certify that on the 30th day of November, 1976, I found evidence of the N 1/16 corner of Section 31 & 36 Township 35, North, Range 11 East, Fourth, Principal Meridian, as described hereon; and that from this evidence I established a new monument and accessories as described hereon to perpetuate the original location of this corner.

Resident witnesses:


Glen Barker

Jim Claflin

Herb Wagoner

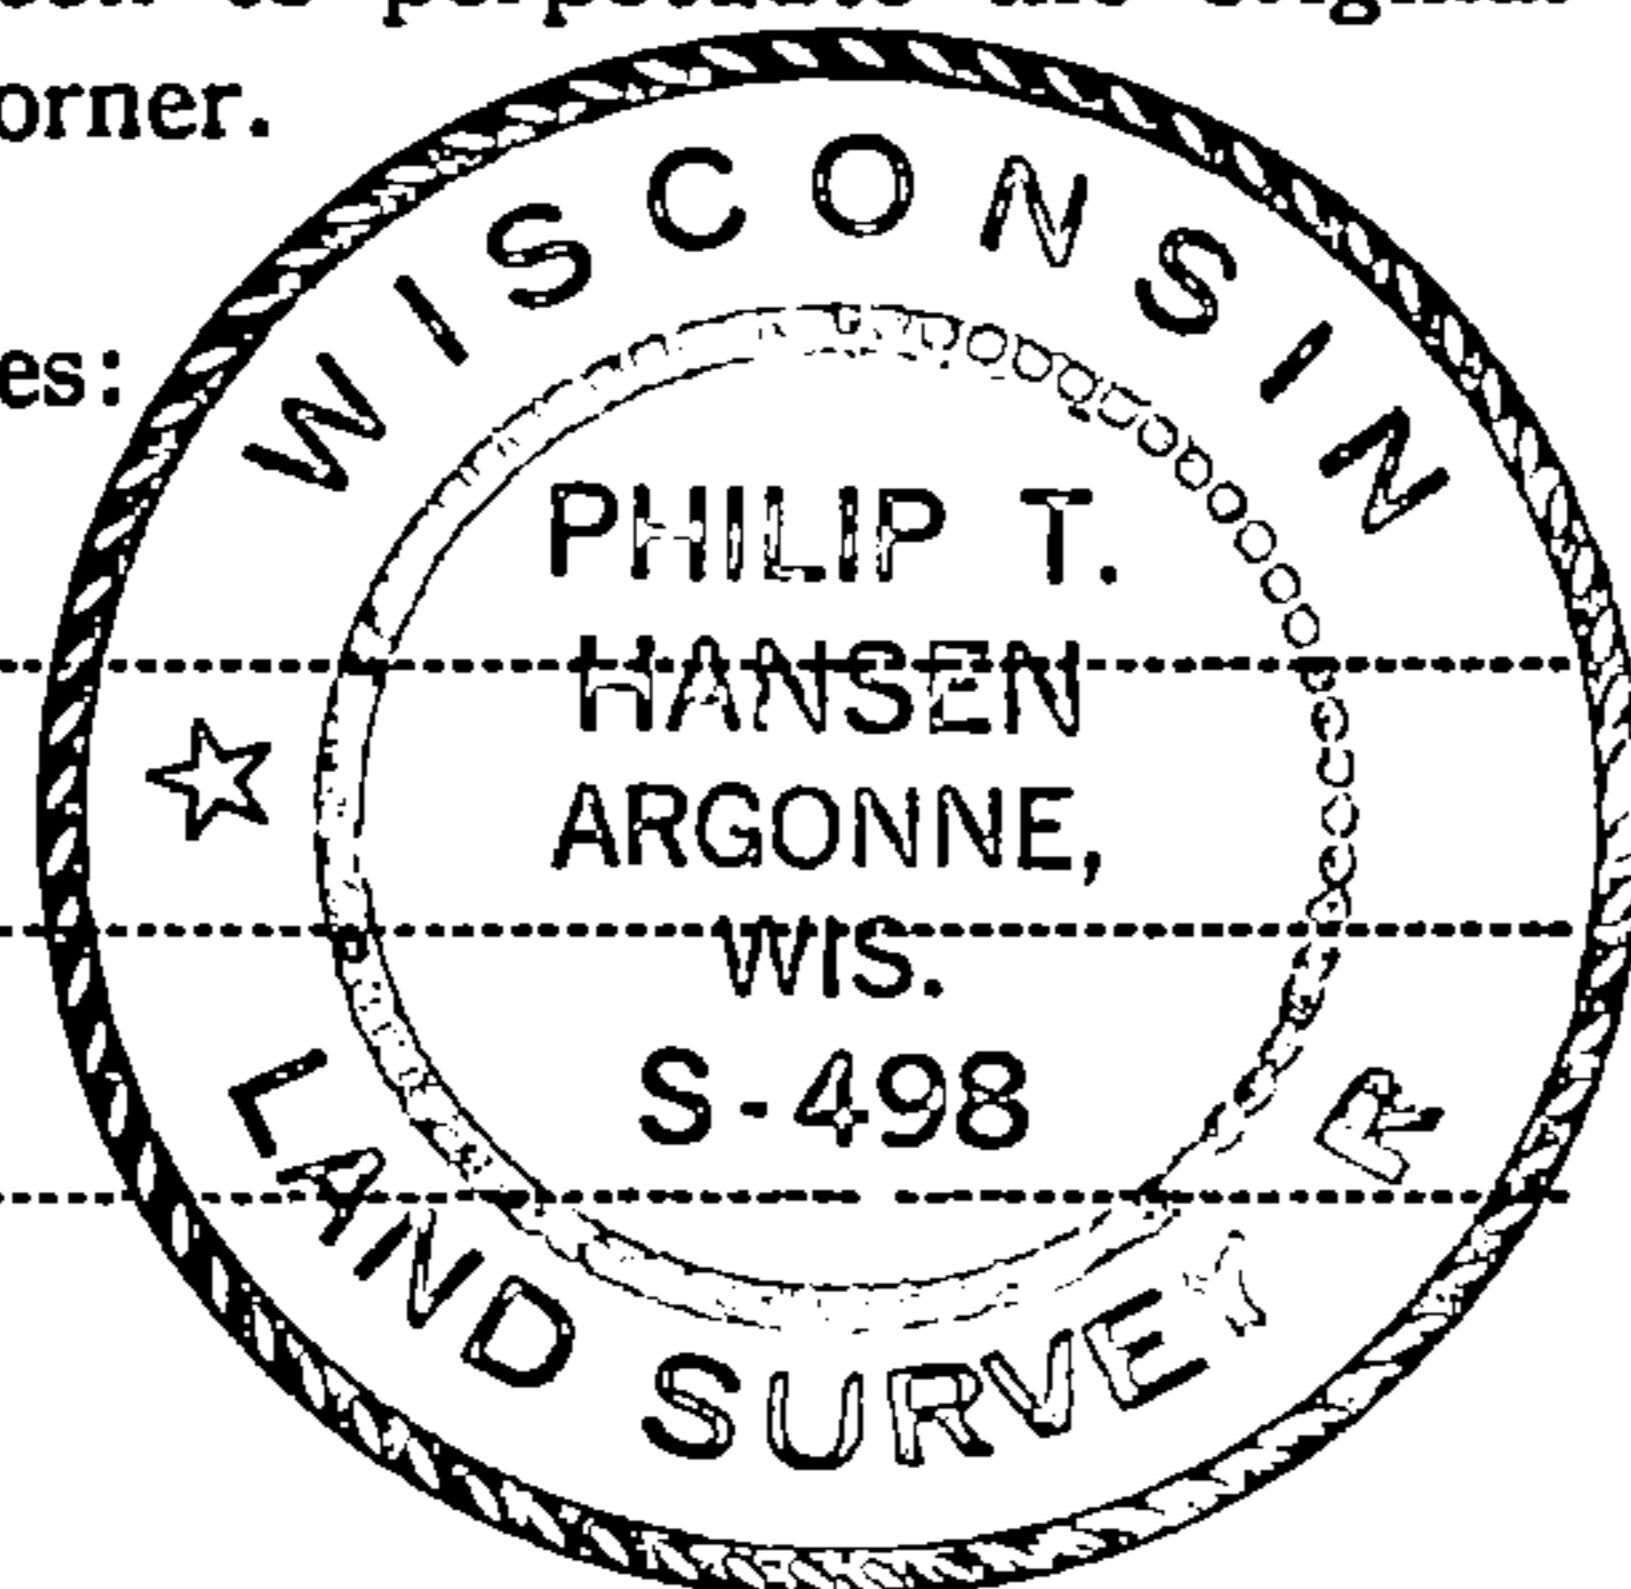

T35N R12E

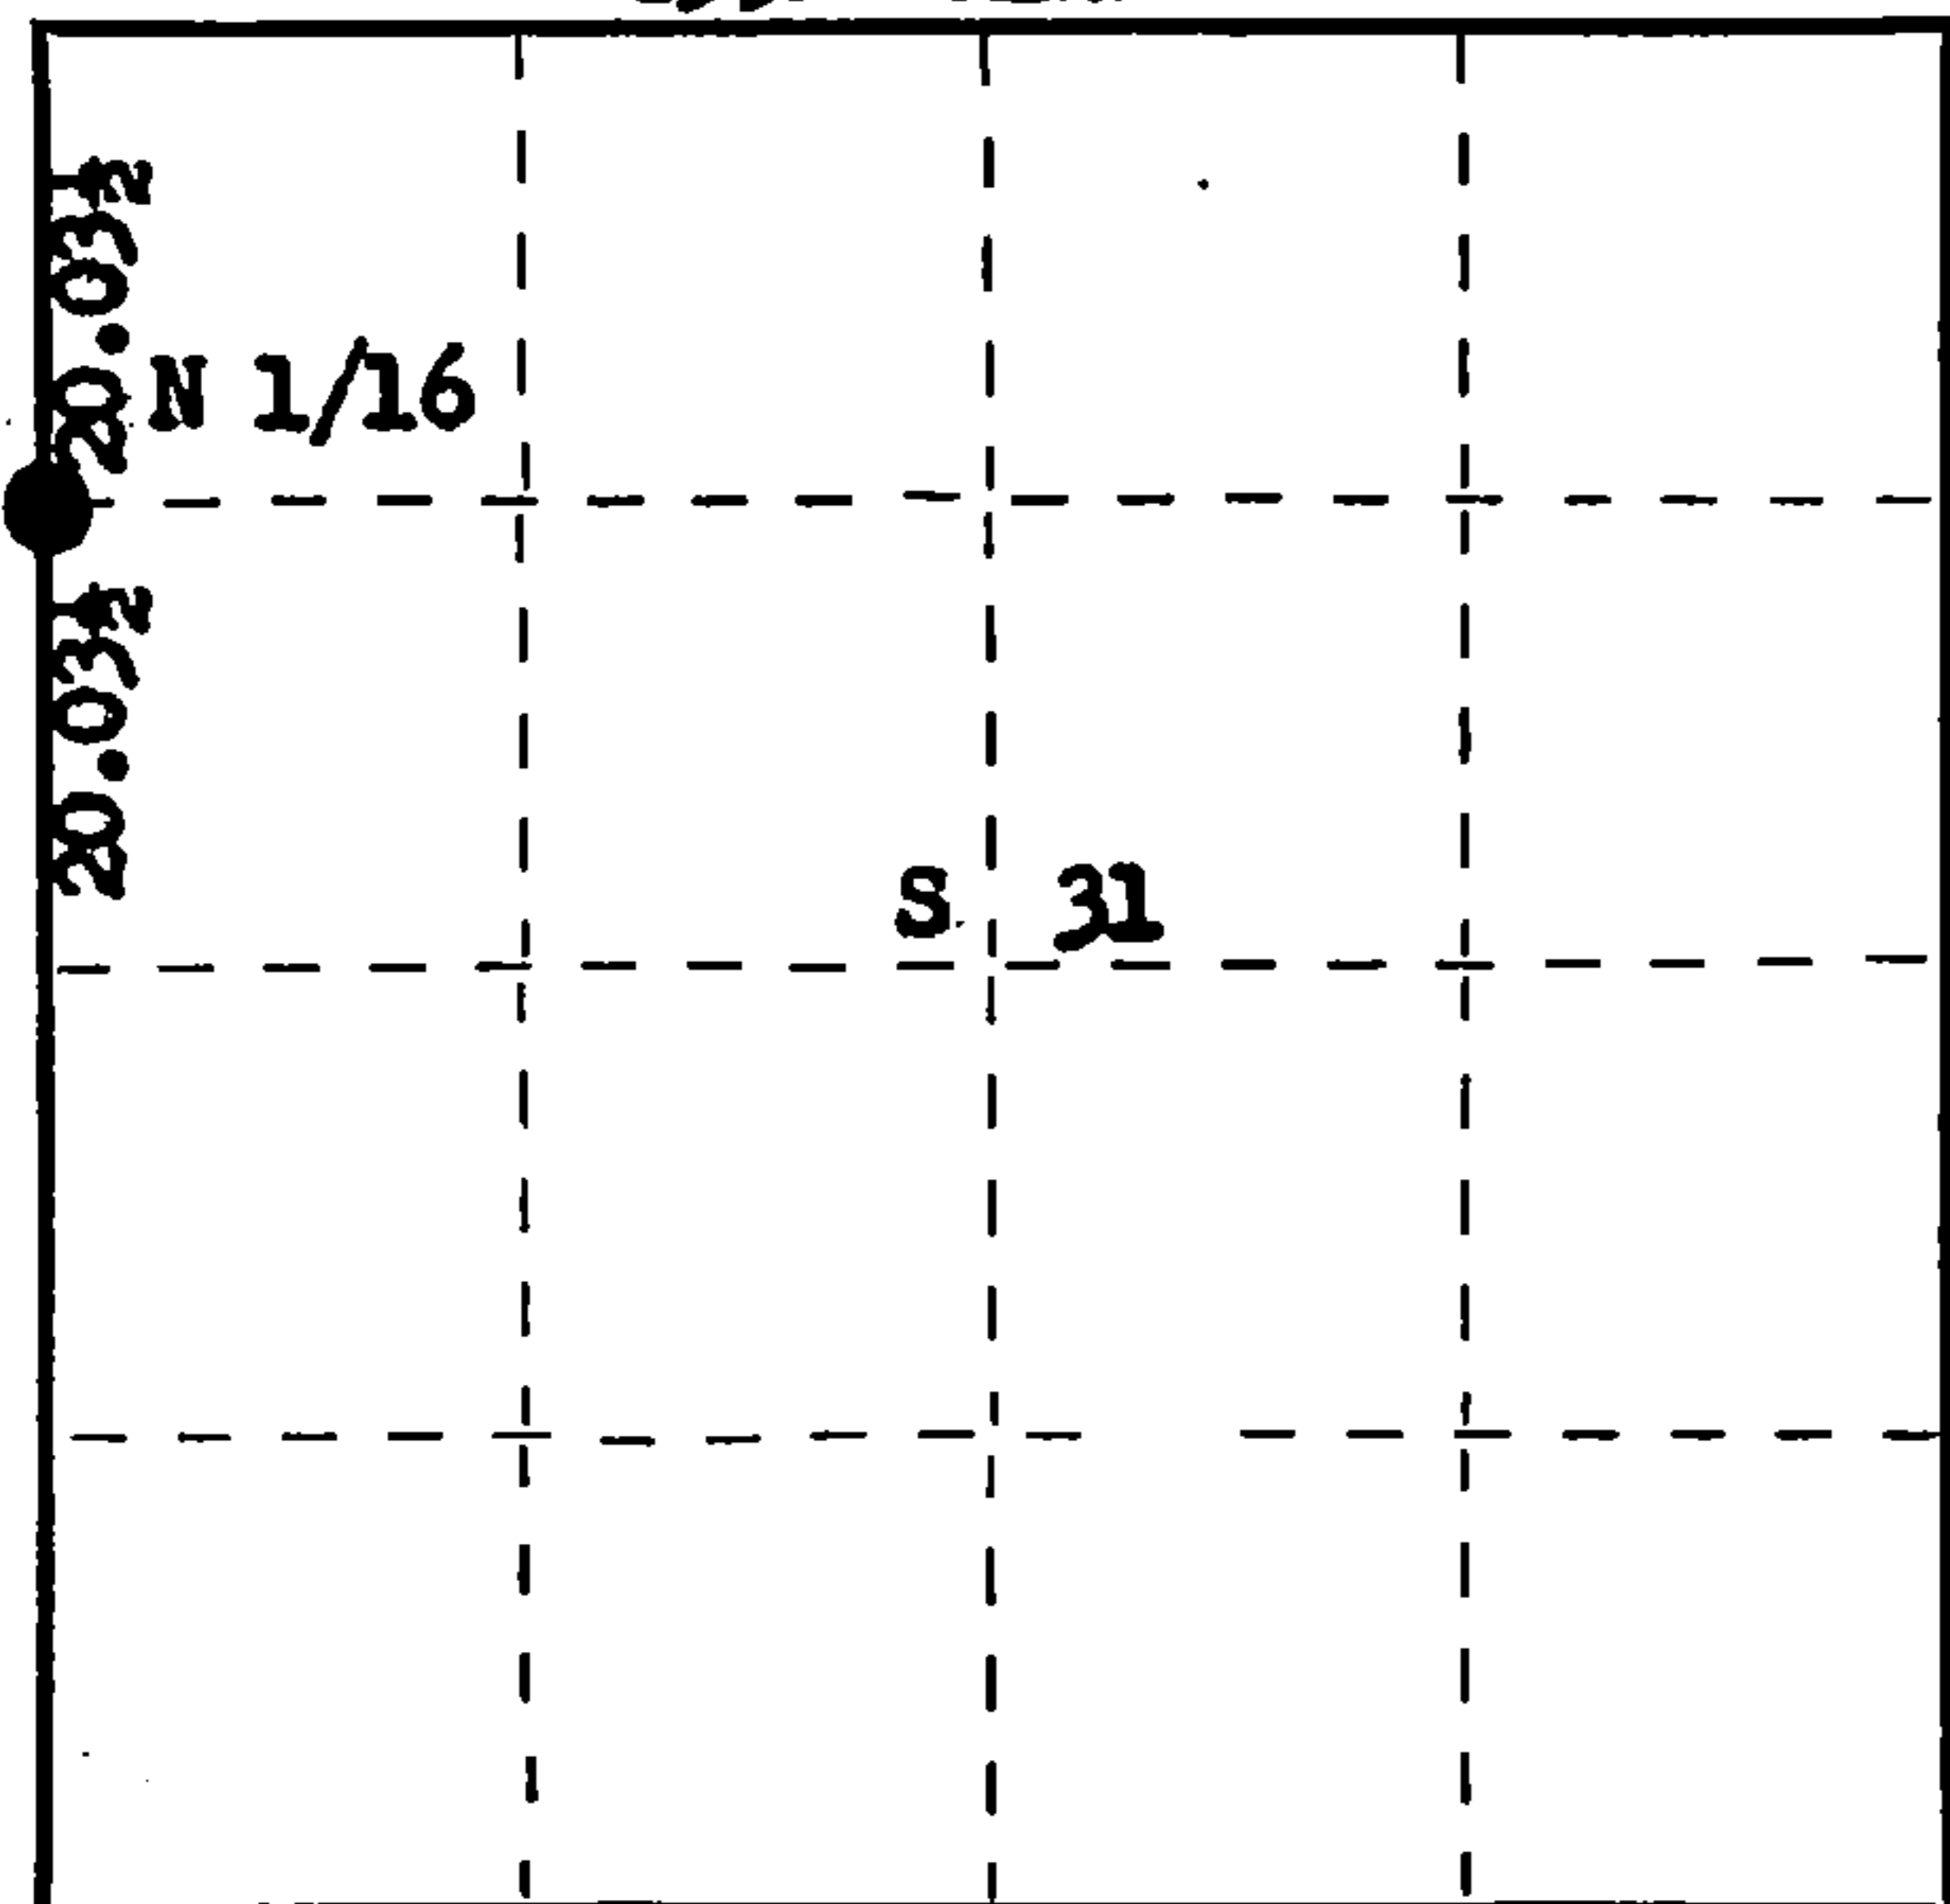

○ = Corner monument restored.

History of original corner establishment:

Corner established by H.C. Lawrence, Registered Land Surveyor, in 1959. Ran a random line S 3° 00' E from recovered Section Corner 25, 30, 31 and 36 80.14 chains to close out 47 links east of Township Corner. Set 3" cedar post at 20.03½ chains and 12 links west intermediate. Marked NBTs - Maple 9" S 53° W 109 links. Basswood S 43° E 93 links.

Description of corner evidence found:

Recovered 4" cedar post, squared and scribed N 1/16 S31, N 1/16 S36 in fair condition. Also an old squared cedar post laying beside it. Recovered OBT - Maple 9" (10") S 53° W 109 links, (12 links) Bass 16" S 43° E 93 links (14 links)

Unable to see any evidence of post being moved. Lawrence's ties would not fit the facing on the BTs.

Description of monument and accessories I established to perpetuate the original location of this corner.

Replaced 4" cedar post with 1½" OD iron pipe with 2" brass cap stamped: Monument projects 2' above ground. NBT - Maple 10" N 52° W 46.5 links, scribed 1/16 BT.

S498
T35N R
N 1/16 36 | 31 12
CPL-1976 E

Dated at Rhineland, Wis., this 13th day of December, 1976

Signature Philip T. Hansen Title Registered Land Surveyor Registration No. S-498
(County Surveyor, Registered Land Surveyor, or other duly authorized official)

Office of Register of Deeds, County of Forest, I hereby certify that the within instrument was filed in this office for record on the 21st day of January, 1977 at 4:00 o'clock P. M.

Eugene Stutzman
(Register of Deeds)
By _____ Deputy

DOCUMENT NUMBER **110880**

FORM 985 R. C. MILLER CO., MILWAUKEE

43511363000