

CERTIFIED LAND CORNER RESTORATION

Index No E-11

State of Wisconsin }  
County of Forest } ss.

History of original corner establishment:

Sugar	10	N56E.	16 Lks.
Sugar	18	N53W	44 Lks.
Sugar	10	S70W	38 Lks.
Sugar	9	S78E.	19 Lks.

I Thomas R. Arnott, do hereby certify that on the 18th day of September, 19 75, I found evidence of the section corner of sections 1, 6, 7 & 12 Township 35, North, Range 12 - 13 E, Fourth Principal Meridian, as described hereon; and that from this evidence I established a new monument and accessories as described hereon to perpetuate the original location of this corner.

Description of corner evidence found:

5/8" iron pin 3" below road grade



Resident witnesses:


Herbert Wagoner

Description of monument and accessories I established to perpetuate the original location of this corner.

Ties:

Forest County aluminum monument	N84 $\frac{1}{2}$ E	24.00 feet
Road sign post	S61W	48.50 feet

FORM 985 H. G. MILLER CO., MILWAUKEE

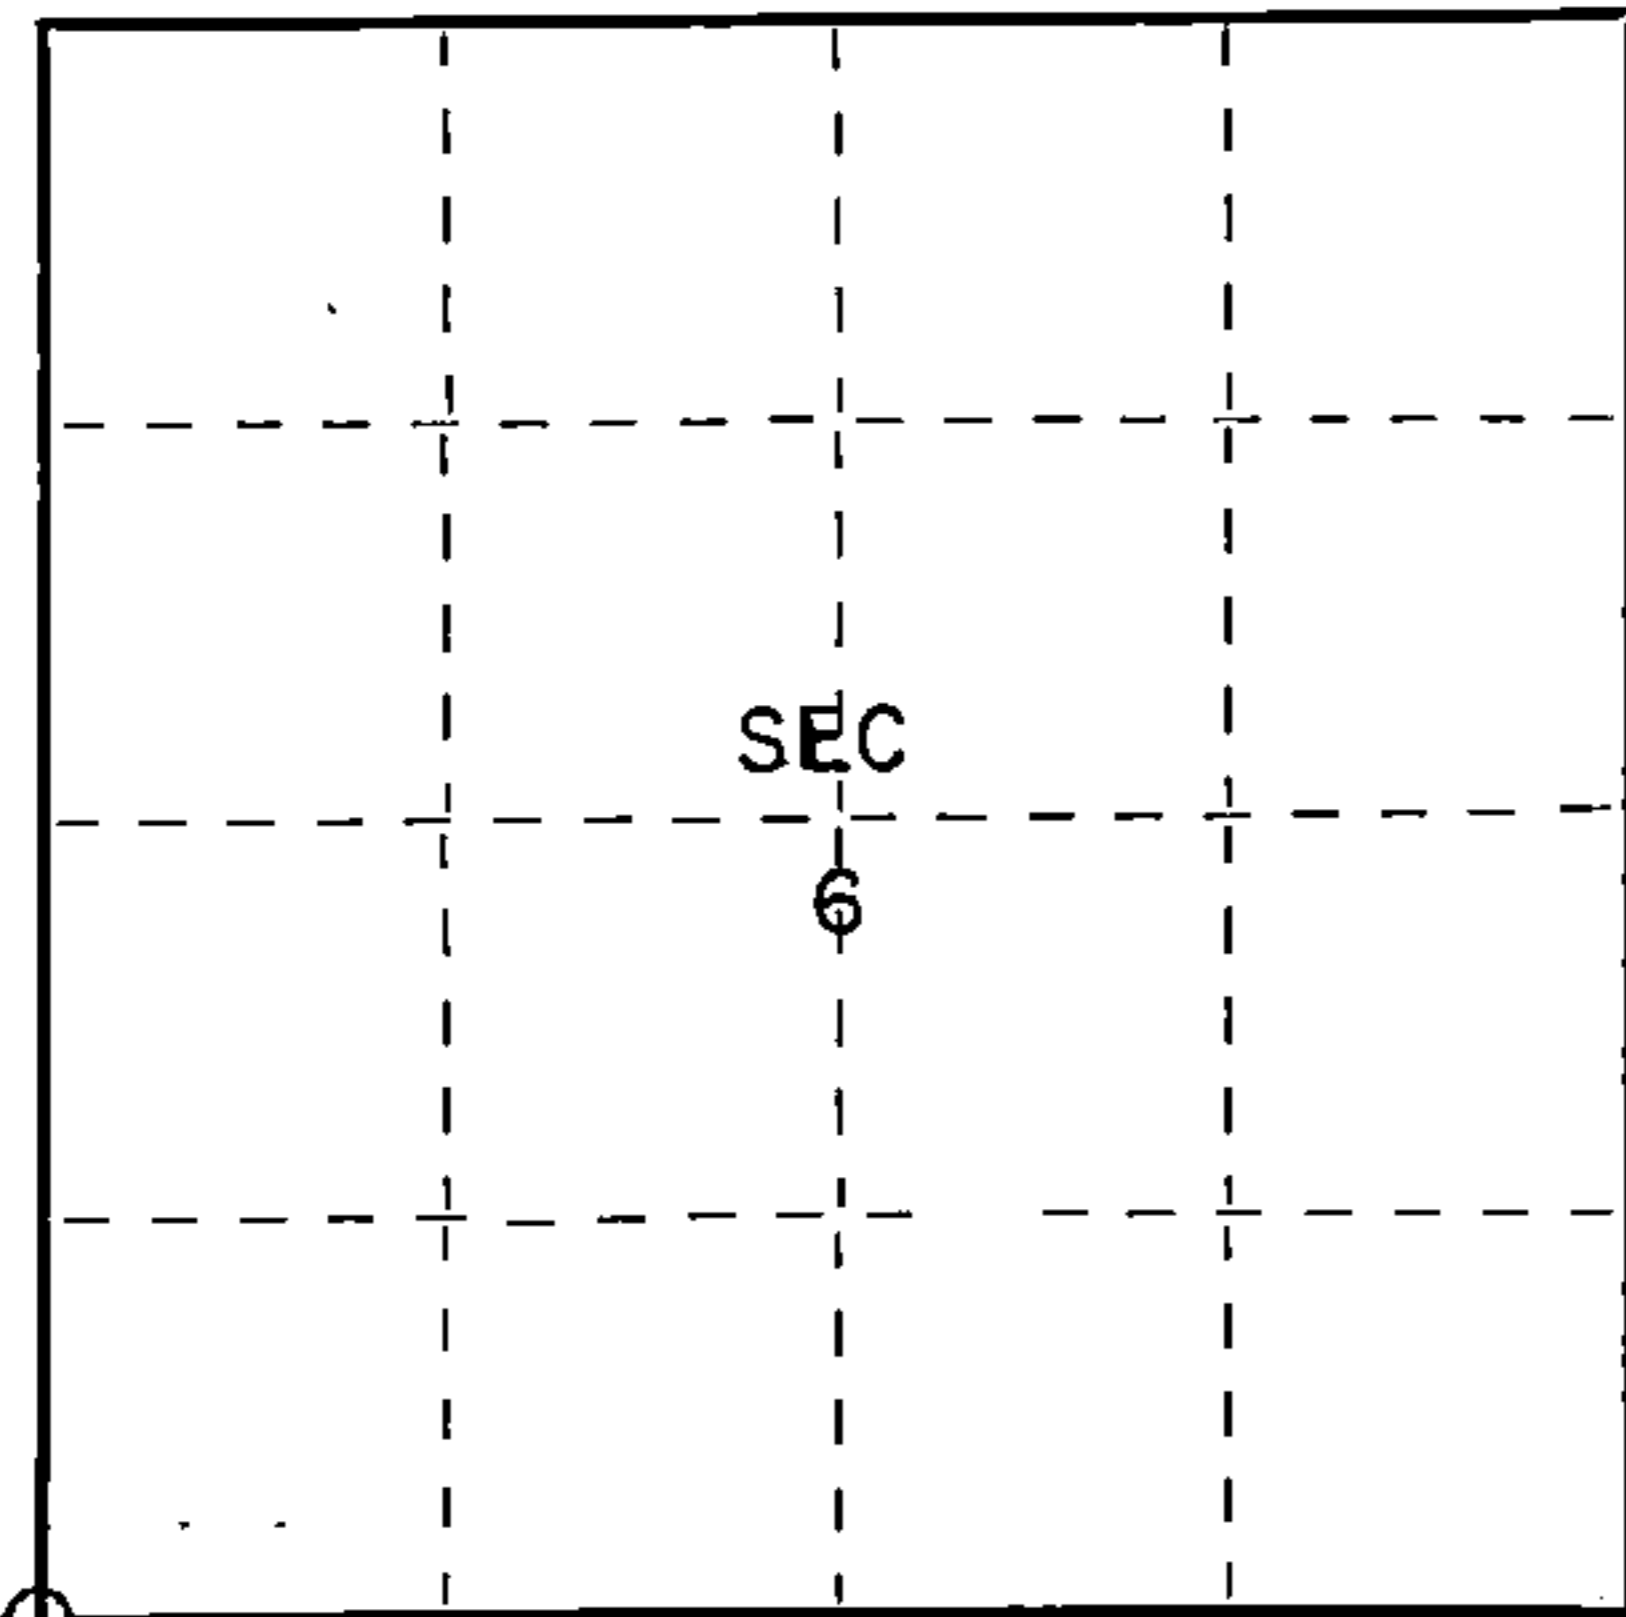

○ = Corner monument restored.

Dated at Grandon, Wis., this 30th day of October, 19 75.

Signature Thomas R. Arnott Title Land Surveyor Registration No. S-887  
(County Surveyor, Registered Land Surveyor, or other duly authorized official)

Office of Register of Deeds, County of Forest, I hereby certify that the within instrument was filed in this office for record on the 30th day of October, 19 75 at 3 o'clock P. M.

Eugene Statelyny Document Number 108120  
(Register of Deeds)

By \_\_\_\_\_ Deputy

43512010000