

CERTIFIED LAND CORNER RESTORATION

Index No. E-22


State of Wisconsin }
County of Forest } ss.

I Philip T. Hansen, do hereby certify that on the 14th day of May, 1979, I found established evidence of the W 1/16 corner of Section 1 and 12 Township 35, North, Range 12 E, Fourth Principal Meridian, as described hereon; and that from this evidence I established a new monument and accessories as described hereon to perpetuate the original location of this corner.


Resident witnesses:

Glen Barker

Jim Claflin

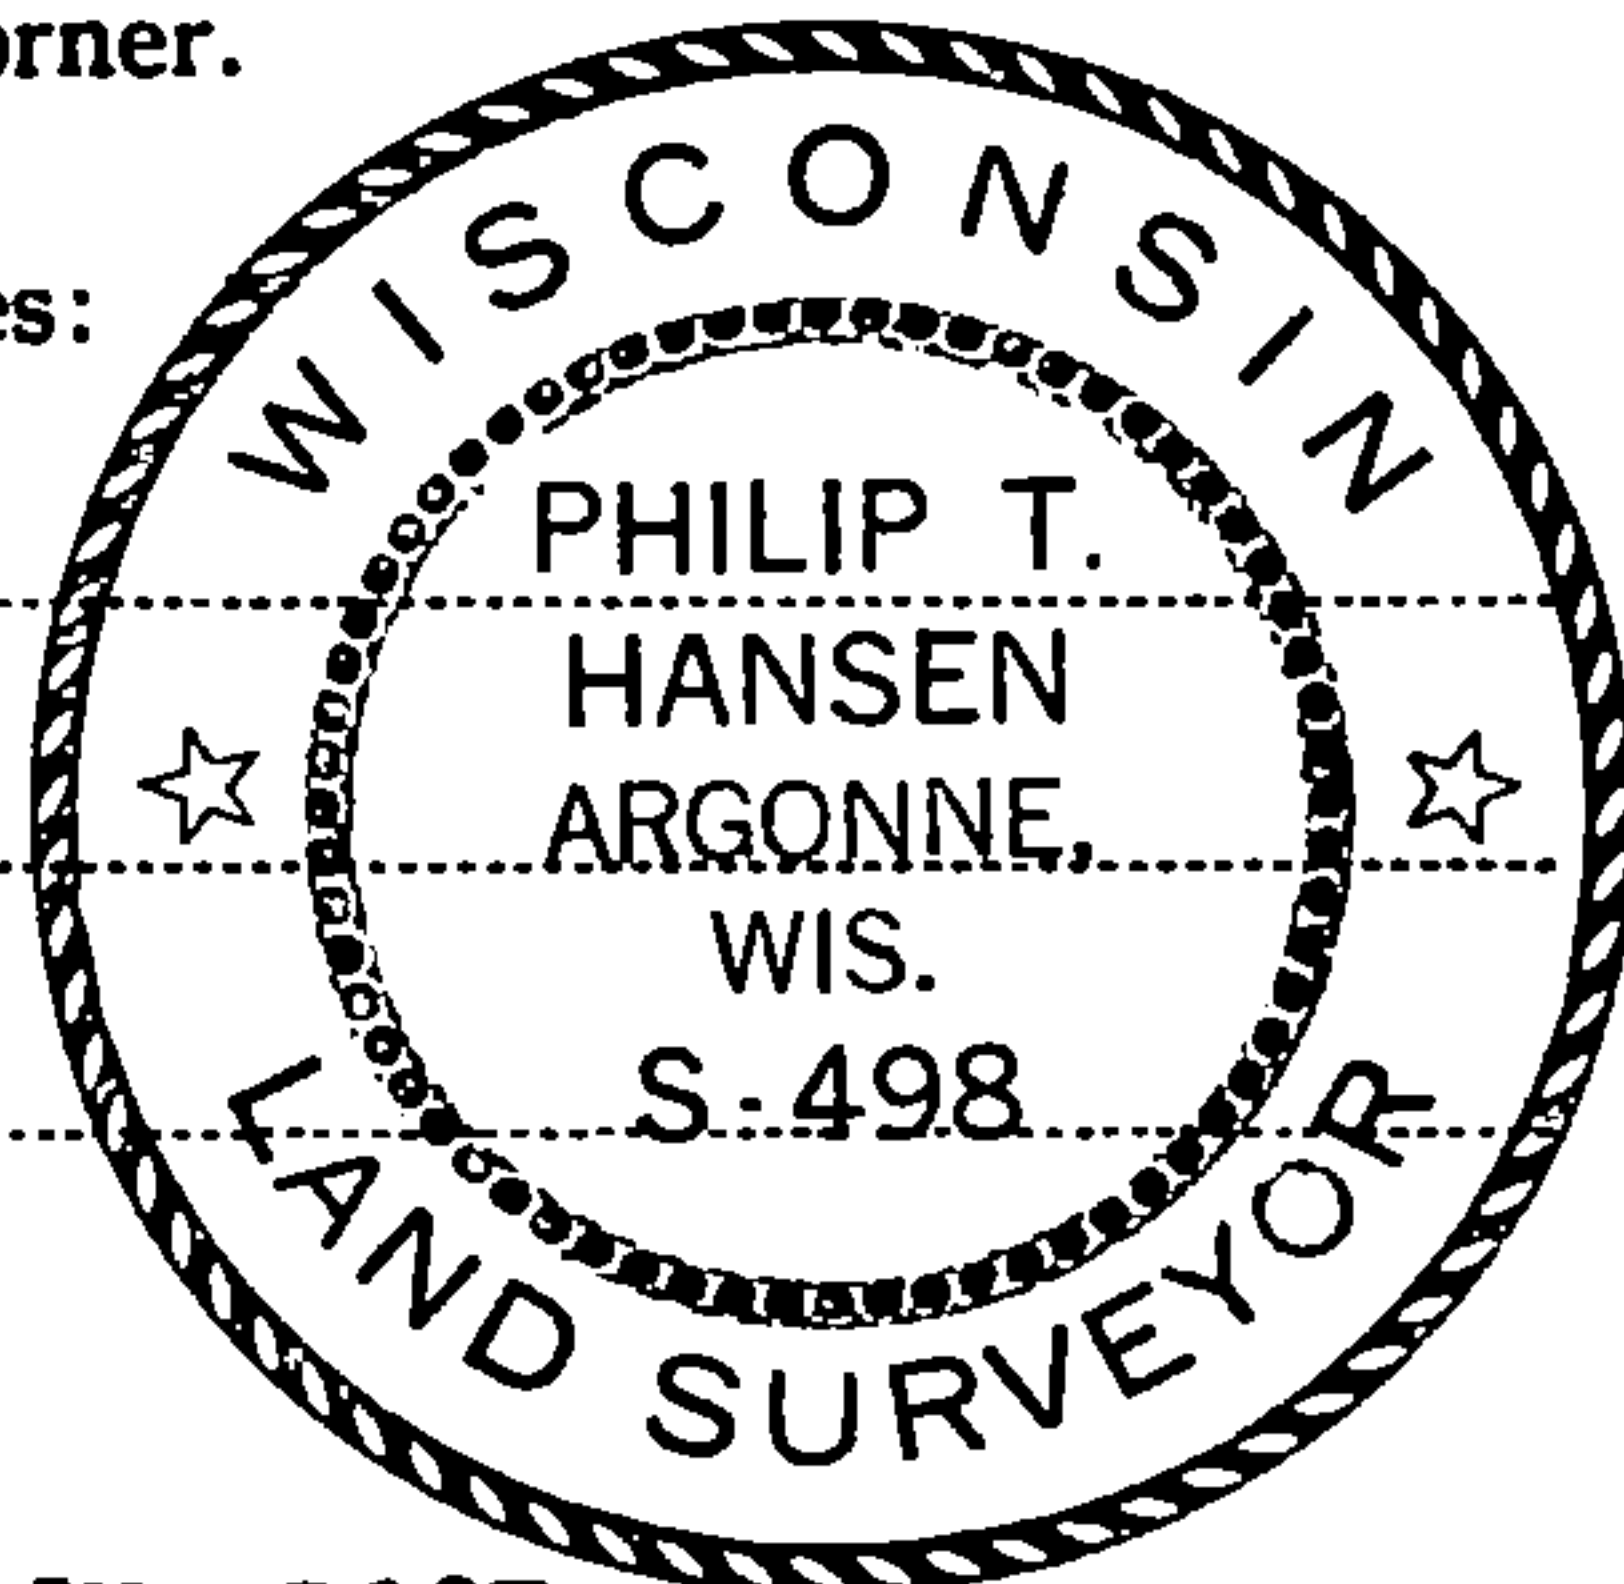

FORM 985 Wisconsin Geological Survey Co. Madison, Wisconsin

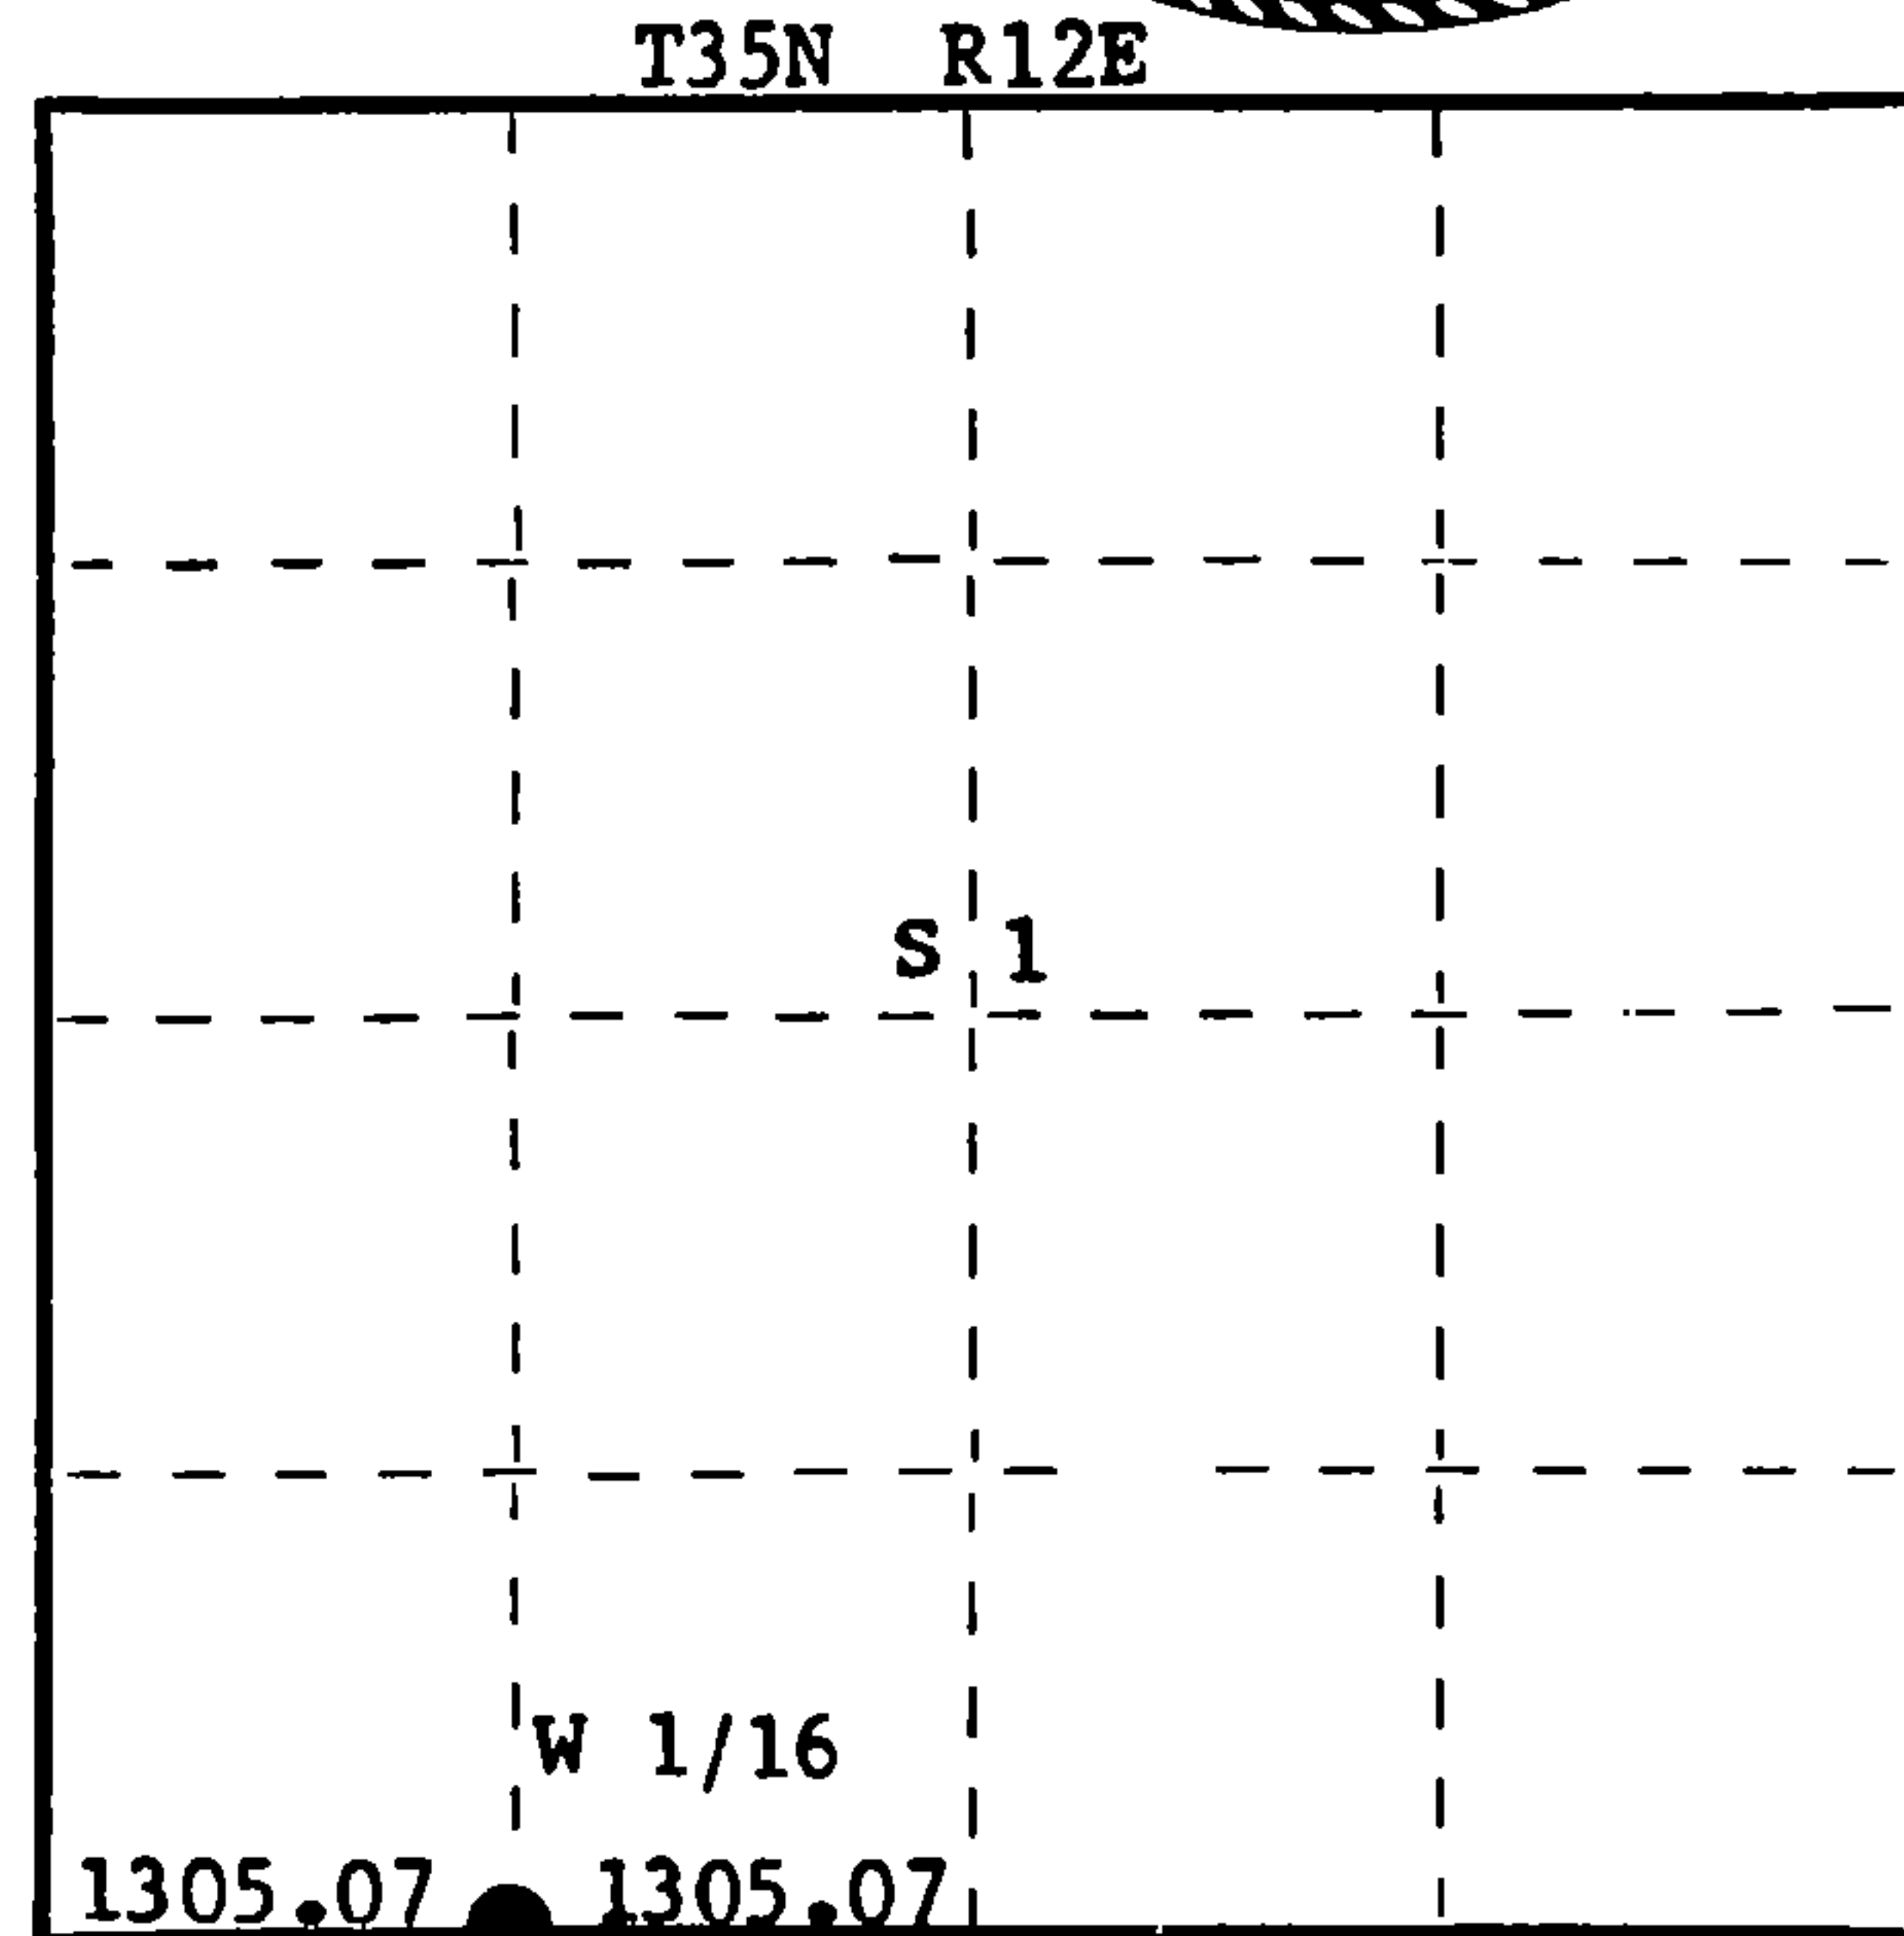

○ = Corner monument restored.

History of original corner establishment:

No records of any previous survey.

Description of corner evidence found:

No evidence of any corner recovered.

Corner established by traverse and computation. Ran traverse from previously established 1/4 corner between section 1 and 12 to section corner 1, 2, 11 and 12. Computed bearing S 88° 16' 06" E at 2610.14 feet. Set W 1/16 corner at 1305.07 feet intermediate.

Description of monument and accessories I established to perpetuate the original location of this corner.

Drove a surveyor's spike in centerline of Lemke Road for true corner.

Set a 1-1/2" iron pipe with 2" brass cap for witness corner, S45°W 40 feet.

Monument projects 24" above ground - cap stamped:

NBO - Power Pole #35-12 1L11 N84°E 111.26 feet

No other trees for BT's available.

S498
T35N R12E
W 1/16 S + 1 W.C.
S 12
N 45° E 40'

Dated at Rhineland, Wis., this 29th day of May, 19 79

Signature Philip T. Hansen Title Registered Land Surveyor Registration No. S-498
(County Surveyor, Registered Land Surveyor, or other duly authorized official)

Office of Register of Deeds, County of Forest, I hereby certify that the within instrument was filed in this office for record on the 13th day of November, 19 79 at 8:30 o'clock A. M.

Eugene Staszny
(Register of Deeds)

By _____ Deputy

DOCUMENT NO. **117074**

43512010030