

CERTIFIED LAND CORNER RESTORATION

Index No. E-17

State of Wisconsin }  
County of Forest } ss.


I Philip T. Hansen, do hereby certify that on the 4th day of April, 1976, I found evidence of the Section corner of S 2 - 3 - 10 - 11 Township 35, North, Range 12 East, Fourth Principal Meridian, as described hereon; and that from this evidence I established a new monument and accessories as described hereon to perpetuate the original location of this corner.

Resident witnesses:


Glen Barker

Jim Claflin

Herb Wagoner

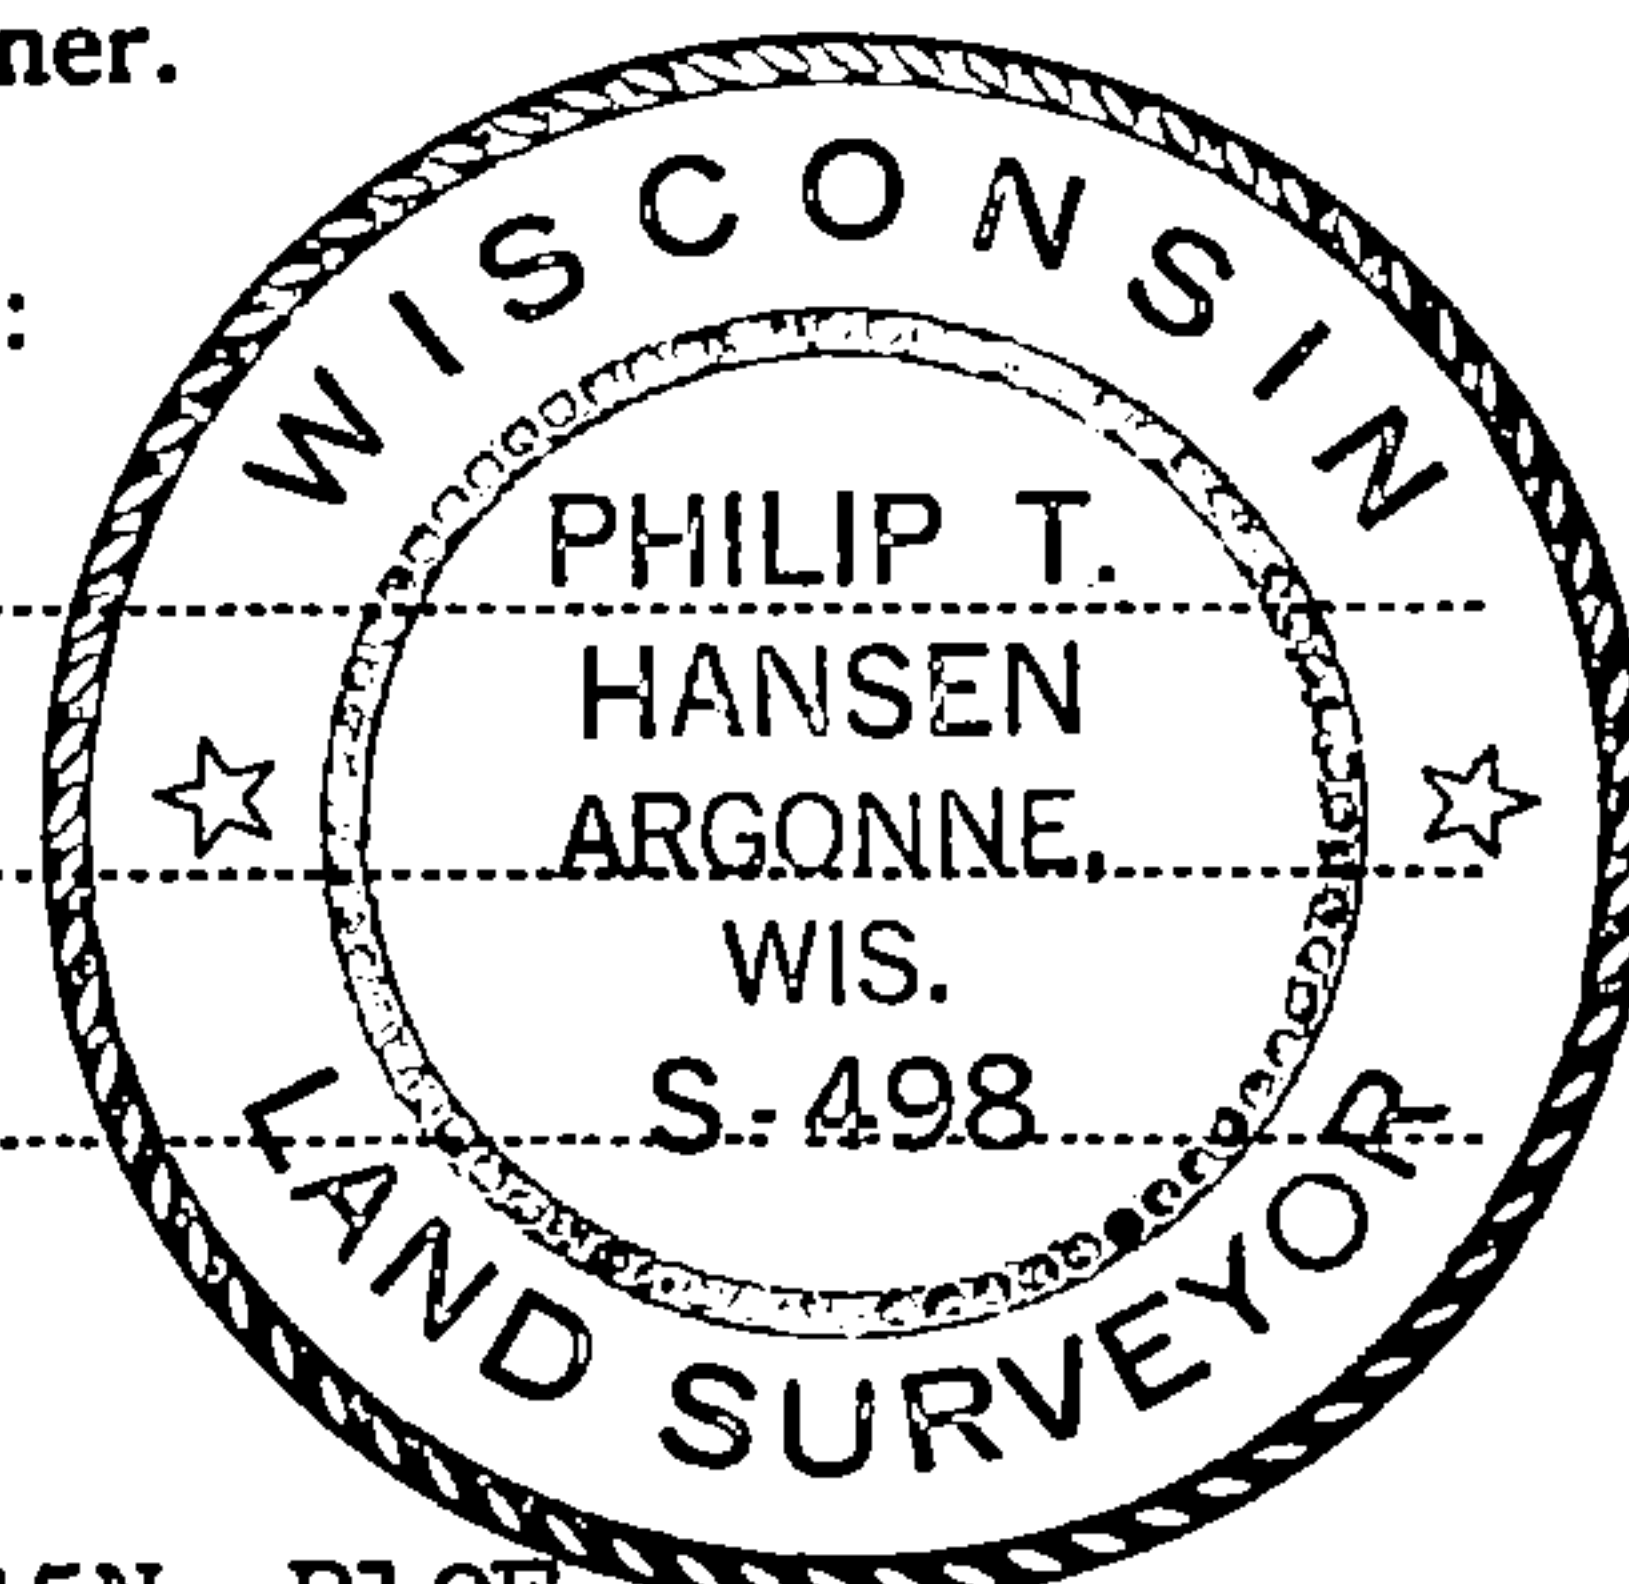

T35N R12E

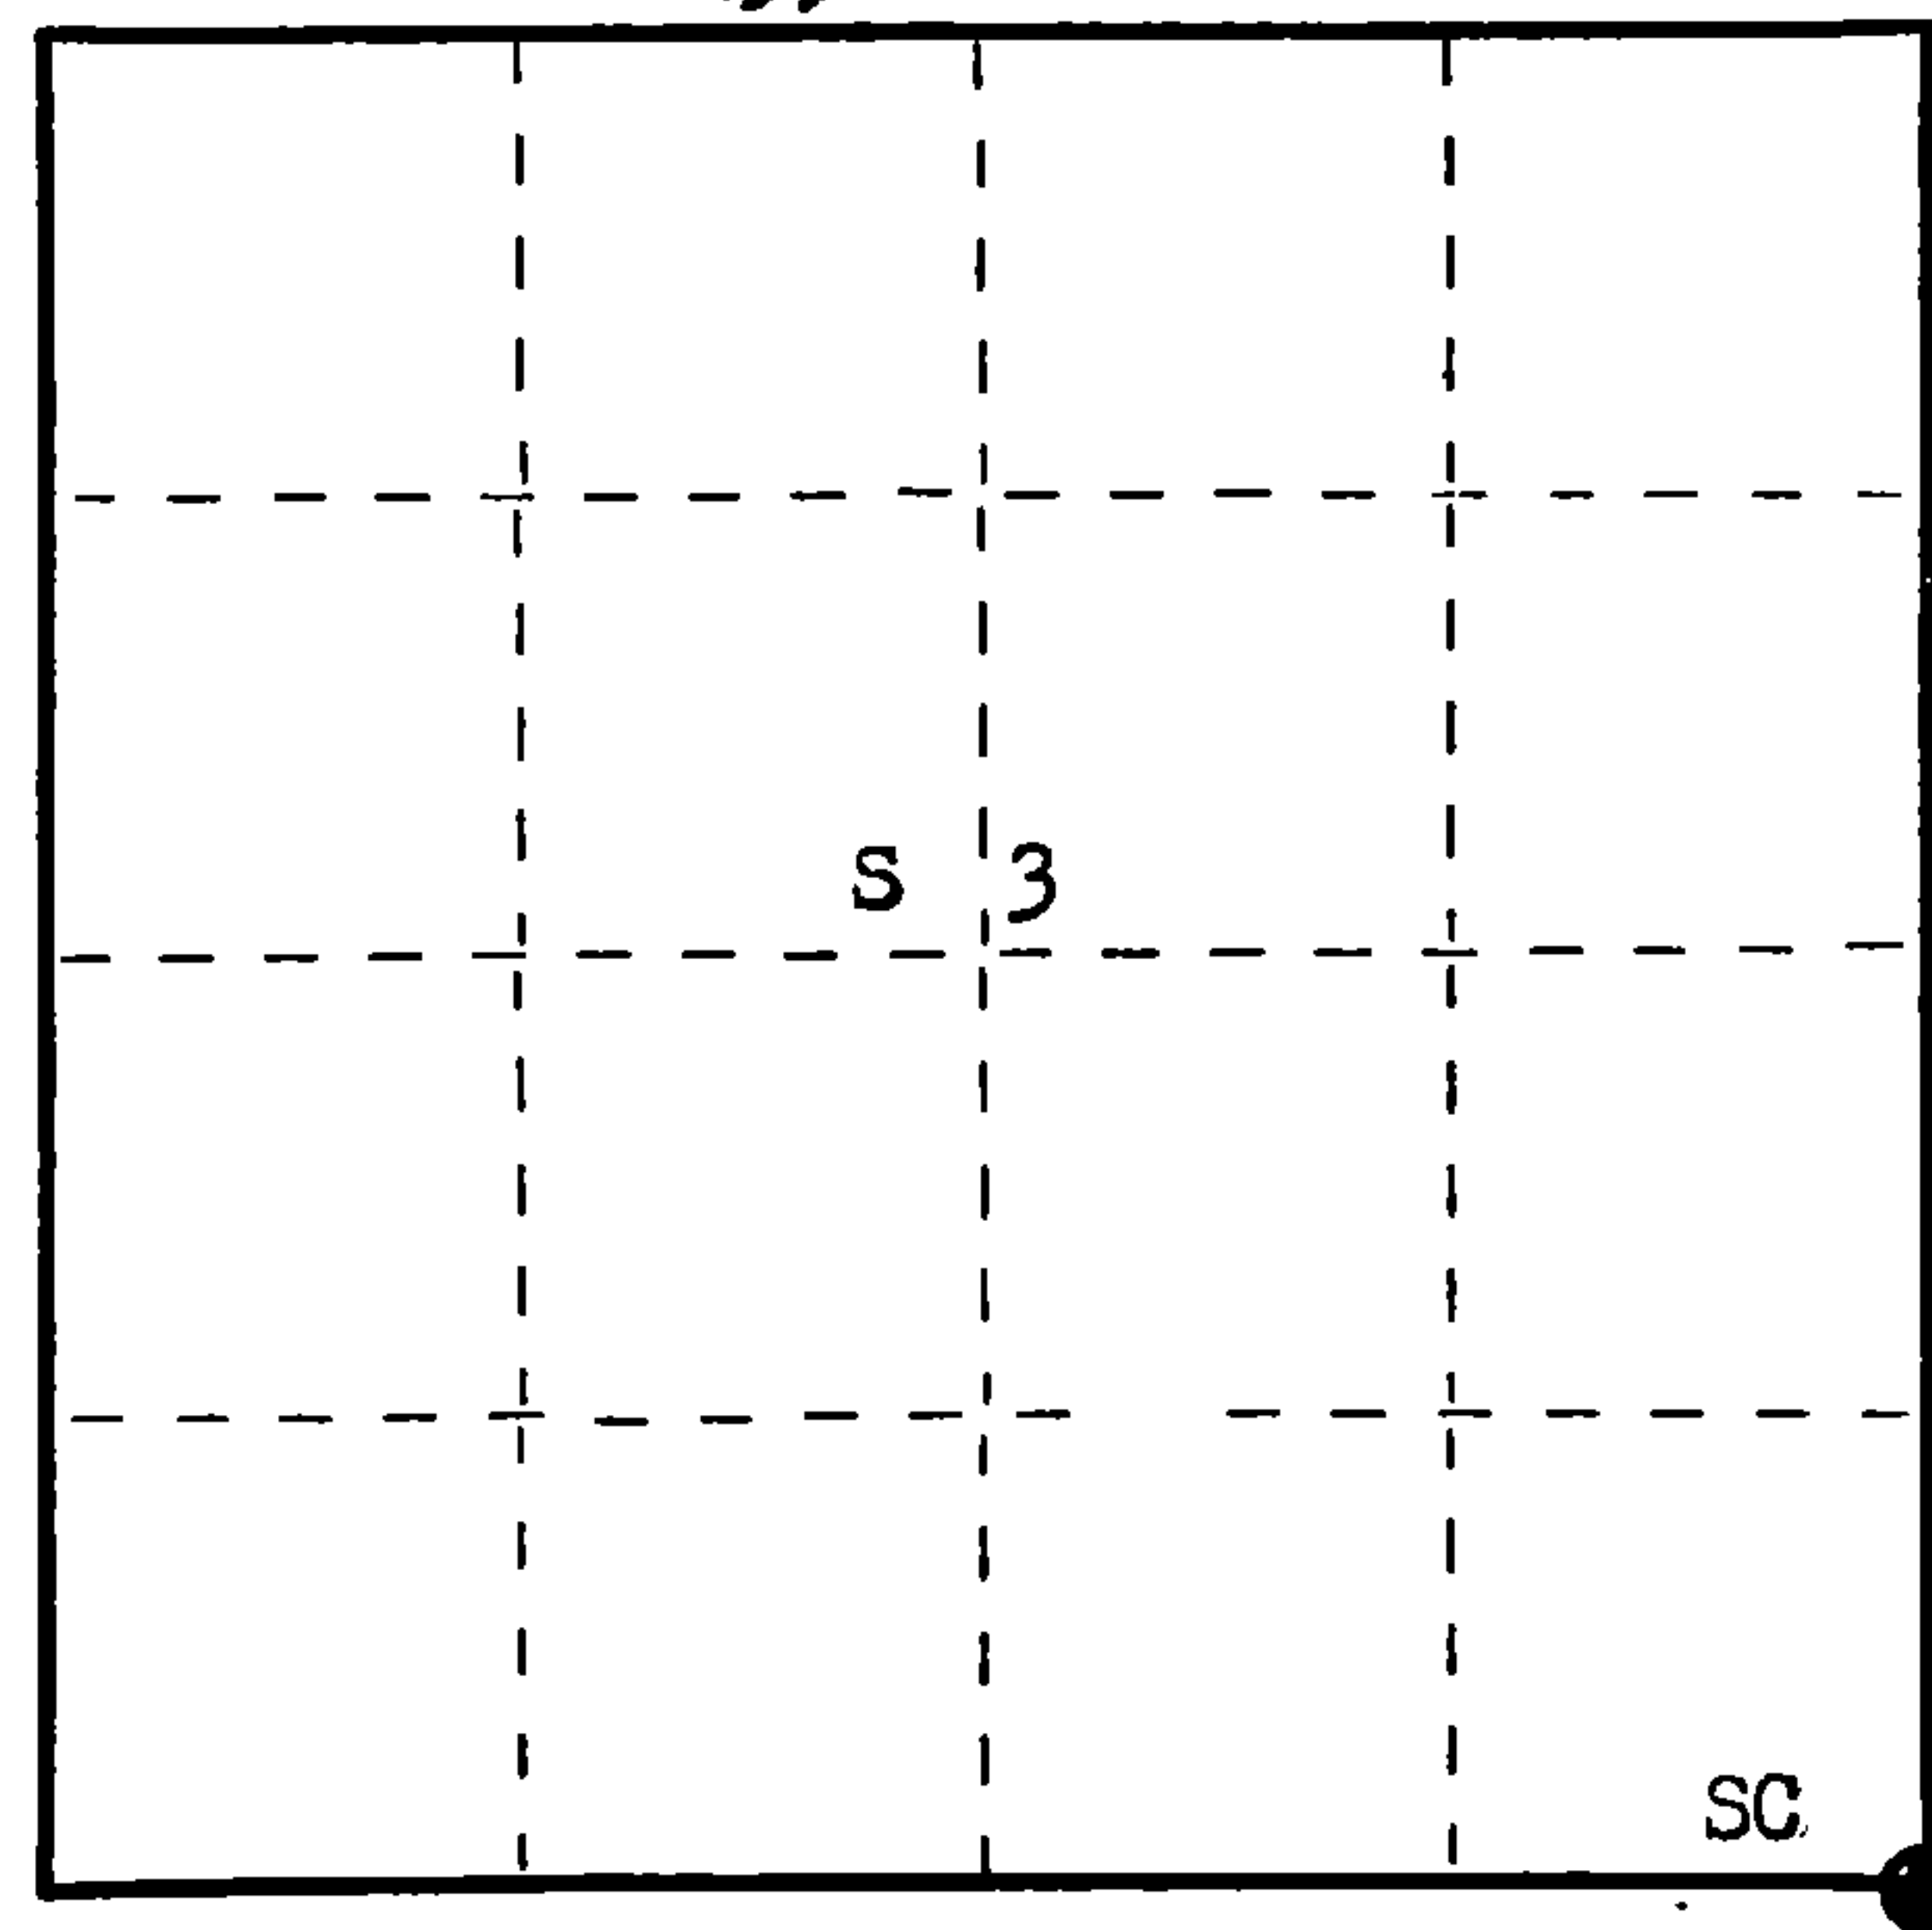

○ = Corner monument restored.

History of original corner establishment: Original corner established by J.L. Nowlin, Deputy Surveyor, in 1860, from which Birch 18" bears N11°W 20 lks and Birch 12" bears N48°E 35 lks.

Description of corner evidence found: Recovered corner post of an old N-S and E-W fence line. The post had broken off at ground level. Extracted the remains of post from the ground.

Recovered OBT. Aspen 18" S40°E 25.5 lks, scribed 11 BT. Scribe marks were under 6" of growth. No records available on this BT.

Corner has been recognized for many years by local land owners.

Description of monument and accessories I established to perpetuate the original location of this corner. Replaced old post with 2 1/2" Berntsen A-1 Federal Monument, cap stamped. Pipe projects 12" above ground level.

NBTs - Sugar 8" N23°E 26 lks, scribed SC BT.  
Sugar 7" S65°E 87 lks, scribed SC BT.  
Sugar 6" S41°W 23 lks, scribed SC BT.

T35N R12E  
Sec. 3 | 2  
10 | 11  
S498 1976

Monument and BTs painted blue.

Dated at Rhineland, Wis., this 24th day of May, 1976

Signature Philip T. Hansen Title Registered Land Surveyor Registration No. S-498  
(County Surveyor, Registered Land Surveyor, or other duly authorized official)

Office of Register of Deeds, County of Forest, I hereby certify that the within instrument was filed in this office for record on the 9th day of June, 1976 at 3:30 o'clock P. M.

Eugene Staszny  
(Register of Deeds)

By \_\_\_\_\_ Deputy

DOCUMENT NUMBER ----- **109396**

FORM 985

4351203000