

CERTIFIED LAND CORNER RESTORATION

Index No. E-15

State of Wisconsin }  
County of Forest } ss.


I Philip T. Hansen, do hereby certify that on the 14th day of June, 1976, I found evidence of the Quarter corner of Sec. 3 and 10 Township 35, North, Range 12 East, Fourth Principal Meridian, as described hereon; and that from this evidence I established a new monument and accessories as described hereon to perpetuate the original location of this corner.

Resident witnesses:


Glen Barker

Jim Claflin

Herb Wagoner

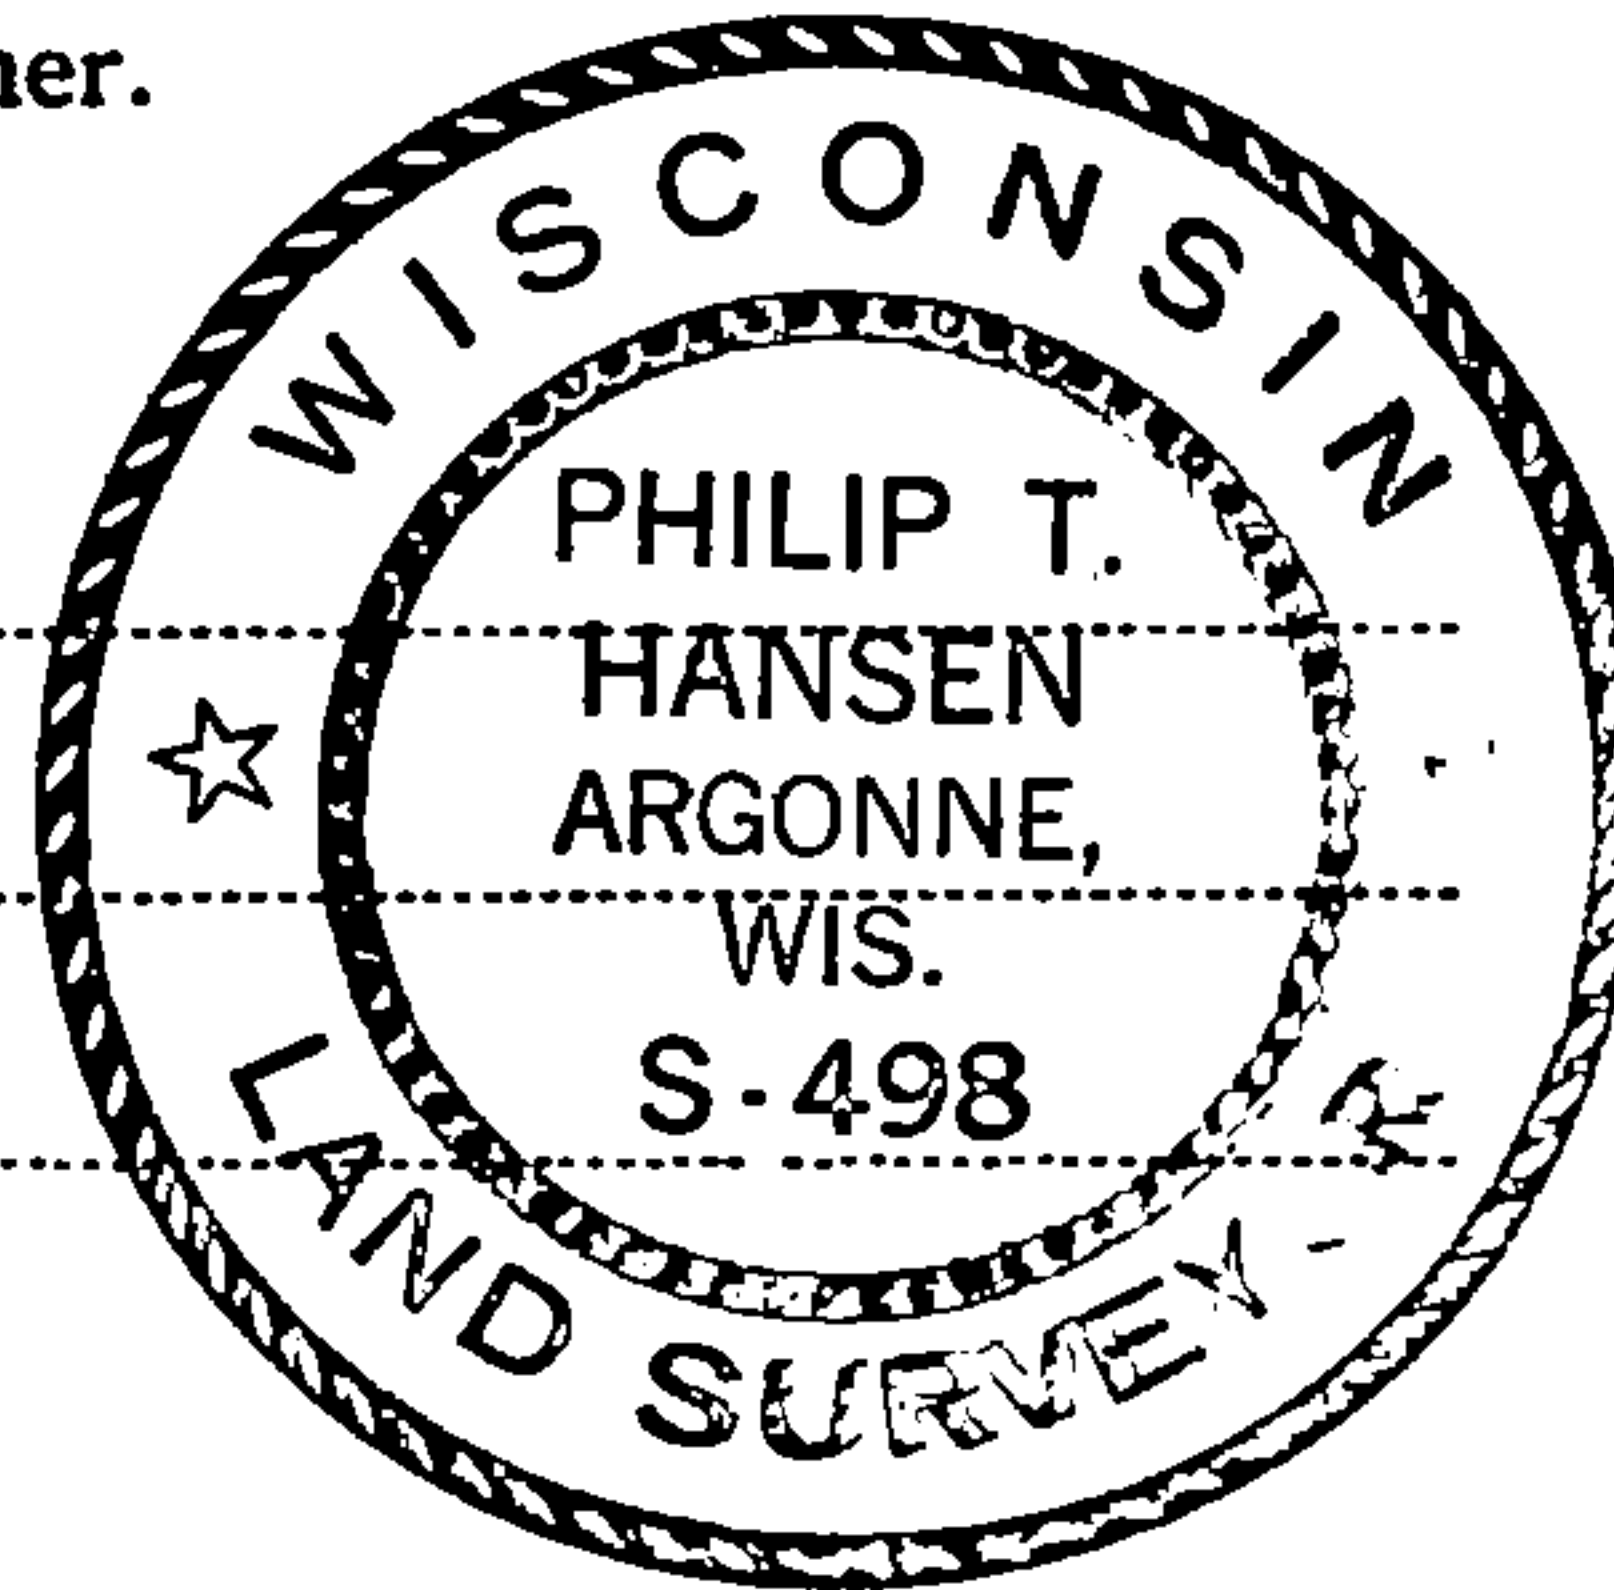

FORM 985  
Wisconsin Surveying & Mapping Co.  
Madison, Wisconsin

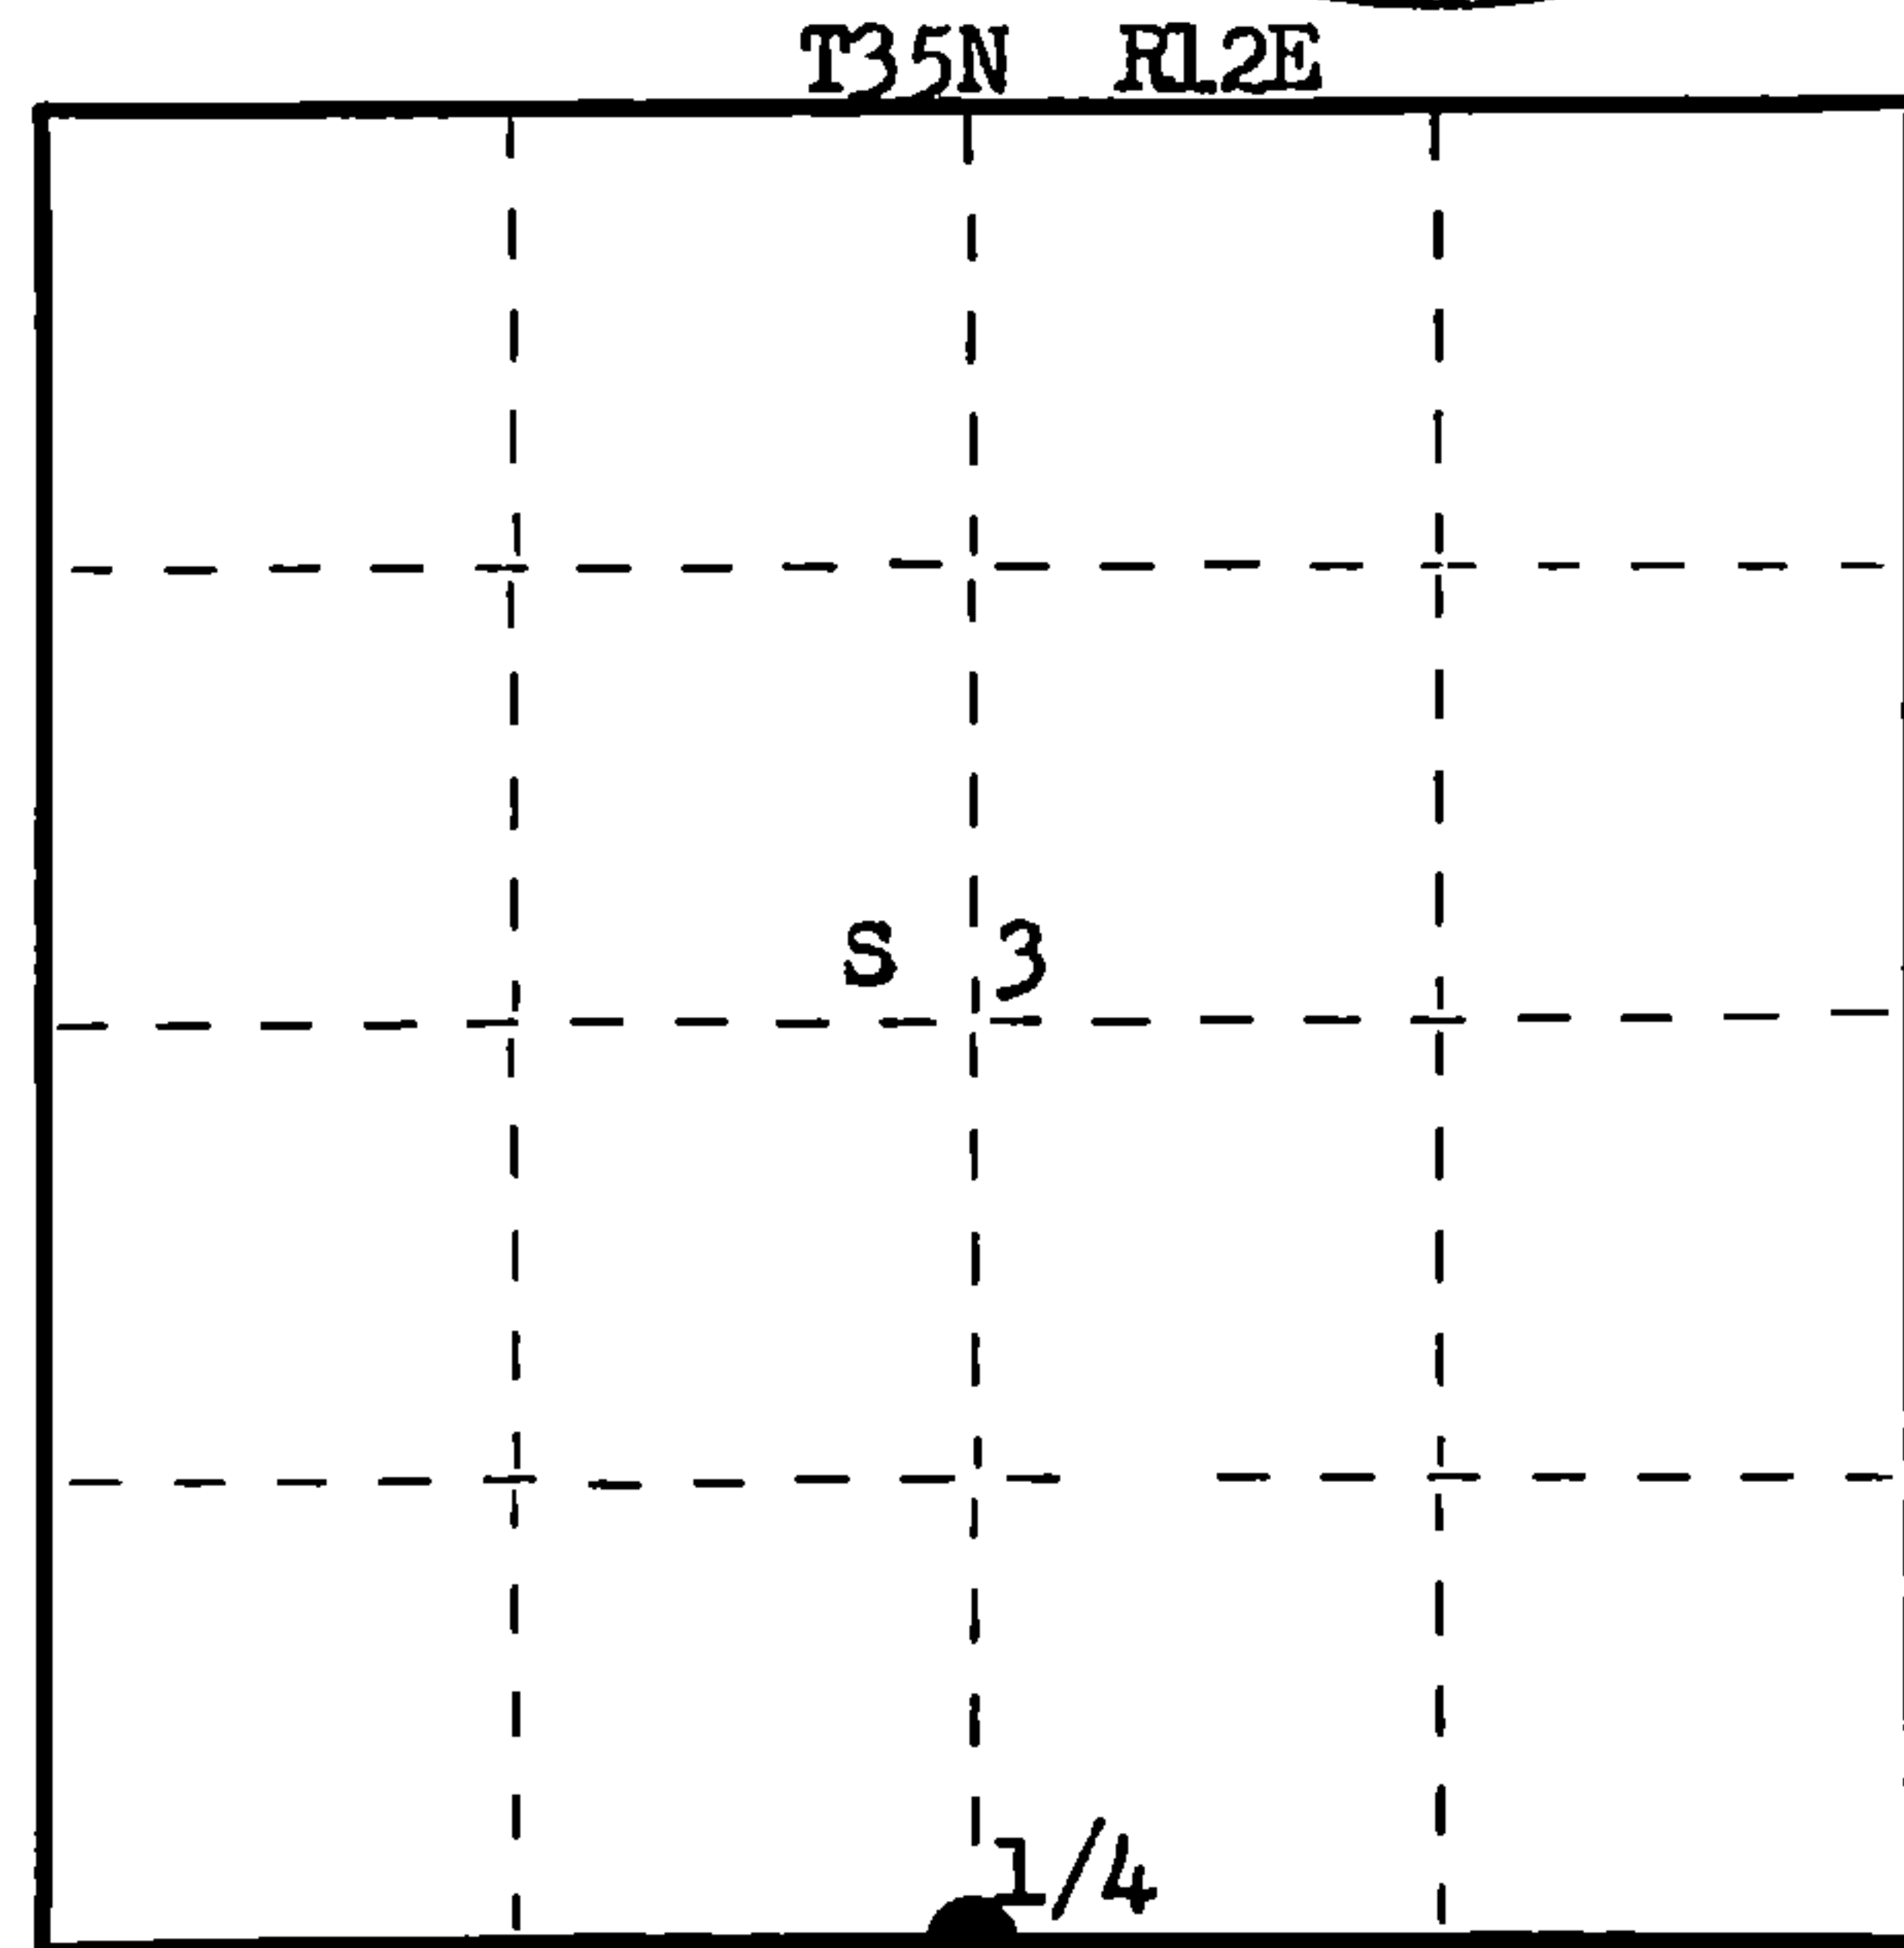

○ = Corner monument restored.

History of original corner establishment:

Original corner established by J.L. Jolwin, Deputy Surveyor, in 1860, from which Birch 30" bears N 54° E 26 lks and Birch 20" bears S 13° W 52 lks. No record of any subsequent surveys or recoveries.

Description of corner evidence found:

At original distance, South along Westimeyer Road, an old rock fence runs East and an old fence line runs West. This has been accepted as the Quarter corner by local and adjacent landowners for many years.

Description of monument and accessories I established to perpetuate the original location of this corner.

Set a 1 1/2" x 18" iron pipe 4" below surface at the intersection of Centerline of Westimeyer Road and the East-West fence lines. Set a 2 1/2" Berntsen A-1 Federal monument for Witness Corner West 50 lks. Monument projects 18 inches above ground. Cap stamped.

NBTs - Sugar 8" N 54° W 132 lks., scribed 1/4 BT.  
Sugar 14" S 44° E 111 lks., scribed 1/4 BT.  
Measurements and bearings to true corner.  
Pipe and BTs - painted blue.

T35N R12E  
1/4 S 3/10 W.C.  
E 50 lks. to Cor.  
S498 1976

Dated at Rhineland, Wis., this 21st day of June, 1976.

Signature Philip T. Hansen Title Registered Land Surveyor Registration No. S-498  
(County Surveyor, Registered Land Surveyor, or other duly authorized official)

Office of Register of Deeds, County of Forest, I hereby certify that the within instrument was filed in this office for record on the 22ND day of June, 1976 at 3:45 o'clock P. M.

Eugene Stutzman  
(Register of Deeds)  
Deputy

DOCUMENT NUMBER

**109498**

43512030020