

CERTIFIED LAND CORNER RESTORATION

Index No. D-15

State of Wisconsin }
County of Forest } ss.

I Philip T. Hansen, do hereby certify that on the 14th day of October, 1977, I found established evidence of the SC 1/16 corner of Section 3 Township 35 North, Range 12 East, Fourth Principal Meridian, as described hereon; and that from this evidence I established a new monument and accessories as described hereon to perpetuate the original location of this corner.


Resident witnesses:

Glen Barker

Herb Wagoner



FORM 985 H. C. MILLER CO., MILWAUKEE

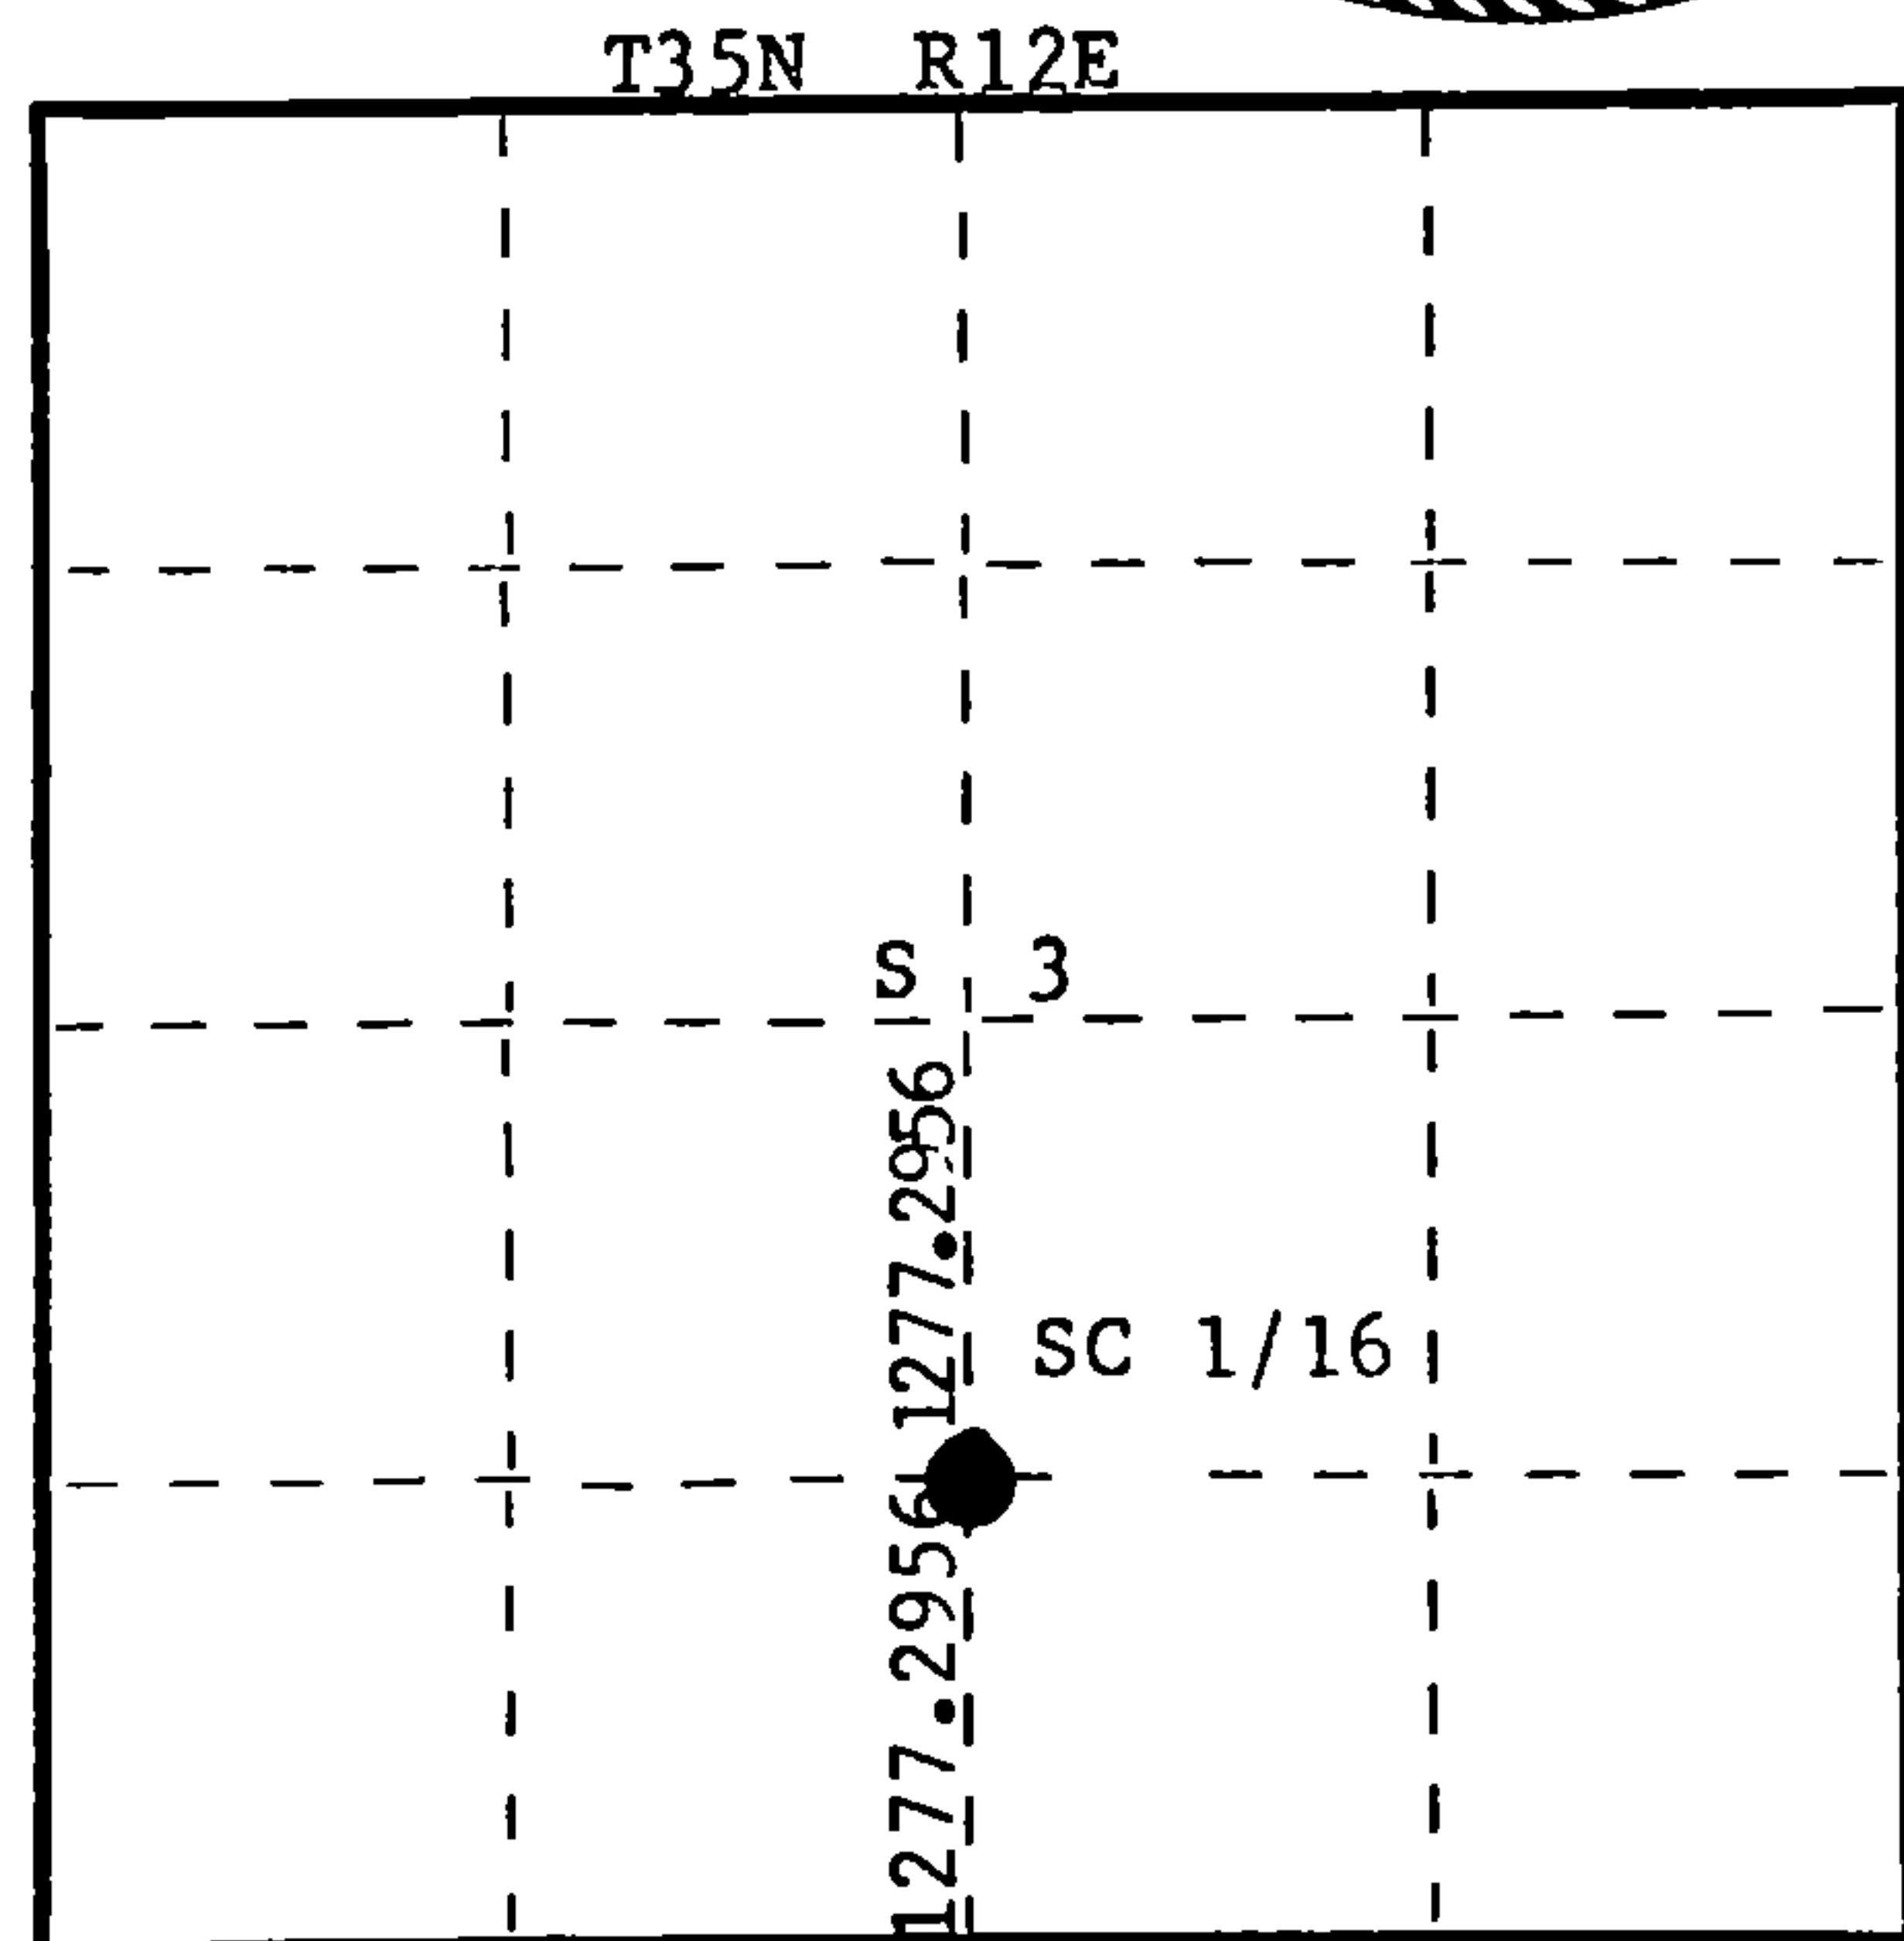

○ = Corner monument restored.

History of original corner establishment:

No records of any previous survey.

Description of corner evidence found:

No evidence of any corner recovered.

Corner established by traverse and computation, subdivision of section. From previously established C 1/4 corner and S 1/4 corner set SC 1/16 at 1277.2956 ft. intermediate at bearing S2° 55' 17" E.

Description of monument and accessories I established to perpetuate the original location of this corner.

Set 1 1/2" x 18" iron pipe, 2 ft. east of centerline of Westimeyer Road for true corner, 4" below surface.

Set 1 1/2" iron pipe with 2" brass cap 45 links east for witness corner. Monument projects 24" above ground. Cap stamped:

Marked NBTs from true corner:

Sugar 8" N52°W, 71.8 links, scribed 1/16 BT.

Sugar 6" S65°W, 51.9 links, scribed 1/16 BT.

S498

T35N R12E

SC 1/16 S +³ W.C.

W 45 lks.

1977

Dated at Rhinelander, Wis., this 17th day of October, 1977

Signature Philip T. Hansen Title Registered Land Surveyor Registration No. S-498
(County Surveyor, Registered Land Surveyor, or other duly authorized official)

Office of Register of Deeds, County of Forest, I hereby certify that the within instrument was filed in this office for record on the 20th day of October, 1977 at 4:20 o'clock P. M.

DOCUMENT NUMBER

112606

EUGENE STATEZNY

(Register of Deeds)

By Lillian Schmidt Deputy

43512031020