

CERTIFIED LAND CORNER RESTORATION

Index No. C-15

State of Wisconsin }  
County of Forest } ss.


I, Philip T. Hansen, do hereby certify that on the 14th day of October, 1977, I ~~found~~ established ~~the~~ C 1/4 corner of Section 3 Township 35, North, Range 12 East, Fourth Principal Meridian, as described hereon; and that from this evidence I established a new monument and accessories as described hereon to perpetuate the original location of this corner.

Resident witnesses:


Glen Barker

Jim Claflin

Herb Wagoner

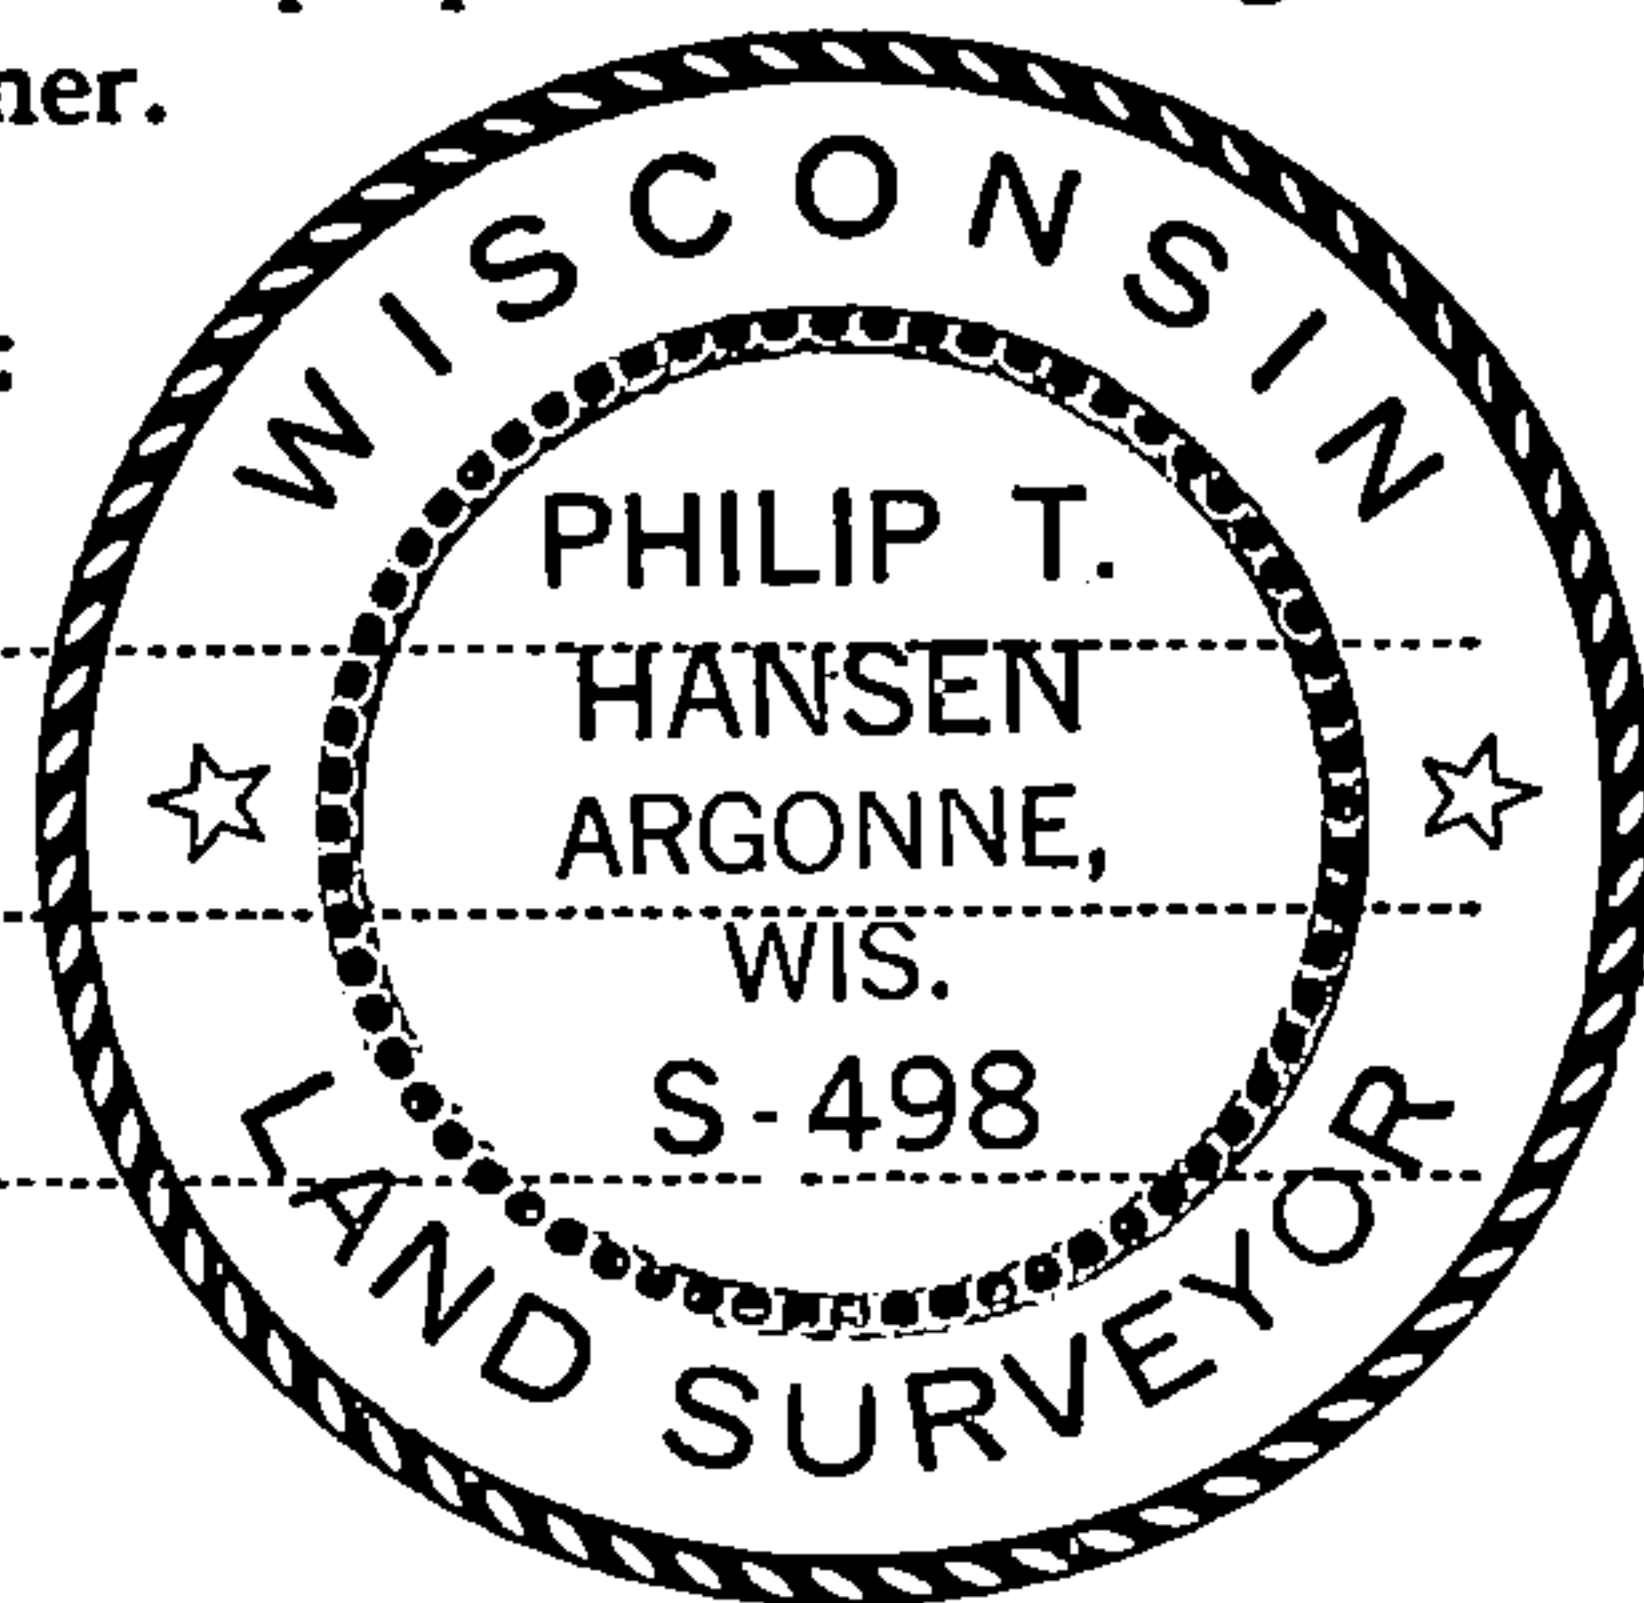

T35N R12E

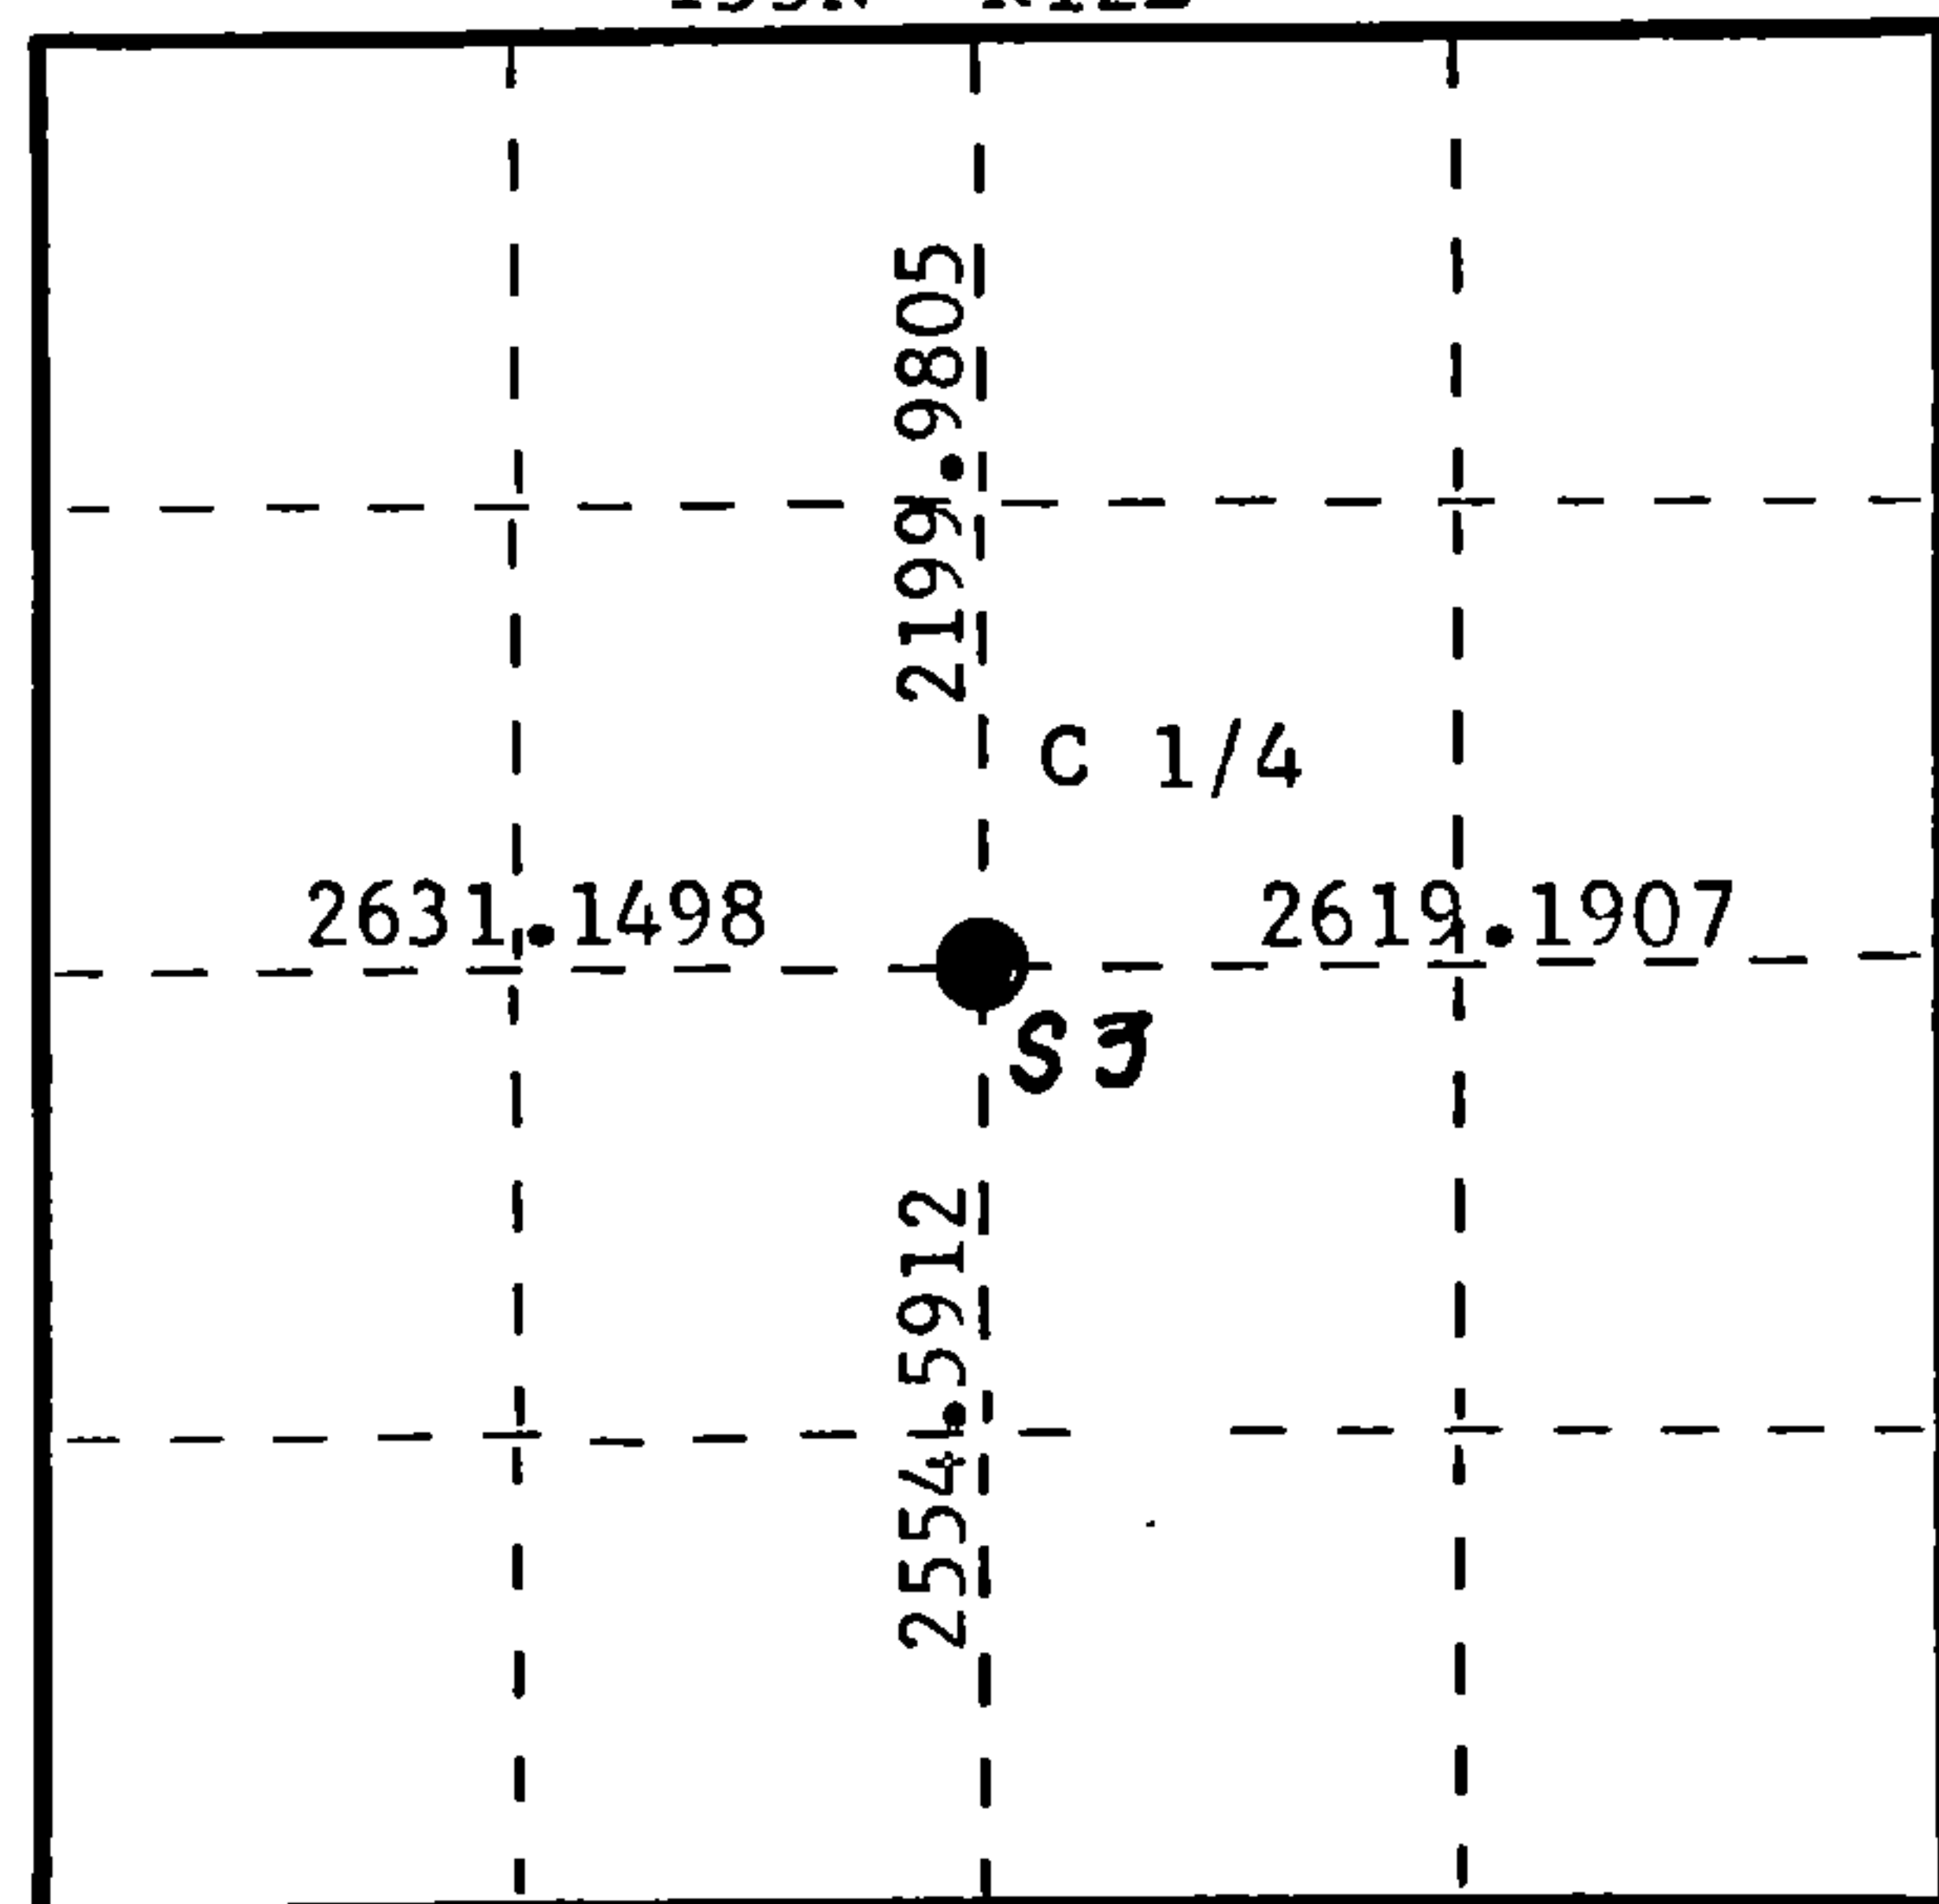

○ = Corner monument restored.

History of original corner establishment:

No records of any previous survey.

Description of corner evidence found:

No evidence of any corner recovered.

Corner established by traverse and computation at 2199.9805 ft. S2° 55' 17" E of N 1/4 corner between Sec. 34 & 3 and 2554.59 ft. N 2° 55' 17" W of S 1/4 corner between Sec. 3 & 10 2619.1907 ft. S 88° 39' 15" W of 1/4 corner between Sec. 2 & 3.

Description of monument and accessories I established to perpetuate the original location of this corner.

Set 1 1/2" x 18" iron pipe on west side of Westimeyer Road for true corner 5" below the surface of road.

Set 1 1/2" iron pipe with 2" brass cap 50 links east of corner for witness corner.

Monument projects 18" above ground. Cap stamped:

Marked NBTs to true corner:

Sugar 7" N62°E, 72.3 links, scribed C 1/4 BT.

Sugar 6" S52°E, 84.2 links, scribed C 1/4 BT.

Sugar 6" S36°E, 102.4 links, scribed C 1/4 BT.

S498  
T35N R12E  
C 1/4 S + 3 W.C.  
E 50 lks.  
1977

Dated at Rhineland, Wis., this 17th day of October, 1977.

Signature Philip T. Hansen Title Registered Land Surveyor Registration No. S-498  
(County Surveyor, Registered Land Surveyor, or other duly authorized official)

Office of Register of Deeds, County of Forest, I hereby certify that the within instrument was filed in this office for record on the 20th day of October, 1977 at 4:20 o'clock P. M.

EUGENE STATEZNY  
(Register of Deeds)

DOCUMENT NUMBER **112604**

By Eileen Schmidt Deputy

FORM 985 H. C. MILLER CO., MILWAUKEE

43512032020