

CERTIFIED LAND CORNER RESTORATION

Index No. B-15

State of Wisconsin }  
County of Forest } ss.

I Philip T. Hansen, do hereby certify that on the 14th day of October, 1977, I ~~found~~ established ~~evidence of the~~ NC 1/16 corner of Section 3 Township 35, North, Range 12 East, Fourth Principal Meridian, as described hereon; and that from this evidence I established a new monument and accessories as described hereon to perpetuate the original location of this corner.

History of original corner establishment:

No records of any previous survey.


Description of corner evidence found:

No evidence of any corner recovered.  
Corner established by traverse and computation by subdivision of section. From previously established C 1/4 corner set NC 1/16 at 1277.2956 at N 2° 55' 07" W, 922.6849 ft. from N 1/4 corner.

Resident witnesses:

Glen Barker

Herb Wagoner

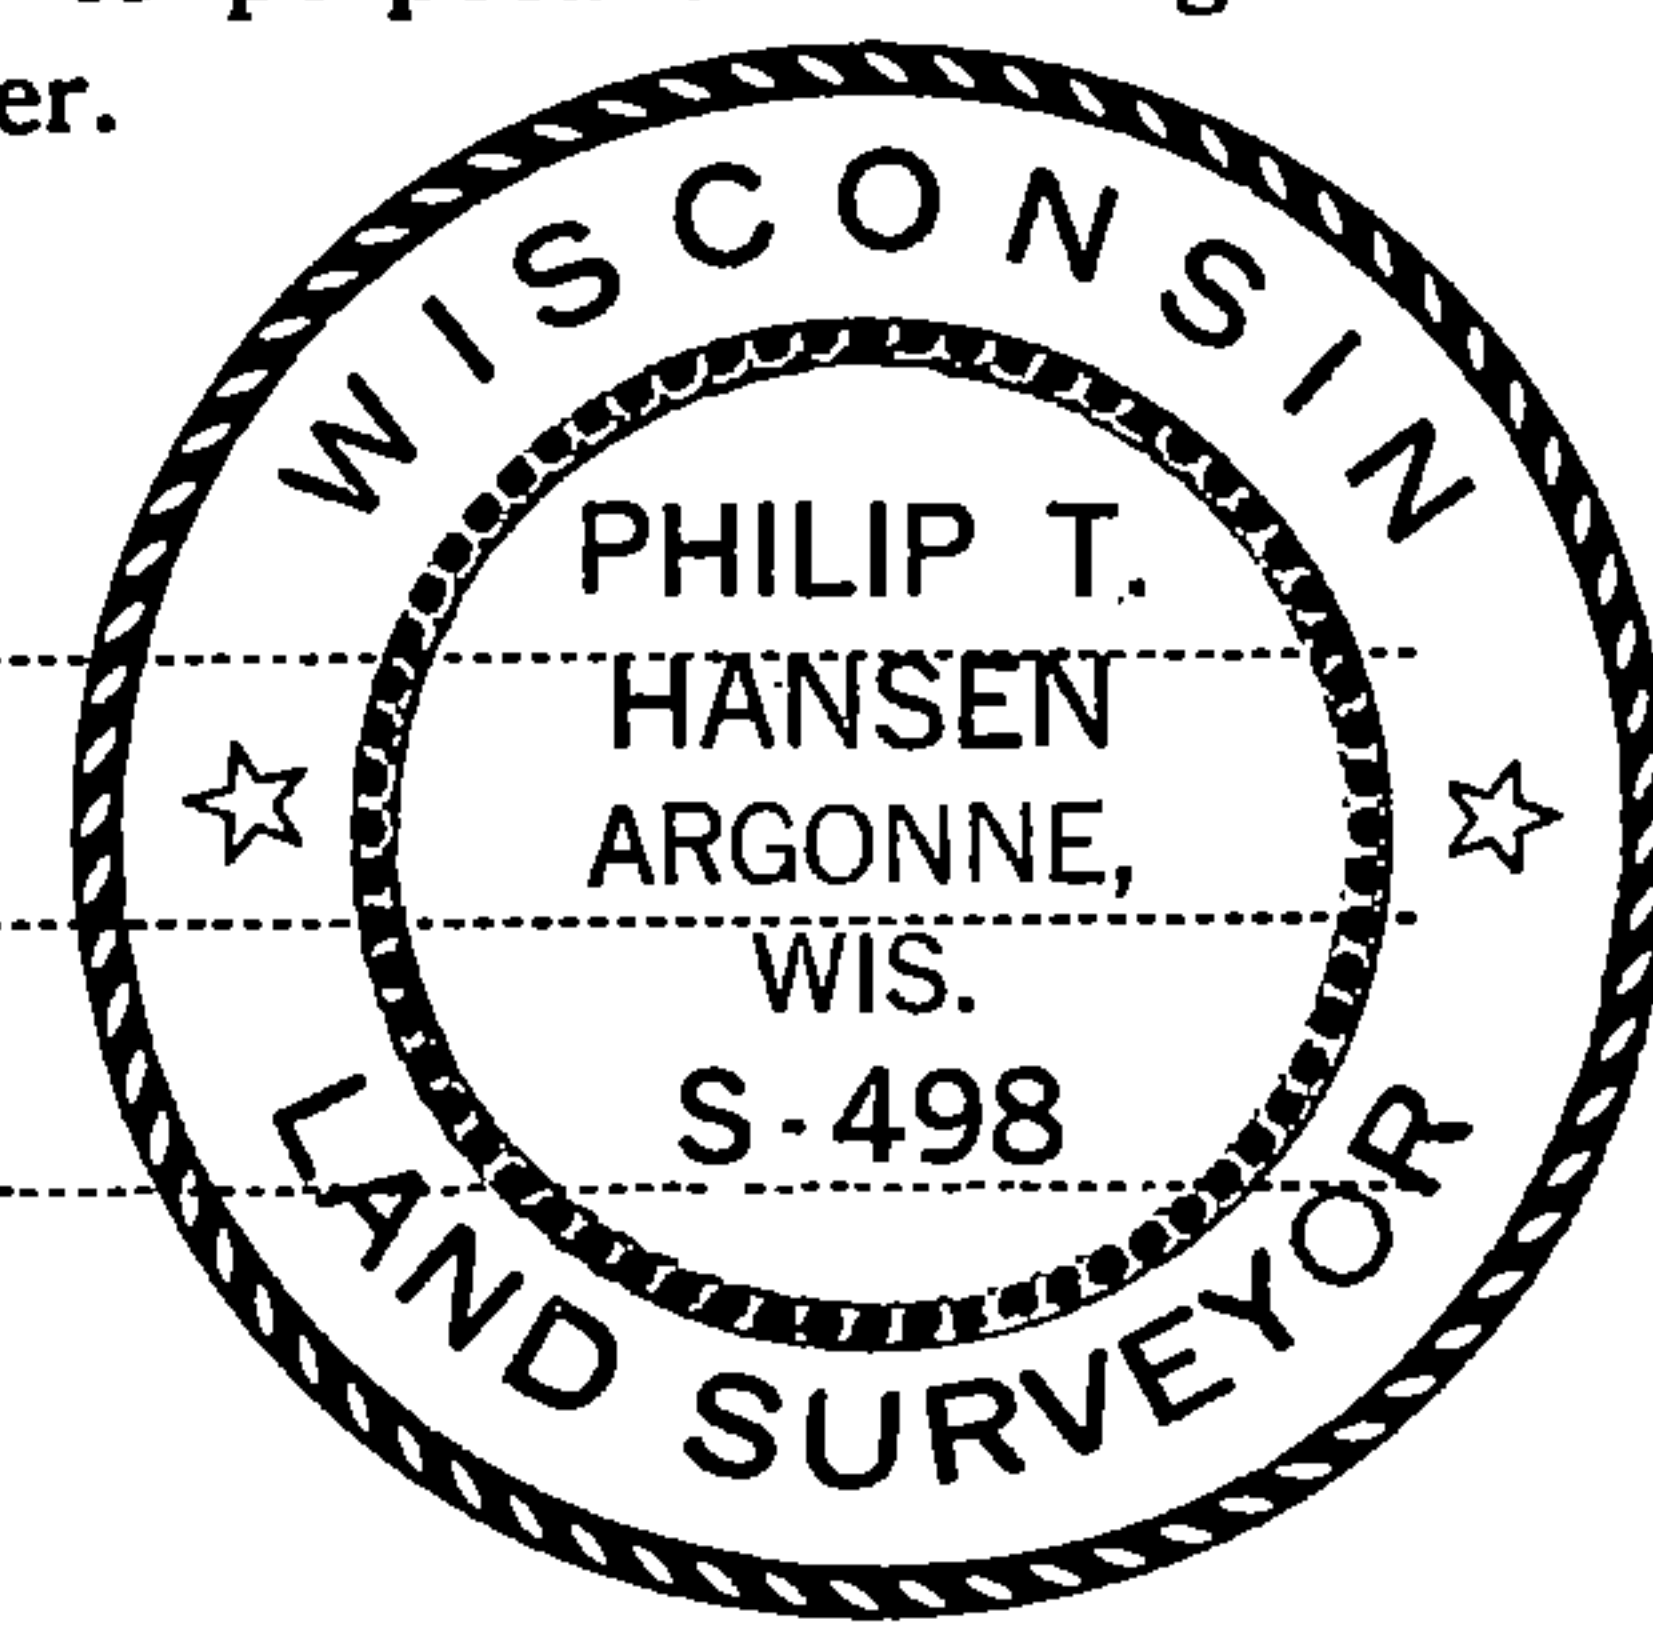

FORM 985 H. C. MILLER CO., MILWAUKEE

Description of monument and accessories I established to perpetuate the original location of this corner.

Drove 1 1/2" x 18" iron pipe in center of Westimeyer Road for true corner 5" below the surface.

Set 1 1/2" iron pipe with 2" brass cap, 50 links west for witness corner.


Monument projects 18" above ground. Cap stamped:

Marked NBTs from true corner:

Sugar 10" N44°W, 97.3 links, scribed 1/16 BT.

Sugar 7" N82°E, 64.5 links, scribed 1/16 BT.

S498  
T35N R12E  
NC 1/16 S + 3 W.C.  
E 50 lks.  
1977

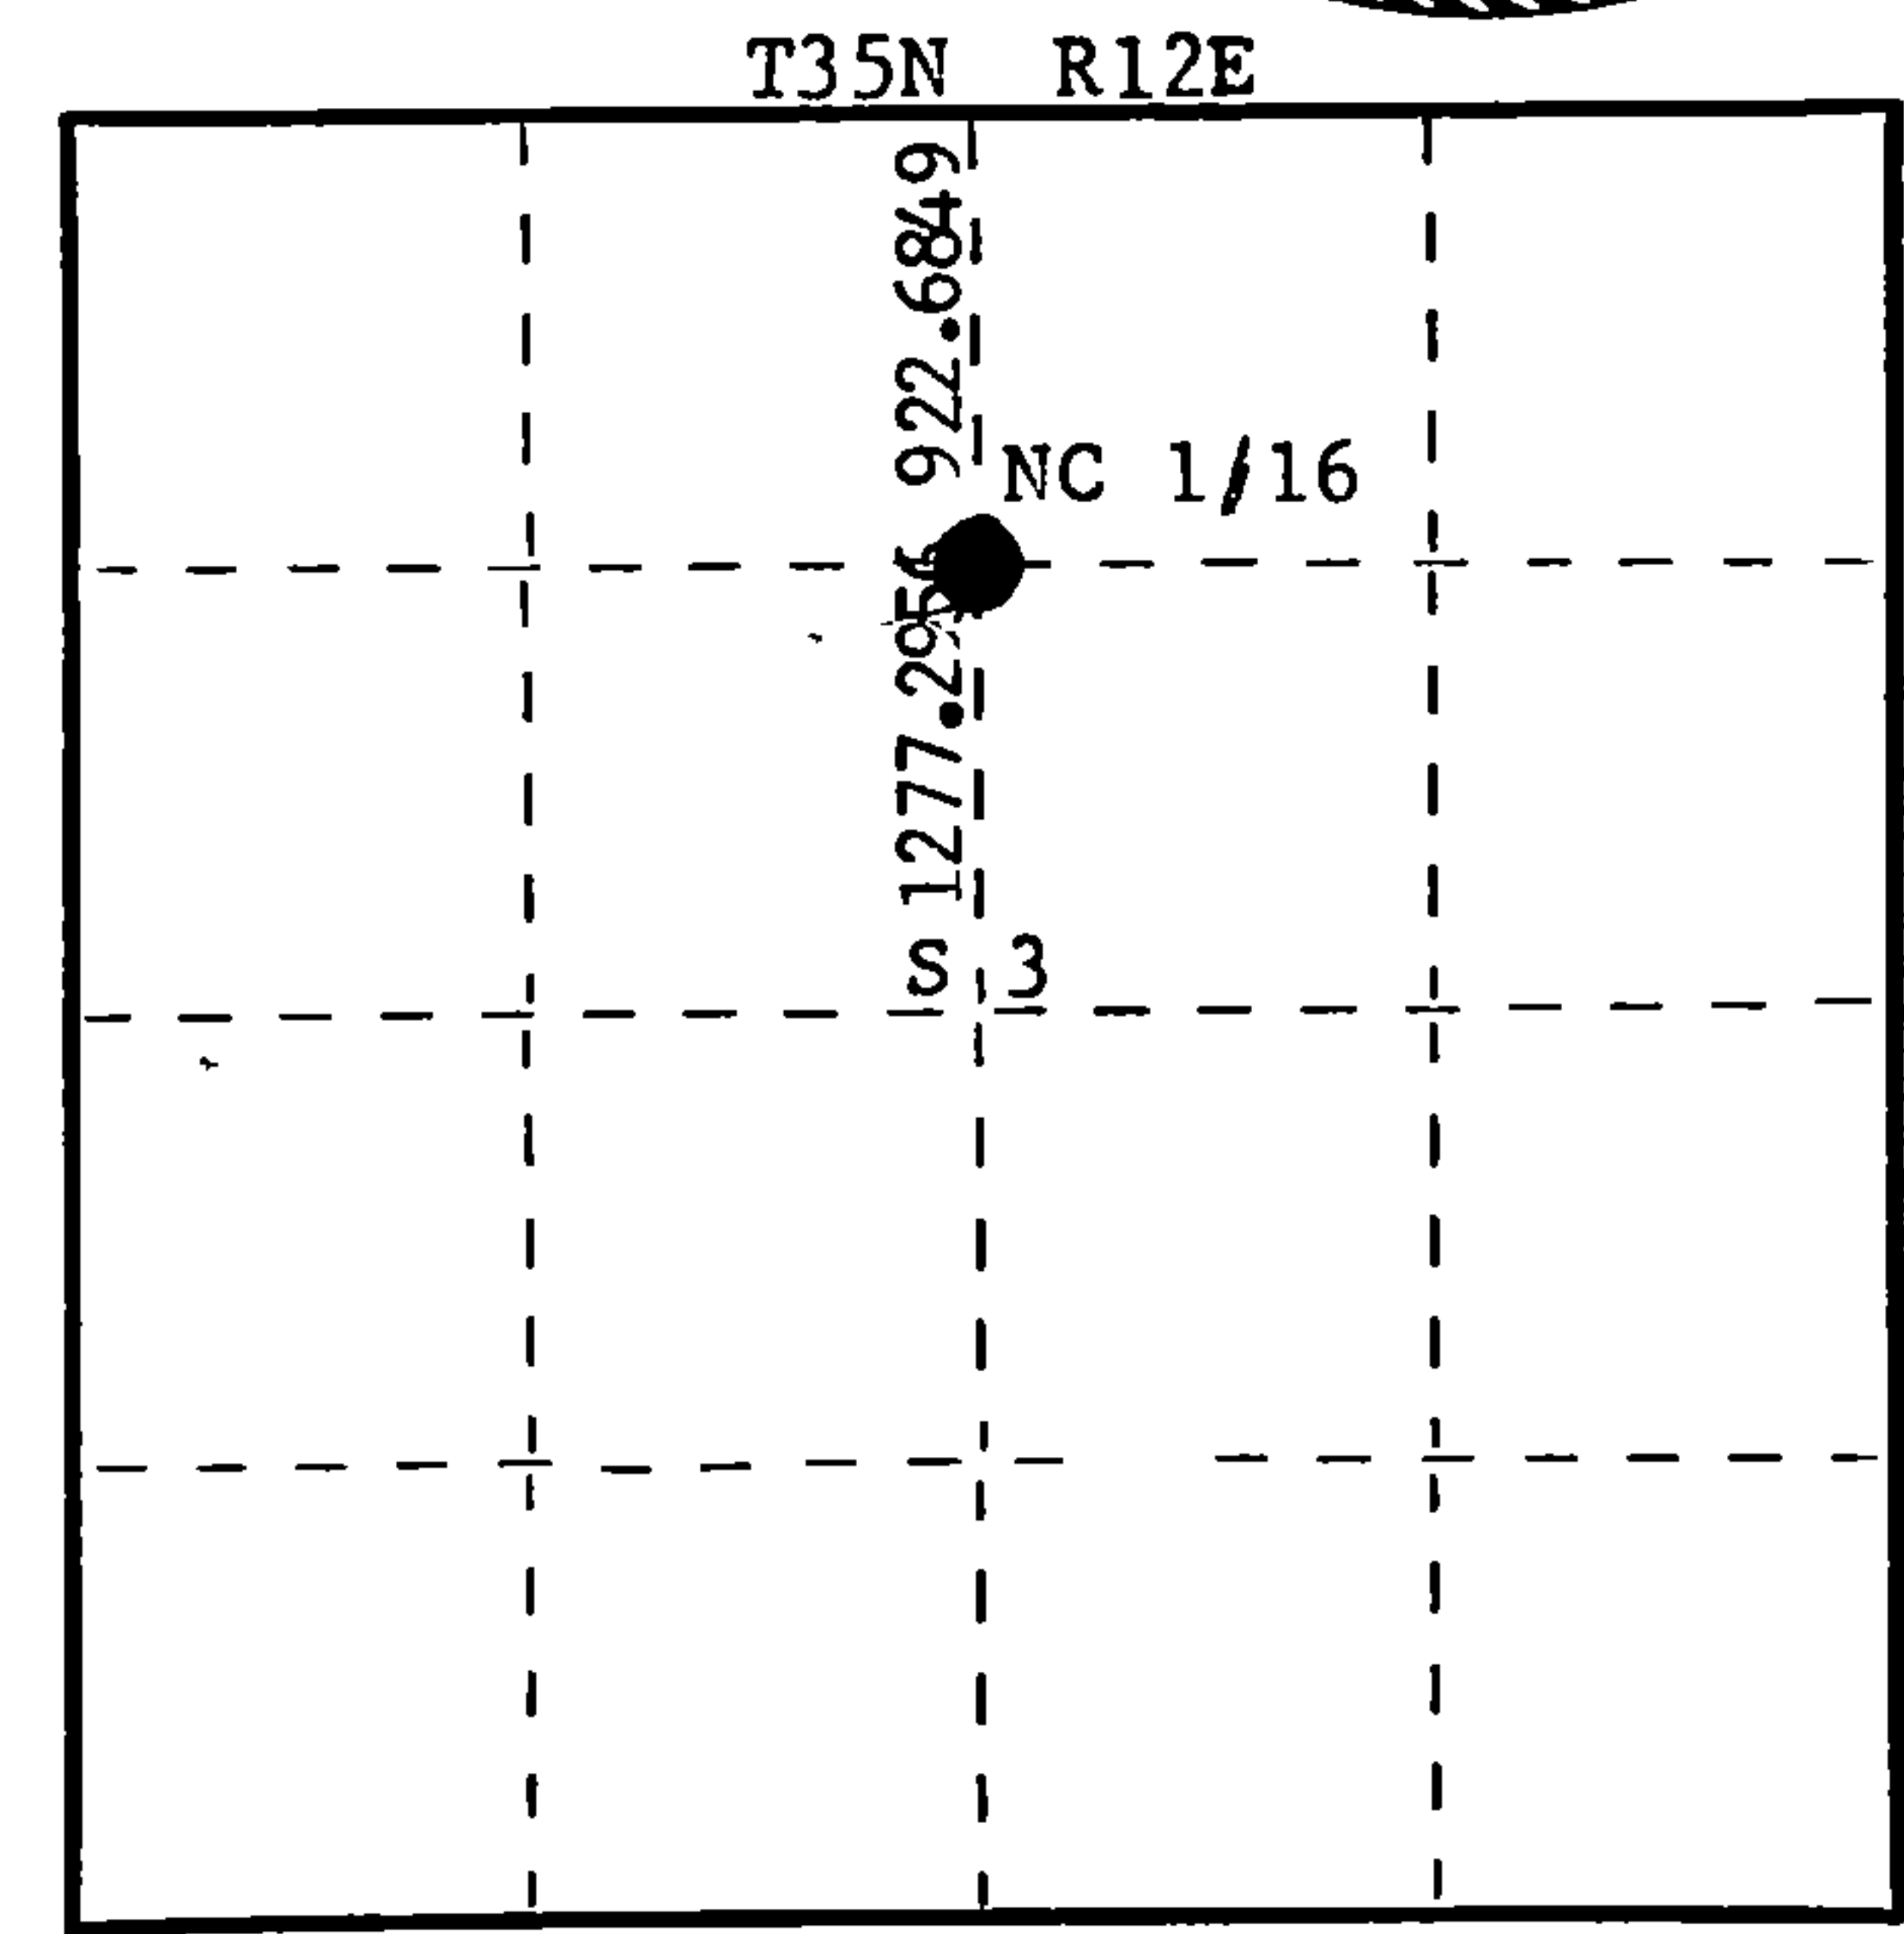

○ = Corner monument restored.

Dated at Rhineland, Wis., this 17th day of October, 1977

Signature Philip T. Hansen Title Registered Land Surveyor Registration No. S-498  
(County Surveyor, Registered Land Surveyor, or other duly authorized official)

Office of Register of Deeds, County of Forest, I hereby certify that the within instrument was filed in this office for record on the 20th day of October, 1977 at 4:20 o'clock P. M.

EUGENE STATEZNY  
(Register of Deeds)

By Eileen Schmidt Deputy

DOCUMENT NUMBER **112602**

435 120 33020