

CERTIFIED LAND CORNER RESTORATION

Index No. E-11

State of Wisconsin }
County of Forest } ss.

History of original corner establishment: Original corner established by James L. Nowlin, Deputy Surveyor, in 1859, from which Sugar 12" bears S10°E 20 lks., Sugar 20" bears N62°E 25 lks.

I Philip T. Hansen, do hereby certify that on the 30th day of April, 19 76, I found evidence of the Quarter corner of Sec. 4 and 9 Township 35, North, Range 12, Fourth Principal Meridian, as described hereon; and that from this evidence I established a new monument and accessories as described hereon to perpetuate the original location of this corner.

Description of corner evidence found: Recovered an old rock cairn with a 3" squared sugar stake in the center. On removing the stake and cairn, found evidence of an old cedar stake in the ground.

Adjacent and local land owners have recognized this corner for years.


Could not find any evidence of original or other BTs.

Resident witnesses:

Glen Barker

Jim Claflin

Herb Wagoner

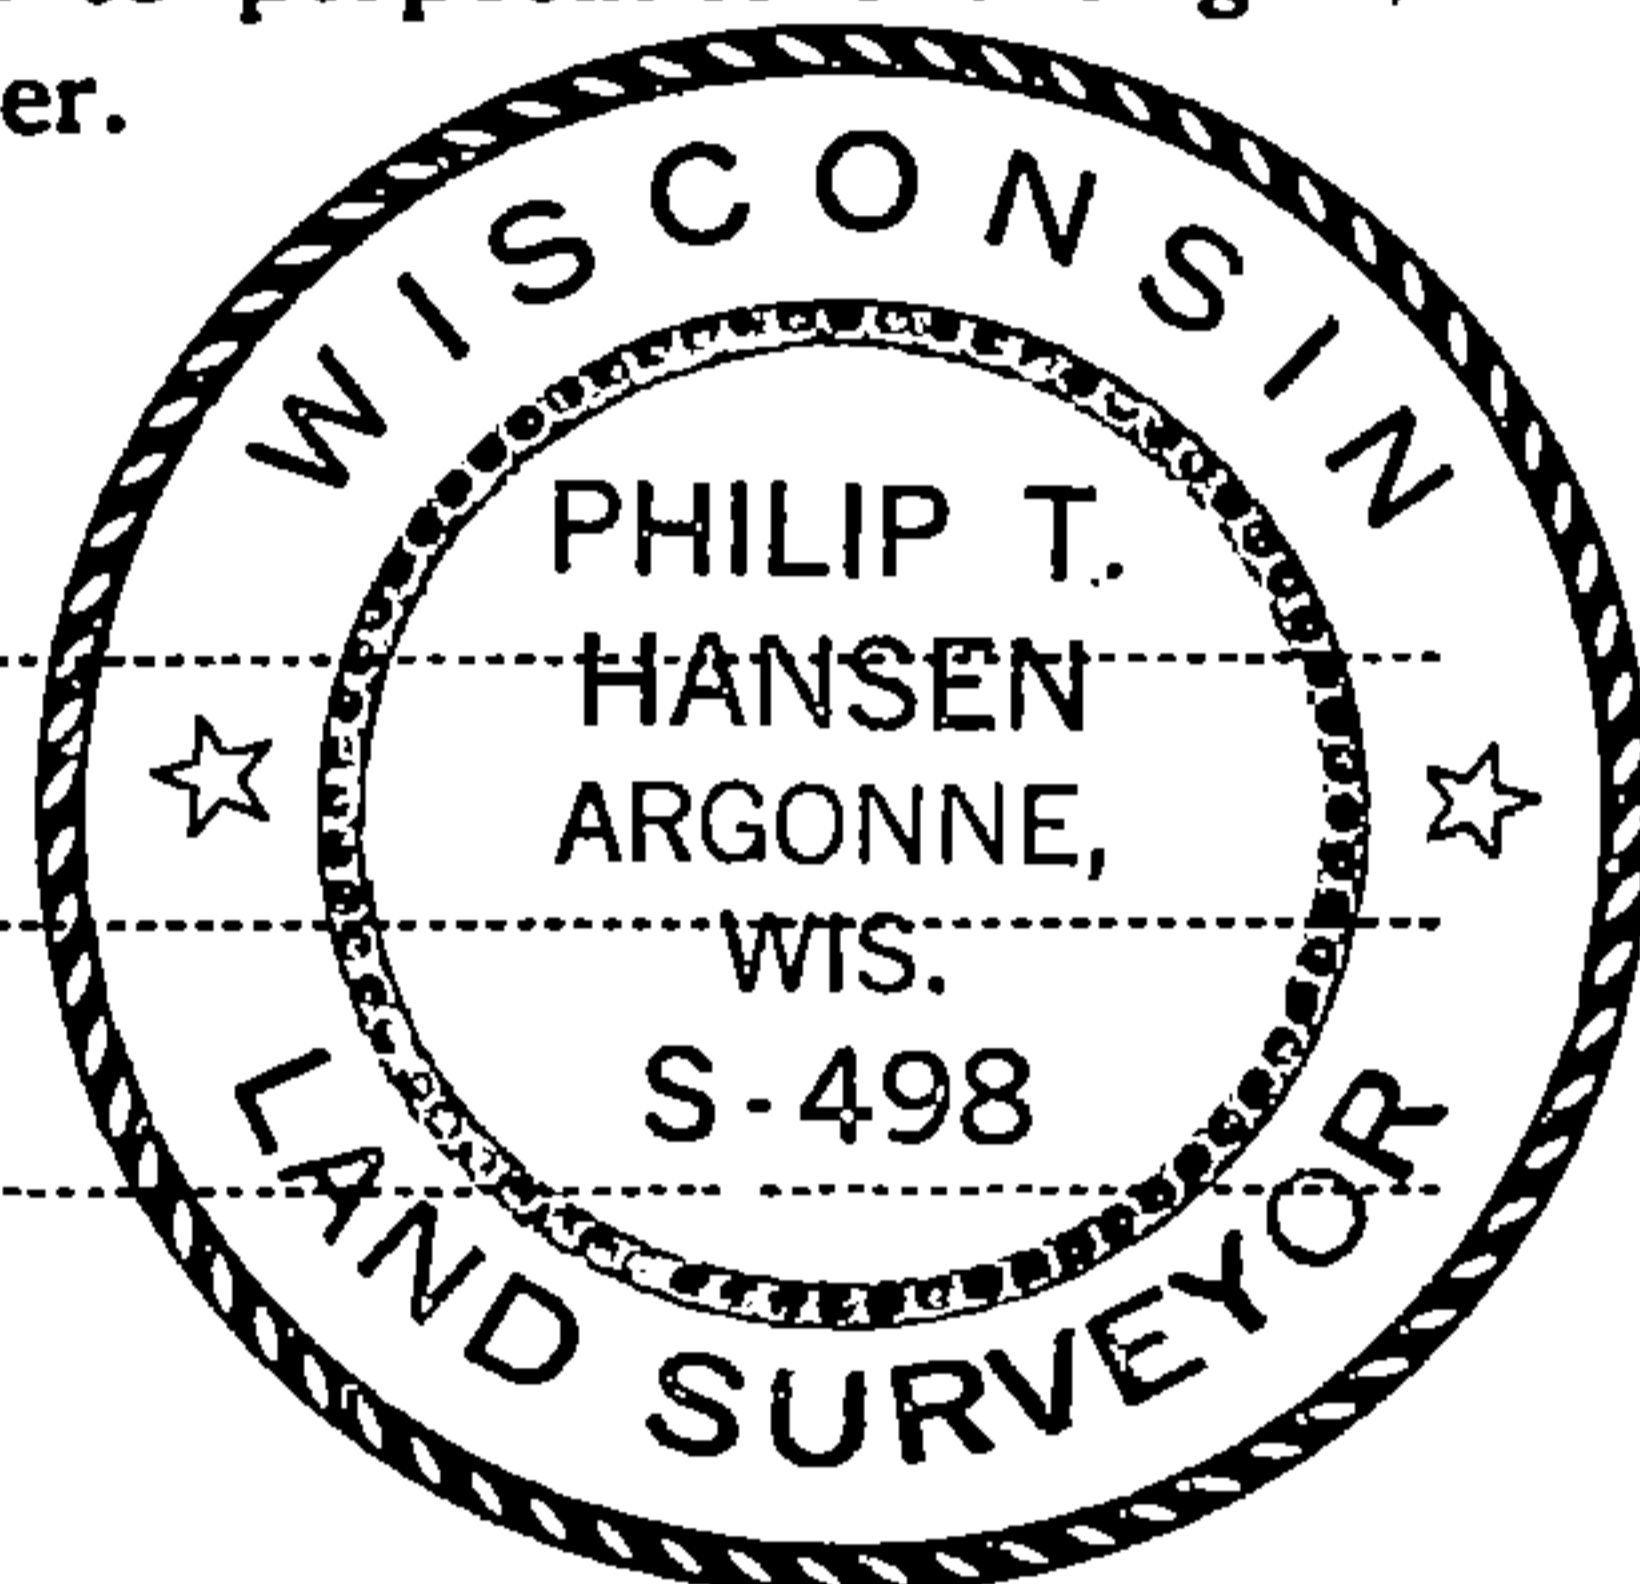

Description of monument and accessories I established to perpetuate the original location of this corner.


Set a 2 1/2" Berntsen A-1 Federal Monument in place of the sugar stake, pipe projects 18" above ground. Placed rock cairn around base. Cap stamped.

NBTs - Sugar 6" N30°E 23.3 lks, scribed 1/4 BT.
Sugar 5" S5°E 44 lks, scribed 1/4 BT.
Sugar 6" S45°E 55.2 lks, scribed 1/4 BT.

T35N R12E
1/4 S 4
S 9
S498-1976

Monument and BTs painted blue.

FORM 985

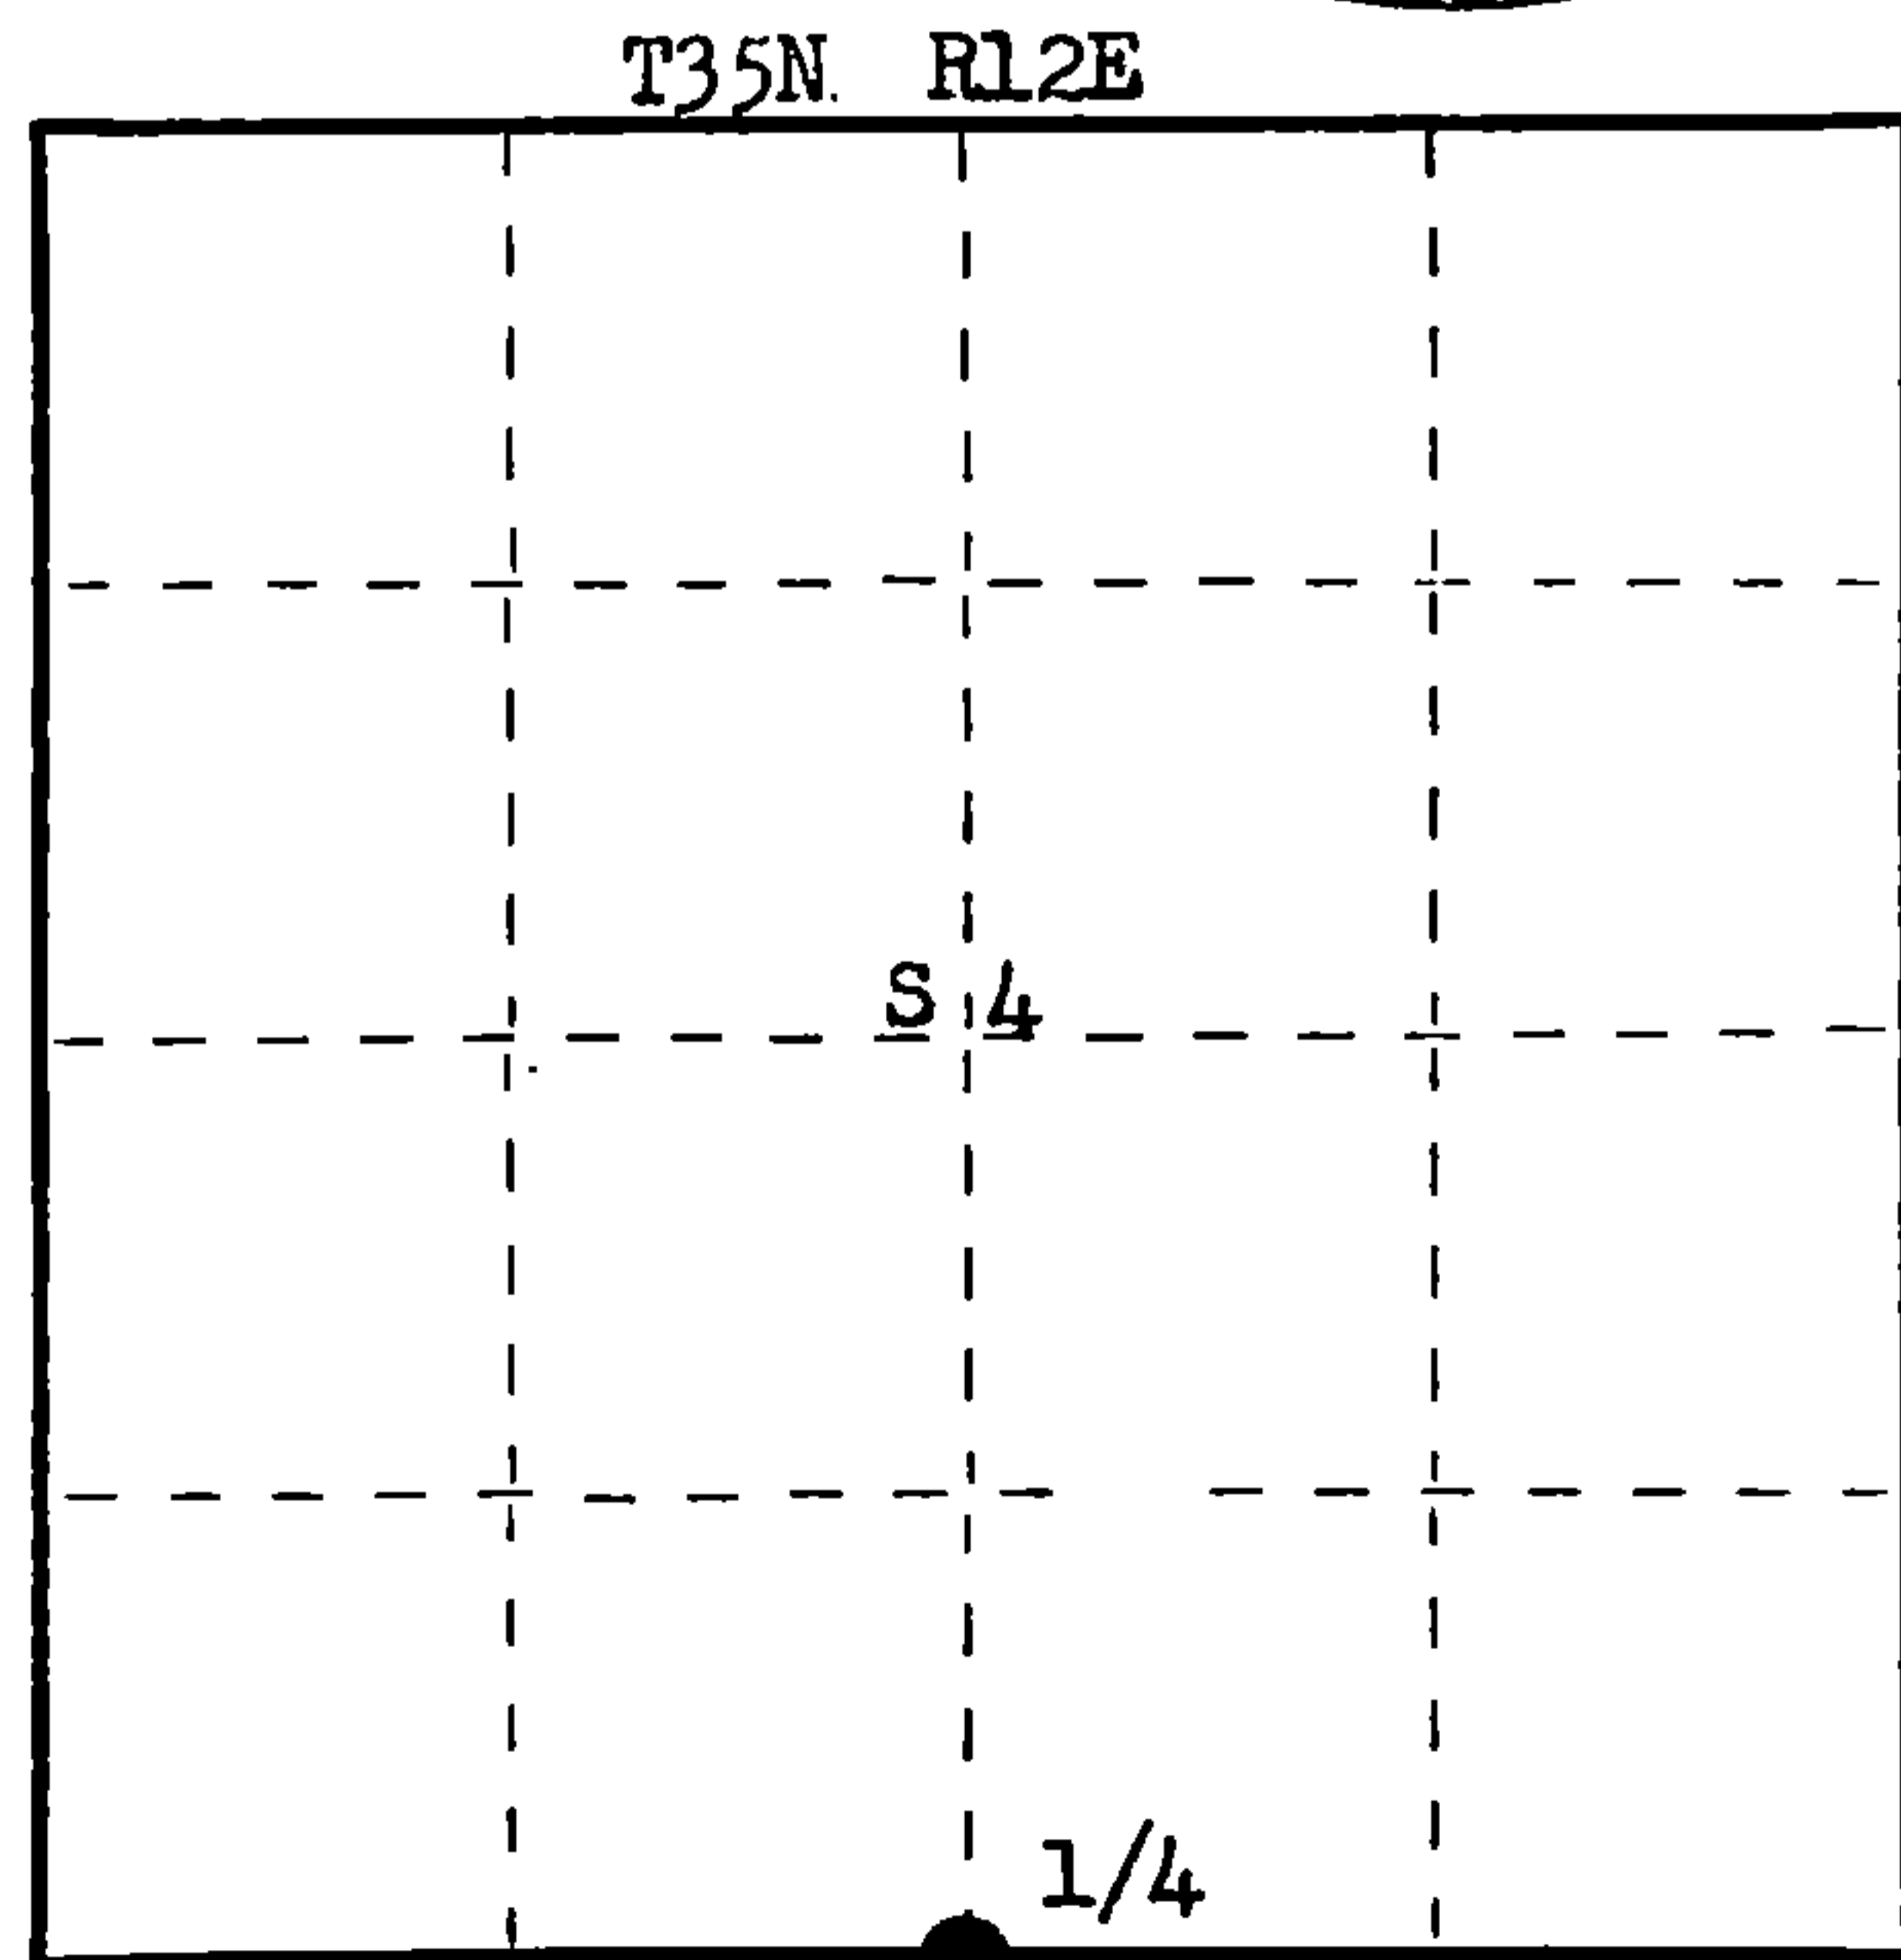

○ = Corner monument restored.

Dated at Rhineland, Wis., this 24th day of May, 19 76.

Signature Philip T. Hansen Title Registered Land Surveyor Registration No. S-498
(County Surveyor, Registered Land Surveyor, or other duly authorized official)

Office of Register of Deeds, County of Forest, I hereby certify that the within instrument was filed in this office for record on the 9TH day of June, 19 76 at 3:30 o'clock P. M.

Eugene Stutzman
(Register of Deeds)

DOCUMENT NUMBER -- **109395**

By..... Deputy

43512040020