

CERTIFIED LAND CORNER RESTORATION

Index No. D-13

State of Wisconsin }
County of Forest } ss.


I Philip T. Hansen, do hereby
certify that on the 28th day
of January, 1977, I ~~found~~
~~established~~ re-established the S 1/16
corner of Section 3 and 4
Township 35, North, Range
12 East, Fourth Principal Meridian,
as described hereon; and that from this evidence
I established a new monument and accessories
as described hereon to perpetuate the original
location of this corner.

Resident witnesses:


Glen Barker

Jim Claflin

Herb Wagoner

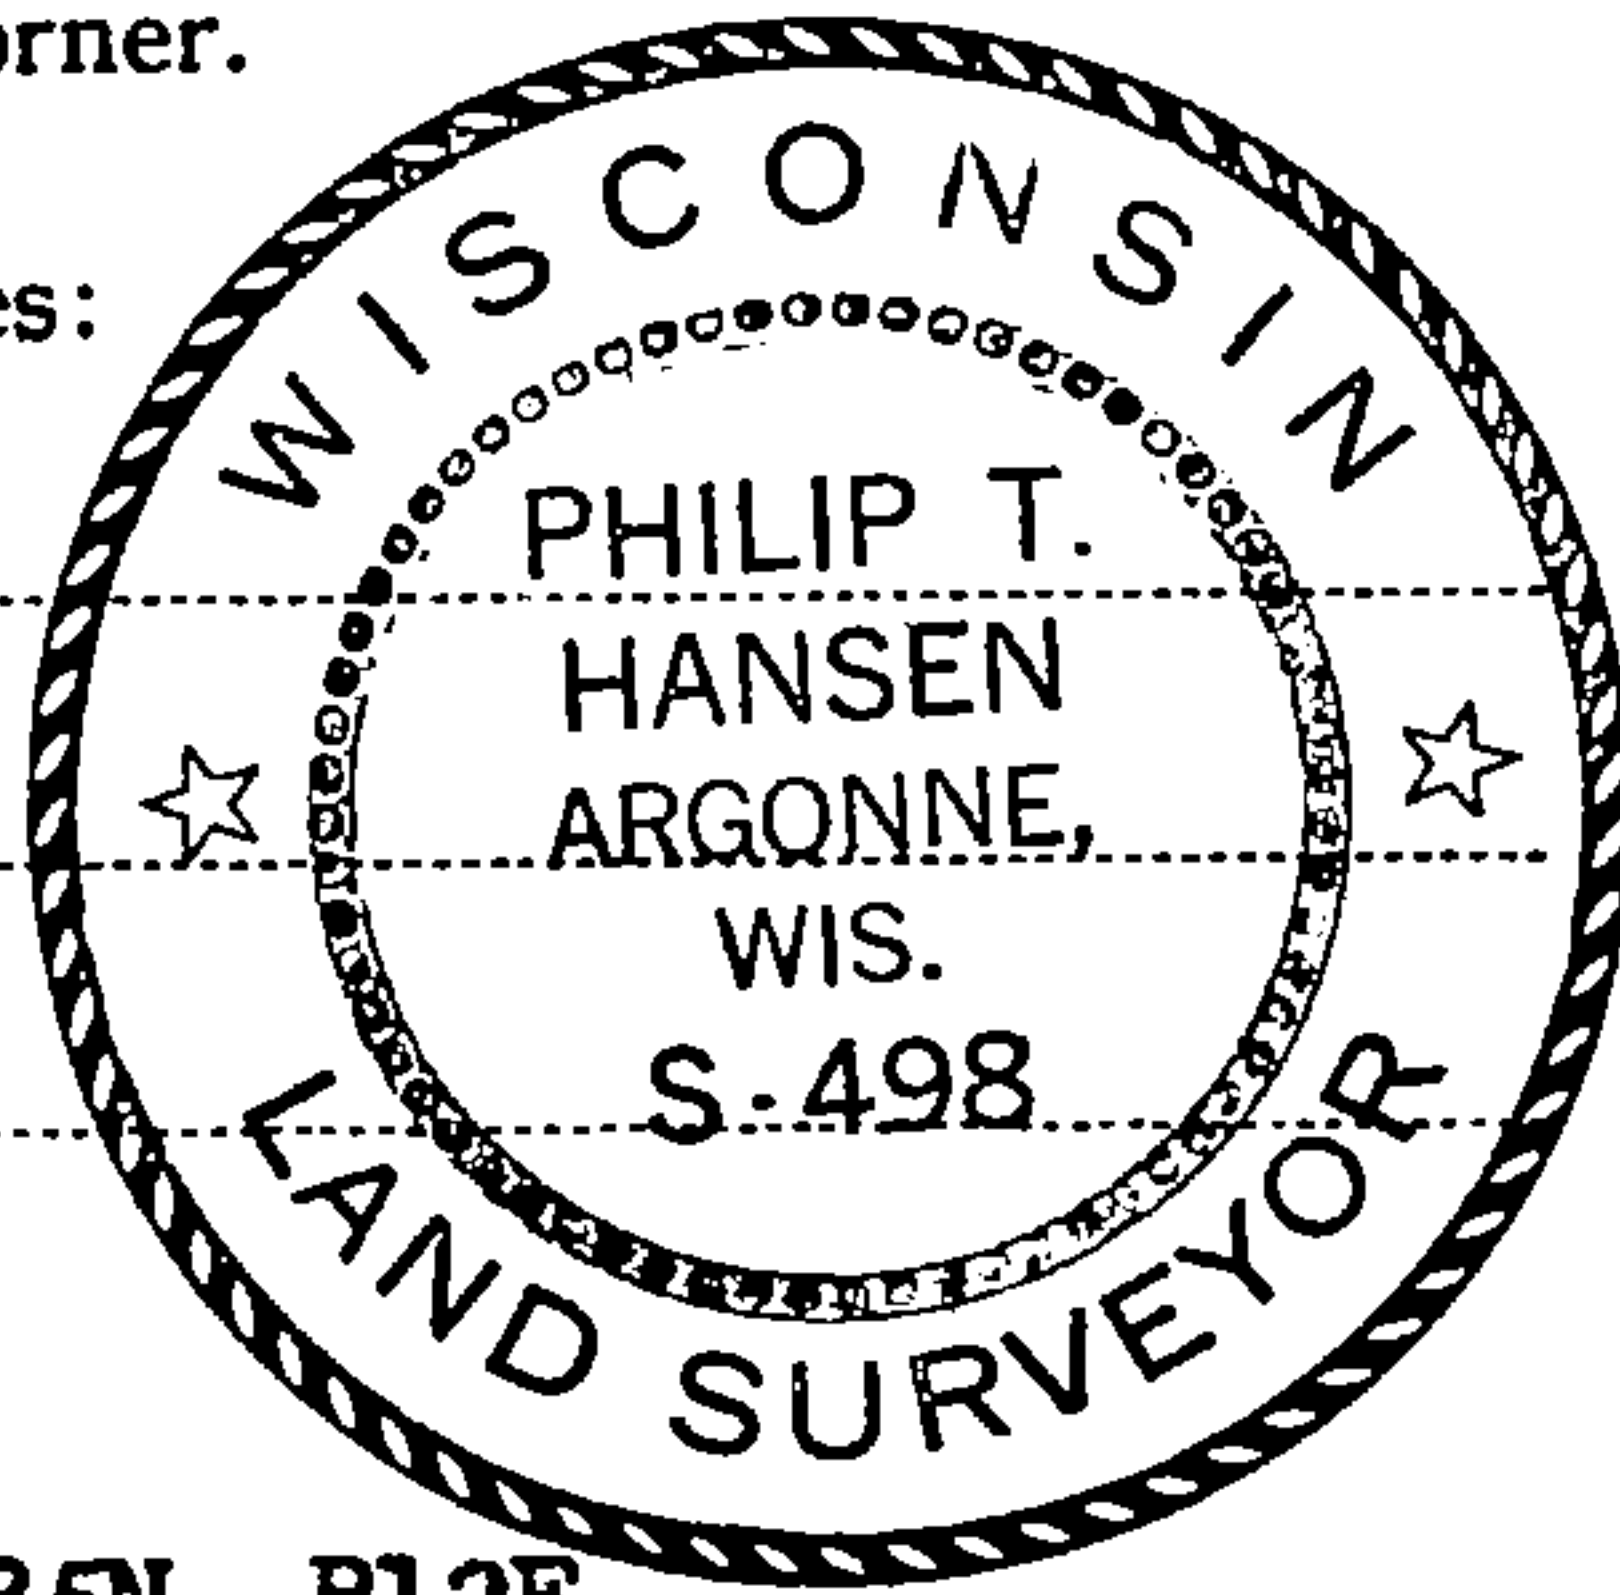

T35N R12E

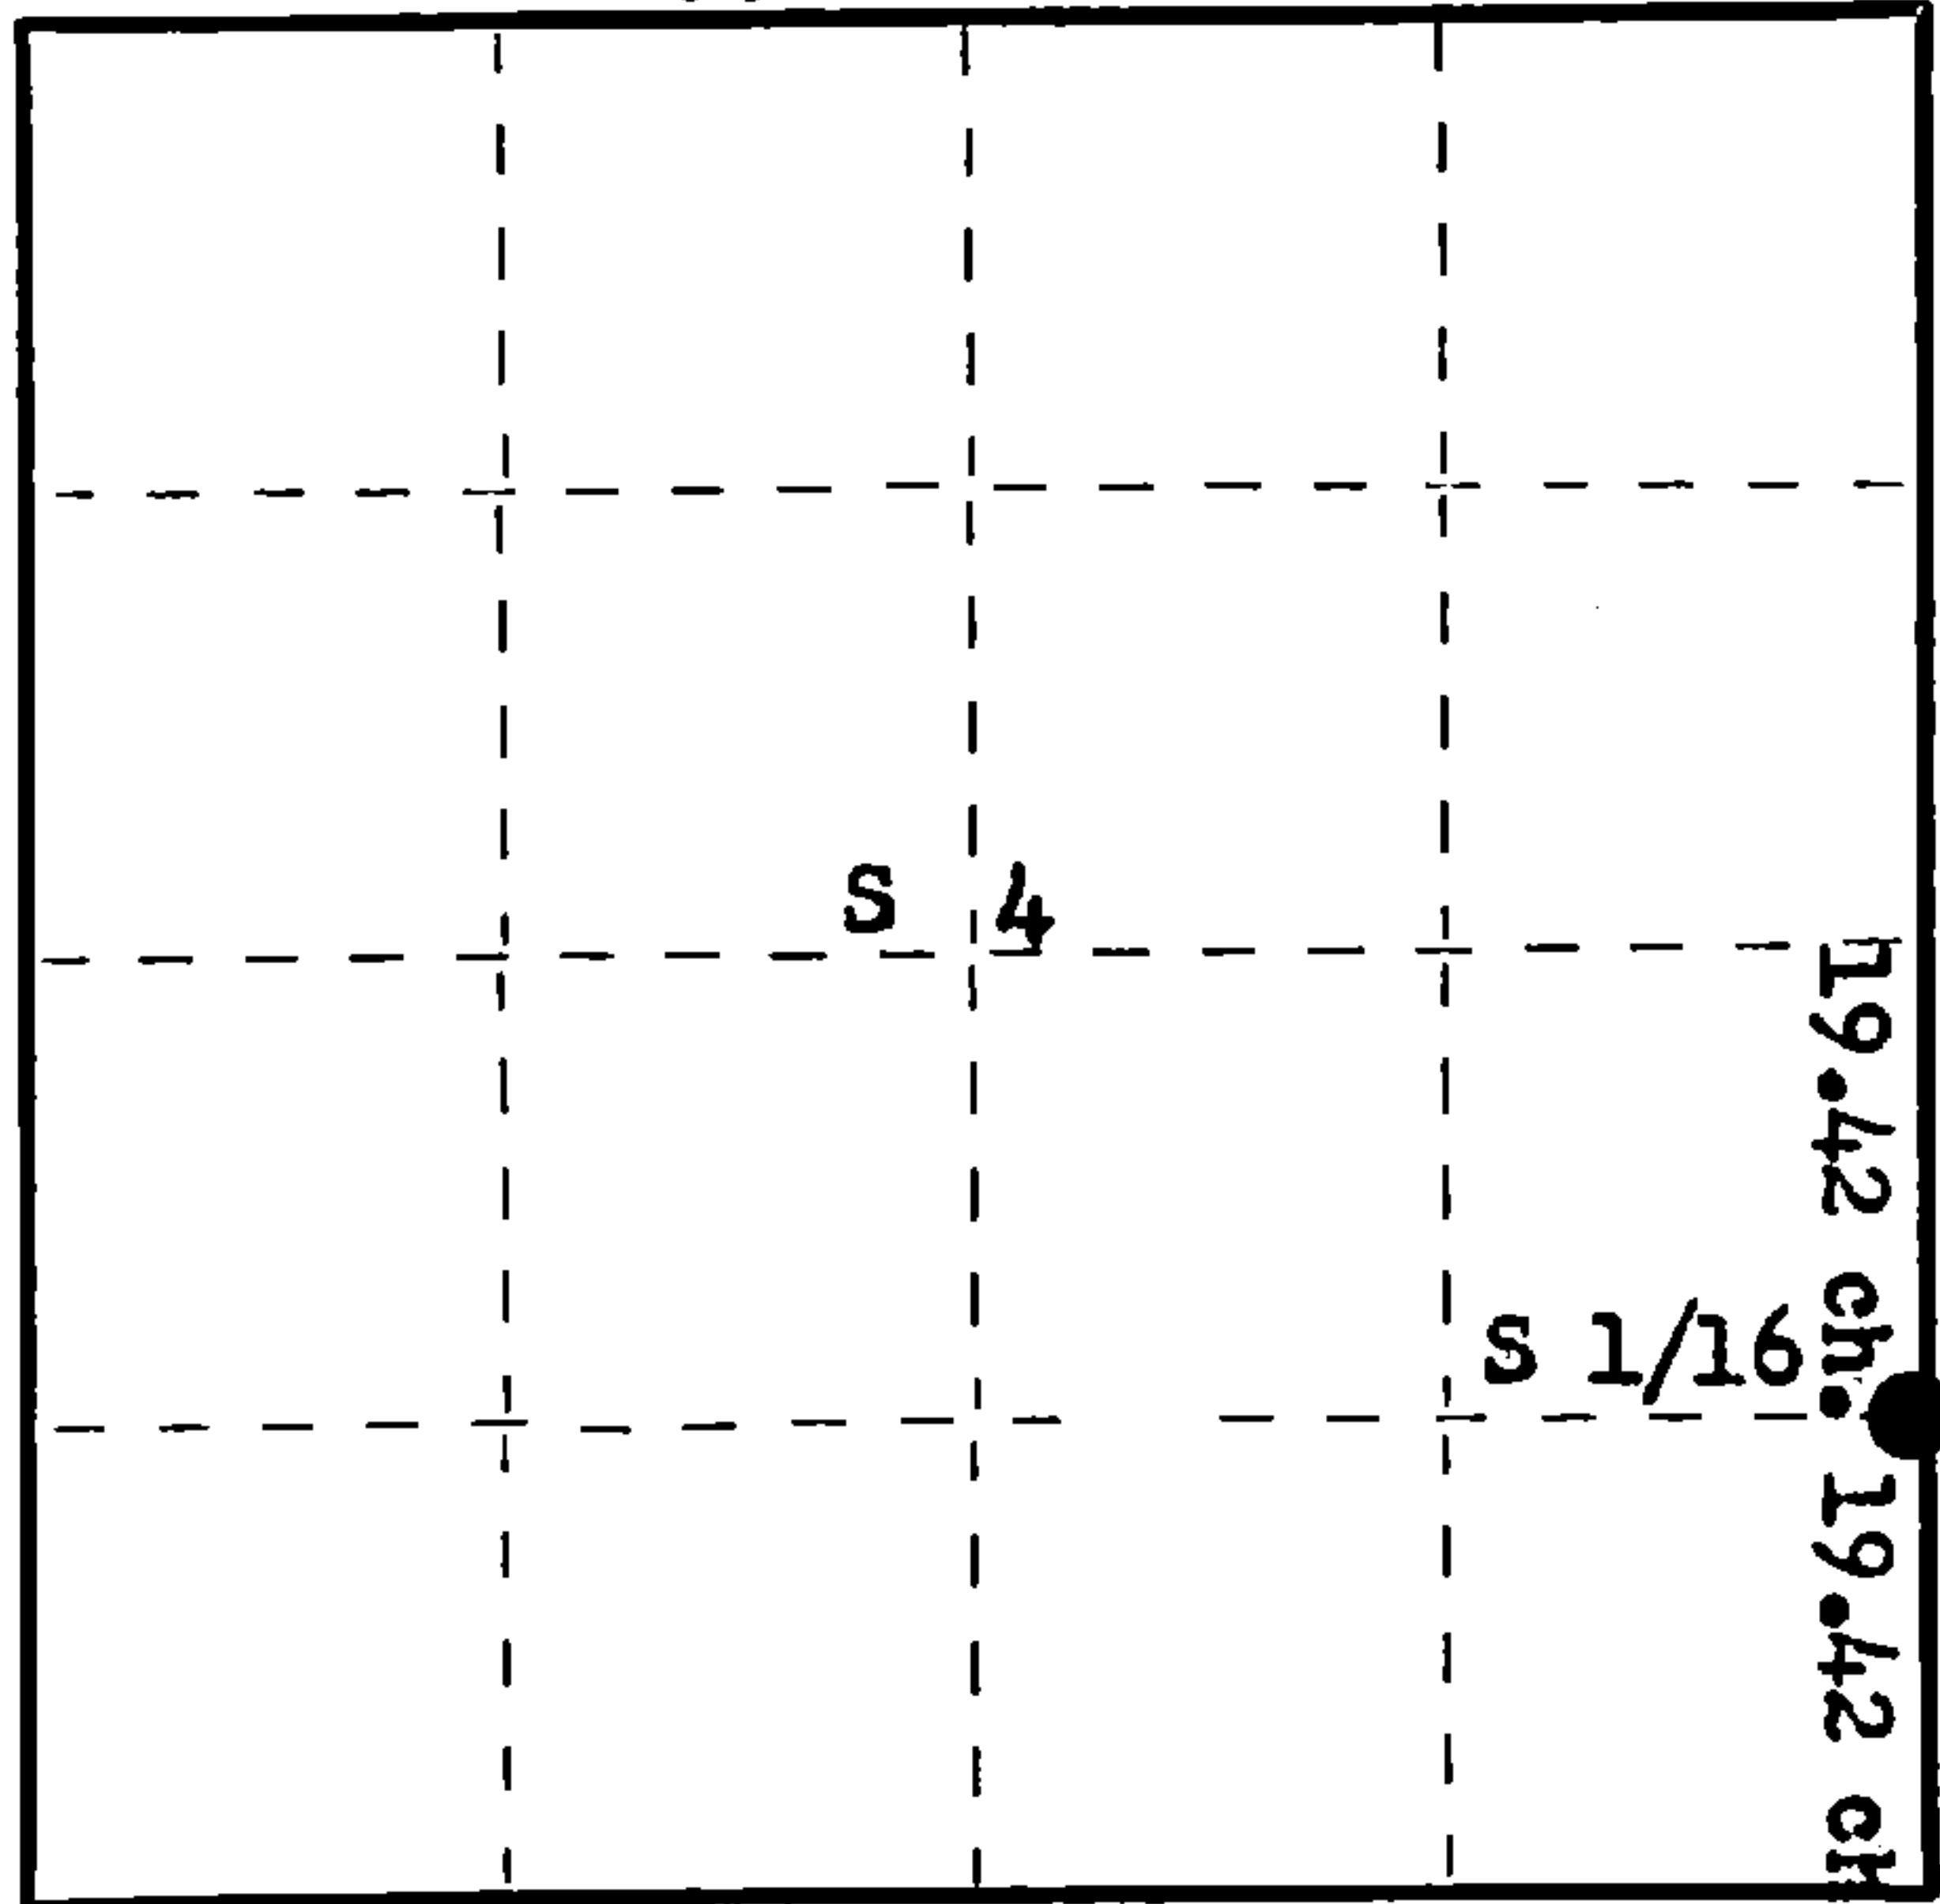

○ = Corner monument restored.

History of original corner establishment:
No records of any previous corner established.

Description of corner evidence found:

Ran traverse between re-established Section Corner 33, 34, 4 and 3 to re-established Section Corner 3, 4, 9 & 10 to re-established Section Corner. Computed distance 72.39 chains as compared to 74.55 chains, original distance. Computed bearing S 3° 04' 01" W. Set 1/4 corner at proportionate distance at 38.84 chains N 03° 04' 01" W. Set S 1/16 corner at 19.42 chains equidistant.

Description of monument and accessories I established to perpetuate the original location of this corner.

Set 1 1/2" x 12" iron pipe, flush with ground on the west side of Walnut Hill Road for true corner.
Set a 1 1/2" iron pipe with 2" brass cap, 50 links west for Witness Corner, projecting 2' above ground. Cap stamped:
NBTs - Sugar 8" N39°W 81.8 links.
Sugar 8" S56°W 82 links, scribed 1/16 BT.
Measurements and bearings made to true corner.

S498
T35N R12E
S 1/16 4 3
E-50 links
CPI - 1977

Dated at Rhineland, Wis., this 5th day of April, 1977

Signature Philip T. Hansen Title Registered Land Surveyor Registration No. S-498
(County Surveyor, Registered Land Surveyor, or other duly authorized official)

Office of Register of Deeds, County of Forest, I hereby certify that the within instrument was filed in this office for record on the 5th day of May, 1977 at 4:00 o'clock P. M.

Eugene Staszny
(Register of Deeds)
By _____ Deputy

DOCUMENT NUMBER
111363

FORM 985 H. C. MILLER CO., MILWAUKEE

43512041000