

CERTIFIED LAND CORNER RESTORATION

Index No. B-13

State of Wisconsin }
County of Forest } ss.


I, Philip T. Hansen, do hereby certify that on the 28th day of January, 1977, I ~~found~~ ^{established} ~~corner~~ of the N 1/16 corner of Section 3 & 4 Township 35, North, Range 12 East, Fourth Principal Meridian, as described hereon; and that from this evidence I established a new monument and accessories as described hereon to perpetuate the original location of this corner.

Resident witnesses:


Glen Barker

Jim Claflin

Herb Wagoner

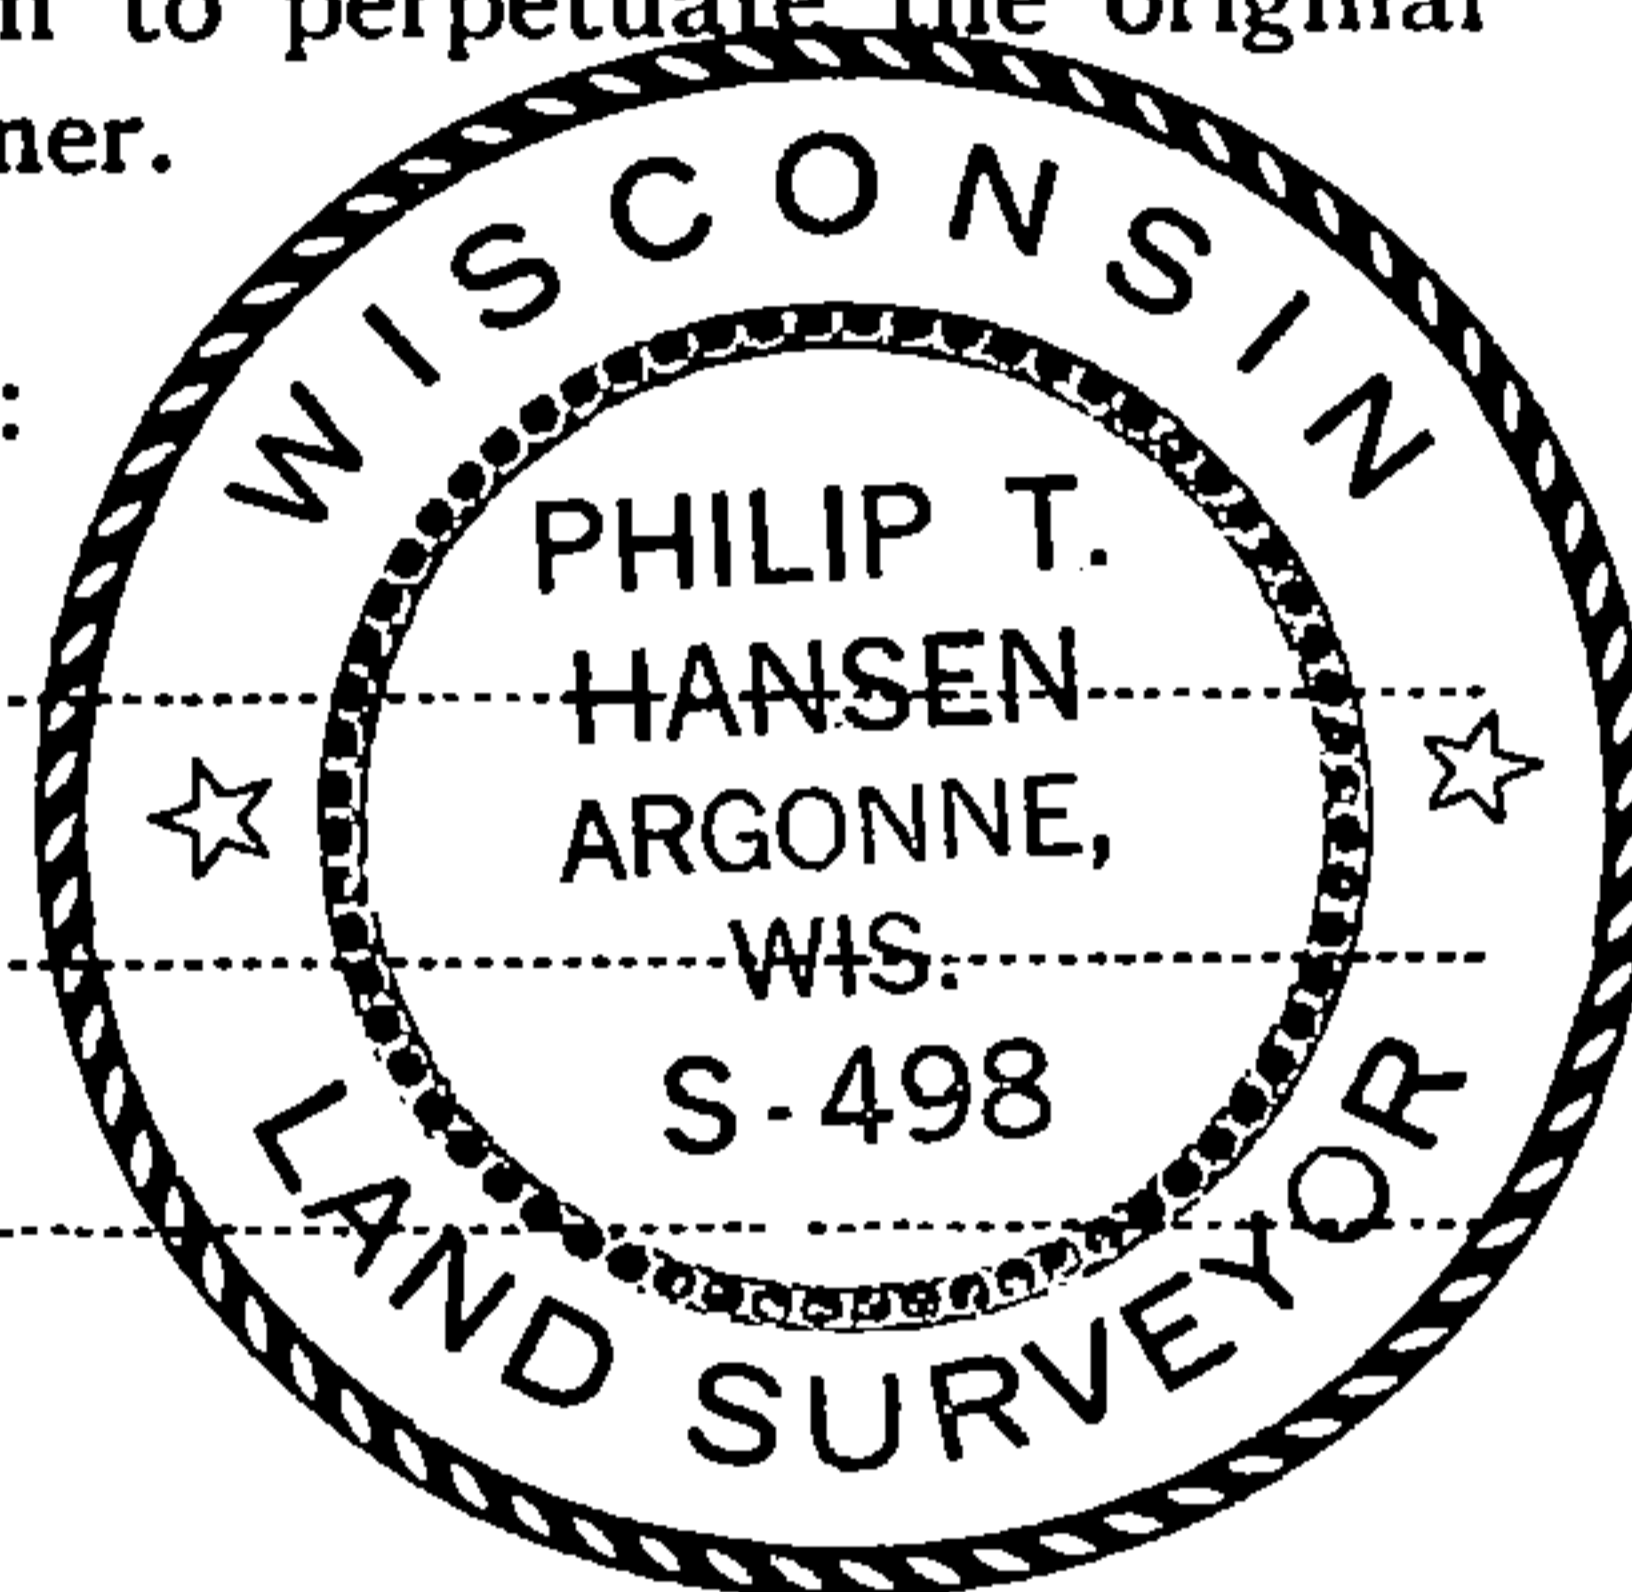

FORM 985 H. C. MILLER CO., MILWAUKEE

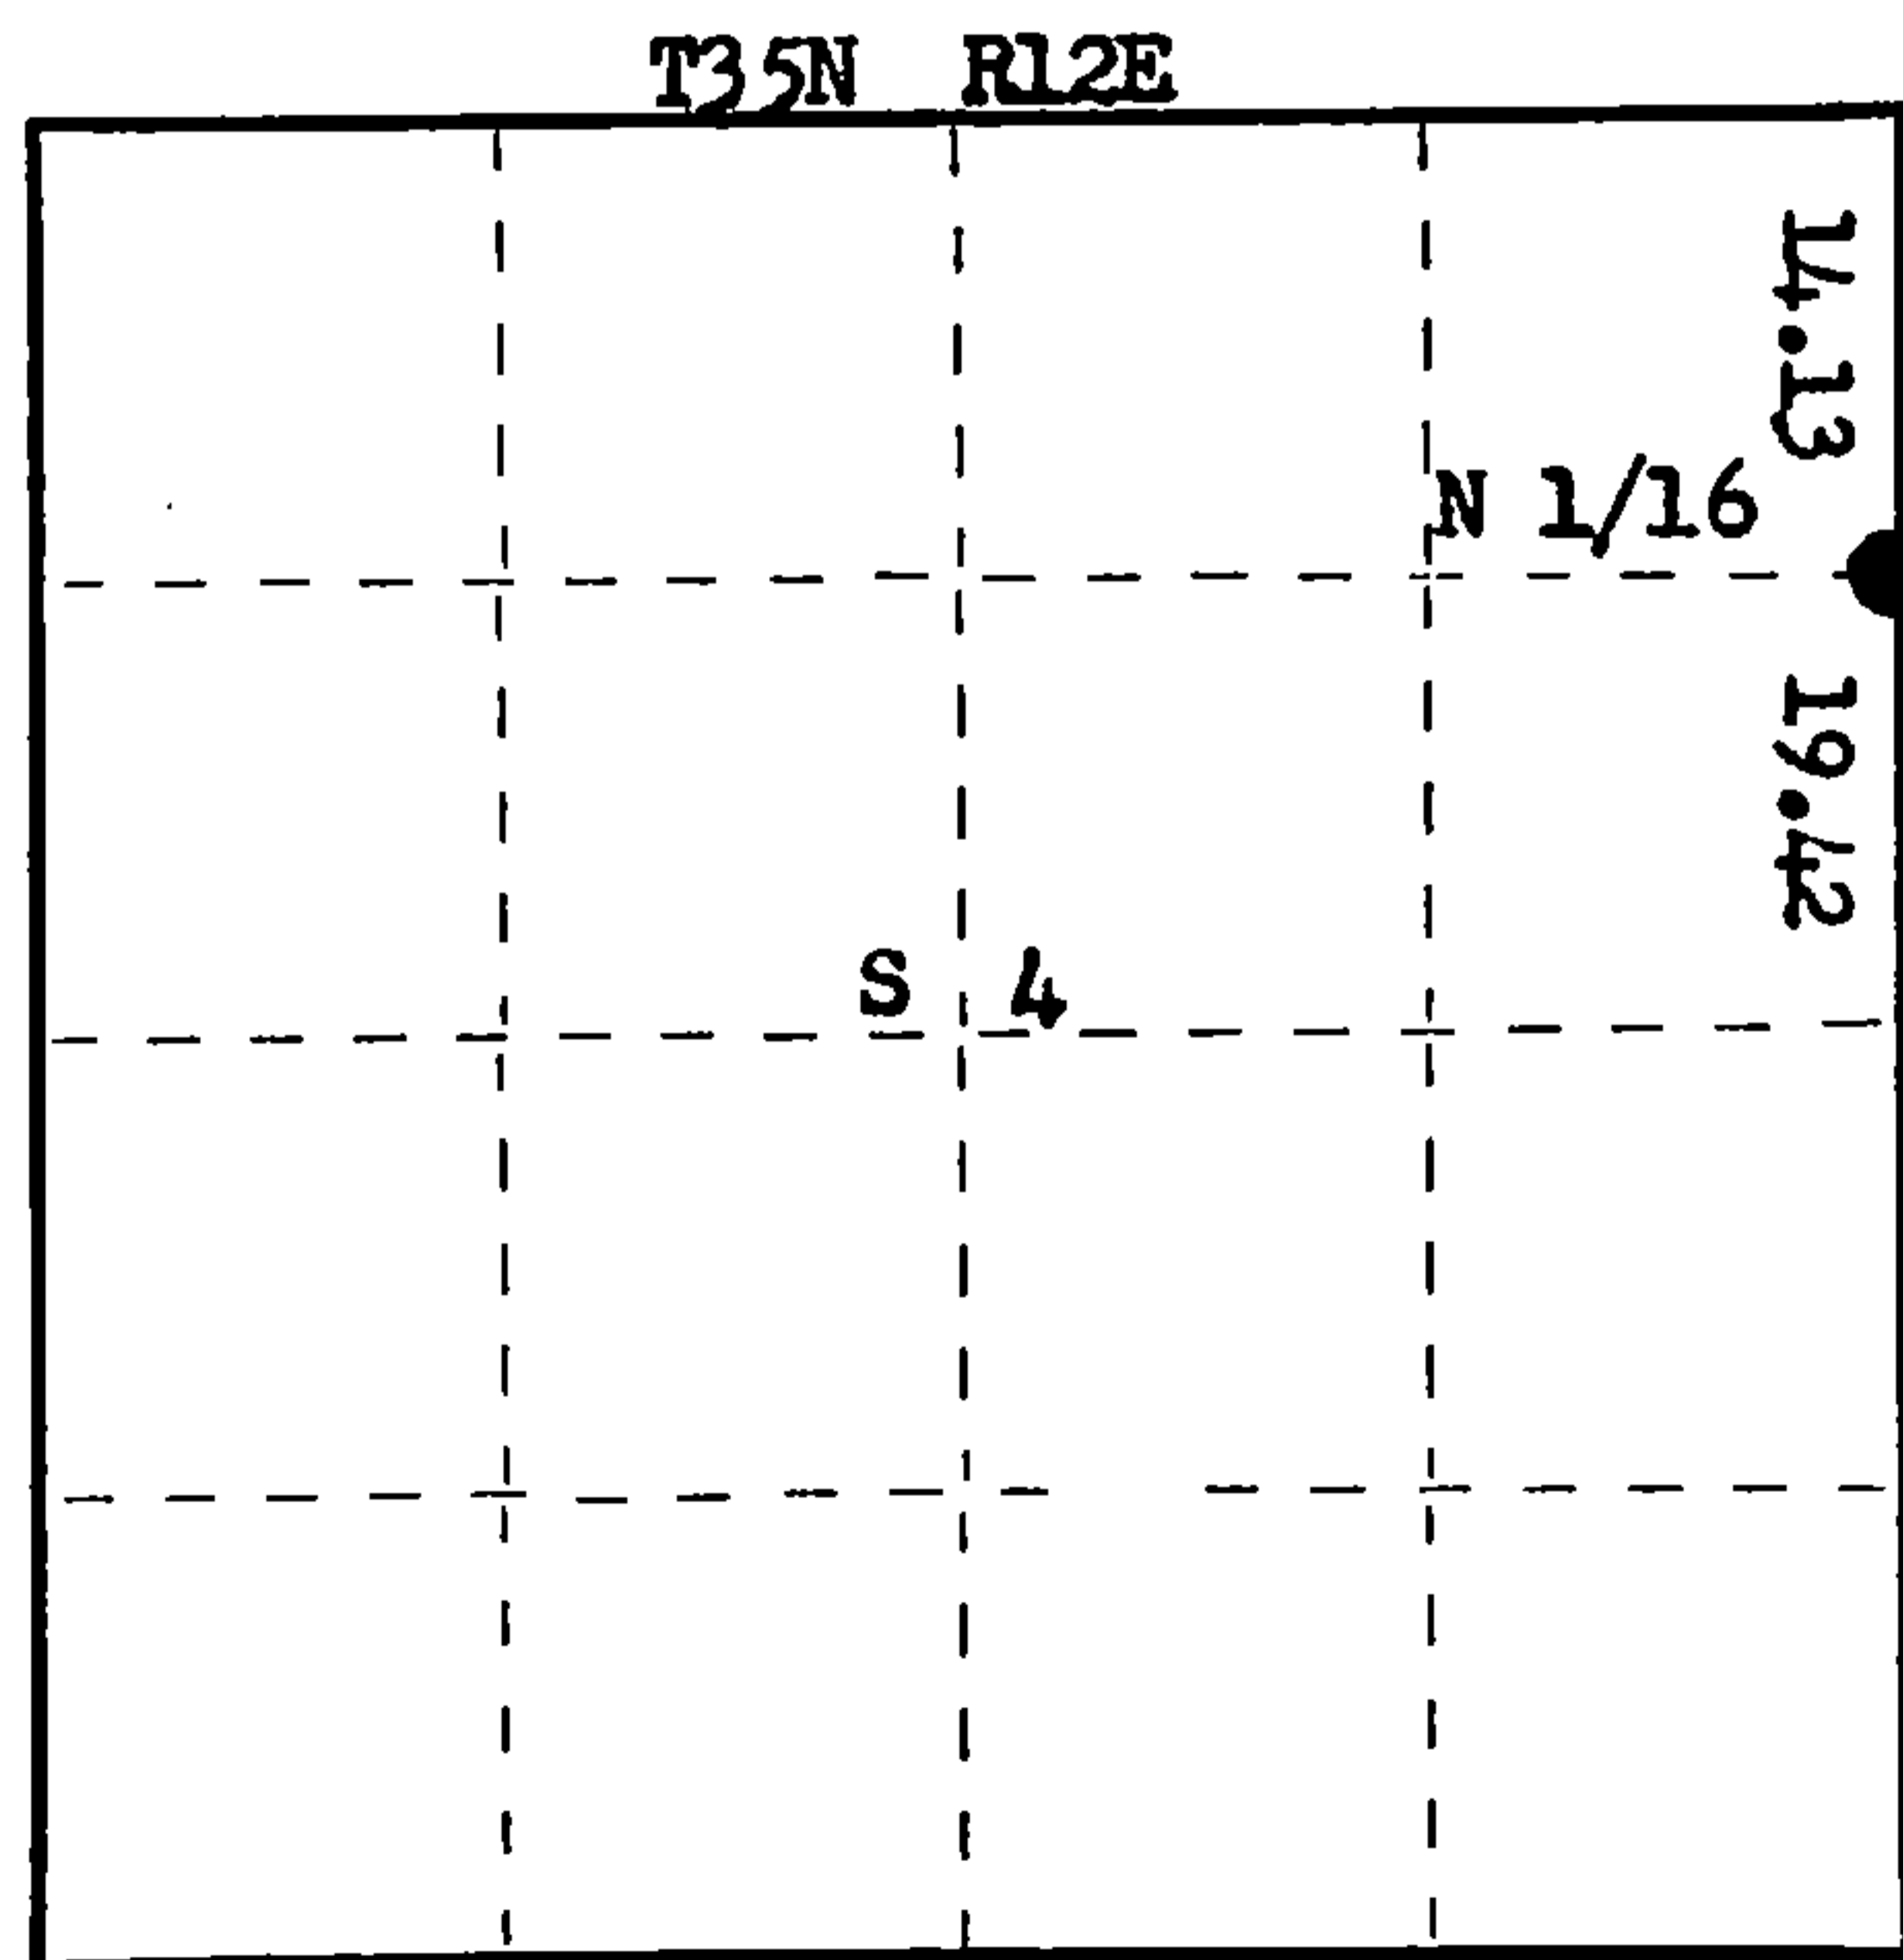

History of original corner establishment:
No records of any previous corner established.

Description of corner evidence found:

Corner established by proportionate measurement. Ran traverse from re-established Section Corner 3, 4, 9 & 10 to re-established Section Corner 33, 34, 4 & 3. Computed distance 72.39 chains, as compared to 74.55 chains, original measurement. Corrected computed bearing N 03° 04' 01" W.
Set 1/4 corner at 38.84 chains N 03° 04' 01" W of Section Corner 3, 4, 9 & 10.
Set N 1/16 corner at 19.42 chains N 03° 04' 01" W of 1/4 corner, 14.13 chains S 03° 04' 01" E of Section Corner.

Description of monument and accessories I established to perpetuate the original location of this corner.

Set a 1 1/2" x 12" iron pipe for true corner, flush with ground, on the west side of Walnut Hill Road.
Set a 1 1/2" iron pipe with 2" brass cap for Witness Corner 50 links west.
Monument projects 20" above ground. Cap stamped:
NBTs - Sugar 16" N52°W 68.4 links, scribed 1/16 BT.
Sugar 10" S19°W 105.8 links, scribed 1/16 BT.
Measurements and bearings to BTs made from true corner.

S498
T35N RL2E
N 1/16 43 W.C.
E 50 lks.
CPI-1977

Dated at Rhineland, Wis., this 5th day of April, 1977.

Signature Philip T. Hansen Title Registered Land Surveyor Registration No. S-498
(County Surveyor, Registered Land Surveyor, or other duly authorized official)

Office of Register of Deeds, County of Forest, I hereby certify that the within instrument was filed in this office for record on the 5th day of May, 1977 at 4:00 o'clock P. M.

Eugene Stetson
(Register of Deeds)

By..... Deputy

DOCUMENT NUMBER
111362

43512043000