

CERTIFIED LAND CORNER RESTORATION

Index No. E-9

State of Wisconsin }  
County of Forest } ss.


I Philip T. Hansen, do hereby certify that on the 23rd day of May, 1977, I ~~found~~ <sup>established</sup> ~~evidence of~~ the Section corner of Sec. 4, 5, 8, 9 Township 35, North, Range 12 East, Fourth Principal Meridian, as described hereon; and that from this evidence I established a new monument and accessories as described hereon to perpetuate the original location of this corner.

Resident witnesses:


Glen Barker

Jim Claflin

Herb Wagoner

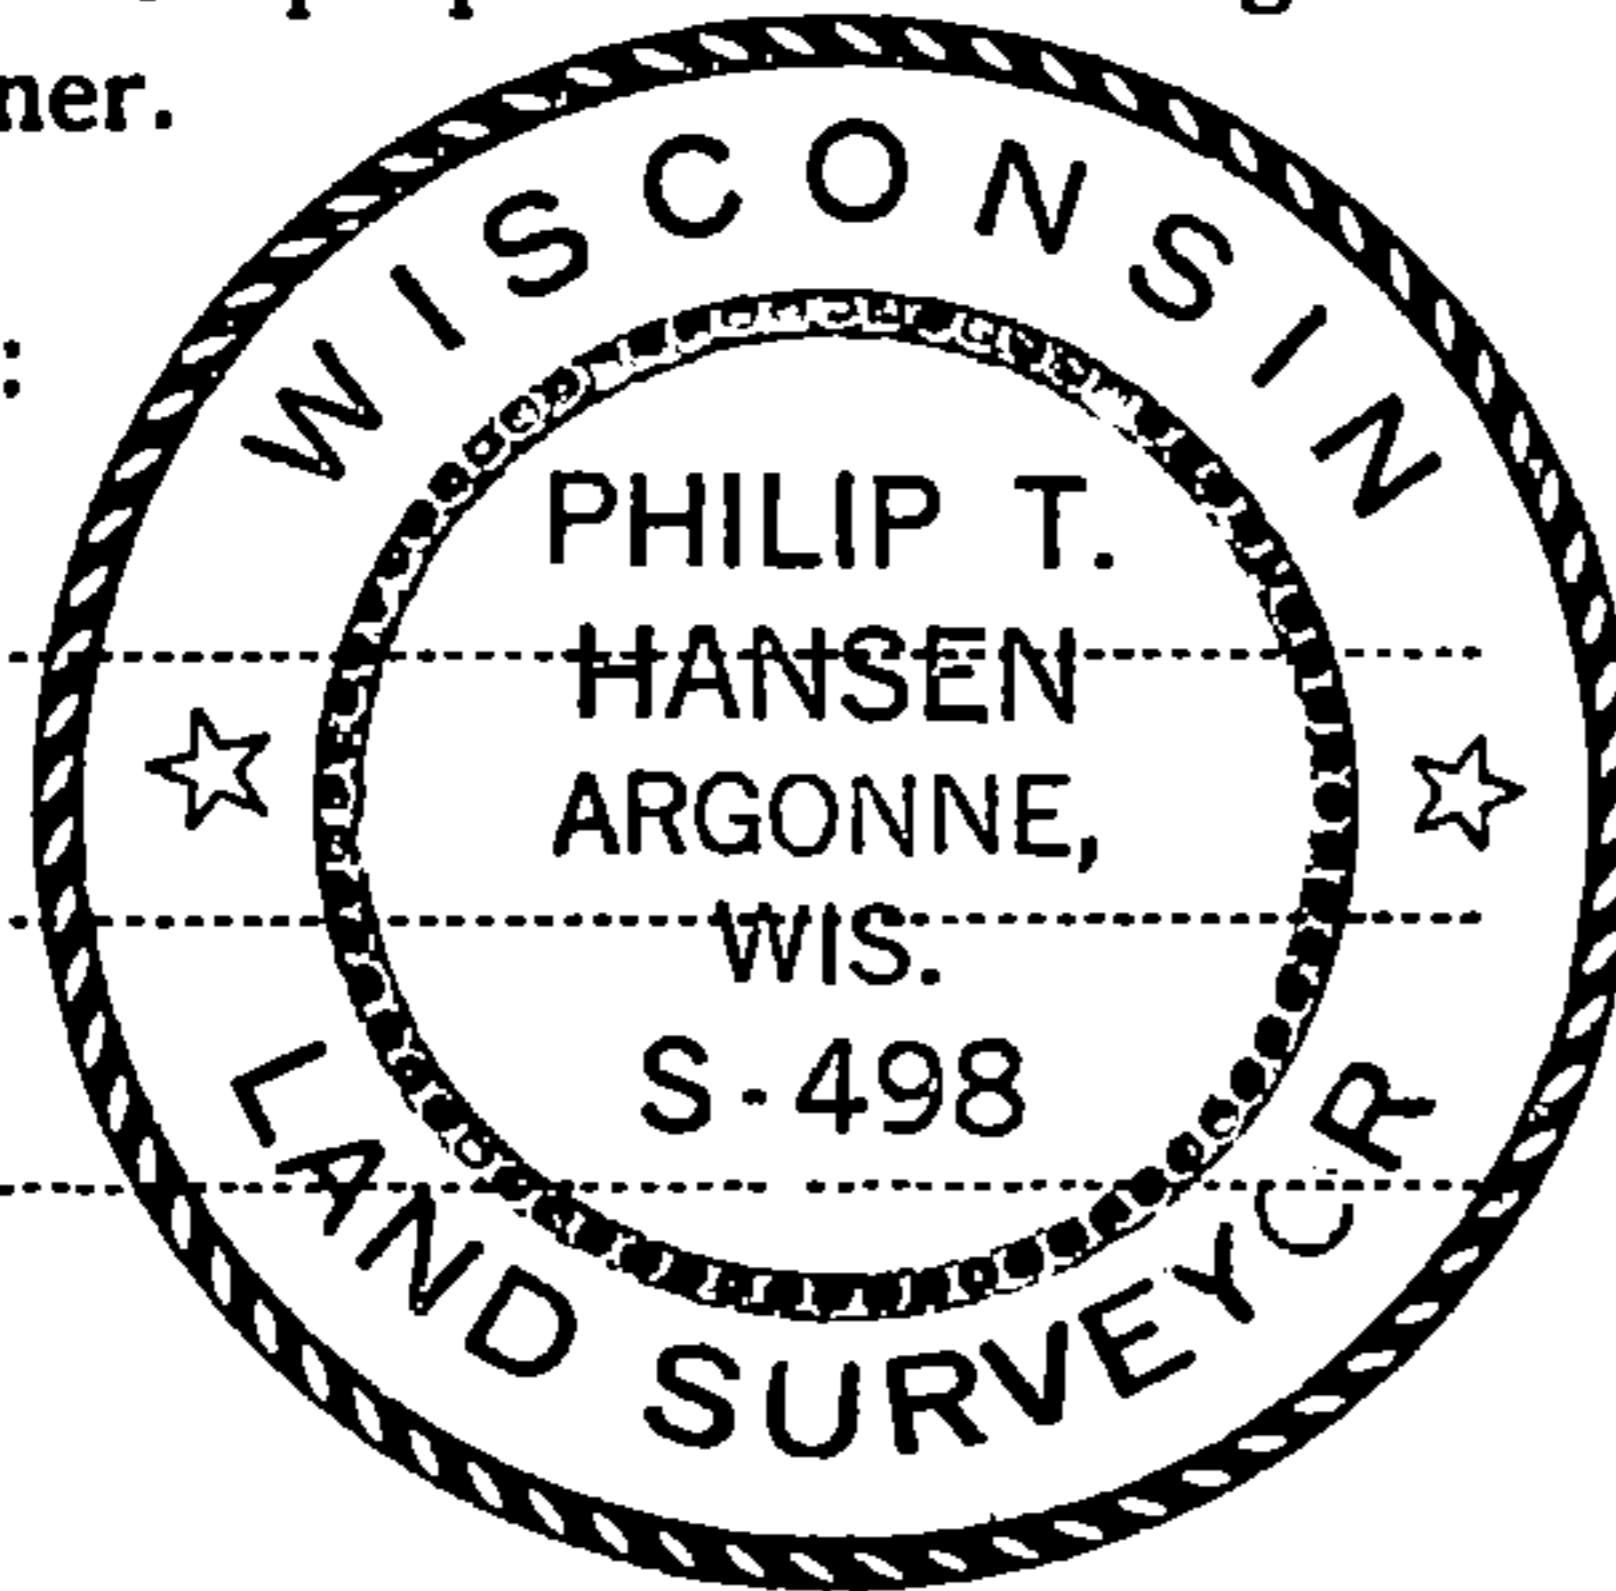

FORM 985

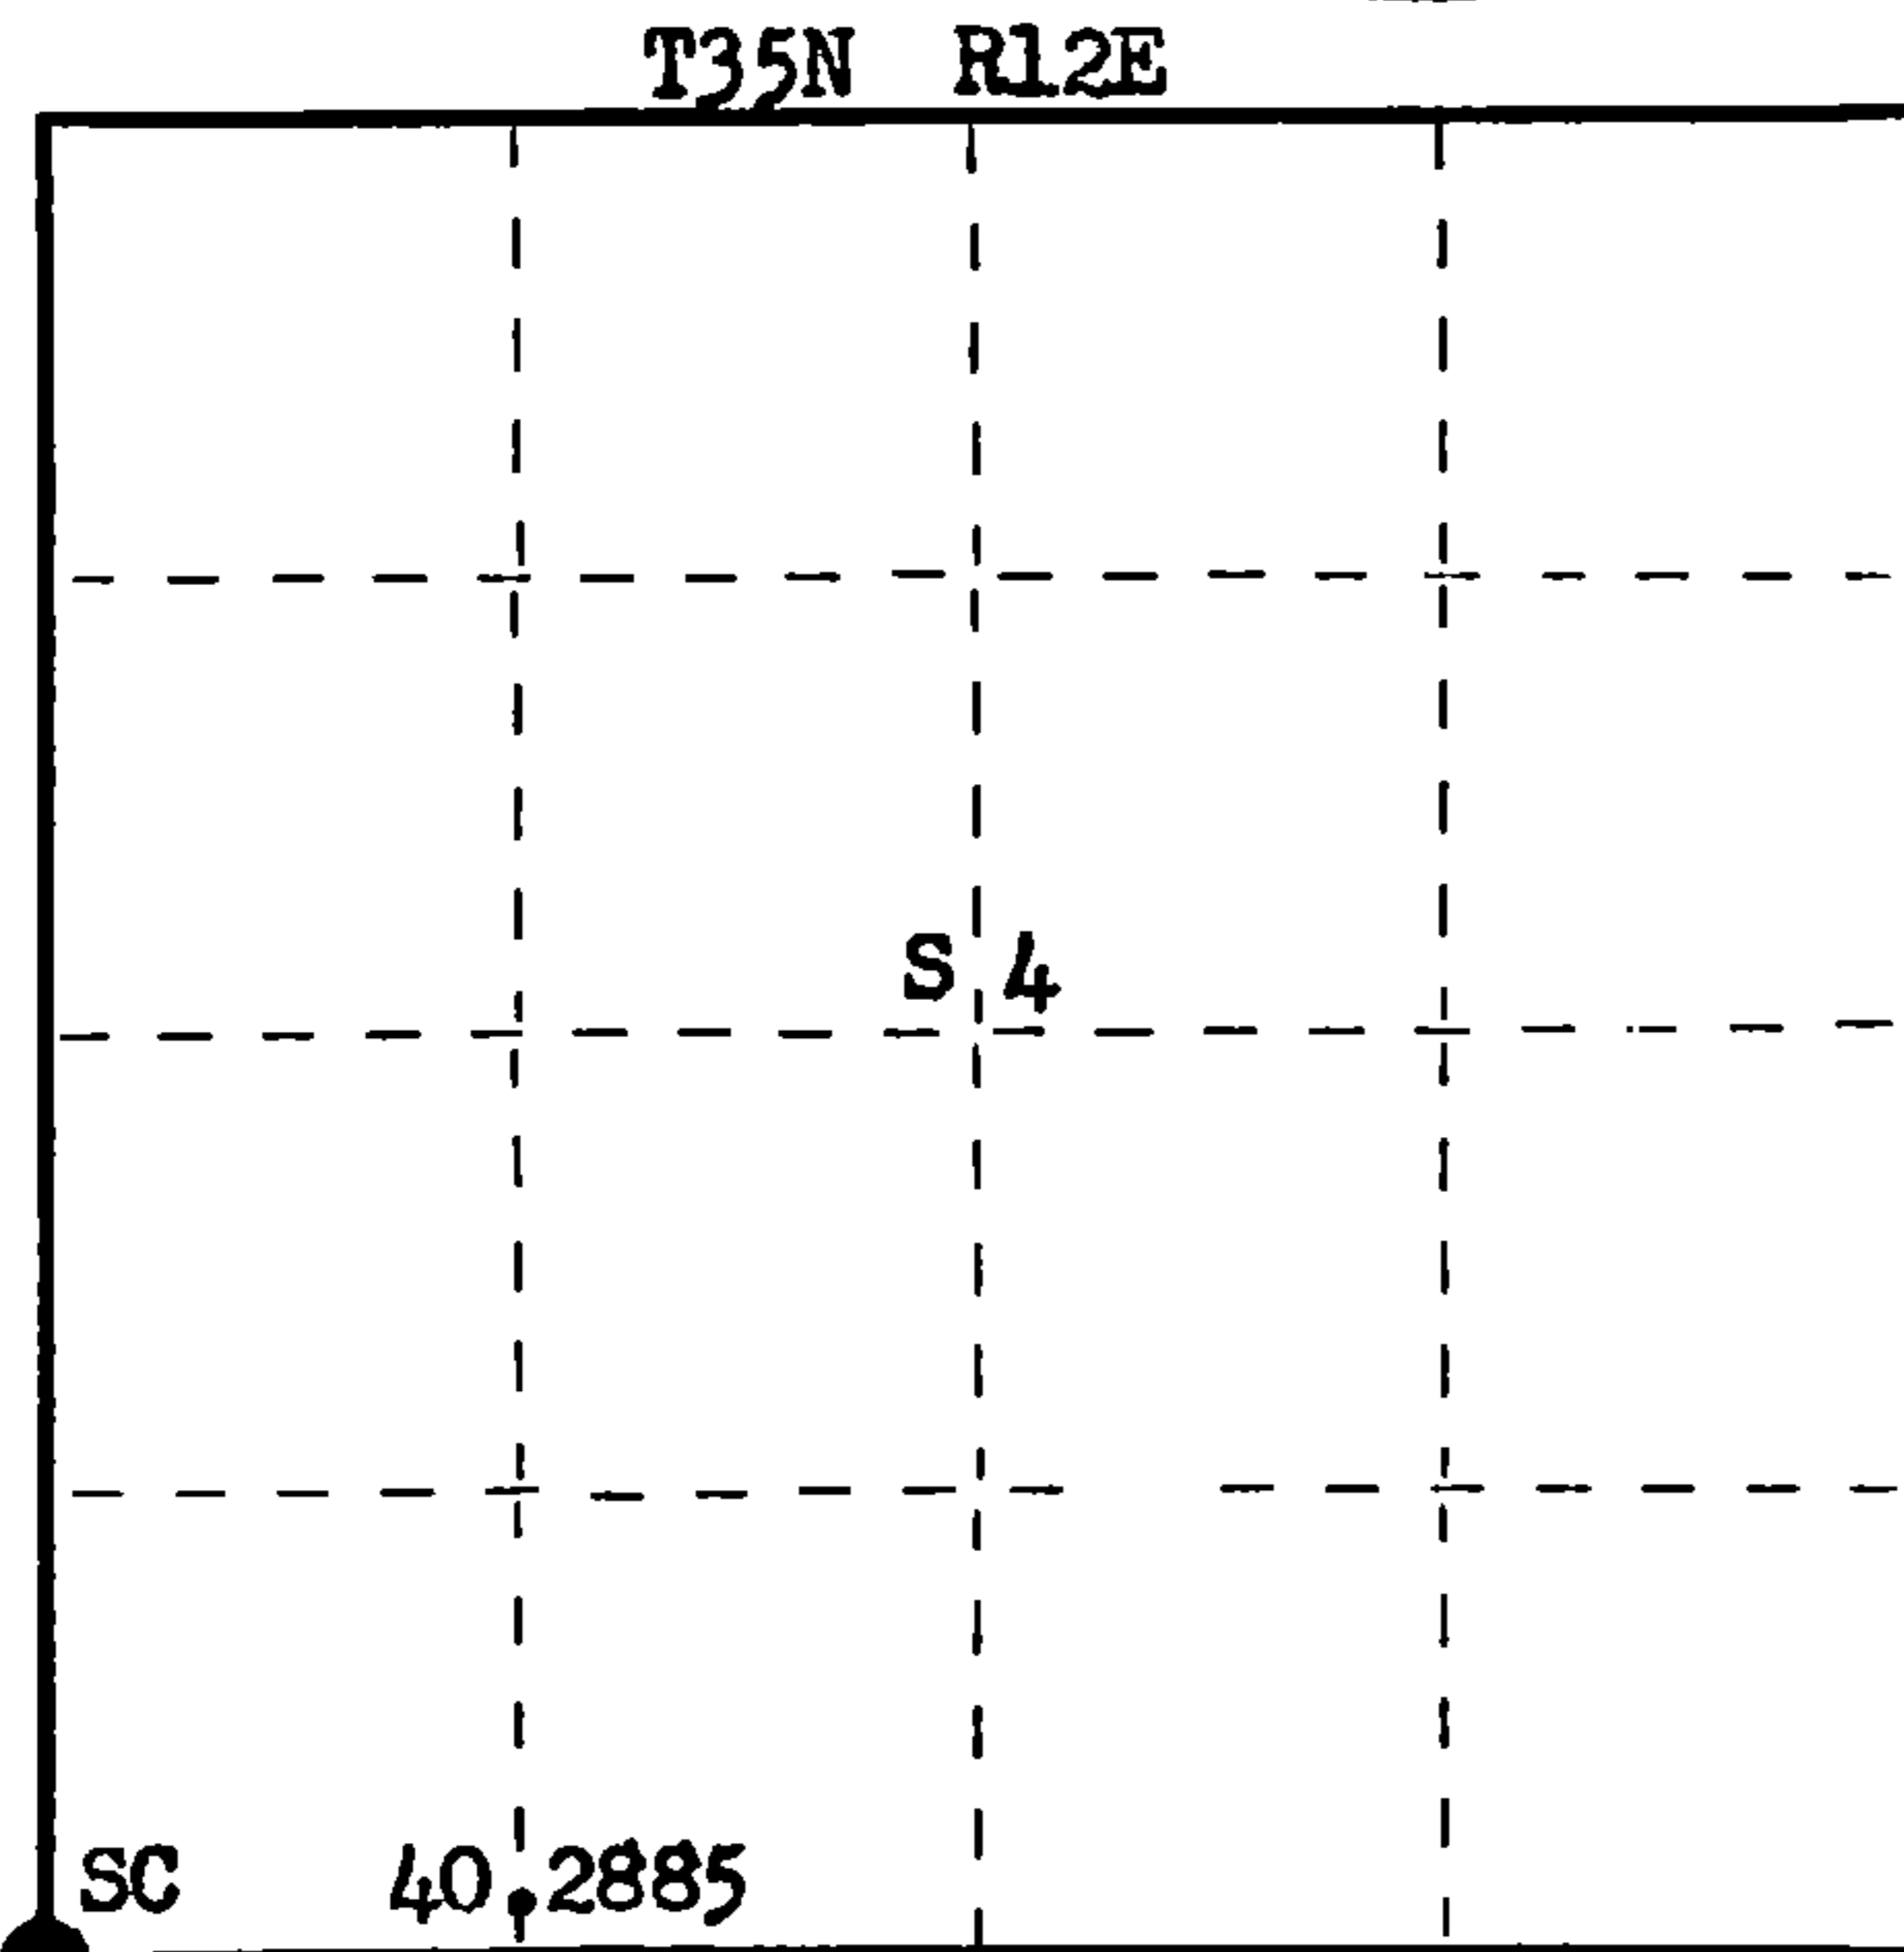

○ = Corner monument restored.

History of original corner establishment:

Original Corner established by Wm. E. Dougherty, Deputy Surveyor, in 1859, from which Birch 12" bears N37°E, 4 links and Birch 10" bears N5°W, 20 links. No record of any subsequent survey made for this corner.

Description of corner evidence found:

No evidence of any corner or BTs found. Established corner by single proportion from 1/4 corner between Section 4 and 9 and Section Corner 7, 8, 5 and 6. Ran traverse from re-established 1/4 corner to Section Corner. Computed and proportioned distance 40.2885 chains at S87° 48' 11" W and 80.577 chains N87° 48' 11" E of Section Corner 5, 6, 7 & 8.

Description of monument and accessories I established to perpetuate the original location of this corner.

Set 2 1/2" Berntsen A-1 Federal Monument, aluminum with magnet installed in cap and base. Monument projects 12" above ground - cap stamped:

- Marked NBTs - Sugar 12" S22°E, 6.2 links, scribed SC BT.
- Sugar 8" S56°W, 33.2 links, scribed SC BT.
- Sugar 7" N52°W, 63 links, scribed SC BT.
- W.Ash 10" N86°E, 63.1 links, scribed SC BT.

T35N R12E  
Sec. 5+4  
8+9  
S498-1977

Dated at Rhineland, Wis., this 31st day of May, 1977

Signature Philip T. Hansen Title Registered Land Surveyor Registration No. S-498  
(County Surveyor, Registered Land Surveyor, or other duly authorized official)

Office of Register of Deeds, County of Forest, I hereby certify that the within instrument was filed in this office for record on the 6th day of July, 1977 at 3:30 o'clock P. M.

Eugene Staszny  
(Register of Deeds)

By \_\_\_\_\_ Deputy

DOCUMENT NUMBER  
**111817**

4351205000