

CERTIFIED LAND CORNER RESTORATION

Index No. E-8

State of Wisconsin }
County of Forest } ss.


I Philip T. Hansen, do hereby certify that on the 25th day of May, 1977, I ~~found~~ ^{established} evidence of the E 1/16 corner of Section 5 & 8 Township 35, North, Range 12 East, Fourth Principal Meridian, as described hereon; and that from this evidence I established a new monument and accessories as described hereon to perpetuate the original location of this corner.

Resident witnesses:


Glen Barker

Jim Claflin

Herb Wagoner

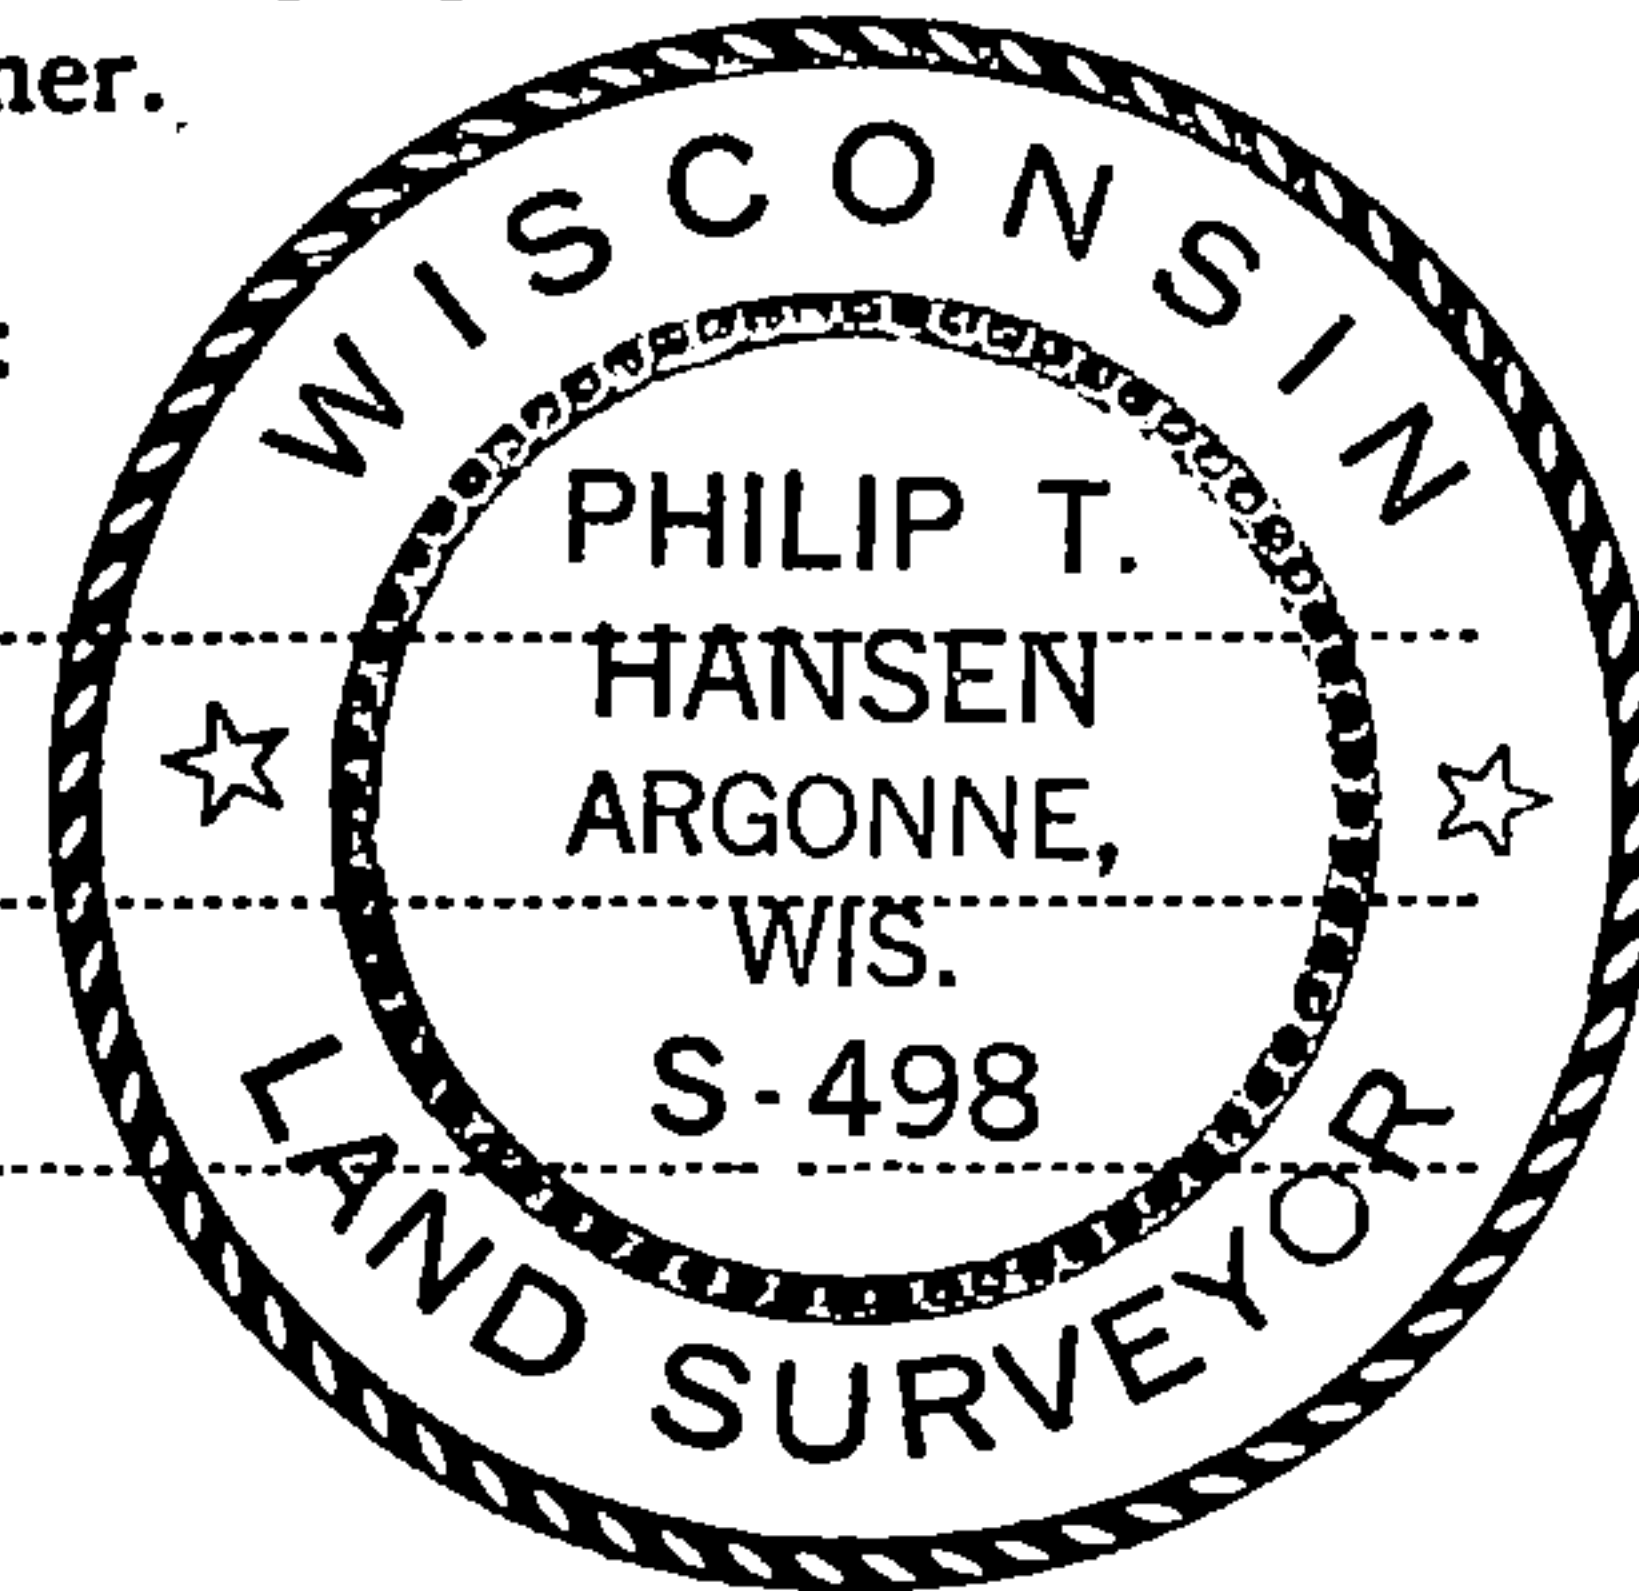

T35N R12E

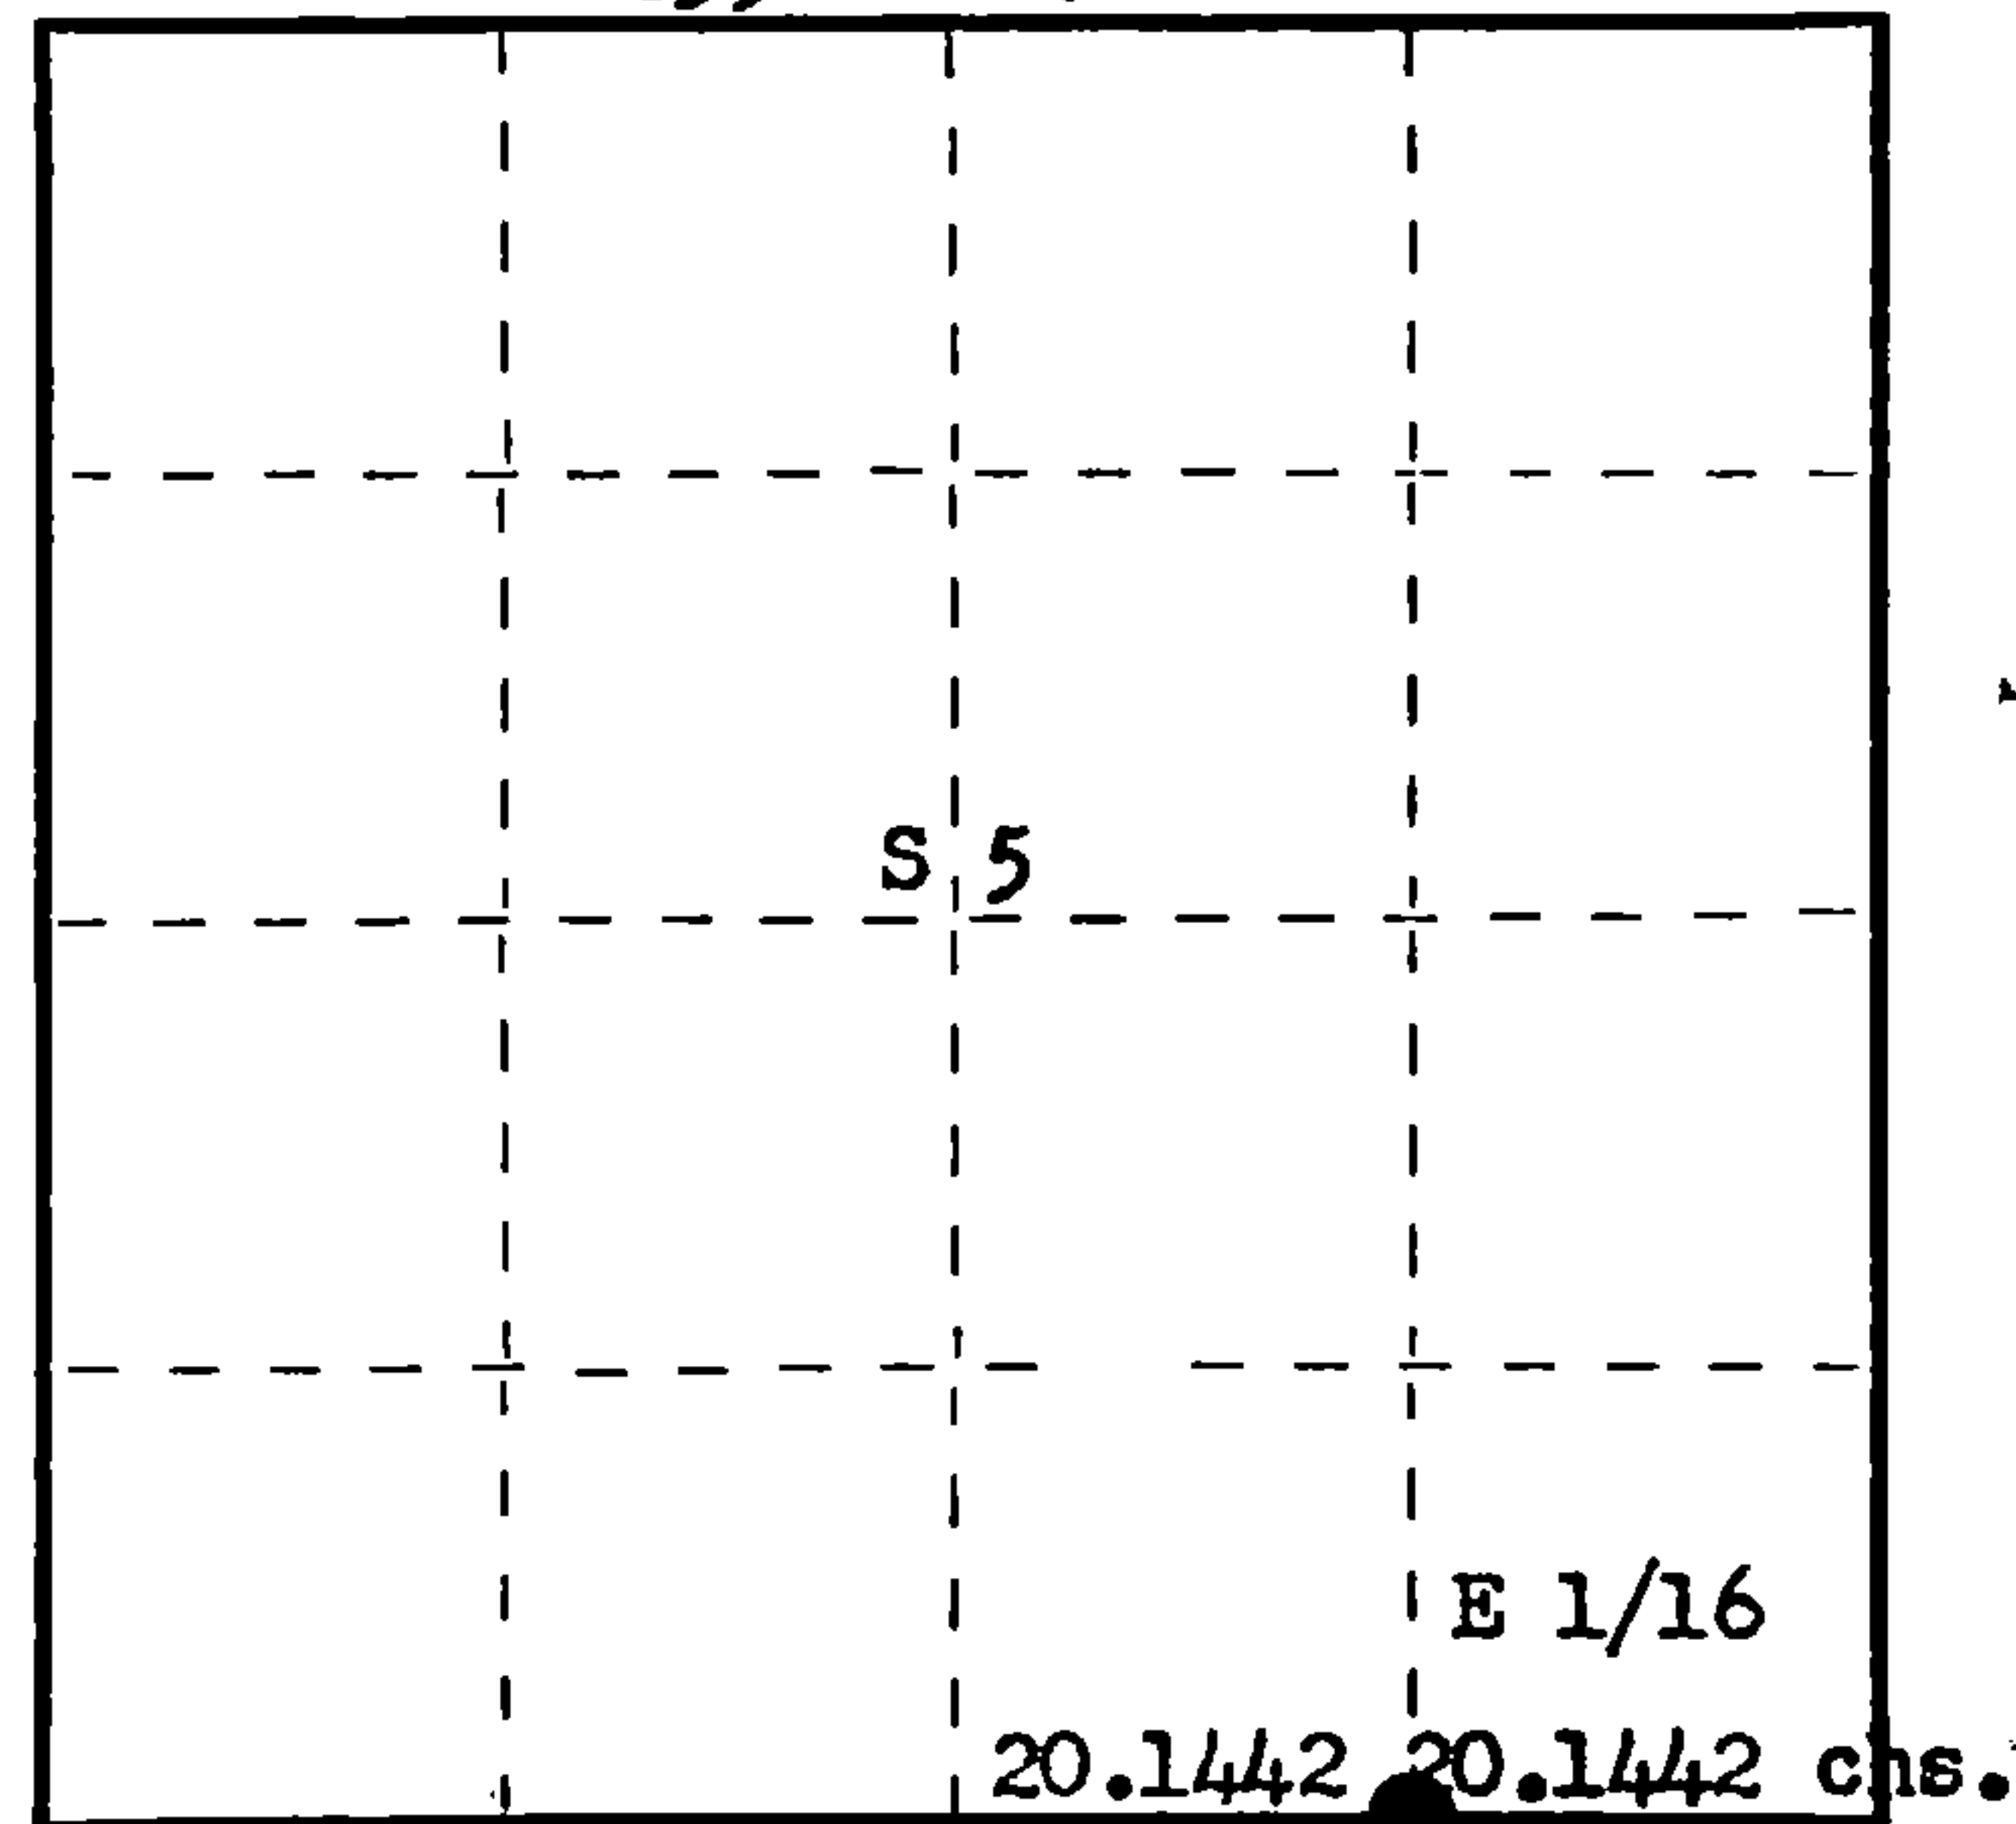

○ = Corner monument restored.

History of original corner establishment:
No records available on surveys for this corner.

Description of corner evidence found:
Corner established by proportion. Ran traverse from Section Corner 4,5,8 & 9 west to Section Corner 5,6,7 & 8. Computed distance 5318.086 ft. (80.577 chains). Set 1/4 corner equidistant at 40.2885 chains and set E 1/16 at 20.1442 chains, equidistant, bearing of line S 87° 48' 11" W.

Description of monument and accessories I established to perpetuate the original location of this corner.
Set 1 1/2" iron pipe with 2" brass cap - stamped:
Monument projects 18" above ground.
Marked NBTs - Maple 10" S24°E, 22.2 links, scribed 1/16 BT.
Black Spruce 7" N87°E, 10.1 links, scribed 1/16 BT.

S498
T35N R12E
E 1/16 S + 5
S + 8
CPI-1977

Dated at Rhineland, Wis., this 31st day of May, 1977

Signature Philip T. Hansen Title Registered Land Surveyor Registration No. S-498
(County Surveyor, Registered Land Surveyor, or other duly authorized official)

Office of Register of Deeds, County of Forest, I hereby certify that the within instrument was filed in this office for record on the 6TH day of July, 1977 at 3:30 o'clock P. M.

Eugene Staszny
(Register of Deeds)

By..... Deputy

DOCUMENT NUMBER
111816

FORM 985

43512050010