

CERTIFIED LAND CORNER RESTORATION

Index No. **D-8**



State of Wisconsin }  
County of Forest } ss.

I Philip T. Hansen, do hereby  
certify that on the 15th day  
of July, 19 77, I ~~found~~  
~~evidence of the~~ SE 1/16  
corner of Section 5  
Township 35, North, Range  
12 East, Fourth Principal Meridian,  
as described hereon; and that from this evidence  
I established a new monument and accessories  
as described hereon to perpetuate the original  
location of this corner.

Resident witnesses:

Glen Barker  
Jim Claflin  
Herb Wagoner

Phil Hansen

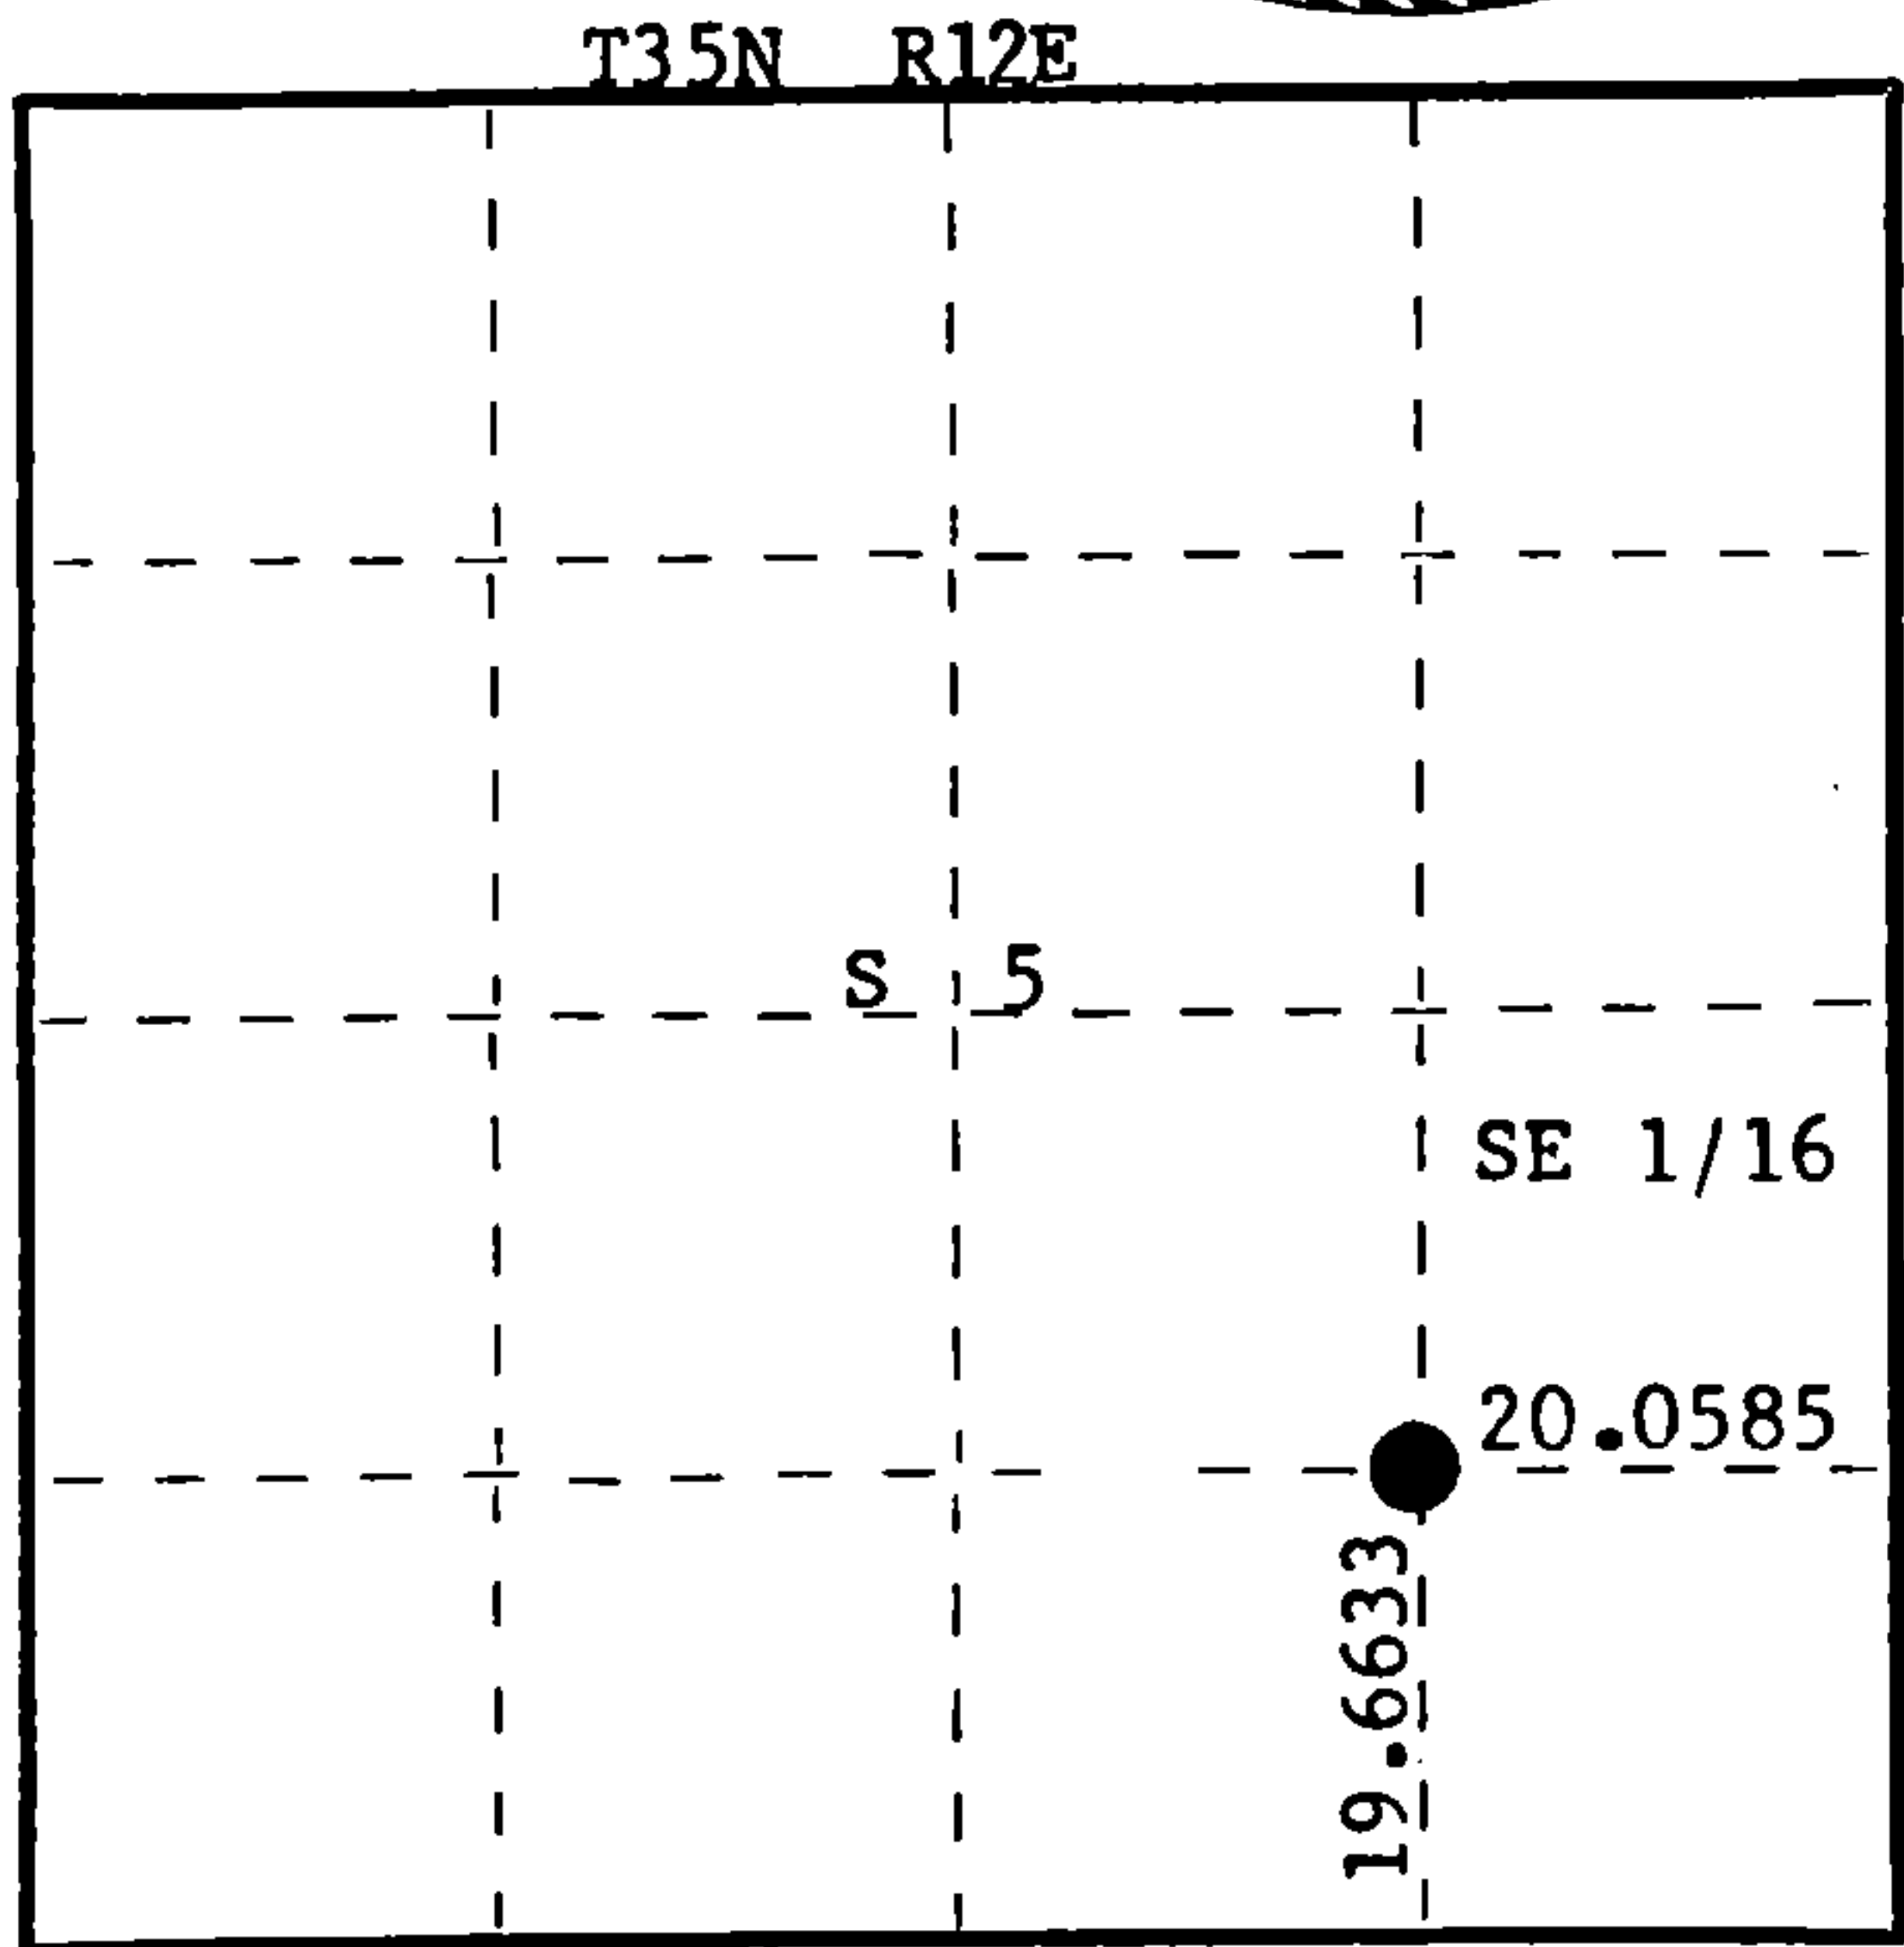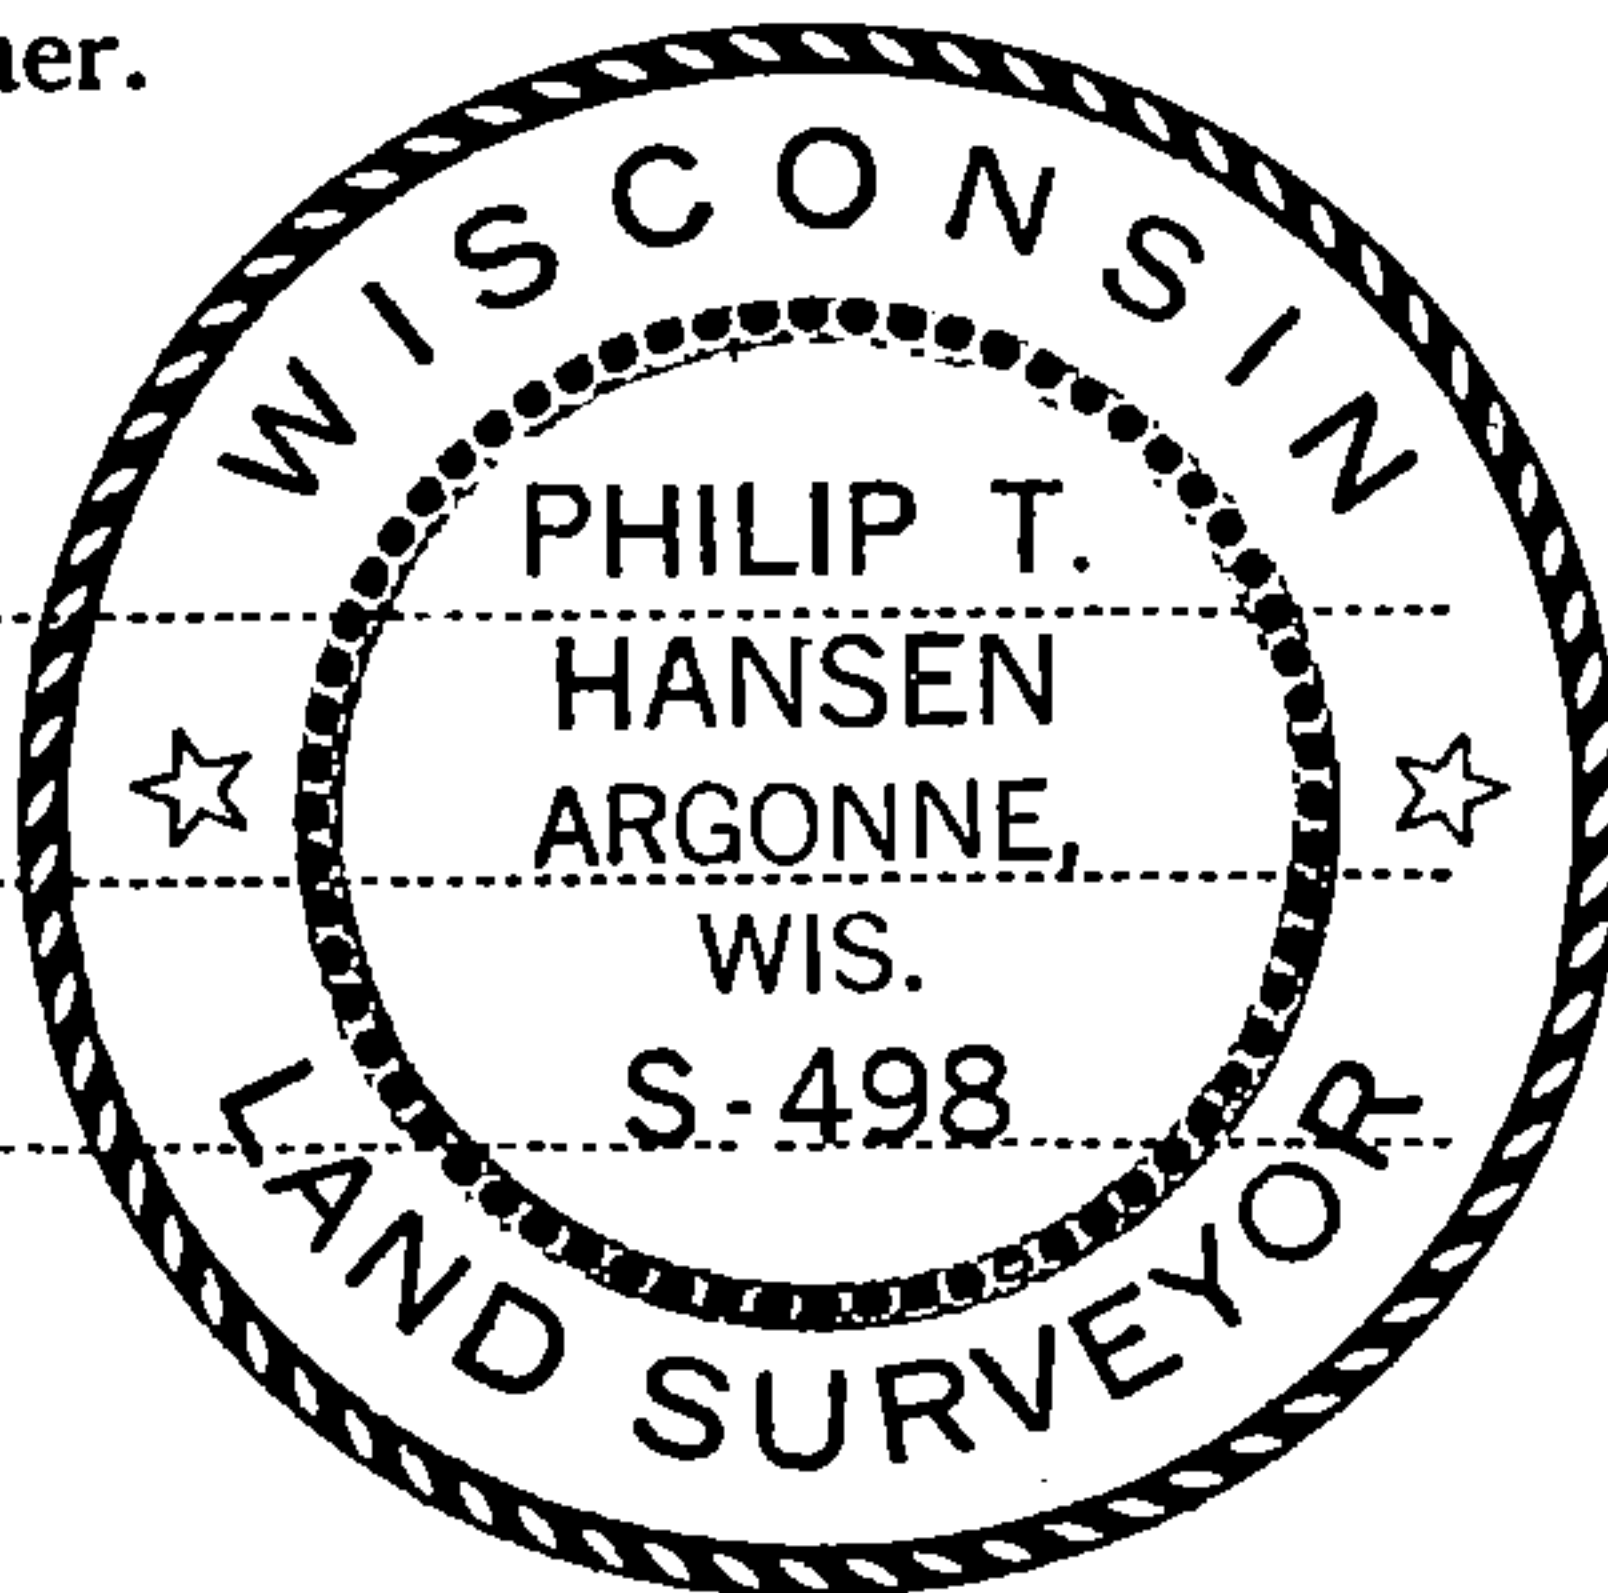

○ = Corner monument restored.

History of original corner establishment:

Corner established by subdivision from traverse computation. Ran traverse from SC 1/16 to point N 88° 10' 41" E a distance of 20.0585 chains to set SE 1/16 corner at intersection of N-S and E-W 1/4 lines of SE 1/4.

Description of corner evidence found:

No evidence of any corner previously established. Found old blazes on line immediately north of line.

Description of monument and accessories I established to perpetuate the original location of this corner.

Set 1½" iron pipe with 2" brass cap, stamped:

Monument projects 2' above ground.

Marked NBTs - Sugar 6" S47°W, 32.9 links.

Sugar 7" S37°E, 18.2 links, scribed 1/16 BT.

Corner sets just west of NW edge of old clearing.

S498  
T35N R12E  
SE 1/16 S + 5  
CPI-1977

Dated at Rhineland, Wis., this 21st day of July, 19 77

Signature Philip T. Hansen Title Registered Land Surveyor Registration No. S-498  
(County Surveyor, Registered Land Surveyor, or other duly authorized official)

Office of Register of Deeds, County of Forest, I hereby certify that the within  
instrument was filed in this office for record on the 9th day of August, 19 77  
at 11:45 o'clock A. M.

(Register of Deeds)

By \_\_\_\_\_ Deputy

DOCUMENT NUMBER  
**112061**