

CERTIFIED LAND CORNER RESTORATION

Index No. **C-7**

State of Wisconsin }
County of Forest } ss.


I Philip T. Hansen, do hereby certify that on the 18th day of July, 1977, I ~~found~~ established ~~at~~ the C 1/4 corner of Section 5 Township 35, North, Range 12 East, Fourth Principal Meridian, as described hereon; and that from this evidence I established a new monument and accessories as described hereon to perpetuate the original location of this corner.

Resident witnesses:


Glen Barker

Jim Claflin

Herb Wagoner

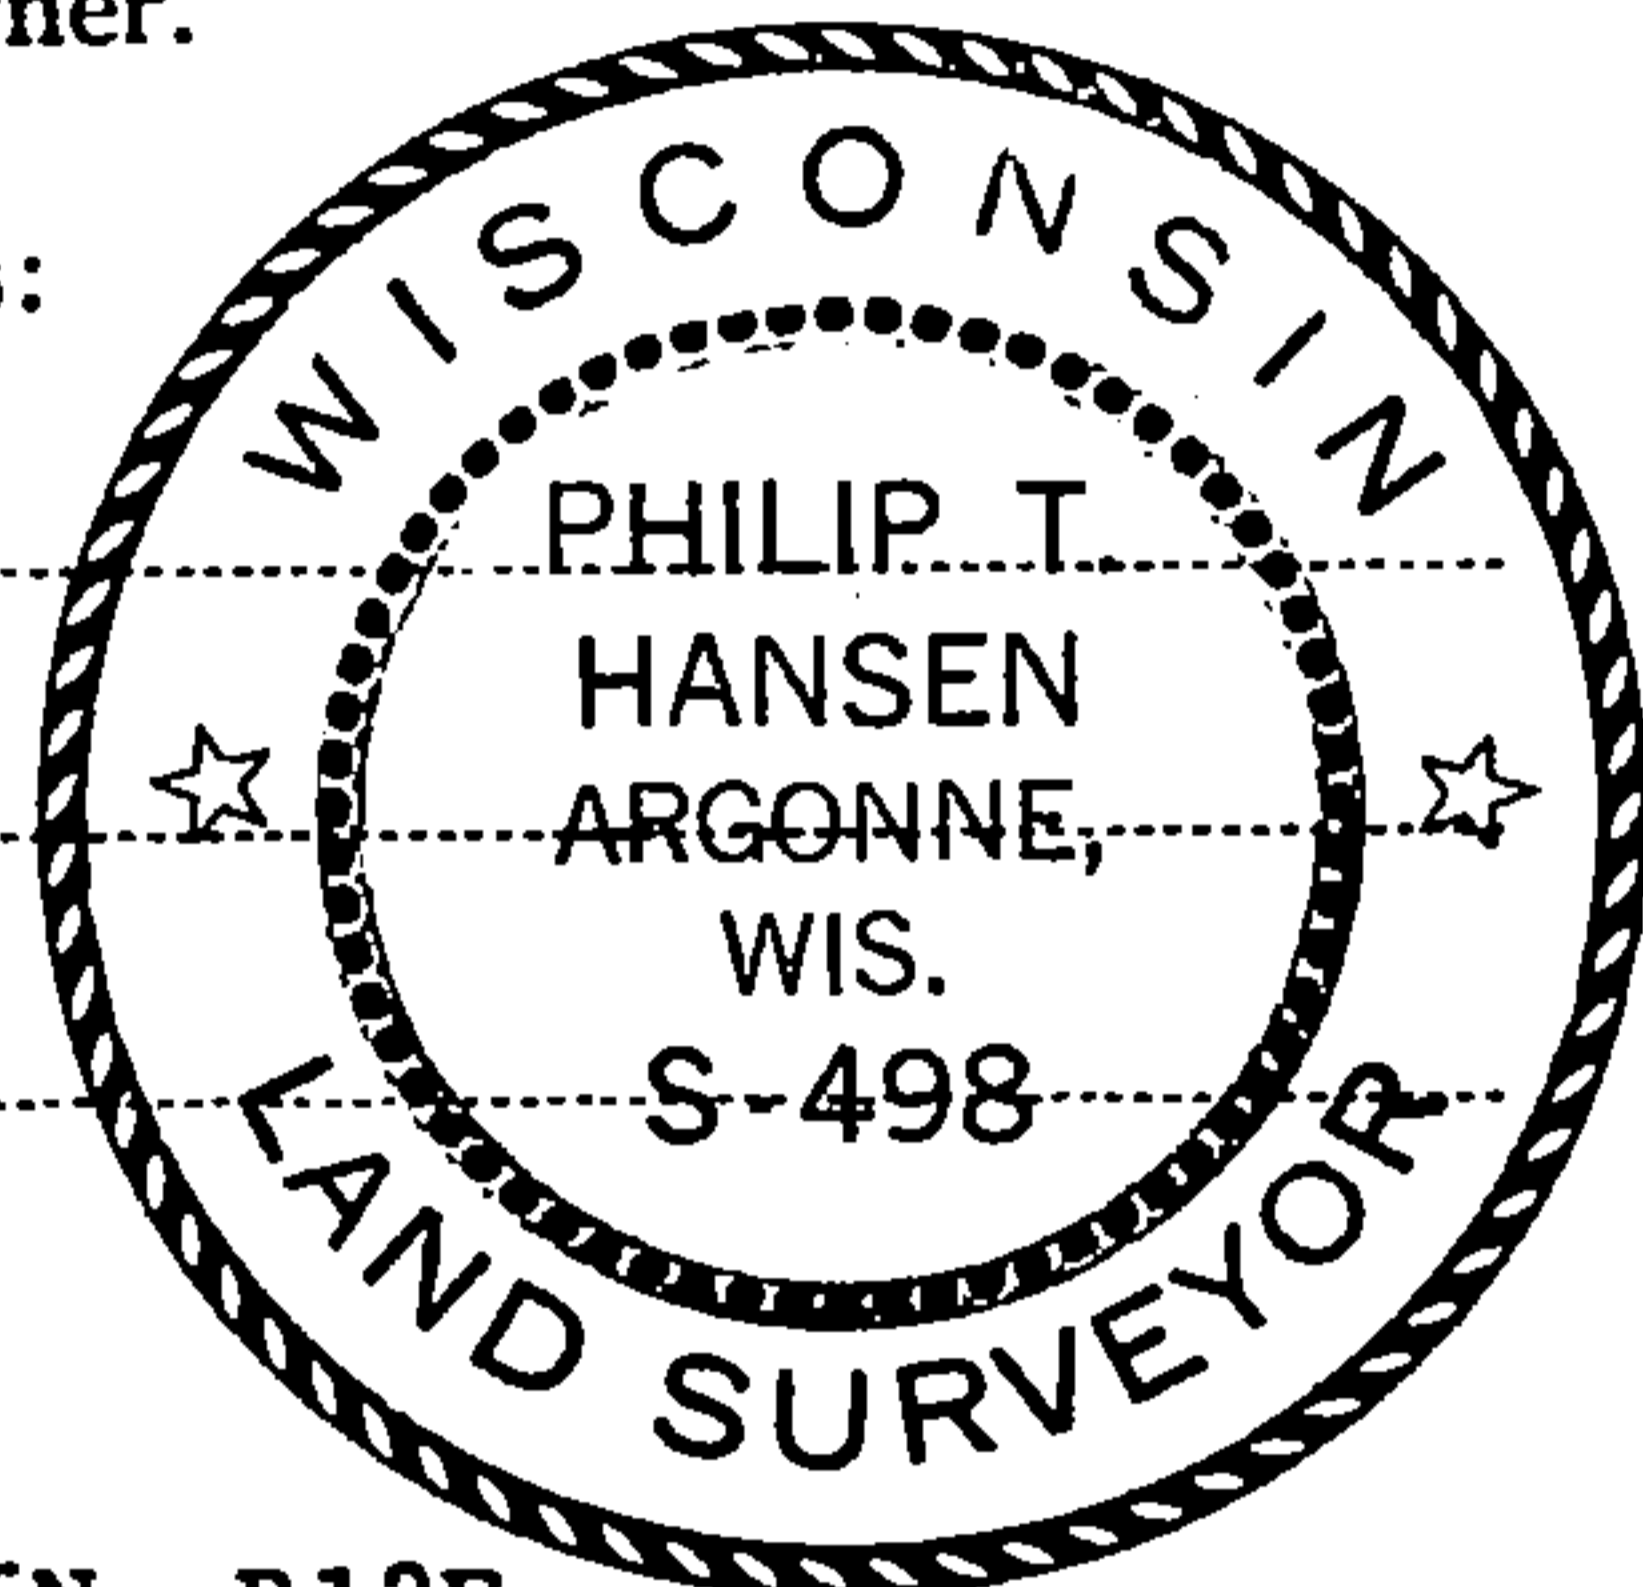

FORM 985 H. C. MILLER CO., MILWAUKEE

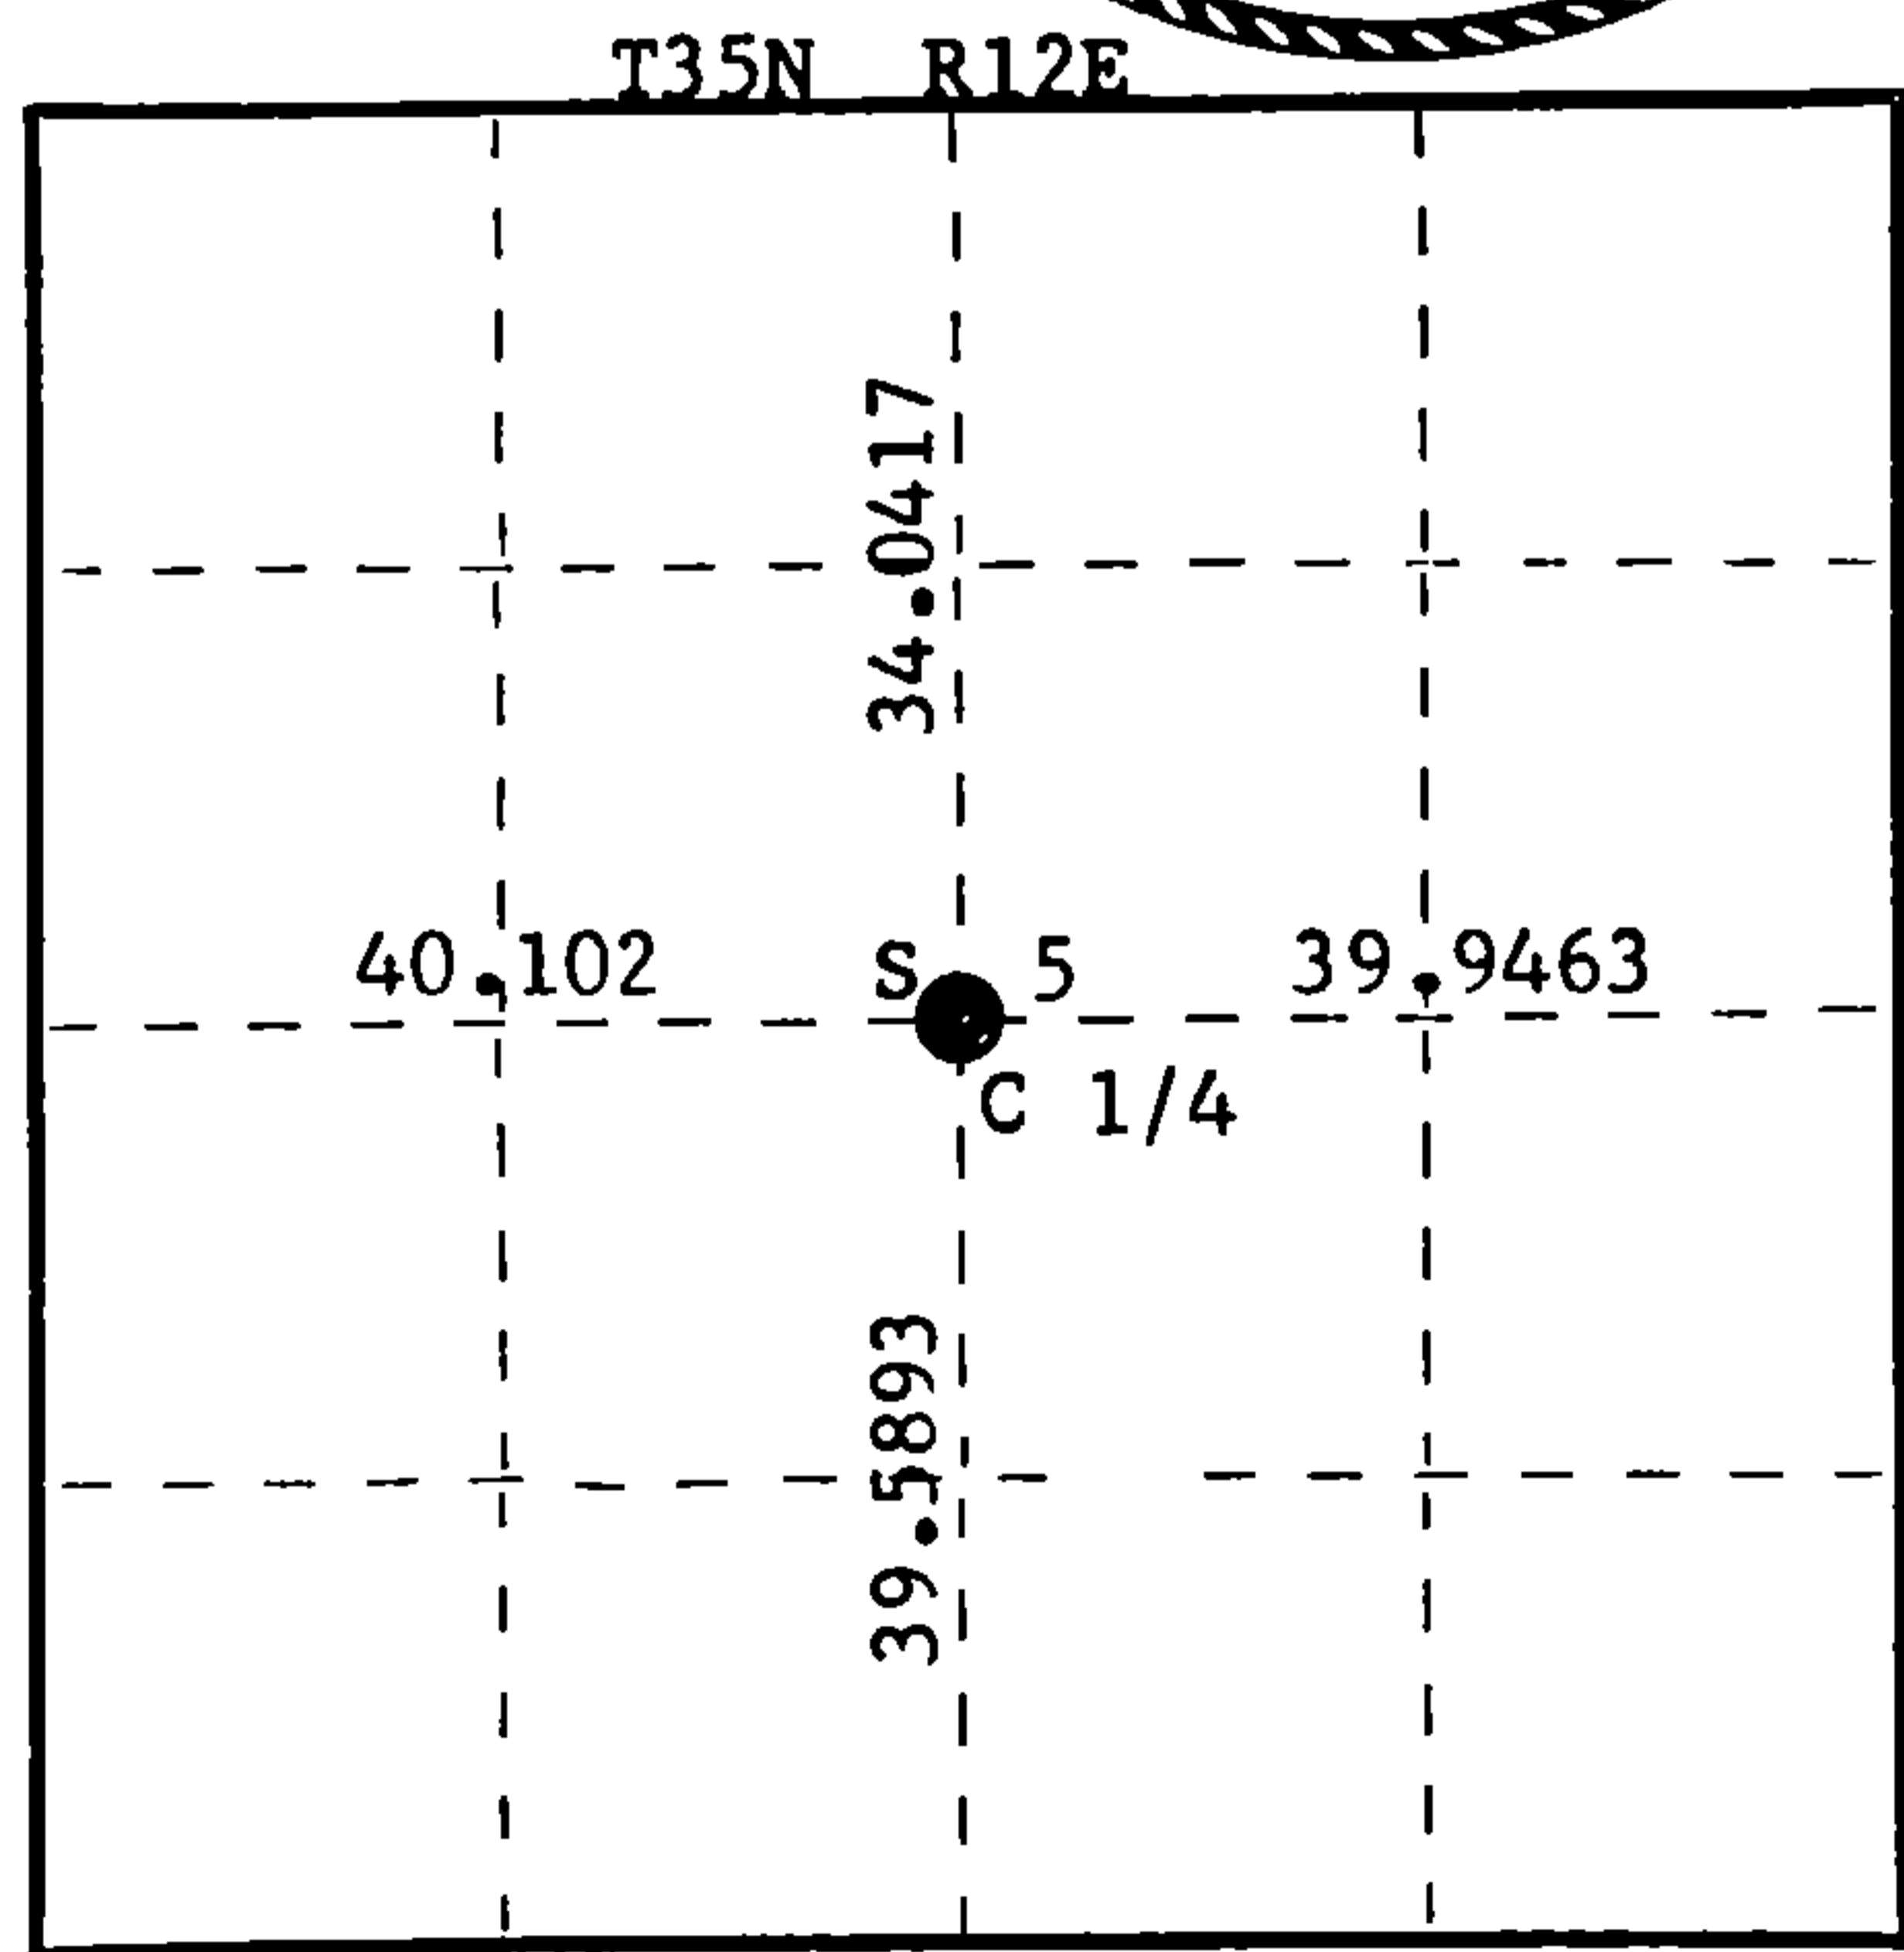

○ = Corner monument restored.

History of original corner establishment:

Corner established by subdivision from traverse of E-W and N-S 1/4 lines from previously established corners.
Set corner, 1 1/2" x 18" iron pipe driven 6" below surface on the east edge of Tower road (N-S) and in alignment with Valley Road west.

Description of corner evidence found:

No evidence of any corner recovered at this corner other than intersection of Valley Road west with N-S Tower Road.

Description of monument and accessories I established to perpetuate the original location of this corner.

Set a 2 1/2" Berntsen A-1 Federal Monument, aluminum with magnet in cap and base for witness corner 40 links east. Cap stamped:
Marked NBTs - Sugar 10" N6°E, 82.1 links, scribed 1/4 BT.
Sugar 10" S15°W, 126.3 links, scribed 1/4 BT.
Sign post, Tower Road S74°W, 69.2 links.

T35N R12E
W.C.
C 1/4 S 5
+

40 lks. W to Cor.
S498-1977

Dated at Rhineland, Wis., this 21st day of July, 1977

Signature Philip T. Hansen Title Registered Land Surveyor Registration No. S-498
(County Surveyor, Registered Land Surveyor, or other duly authorized official)

Office of Register of Deeds, County of Forest, I hereby certify that the within instrument was filed in this office for record on the 9th day of August, 1977 at 11:45 o'clock A. M.

Eugene Staszny
(Register of Deeds)

By _____ Deputy

DOCUMENT NUMBER
112060

43512052020