

CERTIFIED LAND CORNER RESTORATION

Index No. **C-6**

State of Wisconsin }
County of Forest } ss.


I Philip T. Hansen, do hereby certify that on the 17th day of July, 1977, I ~~found~~ established ~~the~~ WC 1/16 corner of Section 5 Township 35, North, Range 12 East, Fourth Principal Meridian, as described hereon; and that from this evidence I established a new monument and accessories as described hereon to perpetuate the original location of this corner.

Resident witnesses:


Glen Barker

Jim Claflin

Herb Wagoner

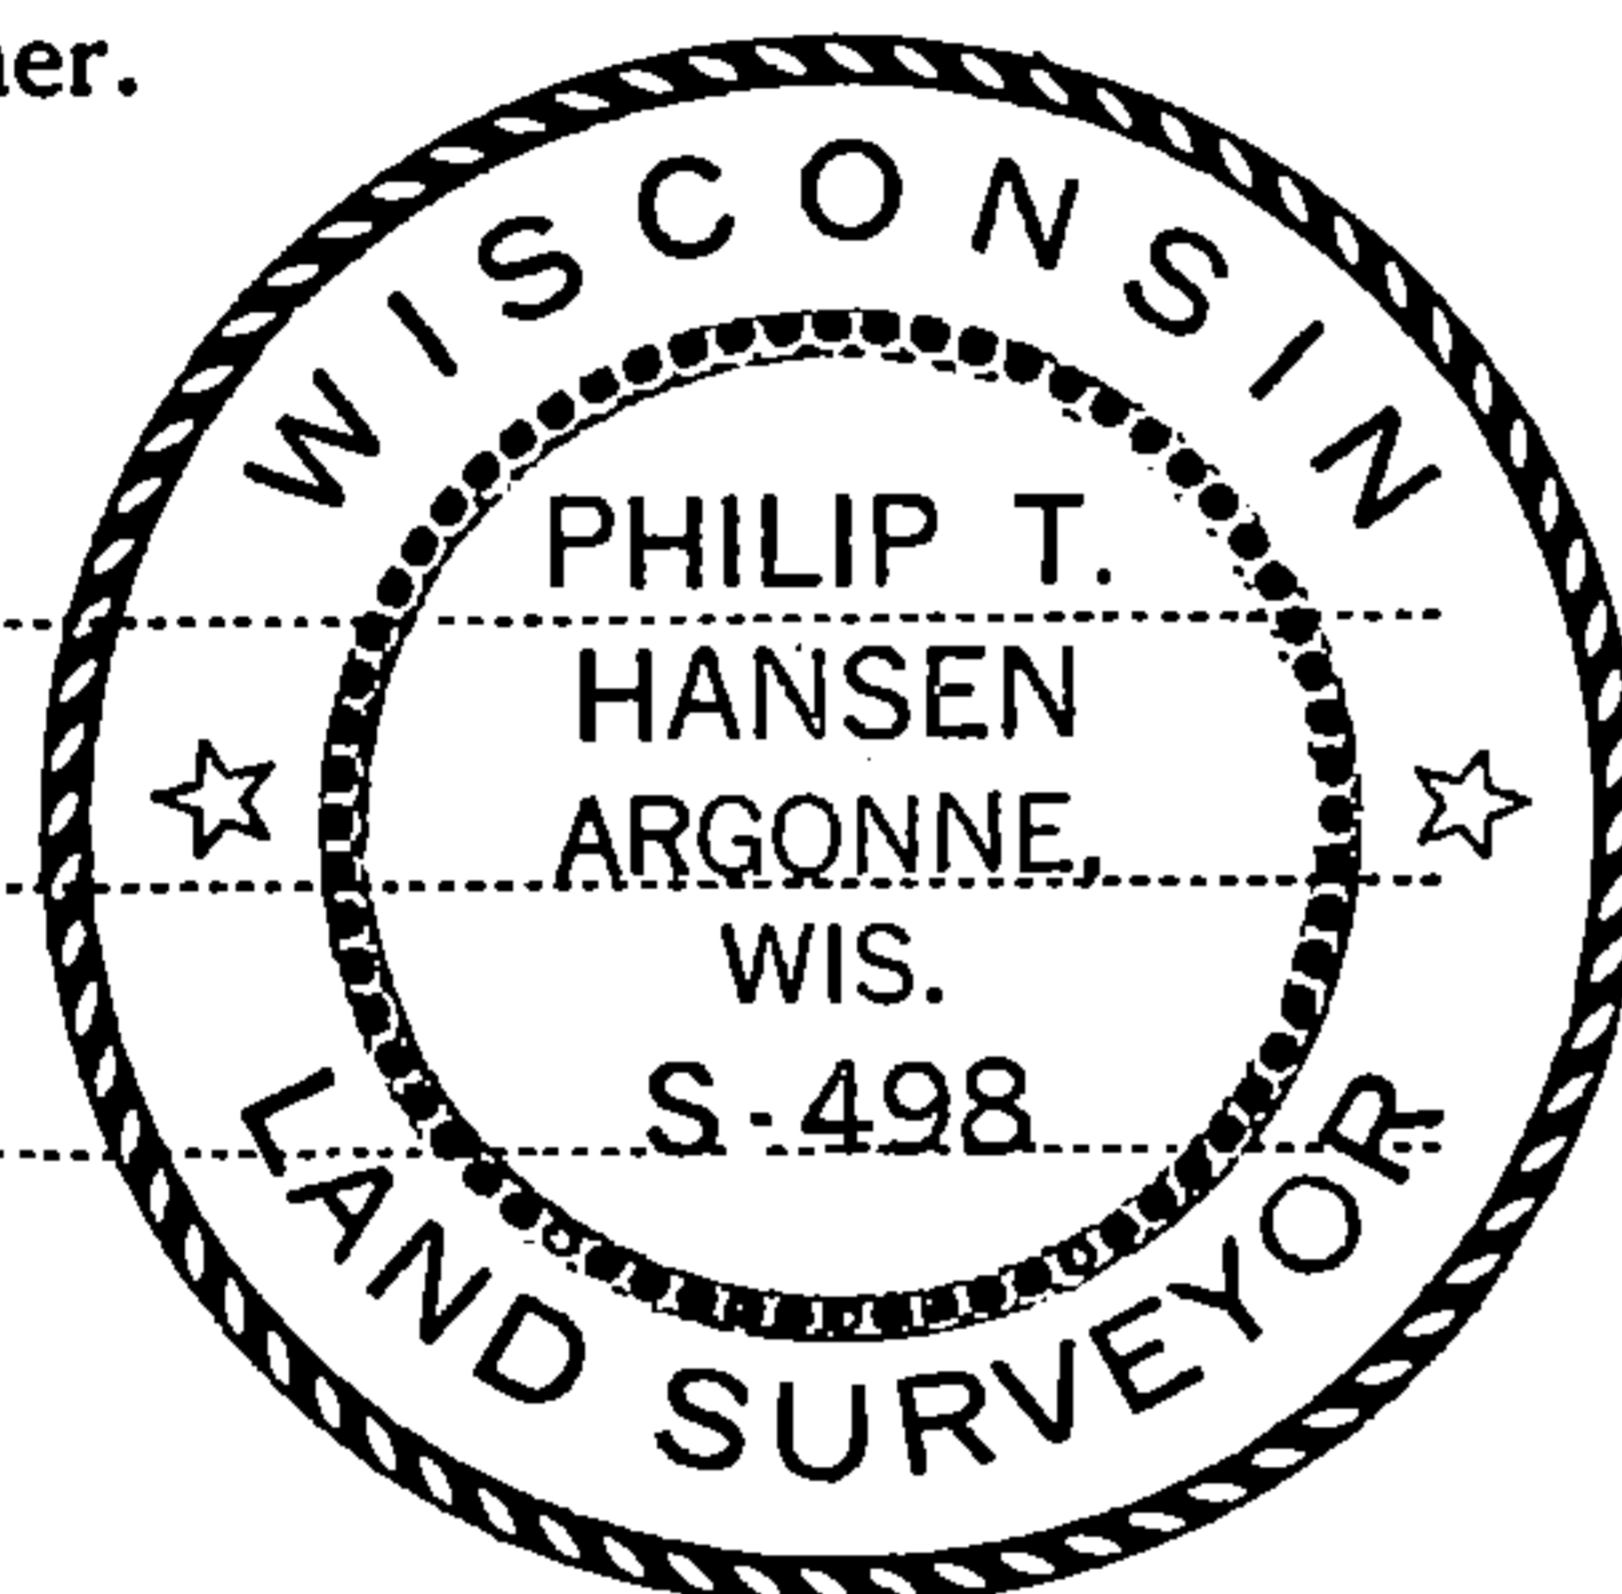

FORM 985 H. C. MILLER CO., MILWAUKEE

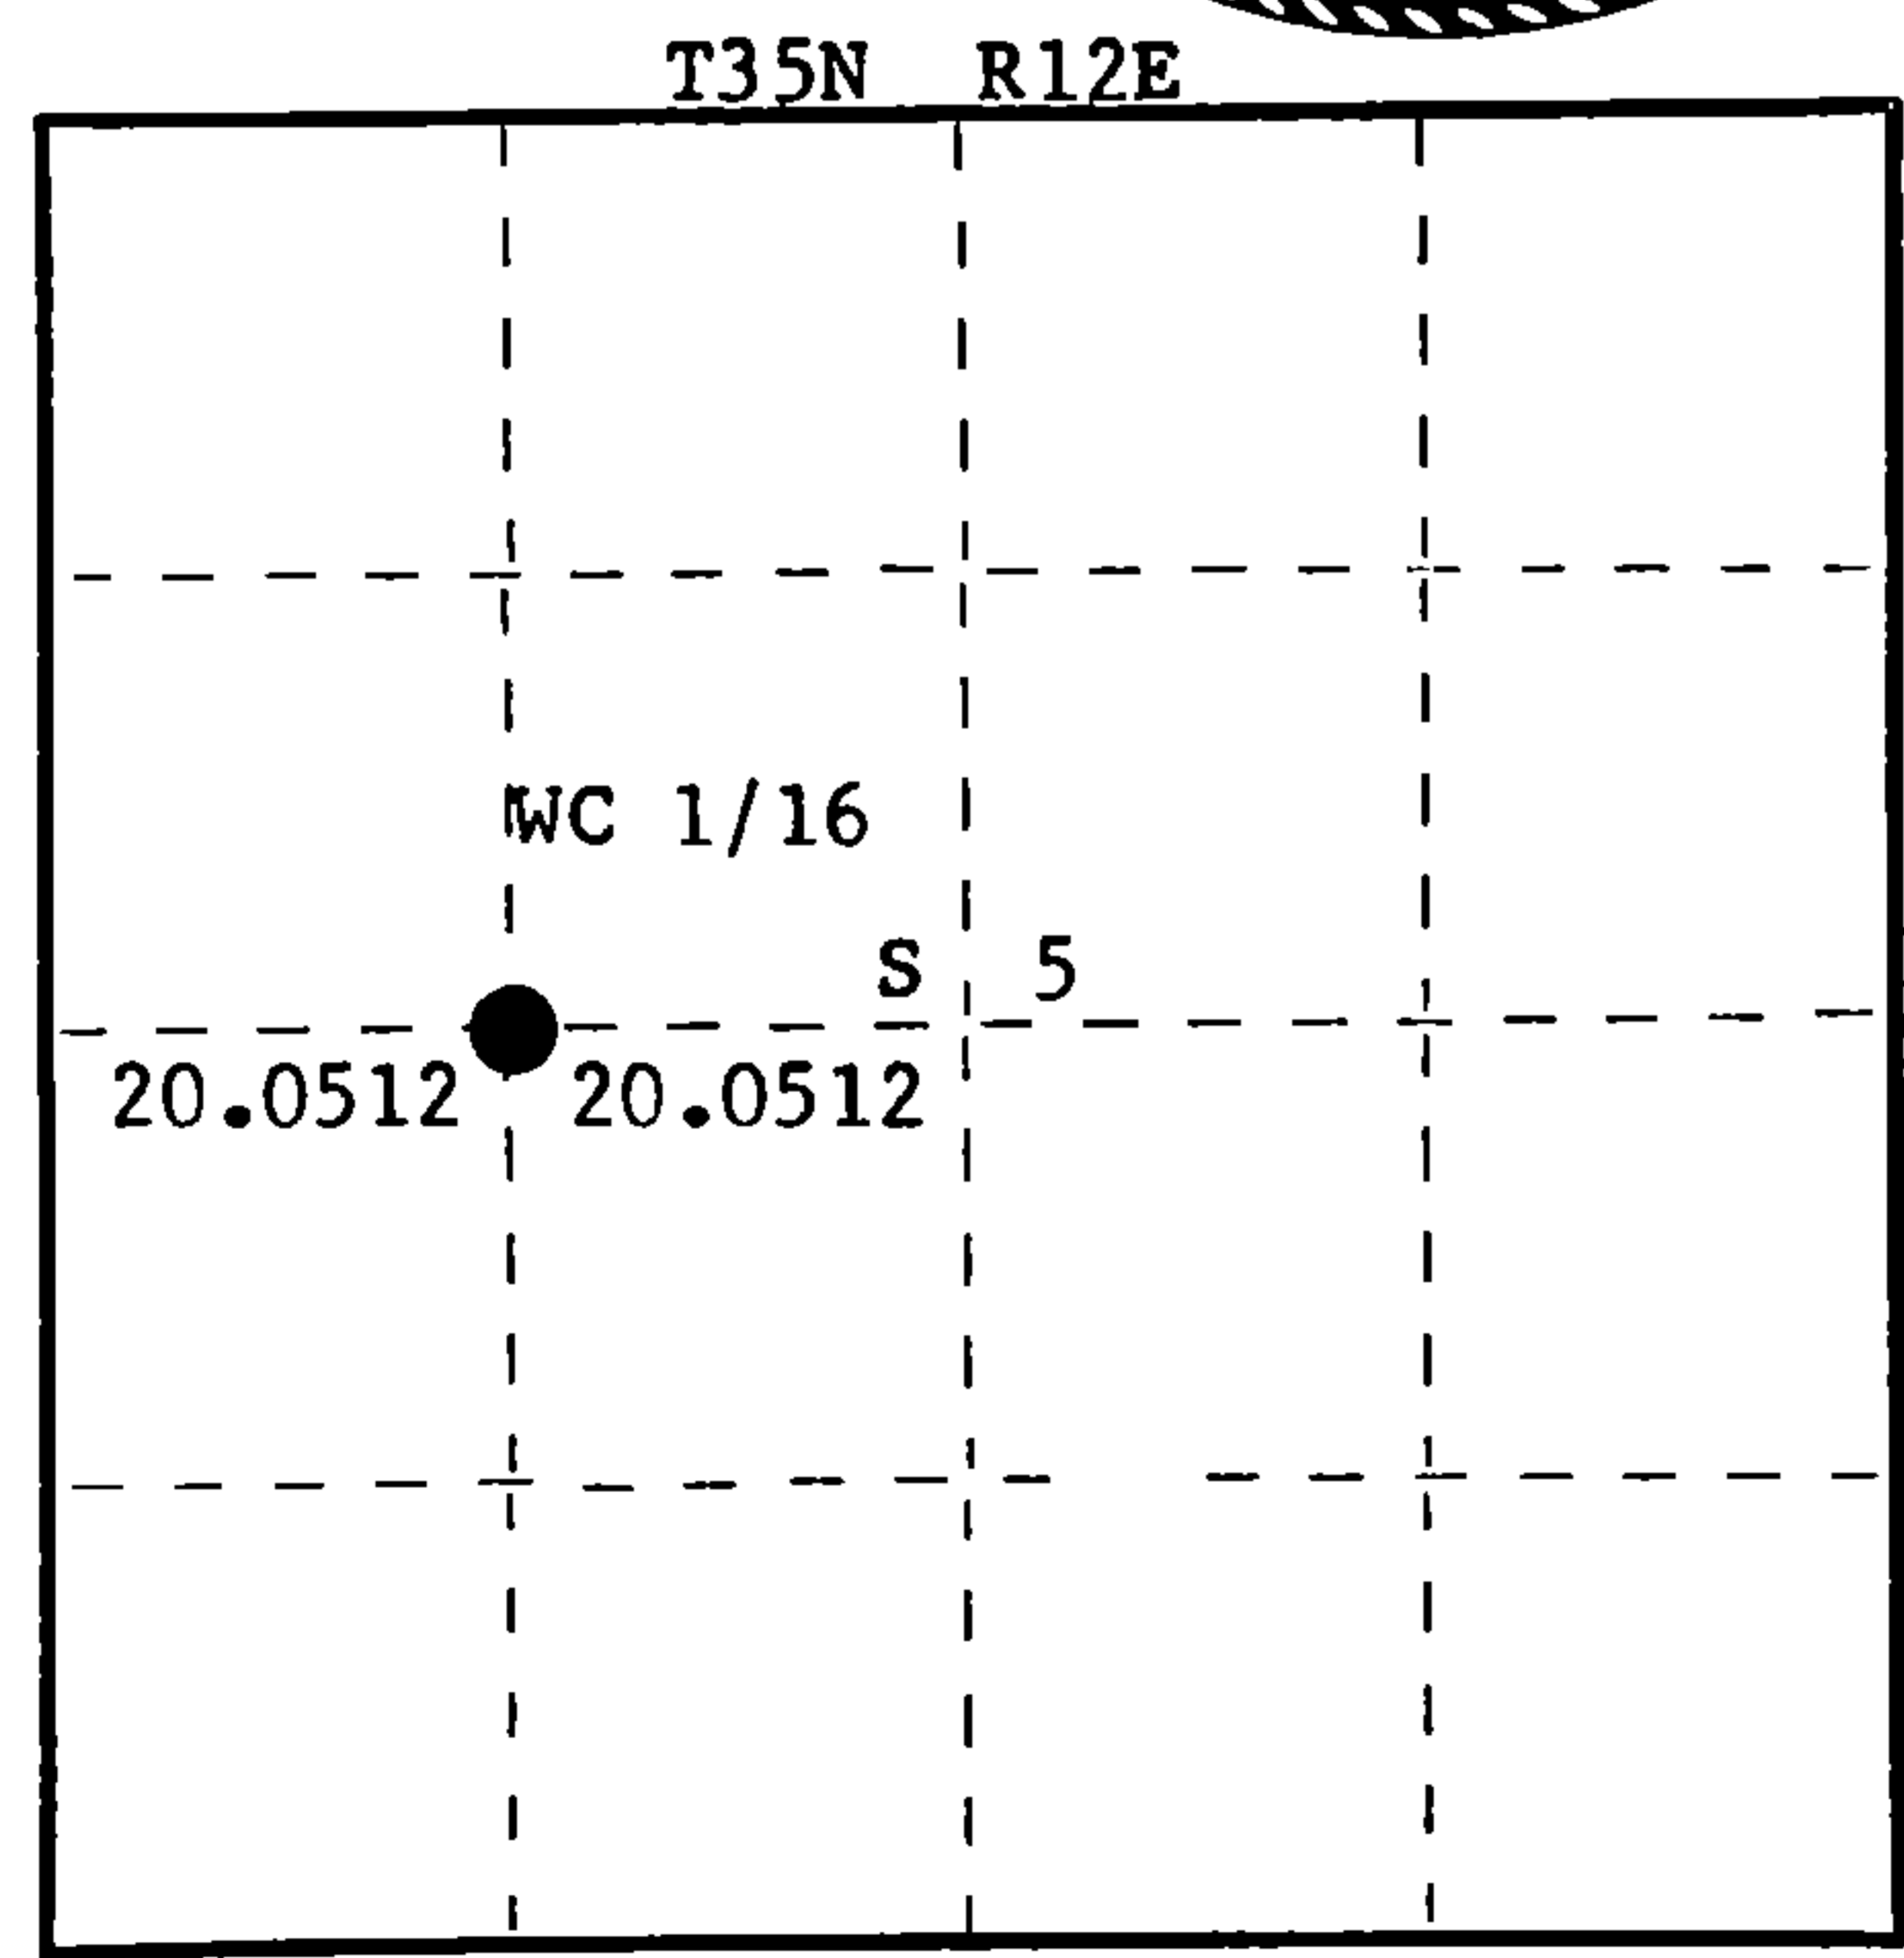

○ = Corner monument restored.

History of original corner establishment:

Corner established by subdivision from traverse computation. Ran traverse from N 1/4 corner to S 1/4 corner and E 1/4 to W 1/4 to establish the C 1/4 corner. Set WC 1/16 corner at 20.0512 chains N88° 26' 43" E intermediate between C 1/4 corner and W 1/4 corner.

Description of corner evidence found:

No evidence of any previous corner established.

Description of monument and accessories I established to perpetuate the original location of this corner.

Set a 1 1/2" x 18" iron pipe on the south edge of Valley Road, 5" below the surface.

Set a 1 1/2" iron pipe with brass cap for witness corner, 30 links south, stamped:

Monument projects 2 1/2' above ground.

Marked NBTs - Sugar 6" S63°W, 28 links, scribed 1/16 BT.

Sugar 8" N2°W, 67.2 links, scribed 1/16 BT.

S498
T35N R12E
WC 1/16 S +⁵ W.C.
N 30 lks
CPI-1977

Dated at Rhineland, Wis., this 21st day of July, 1977

Signature Philip T. Hansen Title Registered Land Surveyor Registration No. S-498
(County Surveyor, Registered Land Surveyor, or other duly authorized official)

Office of Register of Deeds, County of Forest, I hereby certify that the within instrument was filed in this office for record on the 9th day of August, 1977 at 11:45 o'clock A. M.

Eugene Stutzman
(Register of Deeds)
By _____ Deputy

DOCUMENT NUMBER
112059

43512052030