

CERTIFIED LAND CORNER RESTORATION

Index No. **B-7**

State of Wisconsin }  
County of Forest } ss.

I Philip T. Hansen, do hereby certify that on the 17th day of July, 1977, I ~~found~~ established ~~the~~ NC 1/16 corner of Section 5 Township 35, North, Range 12 East, Fourth Principal Meridian, as described hereon; and that from this evidence I established a new monument and accessories as described hereon to perpetuate the original location of this corner.

History of original corner establishment:

Corner established by subdivision from traverse computation from N 1/4 corner S 2° 03' 38" E to previously established C 1/4 corner. Set corner at 14.2471 chains south of N 1/4 and 19.7946 chains from C 1/4 corner.

Description of corner evidence found:


No evidence of any previous corner established.

Resident witnesses:

Glen Barker

Jim Claflin

Herb Wagoner

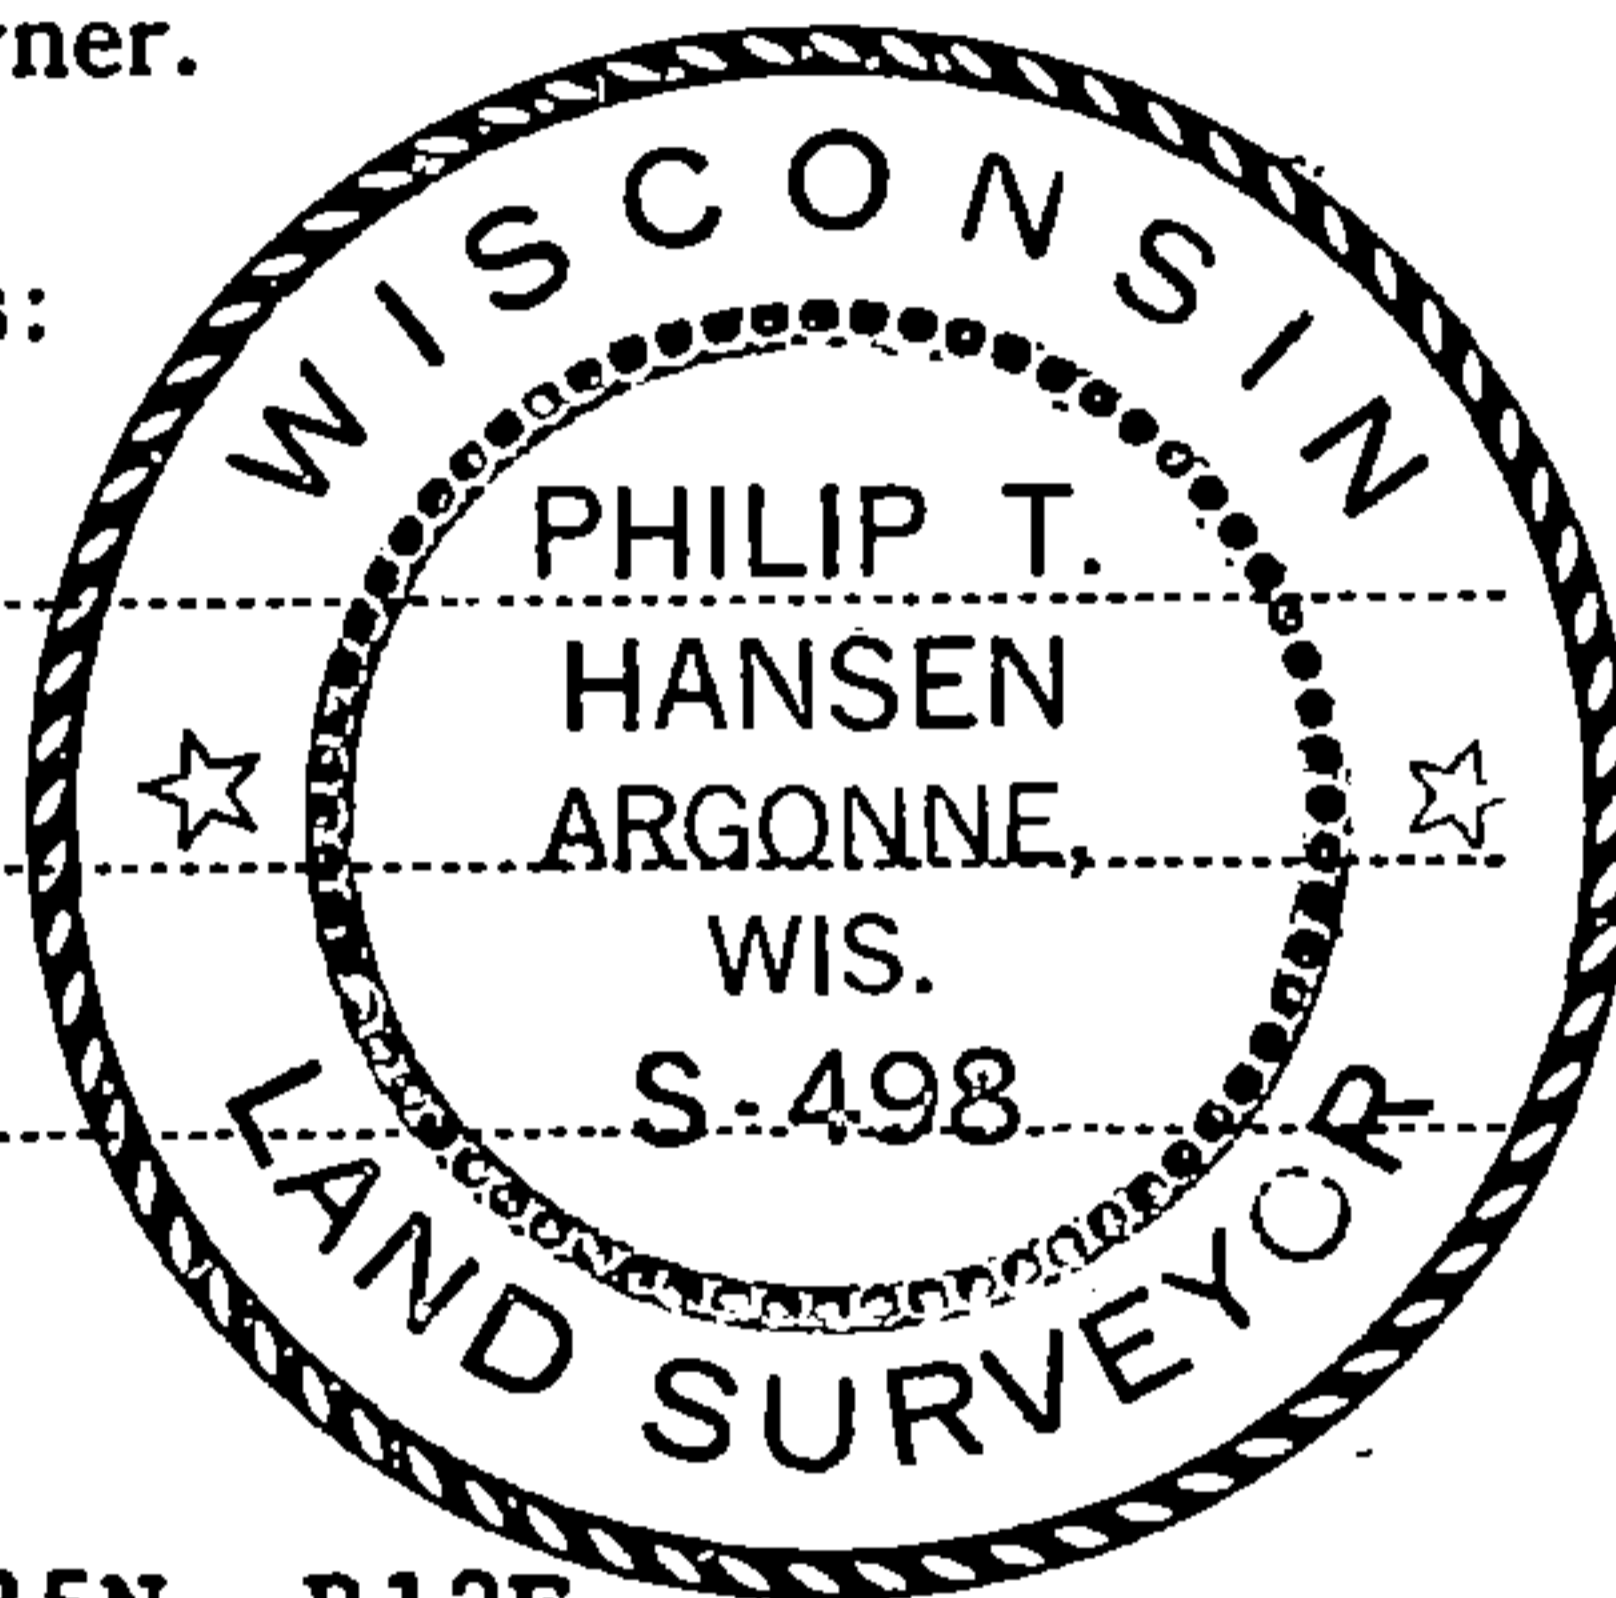

Description of monument and accessories I established to perpetuate the original location of this corner.

Set 1 1/2" x 18" iron pipe for corner in east ditch line of Tower Road, 5" below surface. Set a 1 1/2" iron pipe with 2" brass cap for witness corner 61 links west. Cap stamped: Monument projects 24" above ground.


Marked NBTs - Maple 8" S79°W, 51.1 links, scribed 1/16 BT.

Maple 6" S26°E, 72 links, scribed 1/16 BT.

S498  
T35N R12E  
NC 1/16 S 5 W.C.  
E 61 lks  
CPI-1977

FORM 985 H. C. MILLER CO., MILWAUKEE

T35N R12E

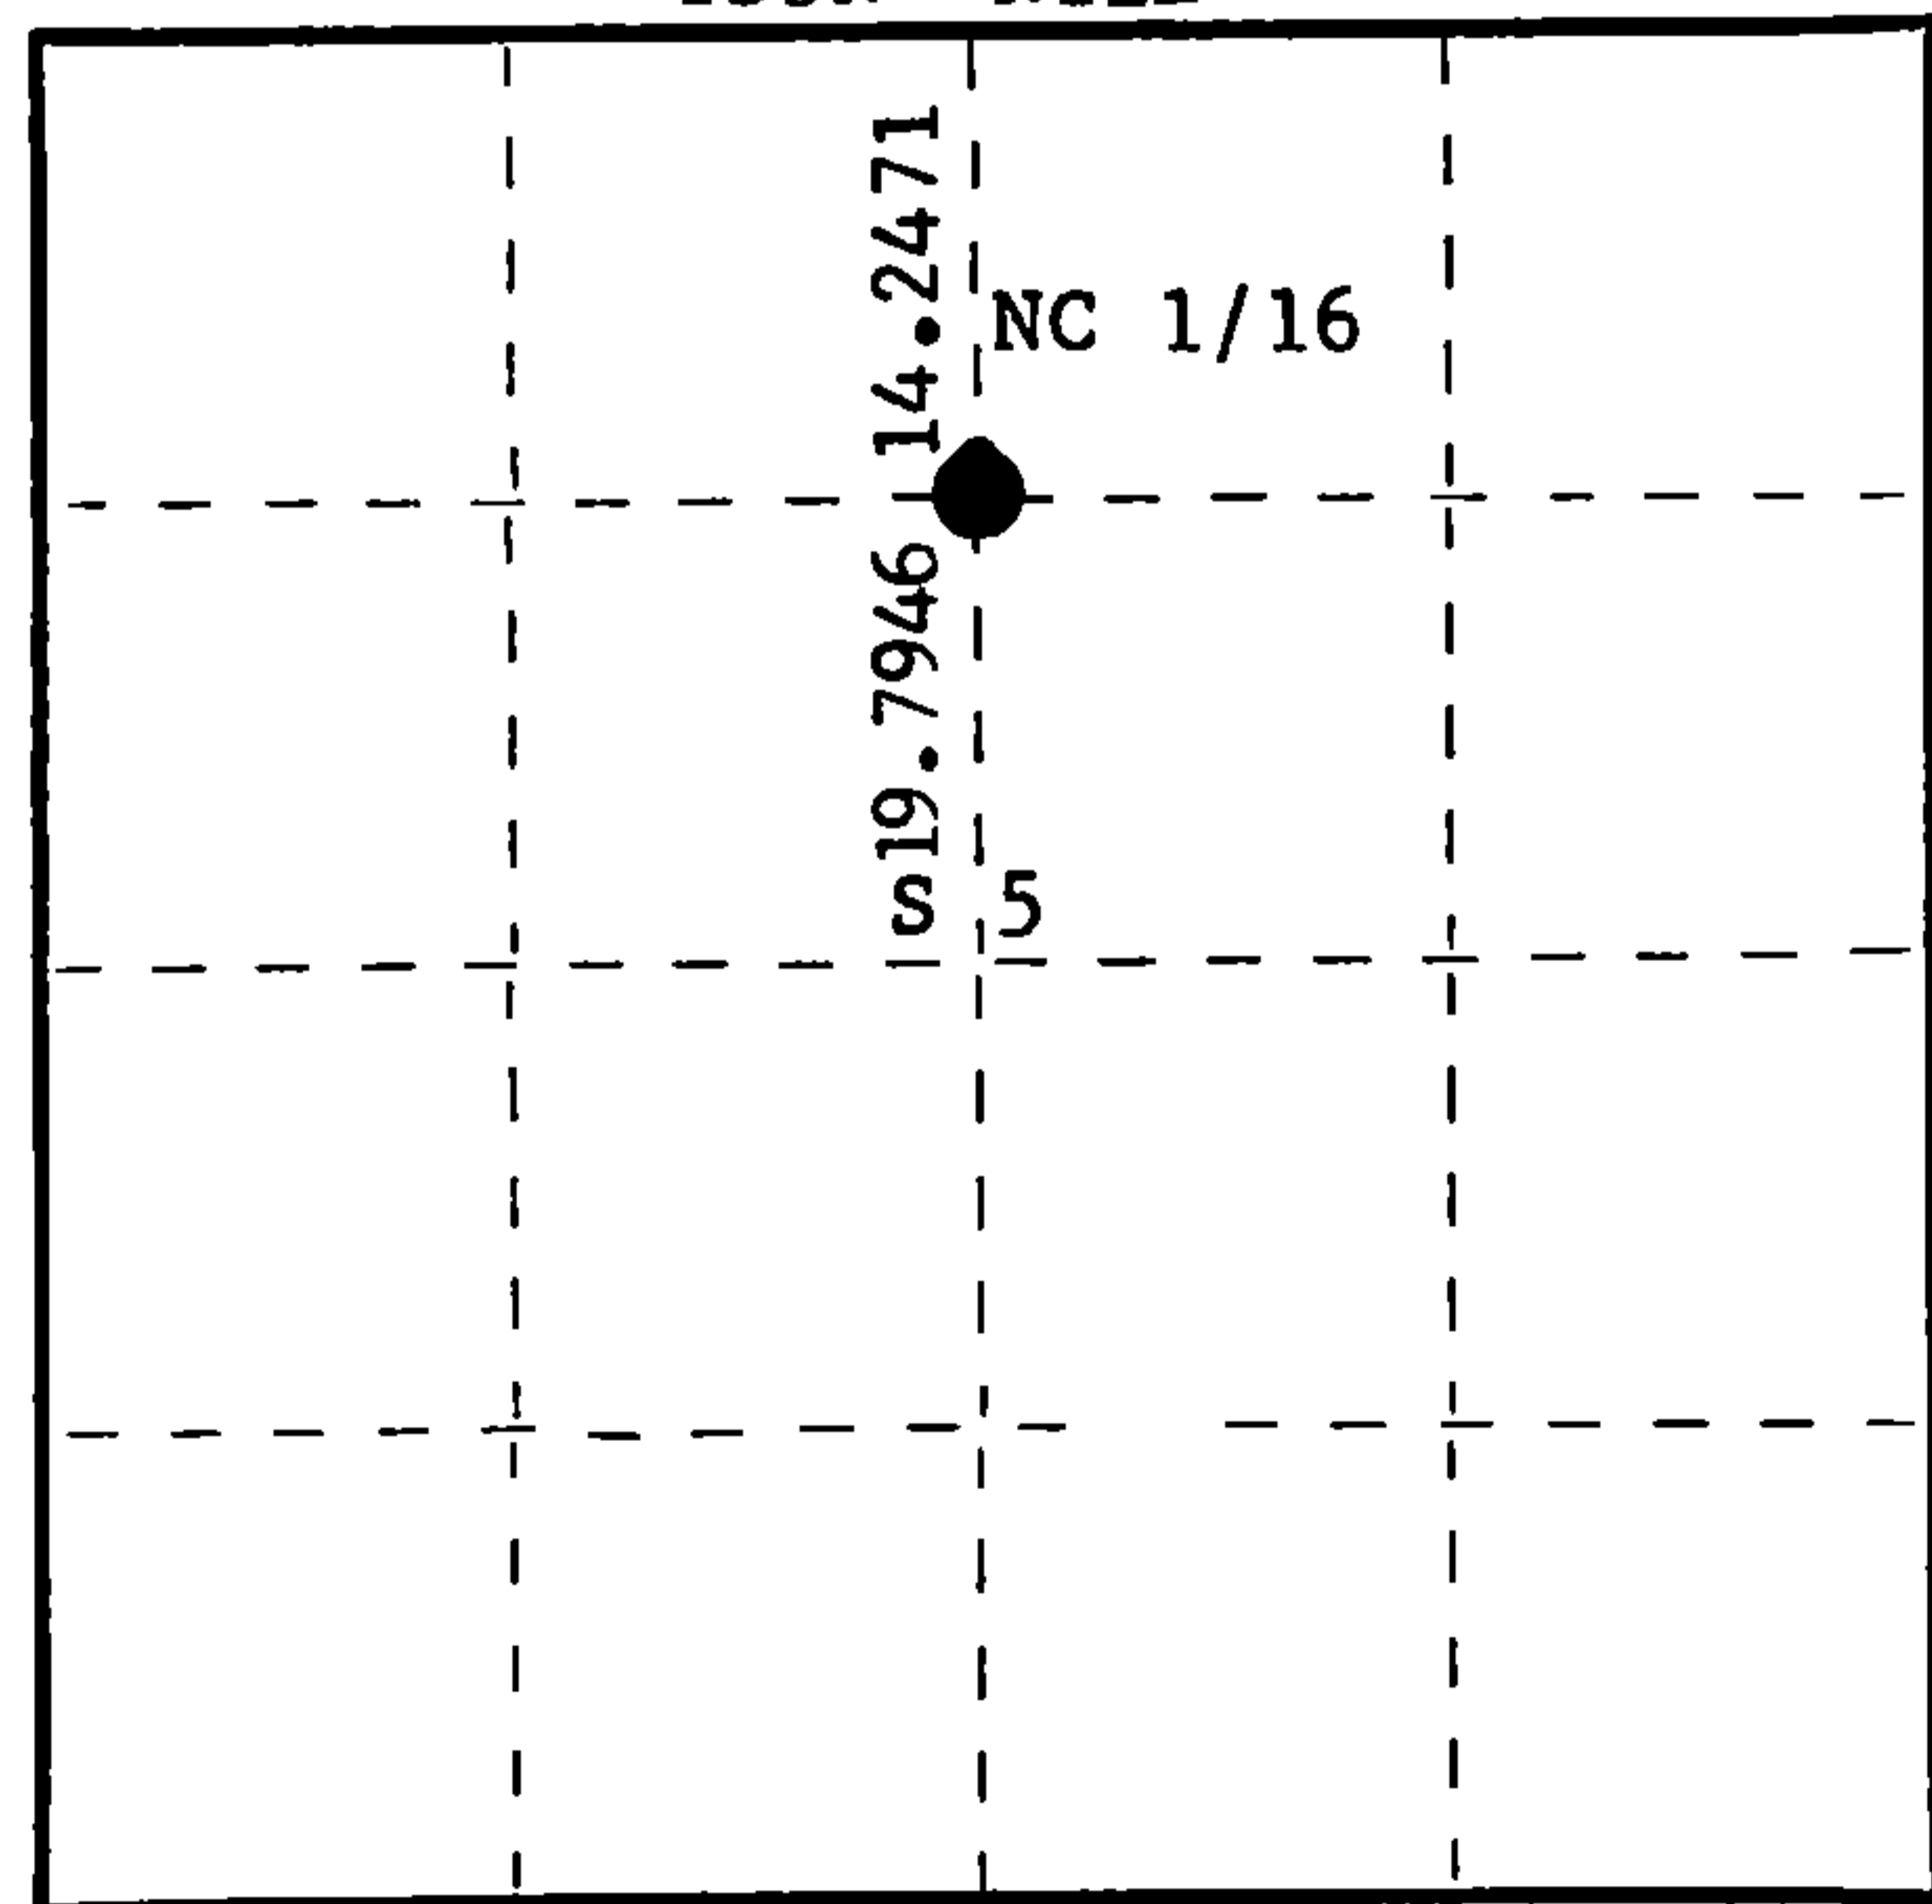

○ = Corner monument restored.

Dated at Rhineland, Wis., this 21st day of July, 1977

Signature Philip T. Hansen Title Registered Land Surveyor Registration No. \_\_\_\_\_  
(County Surveyor, Registered Land Surveyor, or other duly authorized official)

Office of Register of Deeds, County of Forest, I hereby certify that the within instrument was filed in this office for record on the 9th day of August, 1977 at 11:45 o'clock A. M.

Eugene Stutzman  
(Register of Deeds)  
By \_\_\_\_\_ Deputy

DOCUMENT NUMBER  
**112058**

43512053020