

CERTIFIED LAND CORNER RESTORATION

Index No. E-5

State of Wisconsin }
County of Forest } ss.

History of original corner establishment: Original corner established by J.L. Nowlin, Deputy Surveyor, in 1860, from which Elm 12" bears N62°W 10 lks, Elm 15" bears N 15°E 20 lks.

No record of any subsequent surveys.

I Philip T. Hansen, do hereby certify that on the 14th day of May, 1976, I found evidence of the Section corner of S 5, 6, 7, 8 Township 35, North, Range 12 East, Fourth Principal Meridian, as described hereon; and that from this evidence I established a new monument and accessories as described hereon to perpetuate the original location of this corner.


Description of corner evidence found: The Cole road, the centerline of which is the accepted Section N-S between sections 5 and 6 and 7 and 8. The Pitts road has been constructed on the section line between Sections 6 and 7, the intersection of these roads has been the accepted corner by adjacent land owners for years.

Resident witnesses:


Glen Barker

Jim Claflin

Herb Wagoner

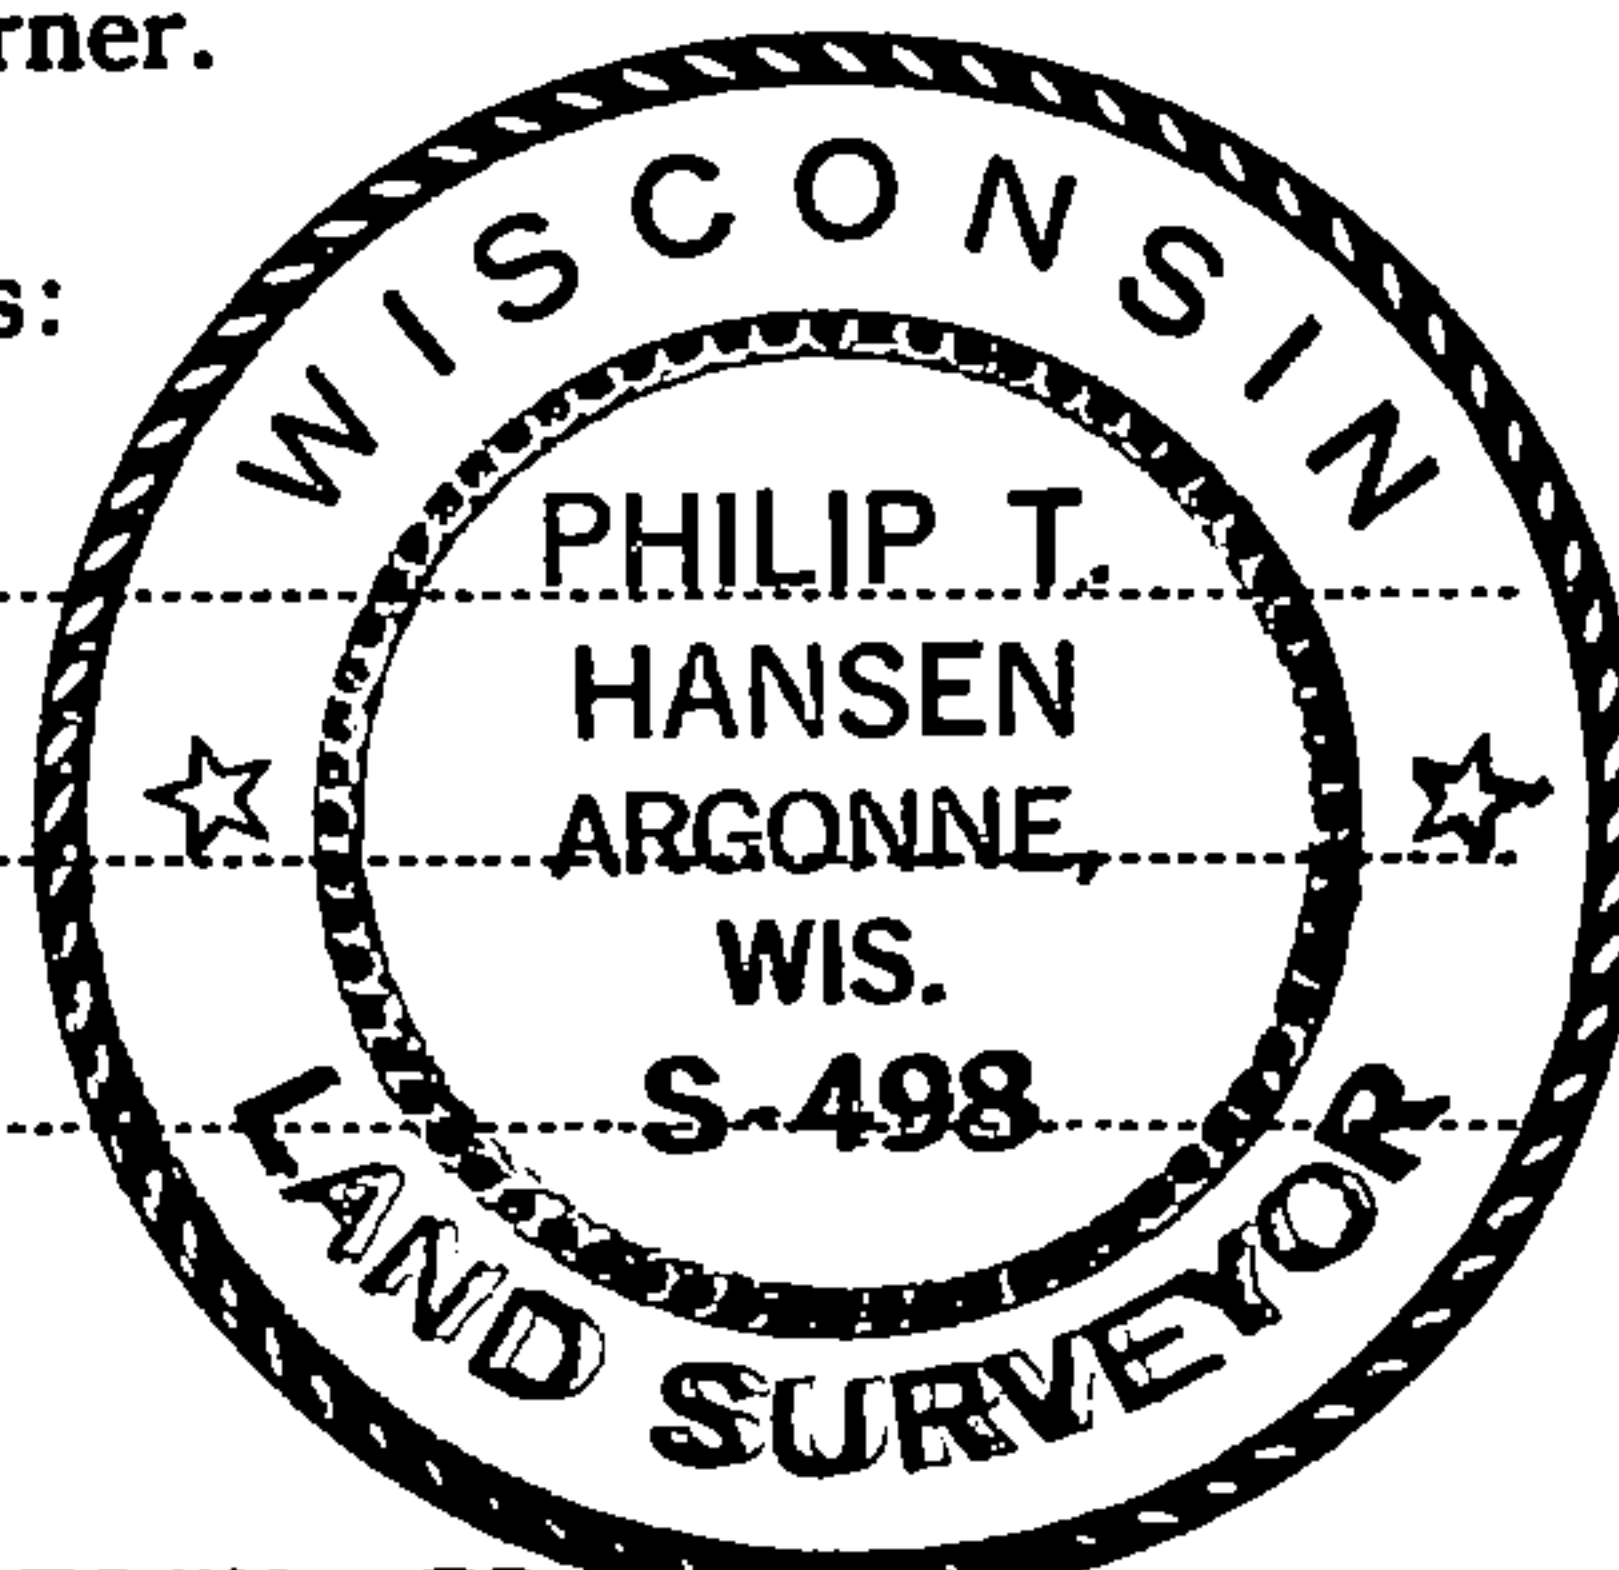

FORM 985

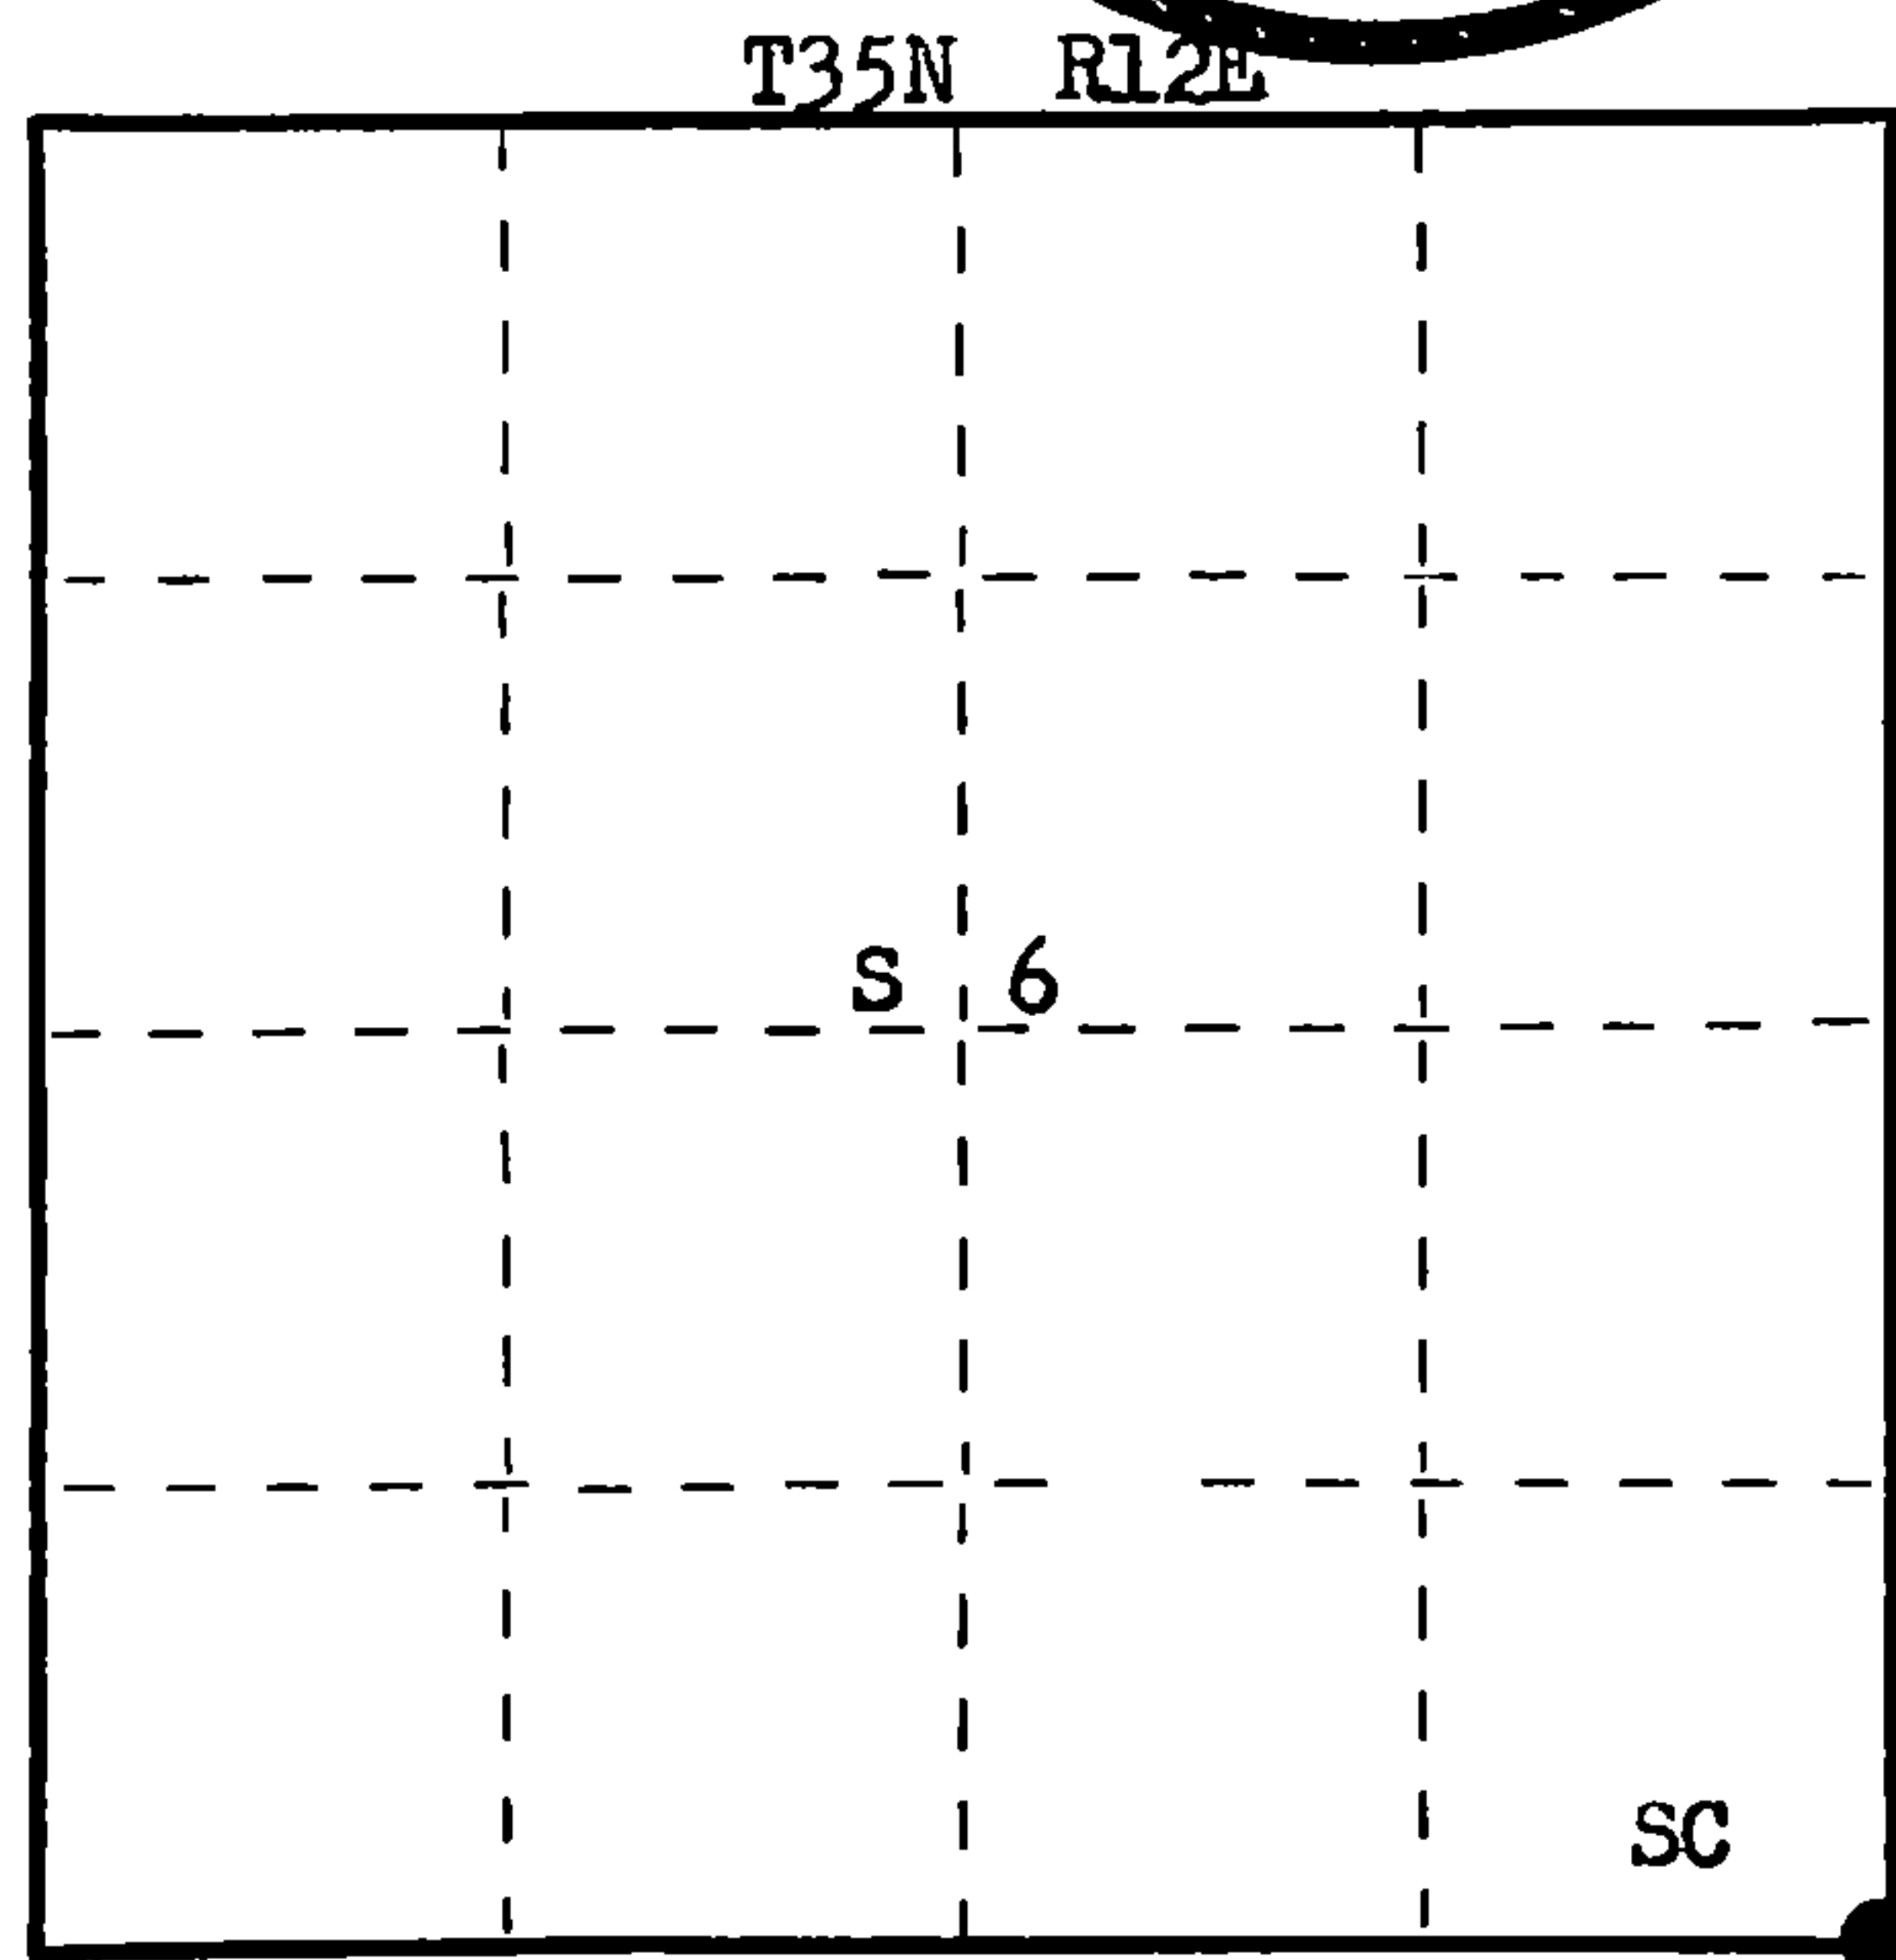

Description of monument and accessories I established to perpetuate the original location of this corner.
Set a RR spike at intersection of centerline of Cole road and Pitts road for section corner. This coincides with a fence line east.
Set a 2 1/2" Berntsen A-1 Federal Monument for Witness Corner, East, 85 lks.
Pipe projects 18" above ground. Cap stamped.
NBT - Sugar 8" S61°E 75.7 lks, scribed SC BT.
Sugar 10" S41°W 168.6 lks, scribed SC BT.
Hi Line pole 3512-511 N50°E 47.1 lks.
Bearings and distances to true corner.
W.C. BTs painted blue.

T35N R12E
Sec. 6/7 5/8 W.C.
W-85 lks. to Cor.
S498-1976

Dated at Rhineland, Wis., this 24th day of May, 1976.

Signature Philip T. Hansen Title Registered Land Surveyor Registration No. S-498
(County Surveyor, Registered Land Surveyor, or other duly authorized official)

Office of Register of Deeds, County of Forest, I hereby certify that the within instrument was filed in this office for record on the 9th day of June, 1976.
at 3:30 o'clock P. M.

Eugene Staszynski
(Register of Deeds)
By _____ Deputy

DOCUMENT NUMBER **109394**

○ = Corner monument restored.

43512060000