

CERTIFIED LAND CORNER RESTORATION

Index No. J-5

State of Wisconsin }  
County of Forest } ss.


I Philip T. Hansen, do hereby certify that on the 27th day of September, 1977, I ~~found~~ established ~~existence of~~ the Section corner of Sec. 7, 8, 17 & 18 Township 35, North, Range 12 East, Fourth Principal Meridian, as described hereon; and that from this evidence I established a new monument and accessories as described hereon to perpetuate the original location of this corner.

Resident witnesses:


Glen Barker

Jim Claflin

Herb Wagoner

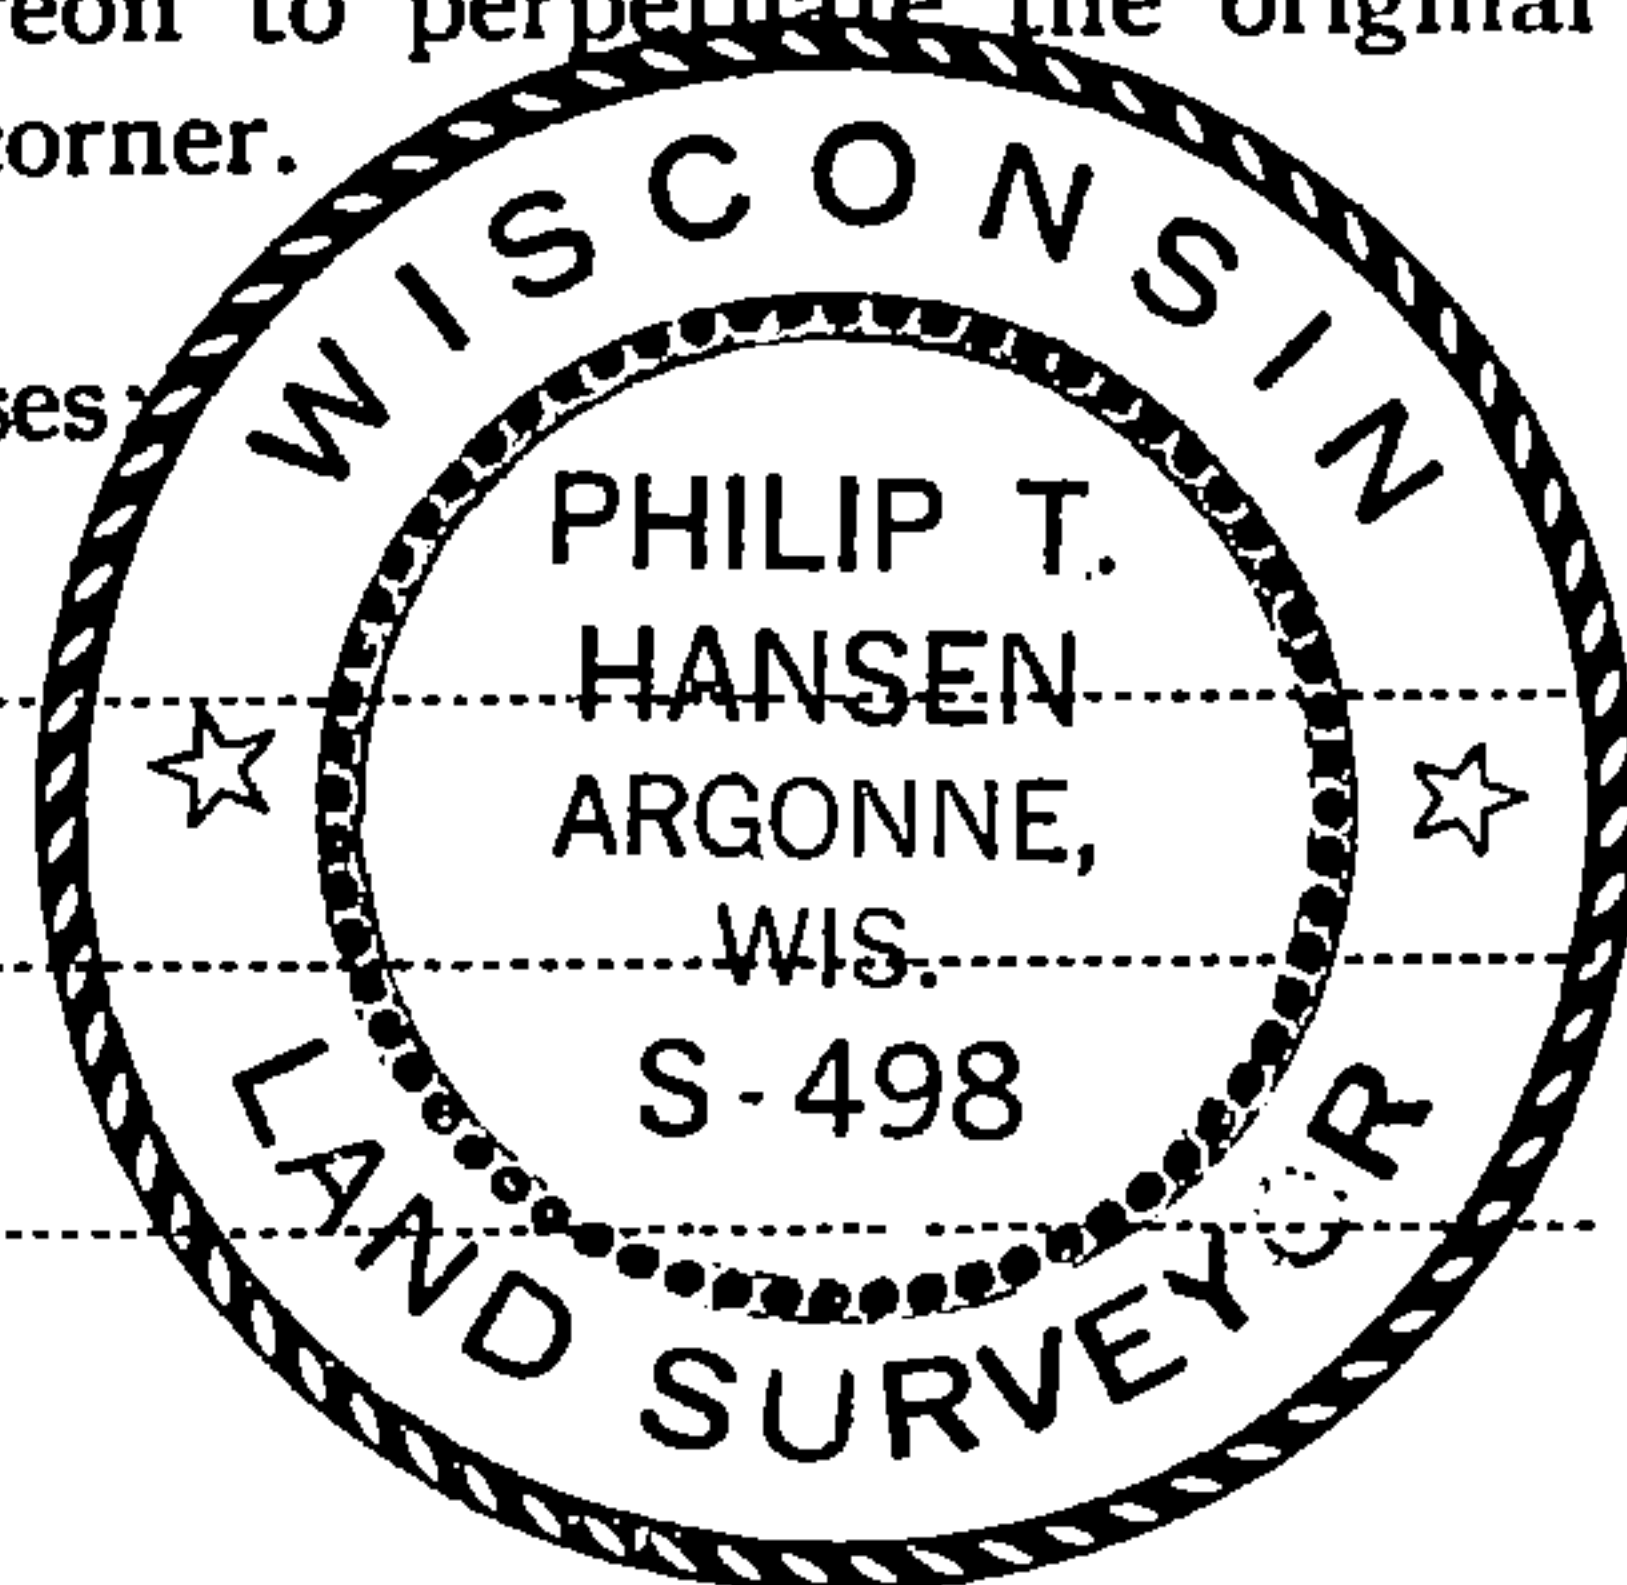

FORM 985 R. C. MILLER CO., MILWAUKEE

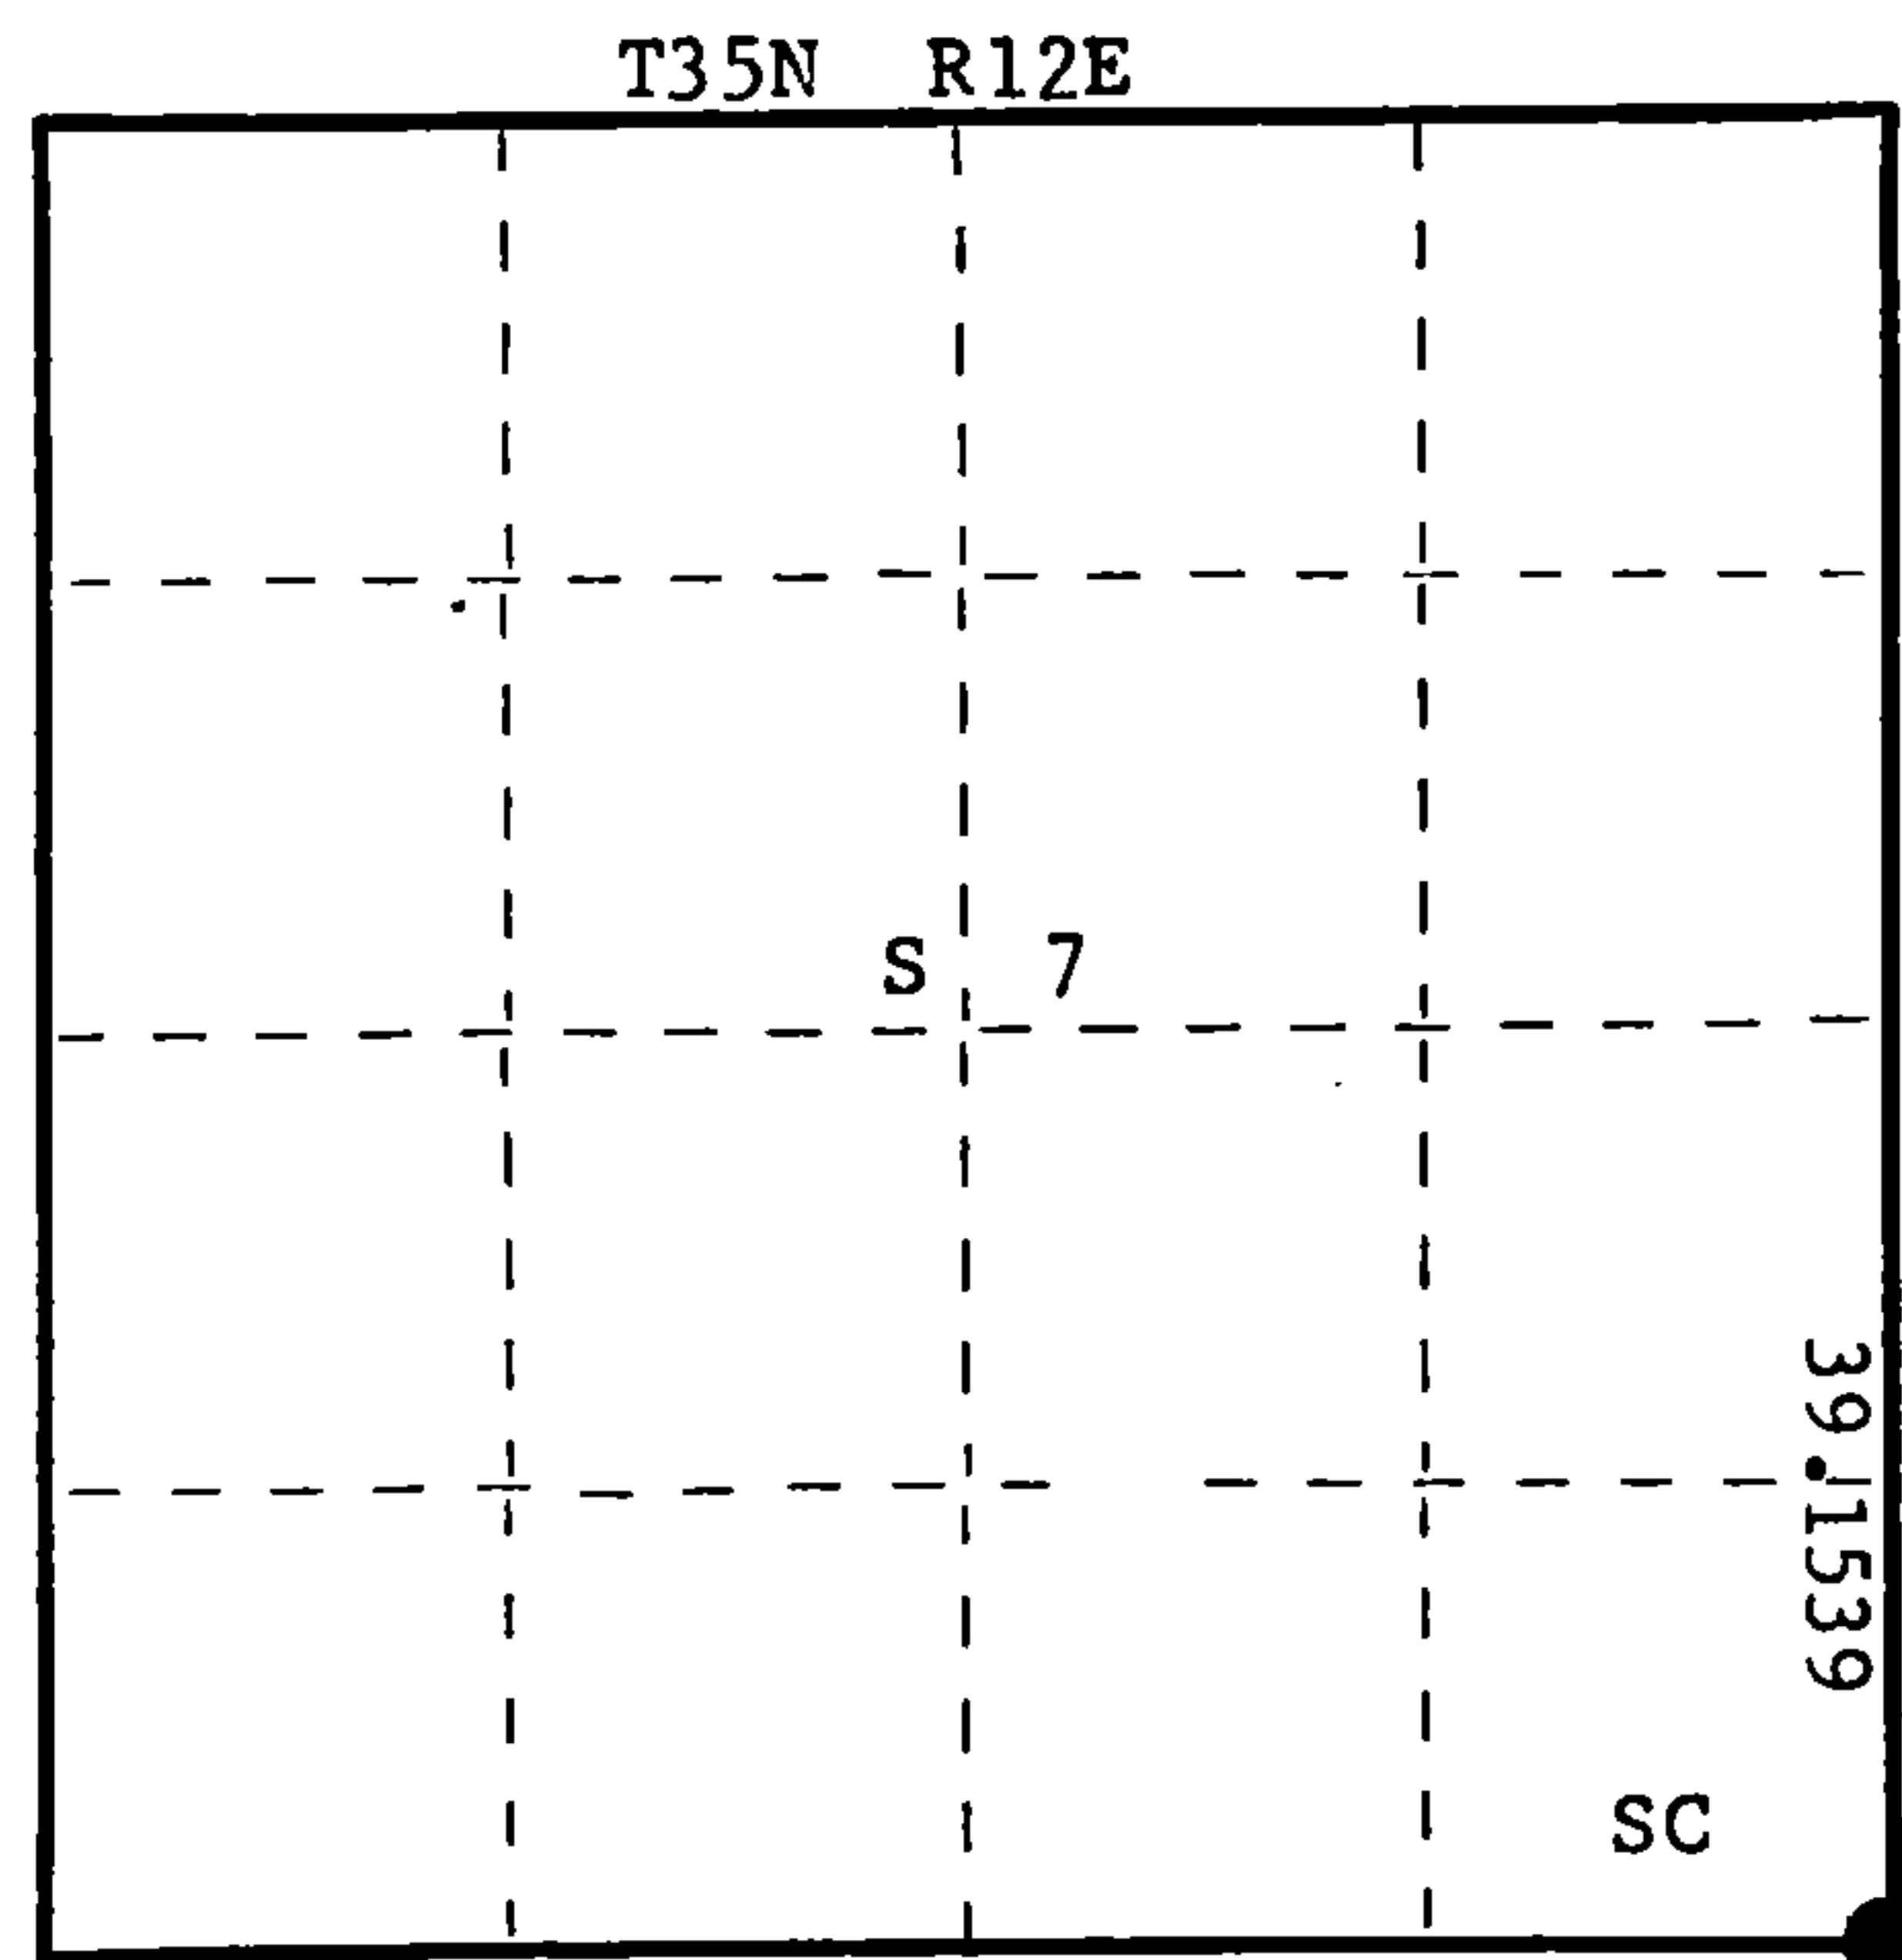

○ = Corner monument restored.

History of original corner establishment:

Original corner established by Hiram C. Fellows, Deputy Surveyor, in 1859. No record of any subsequent survey.

Description of corner evidence found:

No evidence of any corner recovered. P.K. was found at the centerline of Highway B. No reference marks. Established corner by accepting the intersection of County Trunk B and Cole Road to north. This position is 39.15388 chains S 1° 57' 05" E of 1/4 corner between Section 7 & 8.

Description of monument and accessories I established to perpetuate the original location of this corner.

Drove RR spike into blacktop at intersection. Set 2 1/2" Berntsen A-1 Federal Monument for W.C. S45°W 70 links, cap stamped: Monument projects 18" above ground. Marked B.O. - Hi Line Pole #3512 17W9 S50°E, 66.75 links  
Hi line Pole #3512 862 N49°E, 72.1 links.  
Sugar Maple N29°E, 151 links, scribed SC BT.

T35N R12E  
Sec. 7 8  
18 17 W.C.  
S498 - 1977  
N45°E 70 lks to Cor.

Dated at Rhineland, Wis., this 3rd day of October, 1977

Signature Philip T. Hansen Title Registered Land Surveyor Registration No. S-498  
(County Surveyor, Registered Land Surveyor, or other duly authorized official)

Office of Register of Deeds, County of Forest, I hereby certify that the within instrument was filed in this office for record on the 7th day of October, 1977 at 2:45 o'clock P. M.

Eugene Stutzny  
(Register of Deeds)

By..... Deputy

DOCUMENT NUMBER  
**112522**

43512 0710000