

CERTIFIED LAND CORNER RESTORATION

Index No. J-8

State of Wisconsin }
County of Forest } ss.


I Philip T. Hansen, do hereby certify that on the 27th day of September, 1977, I ~~found~~ established ~~evidence~~ of the E 1/16 corner of Section 8 & 17 Township 35, North, Range 12 East, Fourth Principal Meridian, as described hereon; and that from this evidence I established a new monument and accessories as described hereon to perpetuate the original location of this corner.

Resident witnesses:


Glen Barker

Jim Claflin

Herb Wagoner

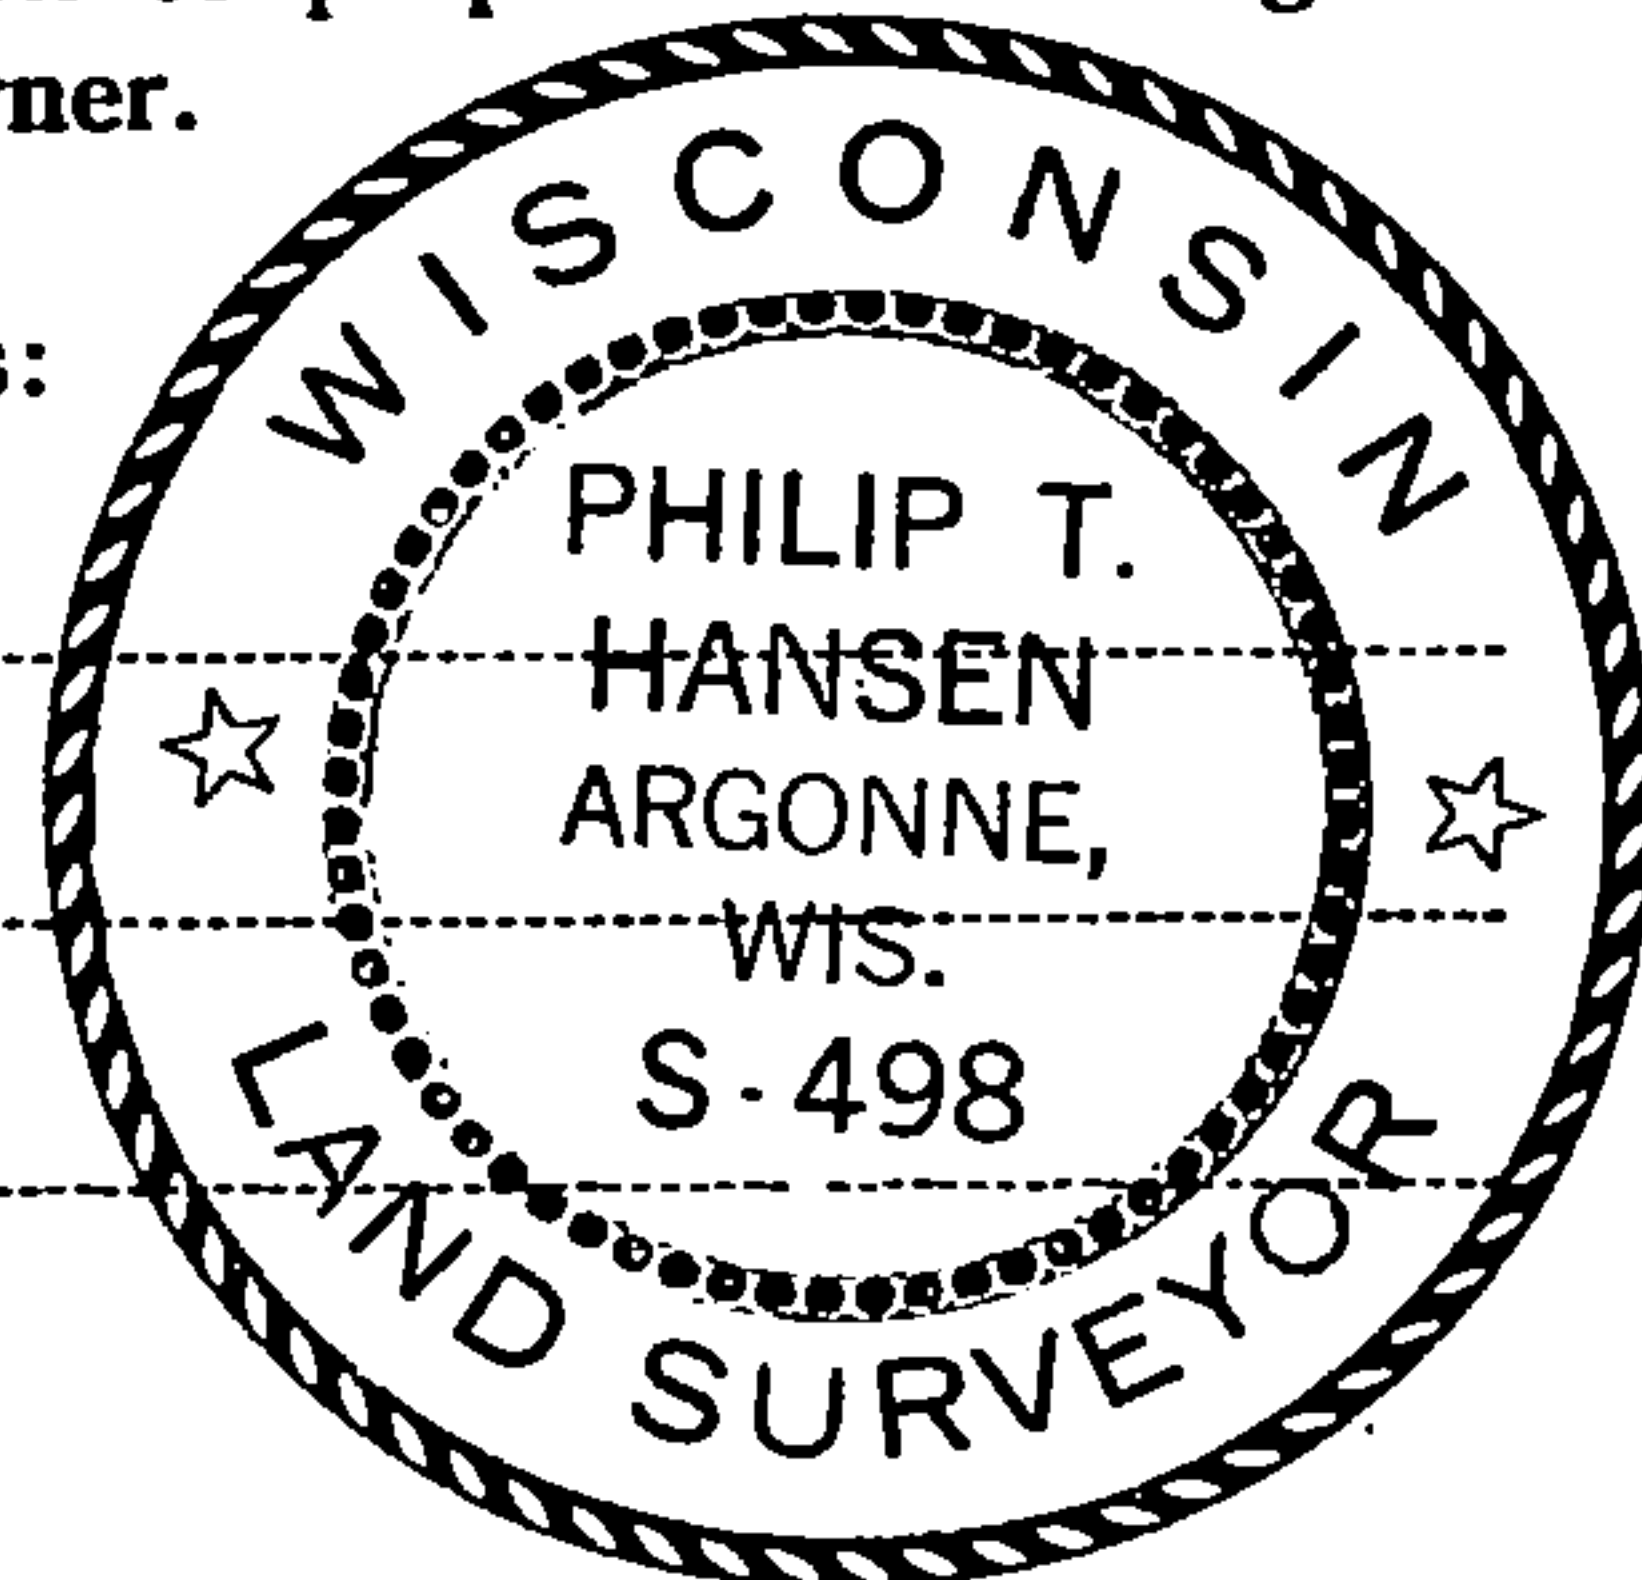

FORM 985 H. C. MILLER CO., MILWAUKEE

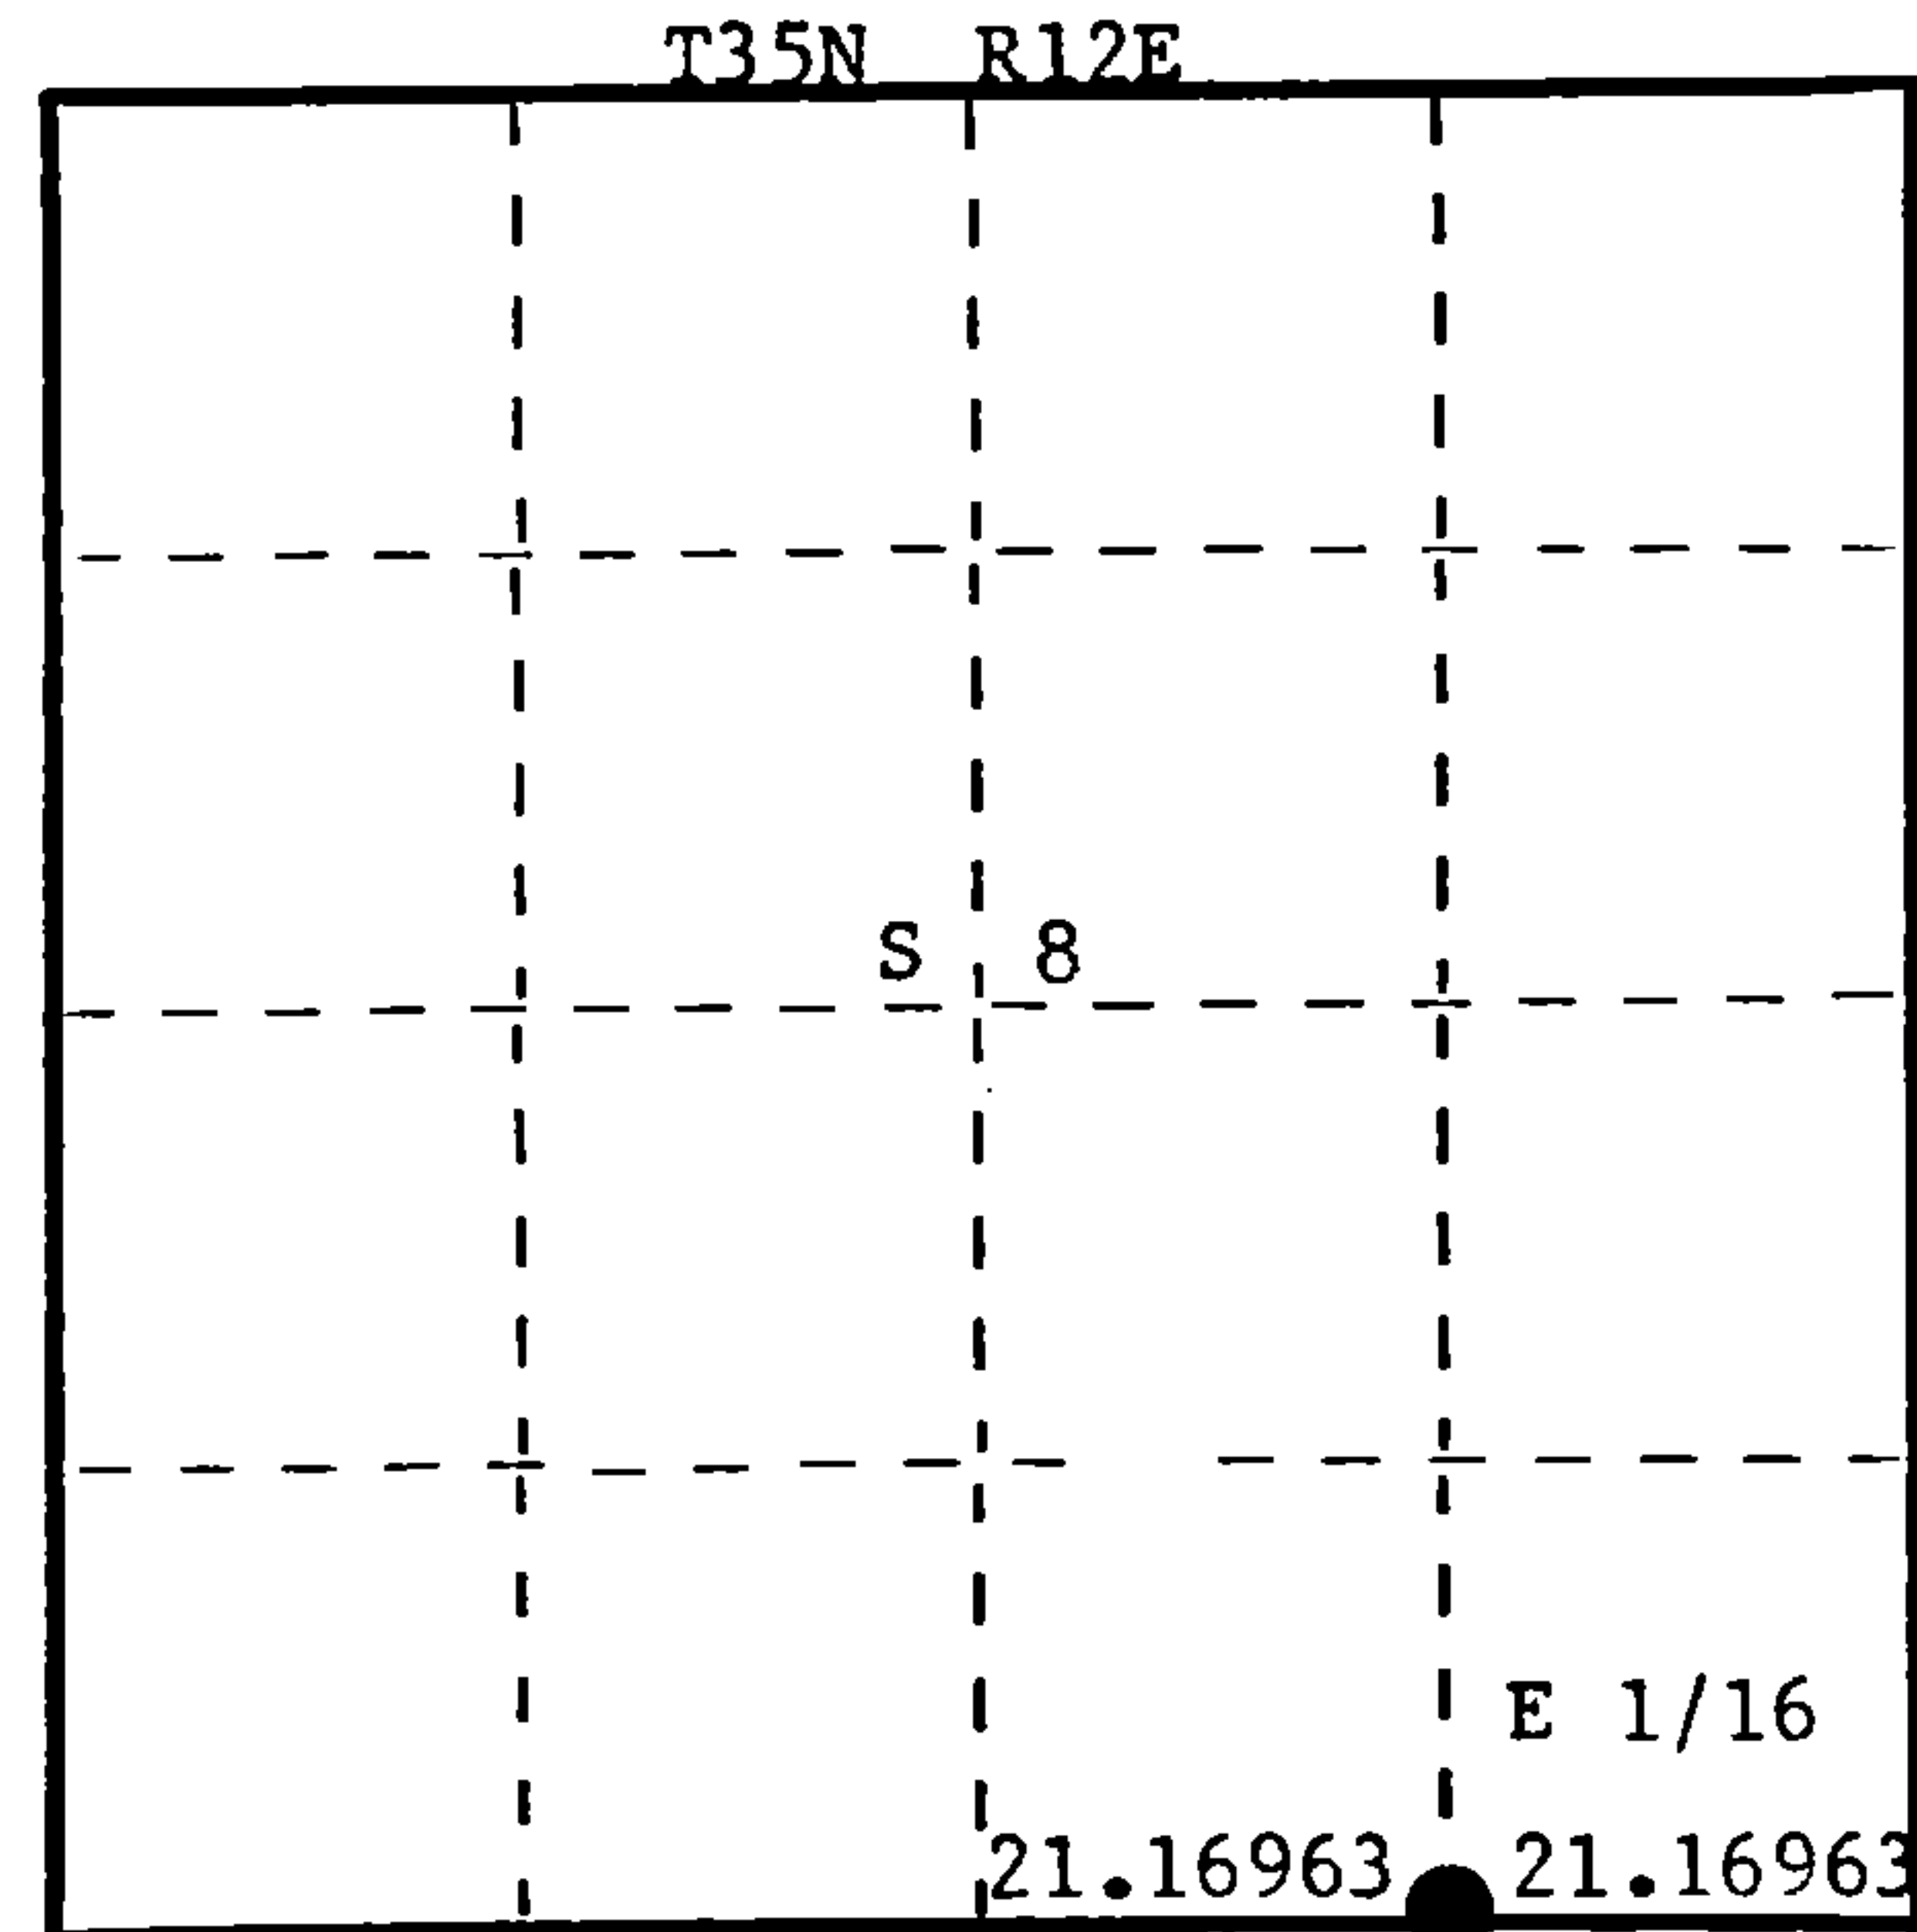

○ = Corner monument restored.

History of original corner establishment:

No record of any previous survey.

Description of corner evidence found:

No evidence of any corner or reference marks recovered.
Accepted intersection of fence line running north and one running south with the centerline of County Trunk B as the corner.
A R.R. spike driven at this location.

Description of monument and accessories I established to perpetuate the original location of this corner.

Set a 1 1/2" iron pipe with 2" brass cap 60 links south of true corner for witness corner.
Monument projects 2' above ground, cap stamped:
Marked NBT from true corner,
Sugar 9" N18°E, 63.4 links, scribed 1/16 BT.
Power Pole #3512 17E5 S46°W, 81.9 links.

S498
T35N R12E
E 1/16 S+8
S+17
N 60 lks.
CPI-1977

Dated at Rhineland, Wis., this 3rd day of October, 1977.

Signature Philip T. Hansen Title Registered Land Surveyor Registration No. S-498
(County Surveyor, Registered Land Surveyor, or other duly authorized official)

Office of Register of Deeds, County of Forest, I hereby certify that the within instrument was filed in this office for record on the 7th day of October, 1977 at 2:45 o'clock P. M.

Eugene Stegny
(Register of Deeds)
By _____ Deputy

DOCUMENT NUMBER
112526

43512080010