

CERTIFIED LAND CORNER RESTORATION

Index No. J-78
6-7

State of Wisconsin }
County of Forest } ss.

I, Philip T. Hansen, do hereby certify that on the 28th day of September, 1977, I ~~found~~ established ~~existence of~~ the 1/32 cor. between W 1/16 & 1/4 corner of Section 8 & 17 Township 35, North, Range 12 East, Fourth Principal Meridian, as described hereon; and that from this evidence I established a new monument and accessories as described hereon to perpetuate the original location of this corner.

History of original corner establishment:
No record of any previous survey.

Description of corner evidence found:


No evidence of any corner recovered.
Corner set by proportional measurement. Computed distance between W 1/16 corner and 1/4 corner 19.72347 chains at bearing S 87° 15' 44" E. Set 1/32 at 9.86173 chains intermediate.

Resident witnesses:

Glen Barker

Jim Claflin

Herb Wagoner

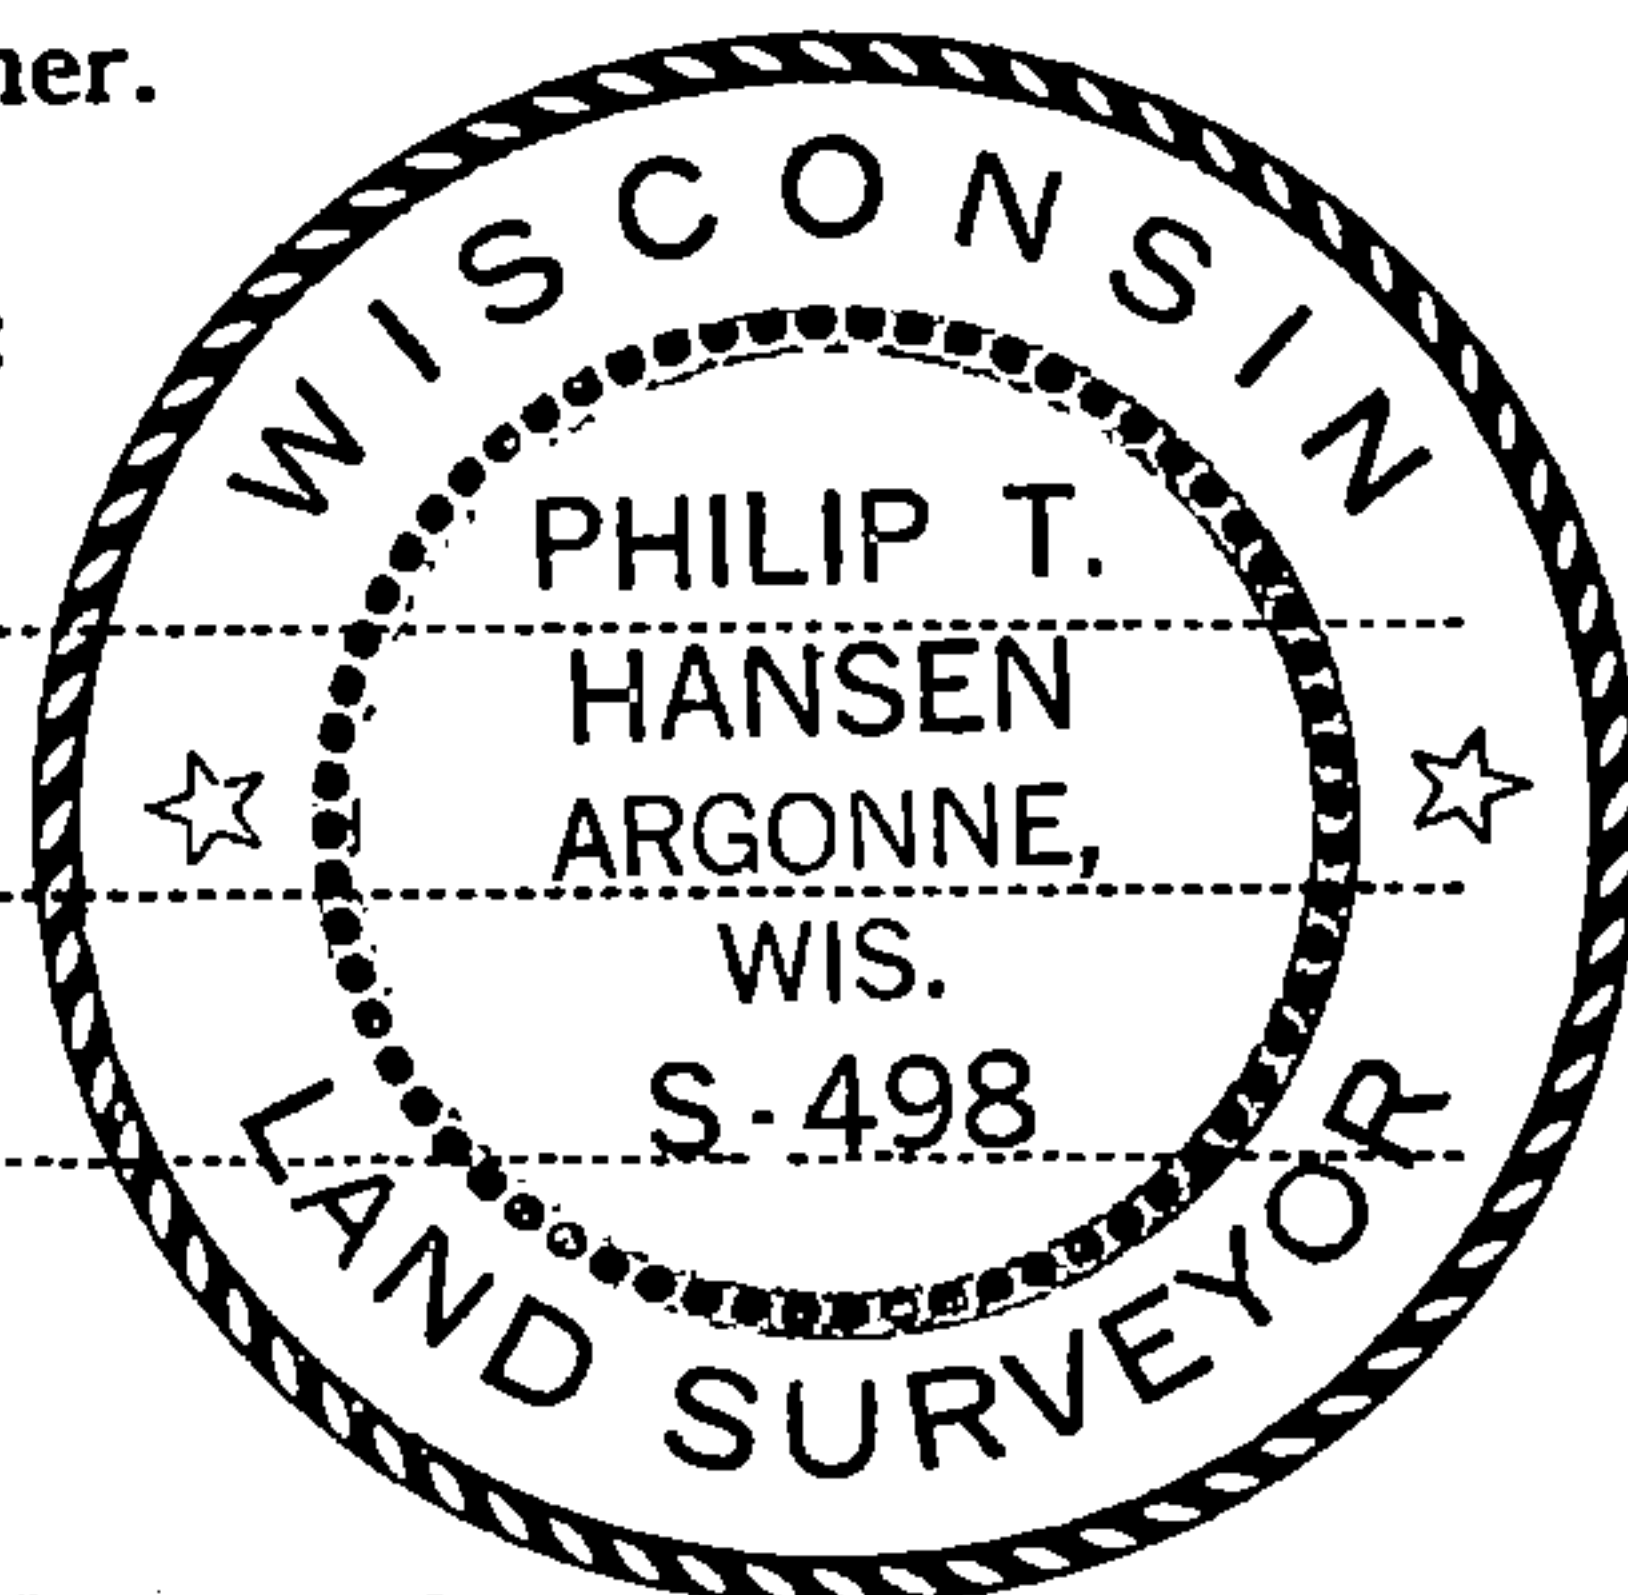


Description of monument and accessories I established to perpetuate the original location of this corner. Drove R.R. spike in the centerline of County Trunk "B" for true corner. Set 1 1/2" iron pipe for witness corner 60 links north. Monument projects 24" above ground. Cap stamped: Marked NBTs from true corner.

Cedar 8" S42°W, 66.7 links.
Tamarack 6" S56°E, 154.2 links, both scribed 1/32 BT.

S498
T35N R12E
1/32 S 8 / S 17 W.C.
S 60 lks.
CPI-1977

FORM 985 H. C. MILLER CO., MILWAUKEE

T35N R12E

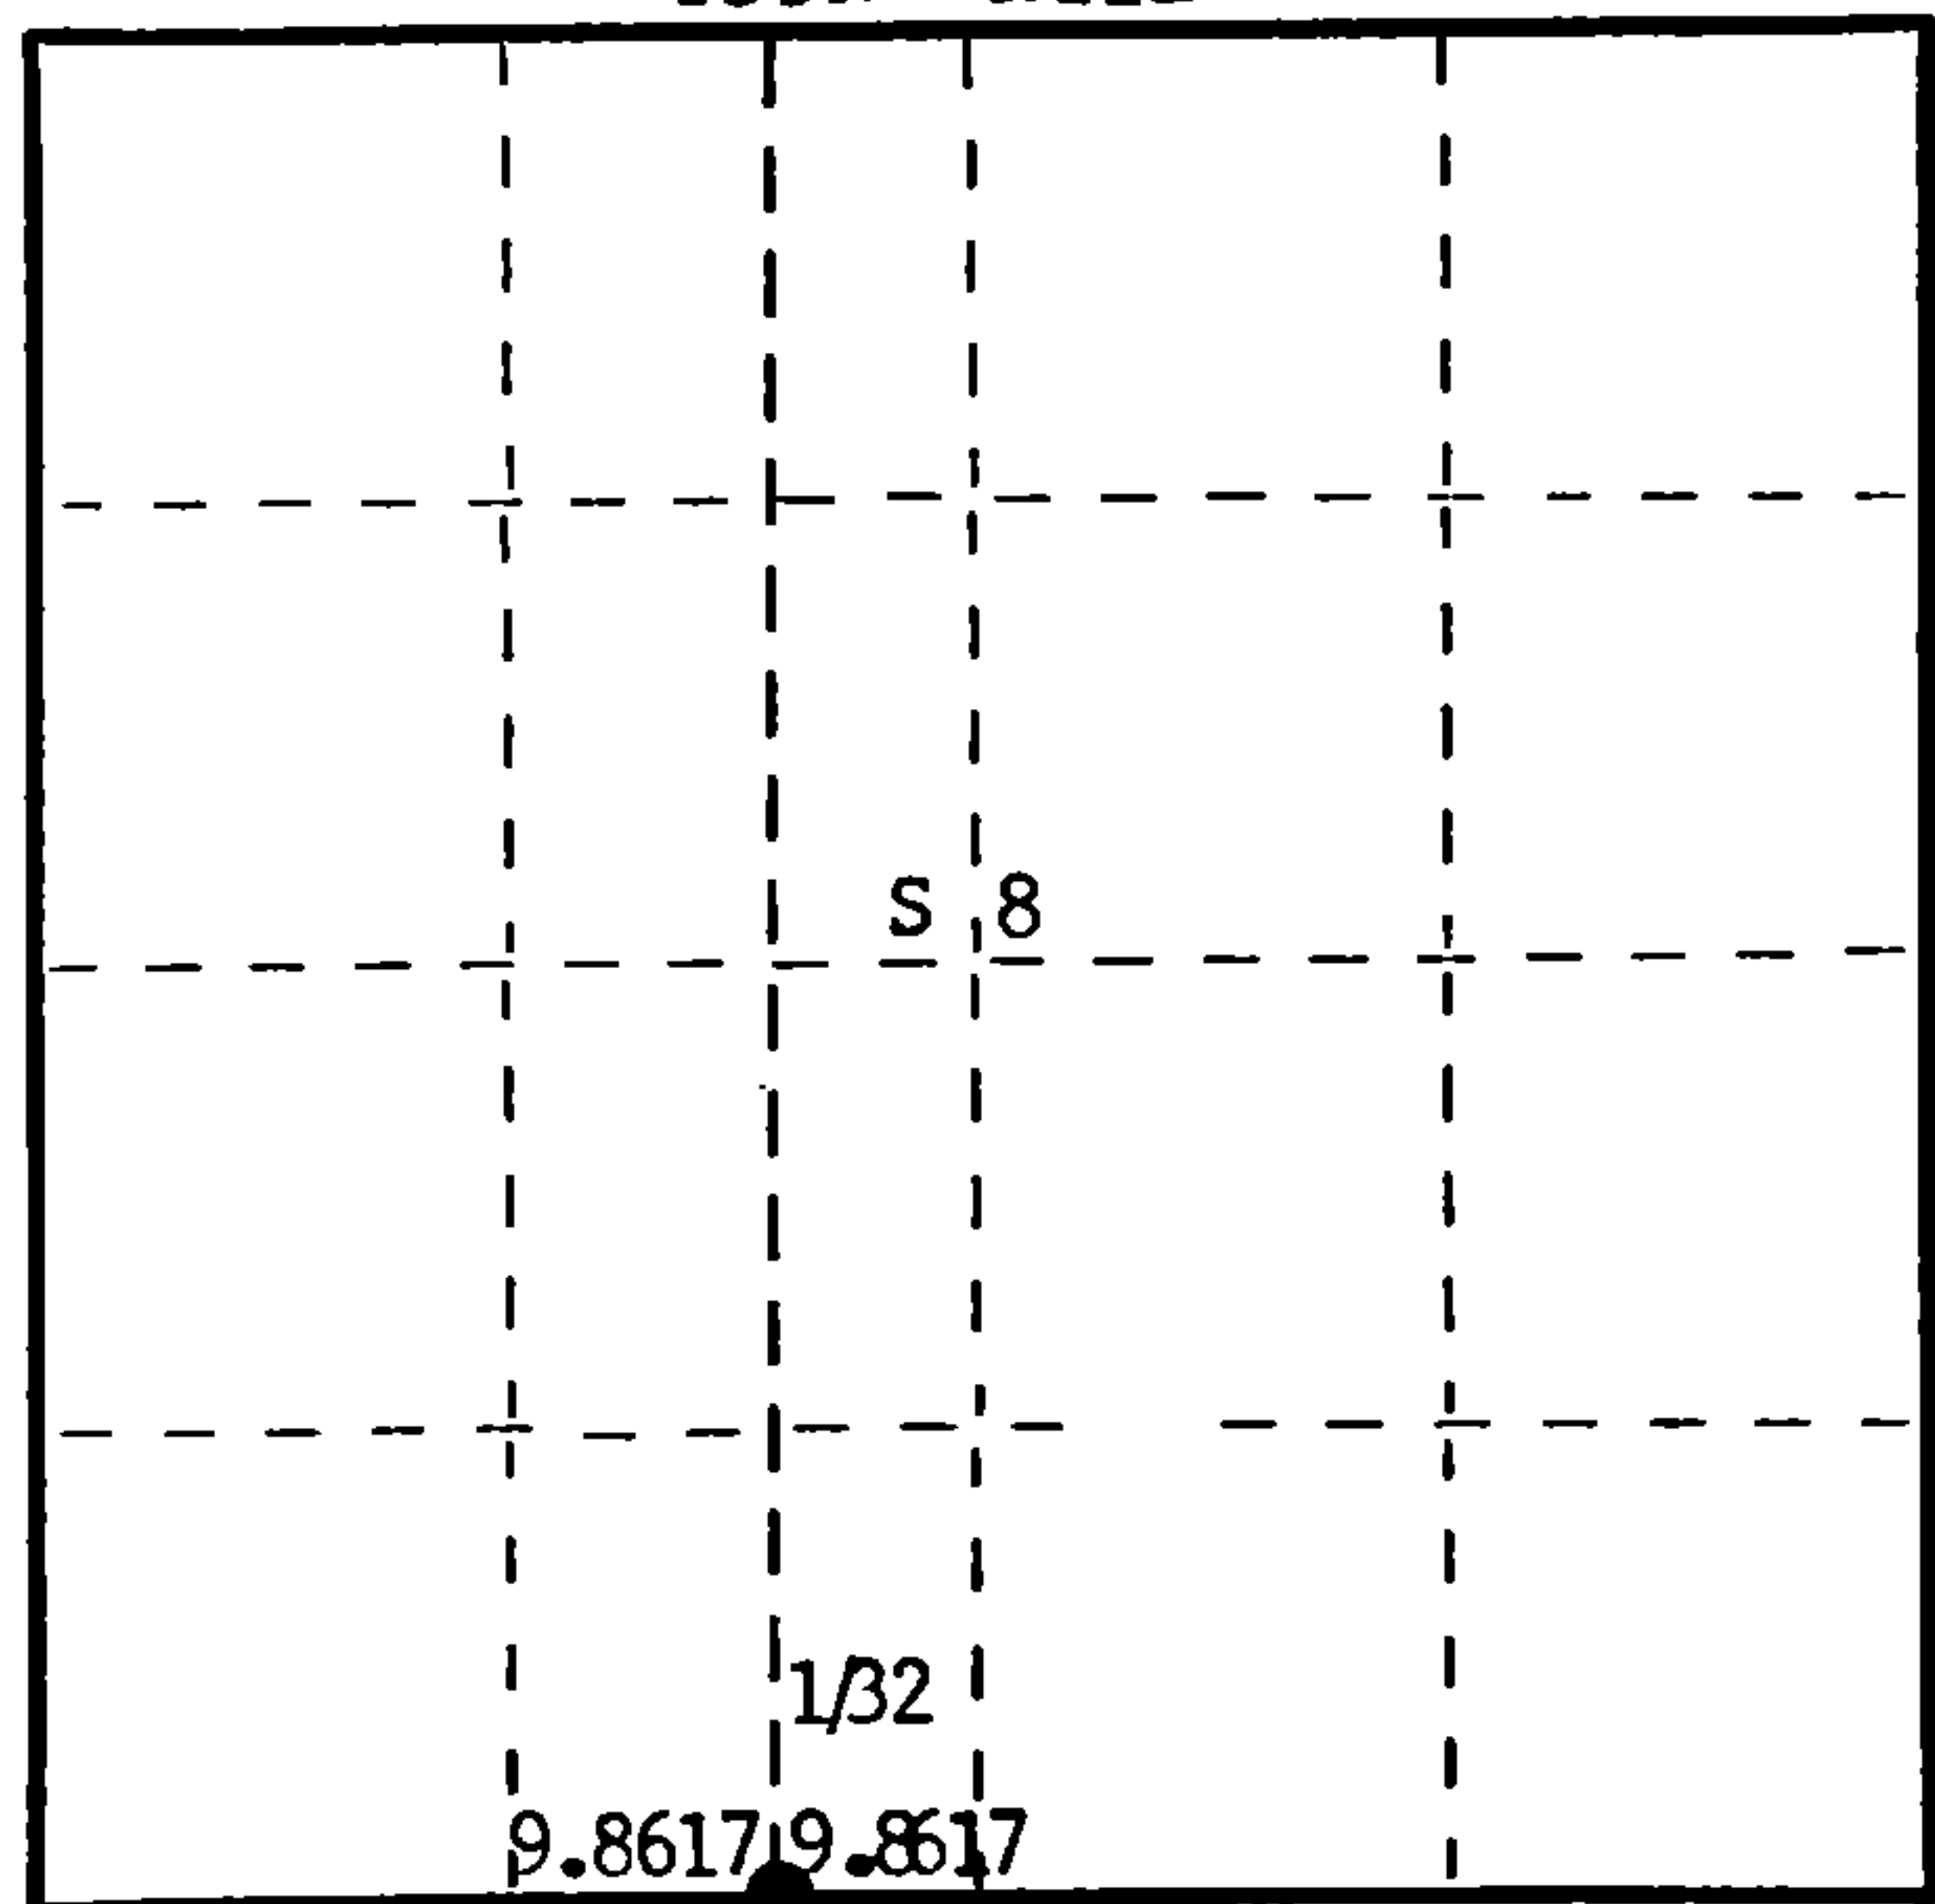

○ = Corner monument restored.

Dated at Rhineland, Wis., this 3rd day of October, 1977

Signature Philip T. Hansen Title Registered Land Surveyor Registration No. S-498
(County Surveyor, Registered Land Surveyor, or other duly authorized official)

Office of Register of Deeds, County of Forest, I hereby certify that the within instrument was filed in this office for record on the 7th day of October, 1977 at 2:45 o'clock P. M.

Eugene Stategny
(Register of Deeds)
By _____ Deputy

DOCUMENT NUMBER
112525

43512080024