

CERTIFIED LAND CORNER RESTORATION

Index No. H-6

State of Wisconsin }  
County of Forest } ss.


I Philip T. Hansen, do hereby certify that on the 6th day of December, 1977, I ~~found~~ established ~~existence of~~ the SW 1/16 corner of Section 8 Township 35, North, Range 12 East, Fourth Principal Meridian, as described hereon; and that from this evidence I established a new monument and accessories as described hereon to perpetuate the original location of this corner.

Resident witnesses:


Glen Barker

Jim Claflin

Herb Wagoner

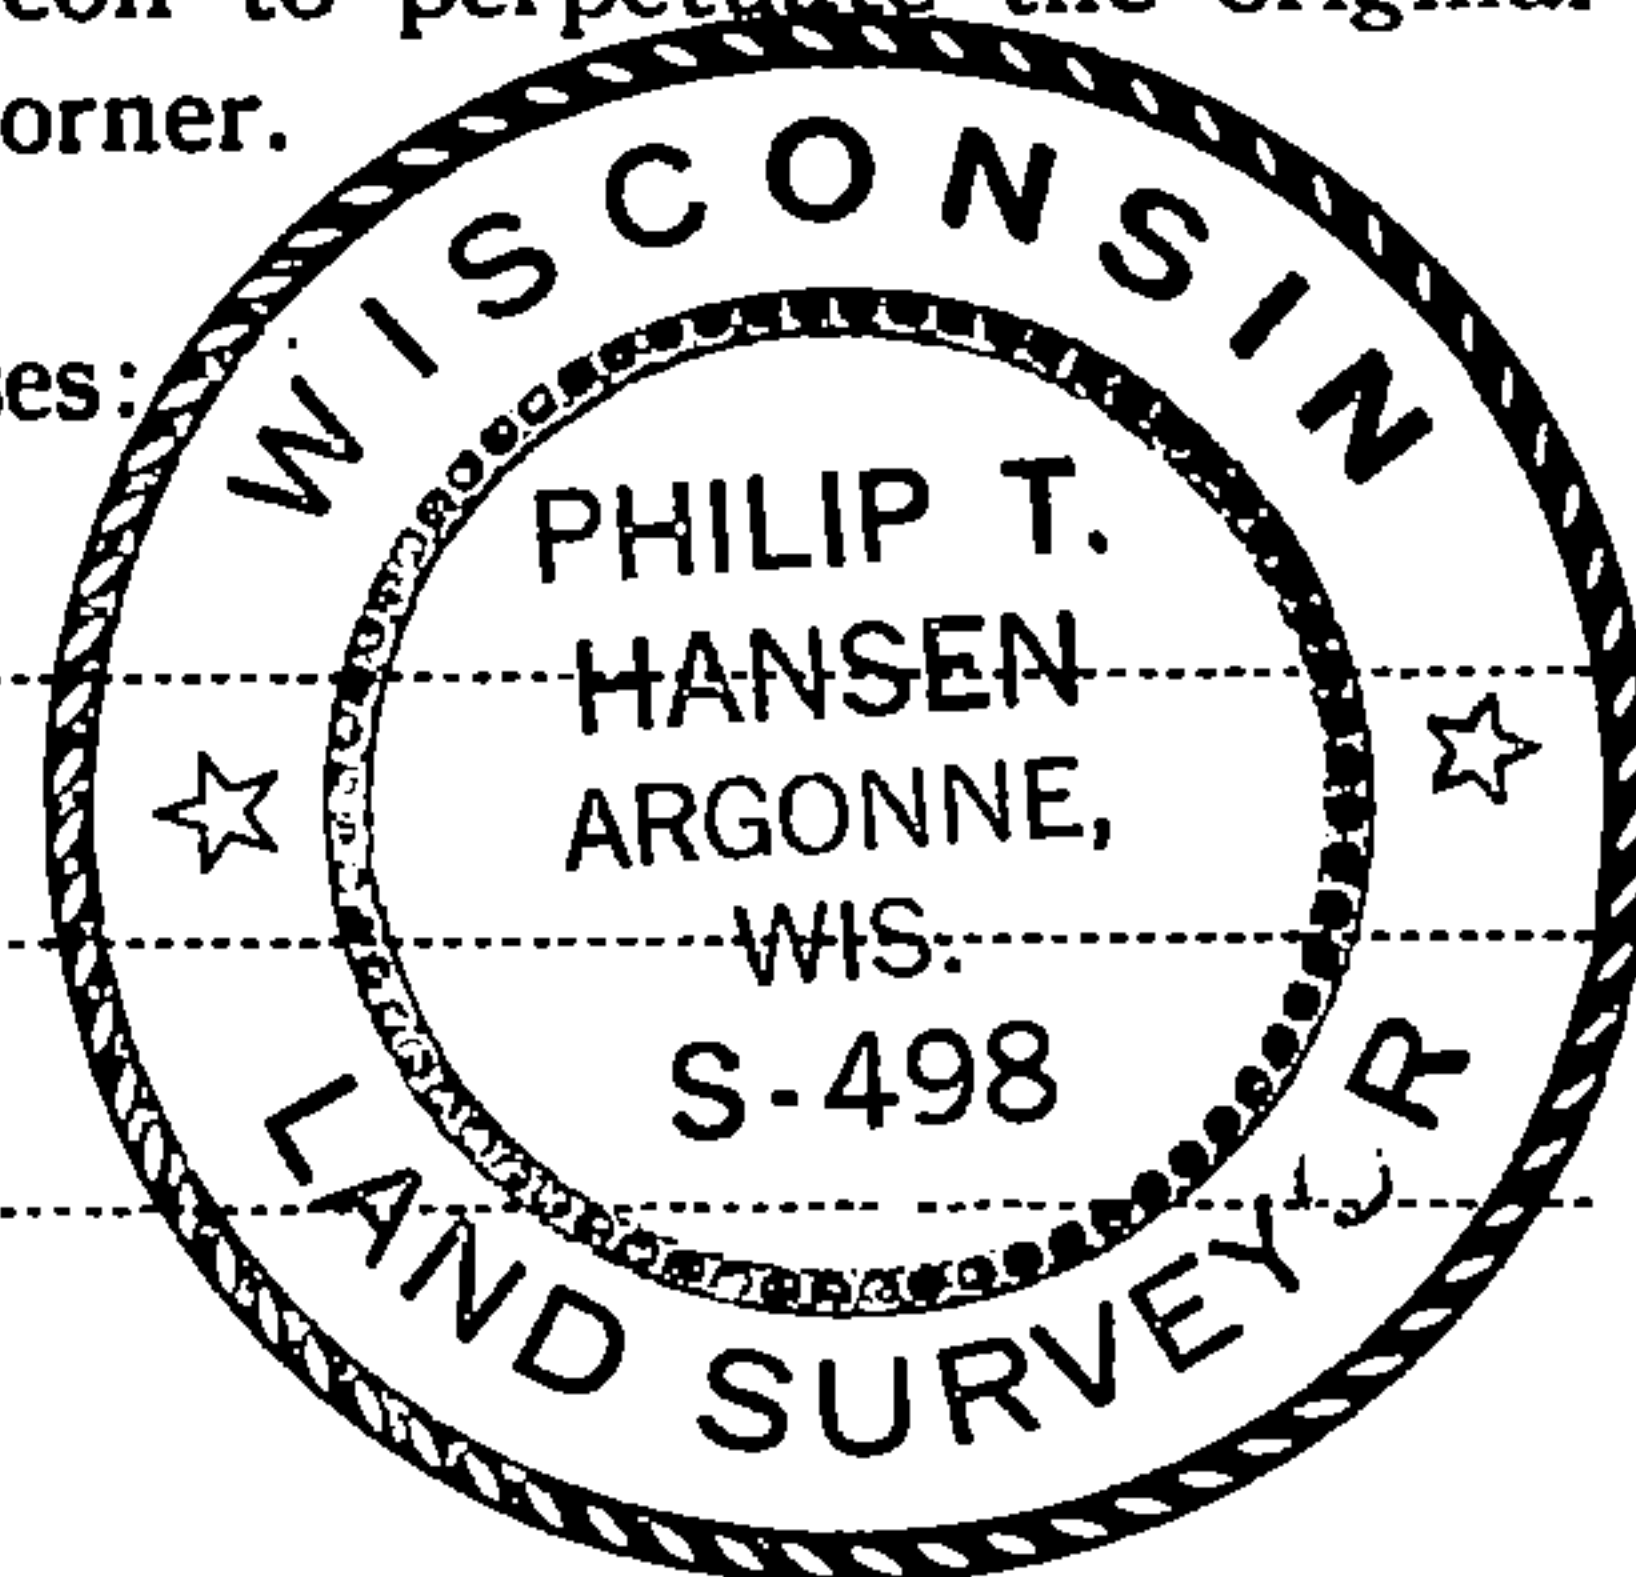

FORM 985 H. C. MILLER CO., MILWAUKEE

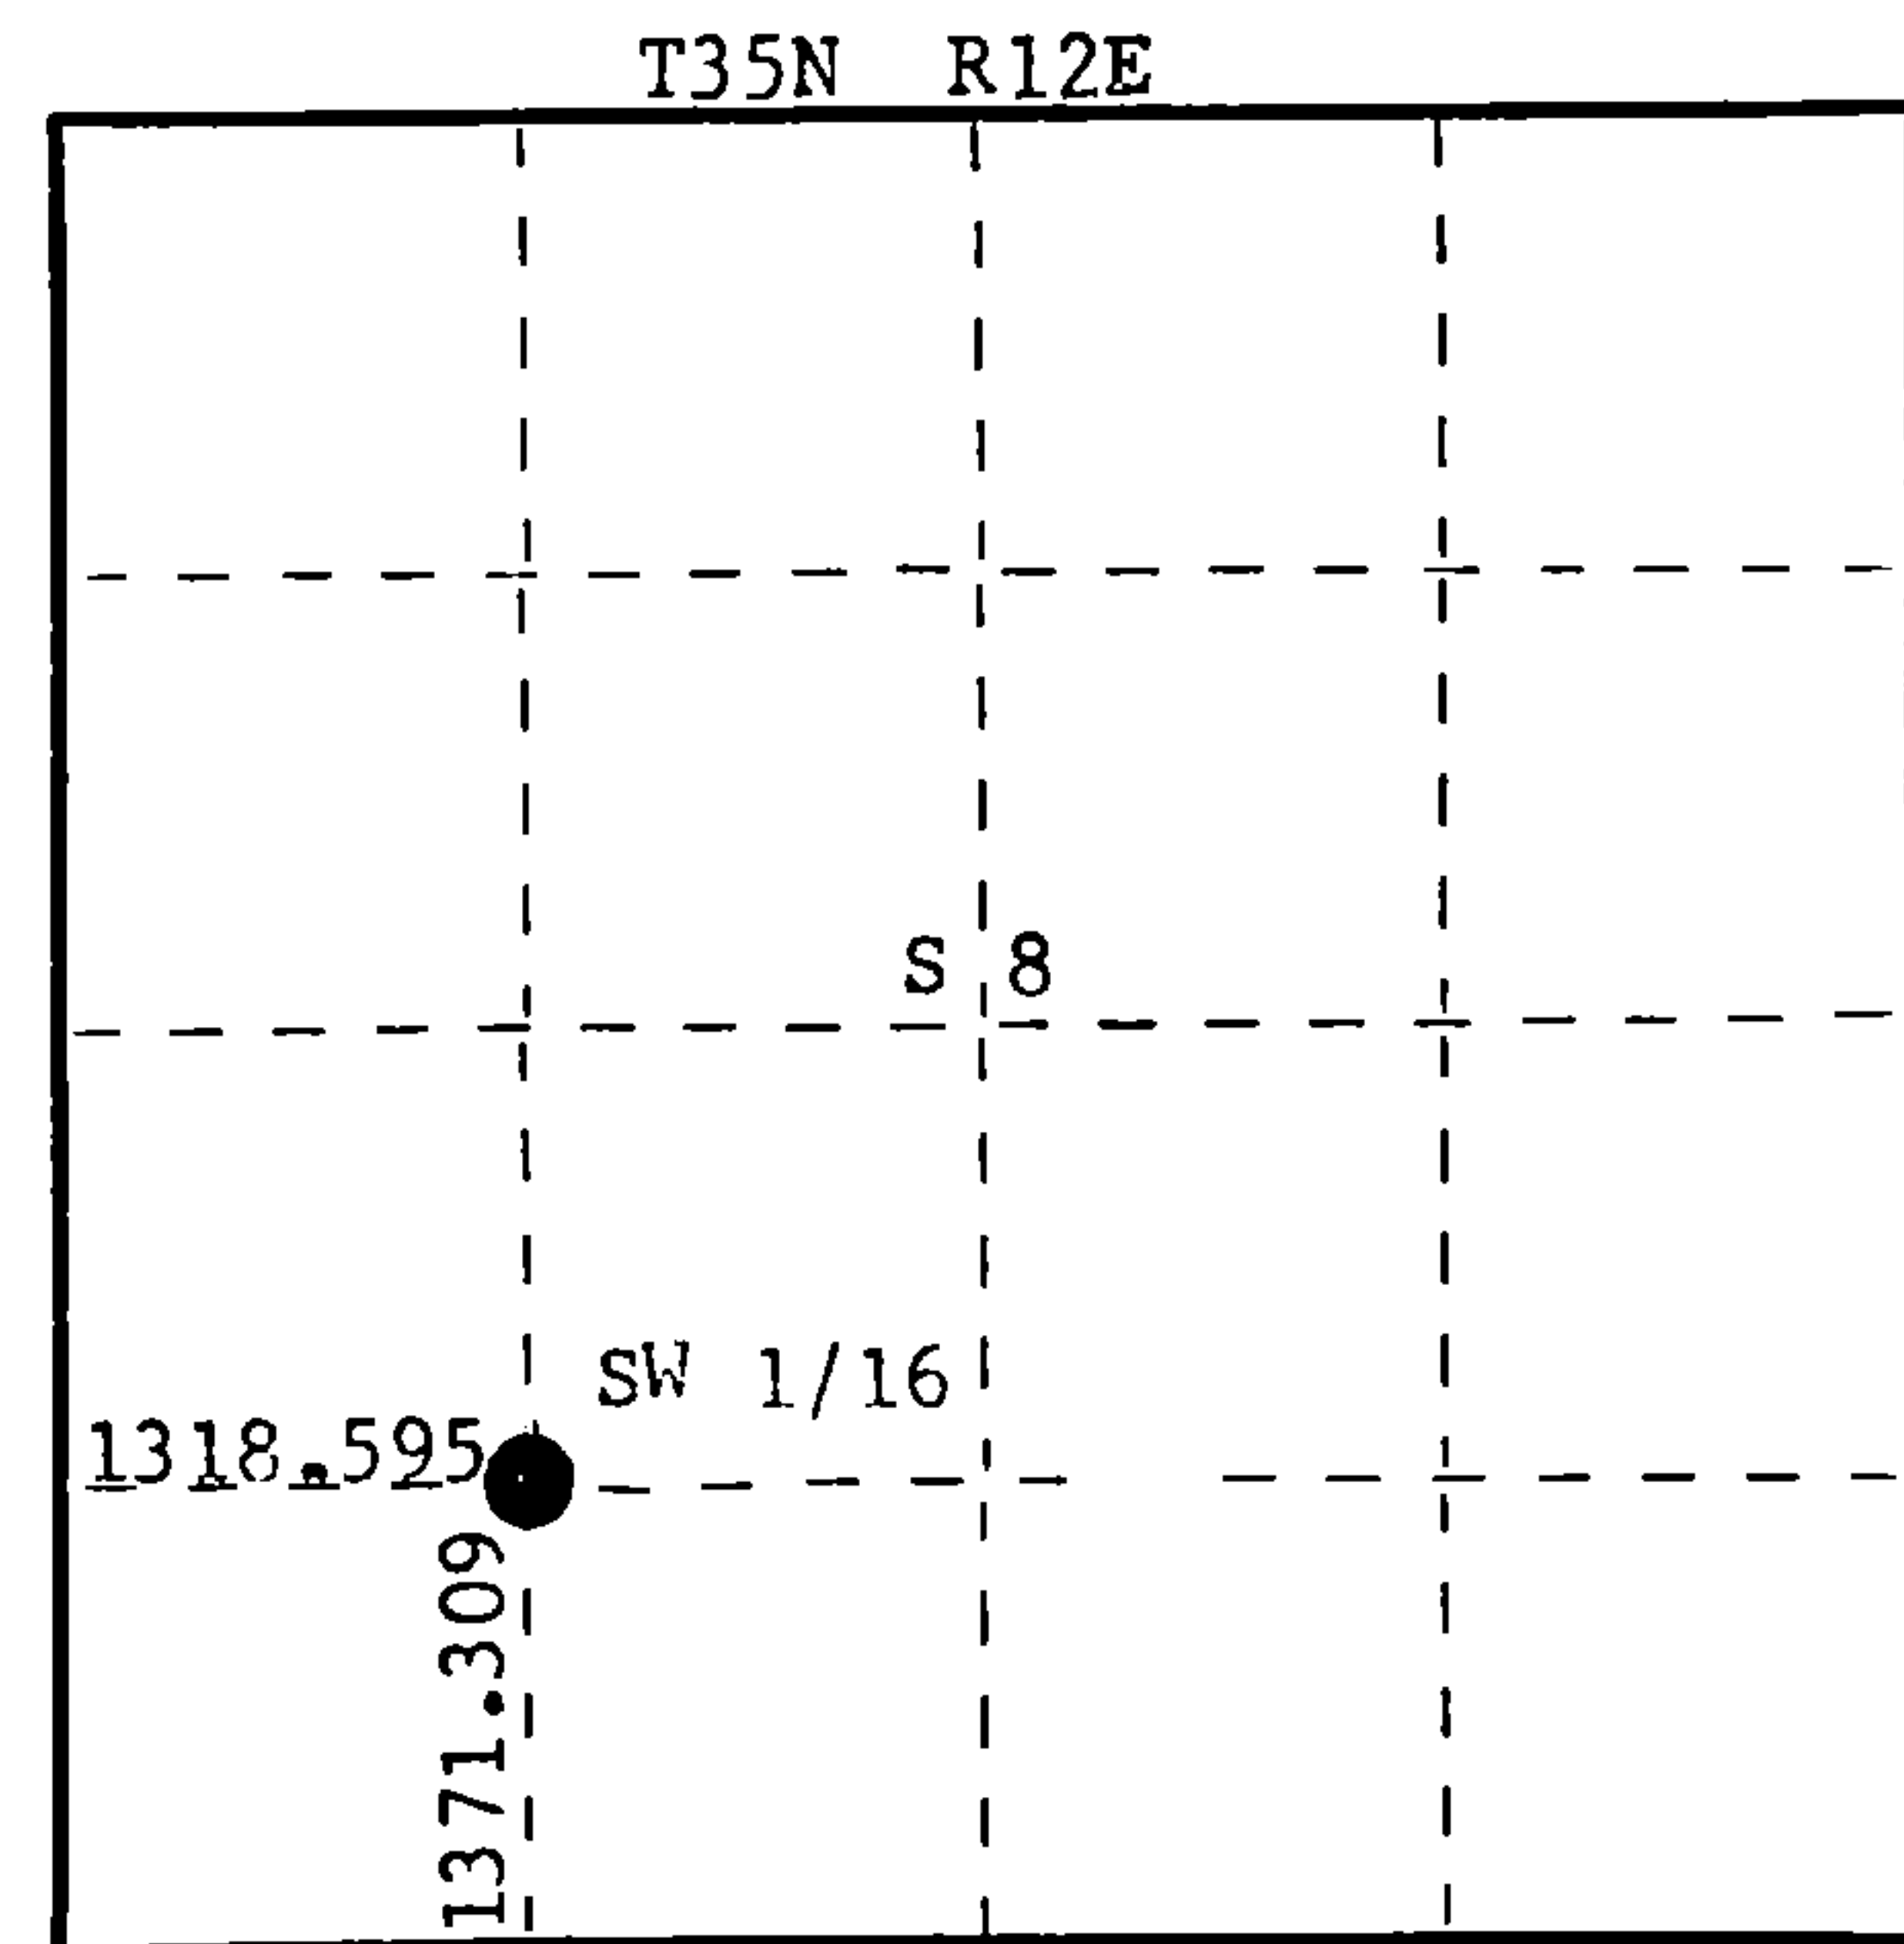

○ = Corner monument restored.

History of original corner establishment:

No records of any previous survey.

Description of corner evidence found:

No evidence of any corner recovered.

Corner established by traverse and proportion. Established the section corner and computed the E-W and N-W 1/4 lines to established C 1/4 corner. Computed the E-W and N-S 1/4 lines of SW 1/4. Set SW 1/16 at computed distances and bearings, S89° 20' 41" E 1318.595 chains from S 1/16 corner and N 1° 09' W 1371.309 ft. from W 1/16 between Sections 8 & 17.

Description of monument and accessories I established to perpetuate the original location of this corner.

Set 1 1/2" iron pipe with 2" brass cap projecting 2' above ground. Cap stamped:

Marked NBTs - Maple 5" S63°E, 24.55 links  
Maple 5" N36°E, 46.52 links, scribed 1/16 BT.

S498  
T35N R12E  
SW 1/16 S+8  
CPI-1977

Dated at Rhineland, Wis., this 12th day of December, 1977

Signature Philip T. Hansen Title Registered Land Surveyor Registration No. S-498  
(County Surveyor, Registered Land Surveyor, or other duly authorized official)

Office of Register of Deeds, County of Forest, I hereby certify that the within instrument was filed in this office for record on the 14th day of December, 1977 at 3:00 o'clock P. M.

Eugene Stutzman  
(Register of Deeds)  
By..... Deputy

DOCUMENT NUMBER **112966**

43512081030