

CERTIFIED LAND CORNER RESTORATION

Index No. **G-6**

State of Wisconsin } ss.  
County of Forest


I Philip T. Hansen, do hereby  
certify that on the 7th day  
of December, 1977, I ~~found~~  
established ~~evidence of~~ the WC 1/16  
corner of Section 8  
Township 35, North, Range  
12 East, Fourth Principal Meridian,  
as described hereon; and that from this evidence  
I established a new monument and accessories  
as described hereon to perpetuate the original  
location of this corner.

Resident witnesses:


Glen Barker

Jim Claflin

Herb Wagoner

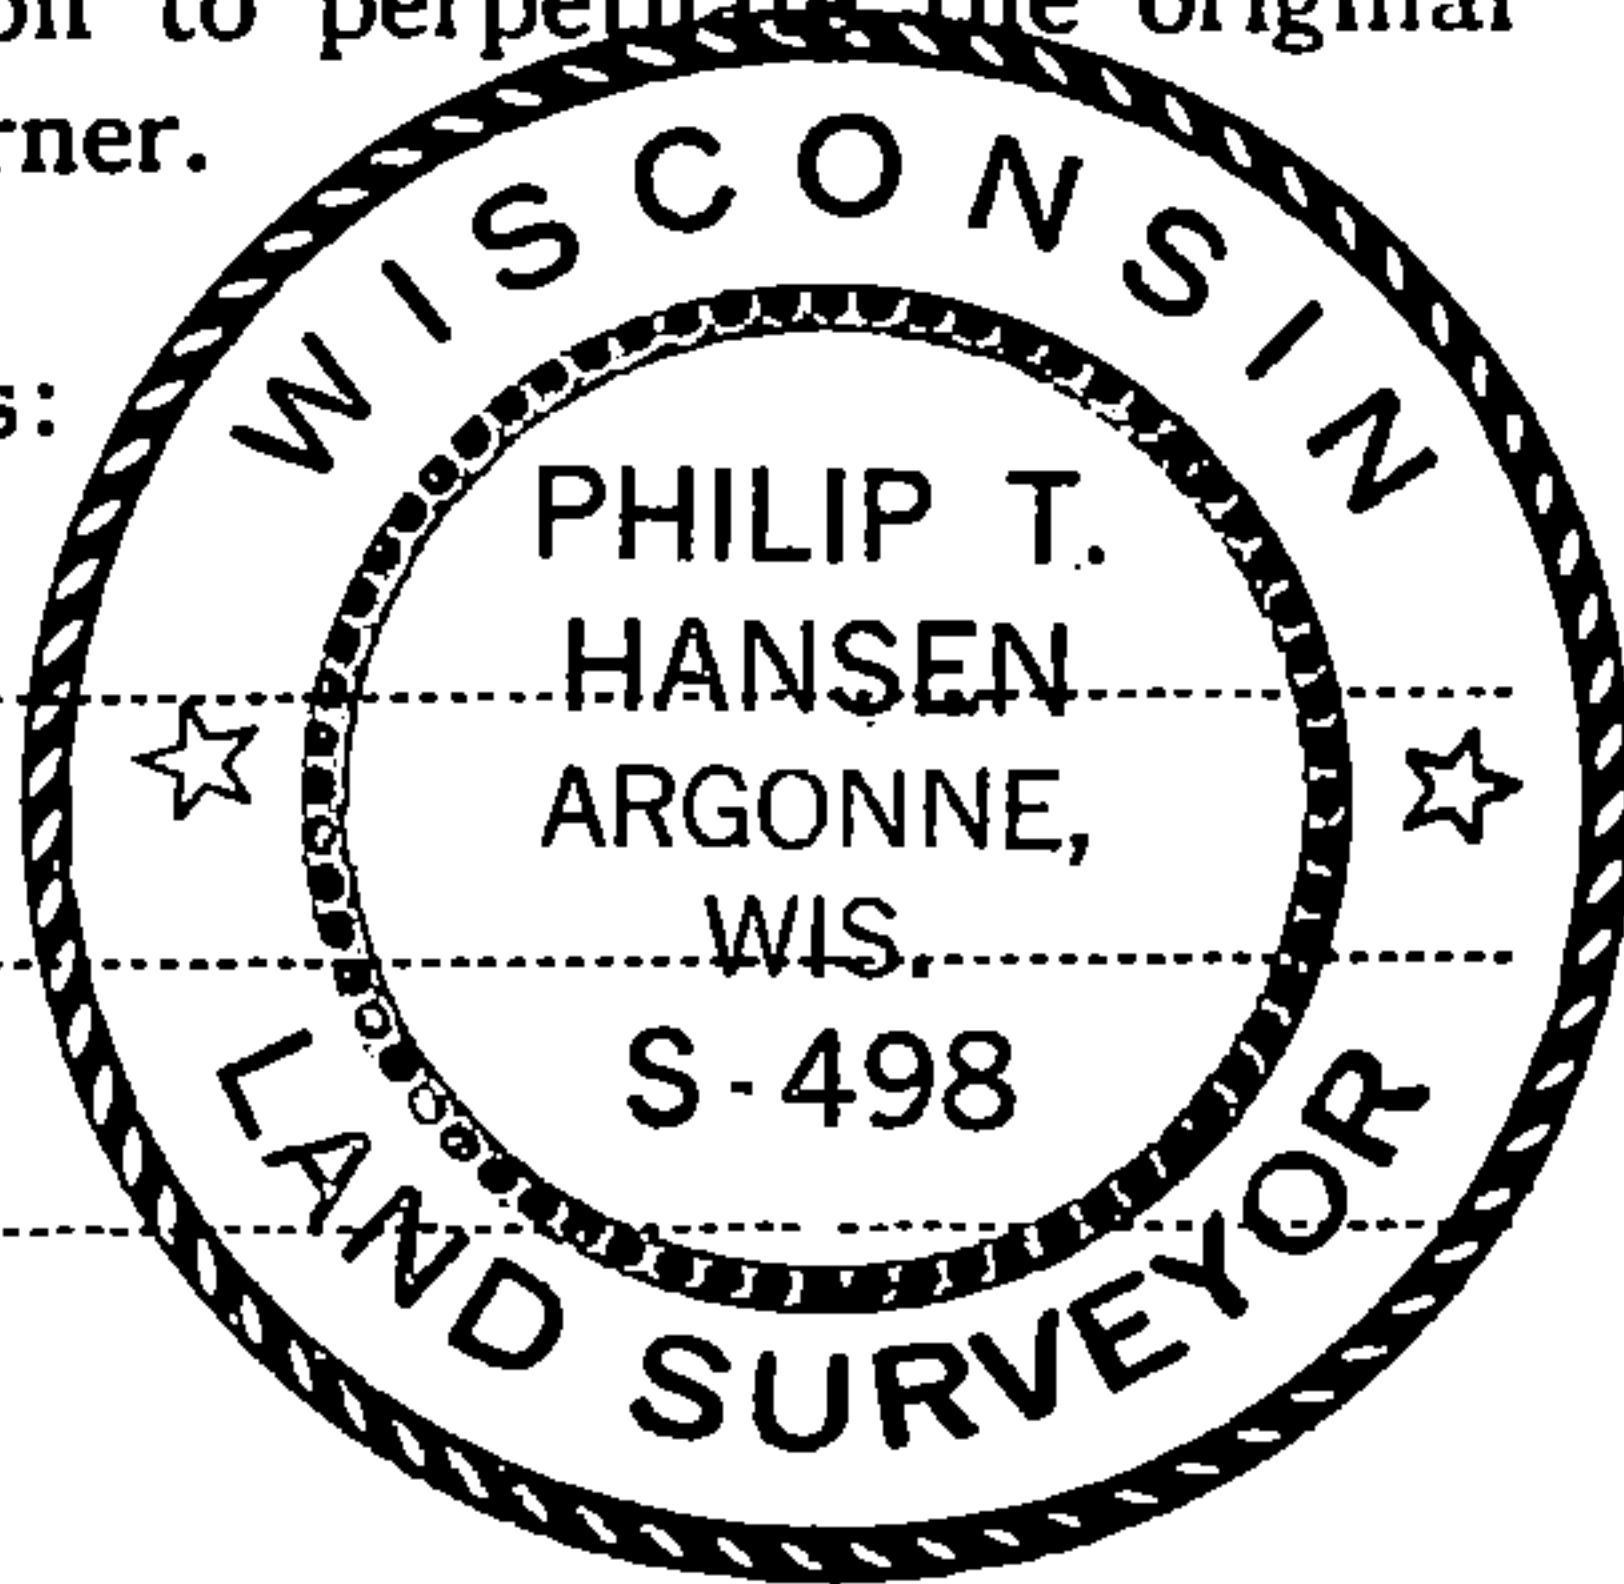

FORM 985 R. C. MILLER CO., MILWAUKEE

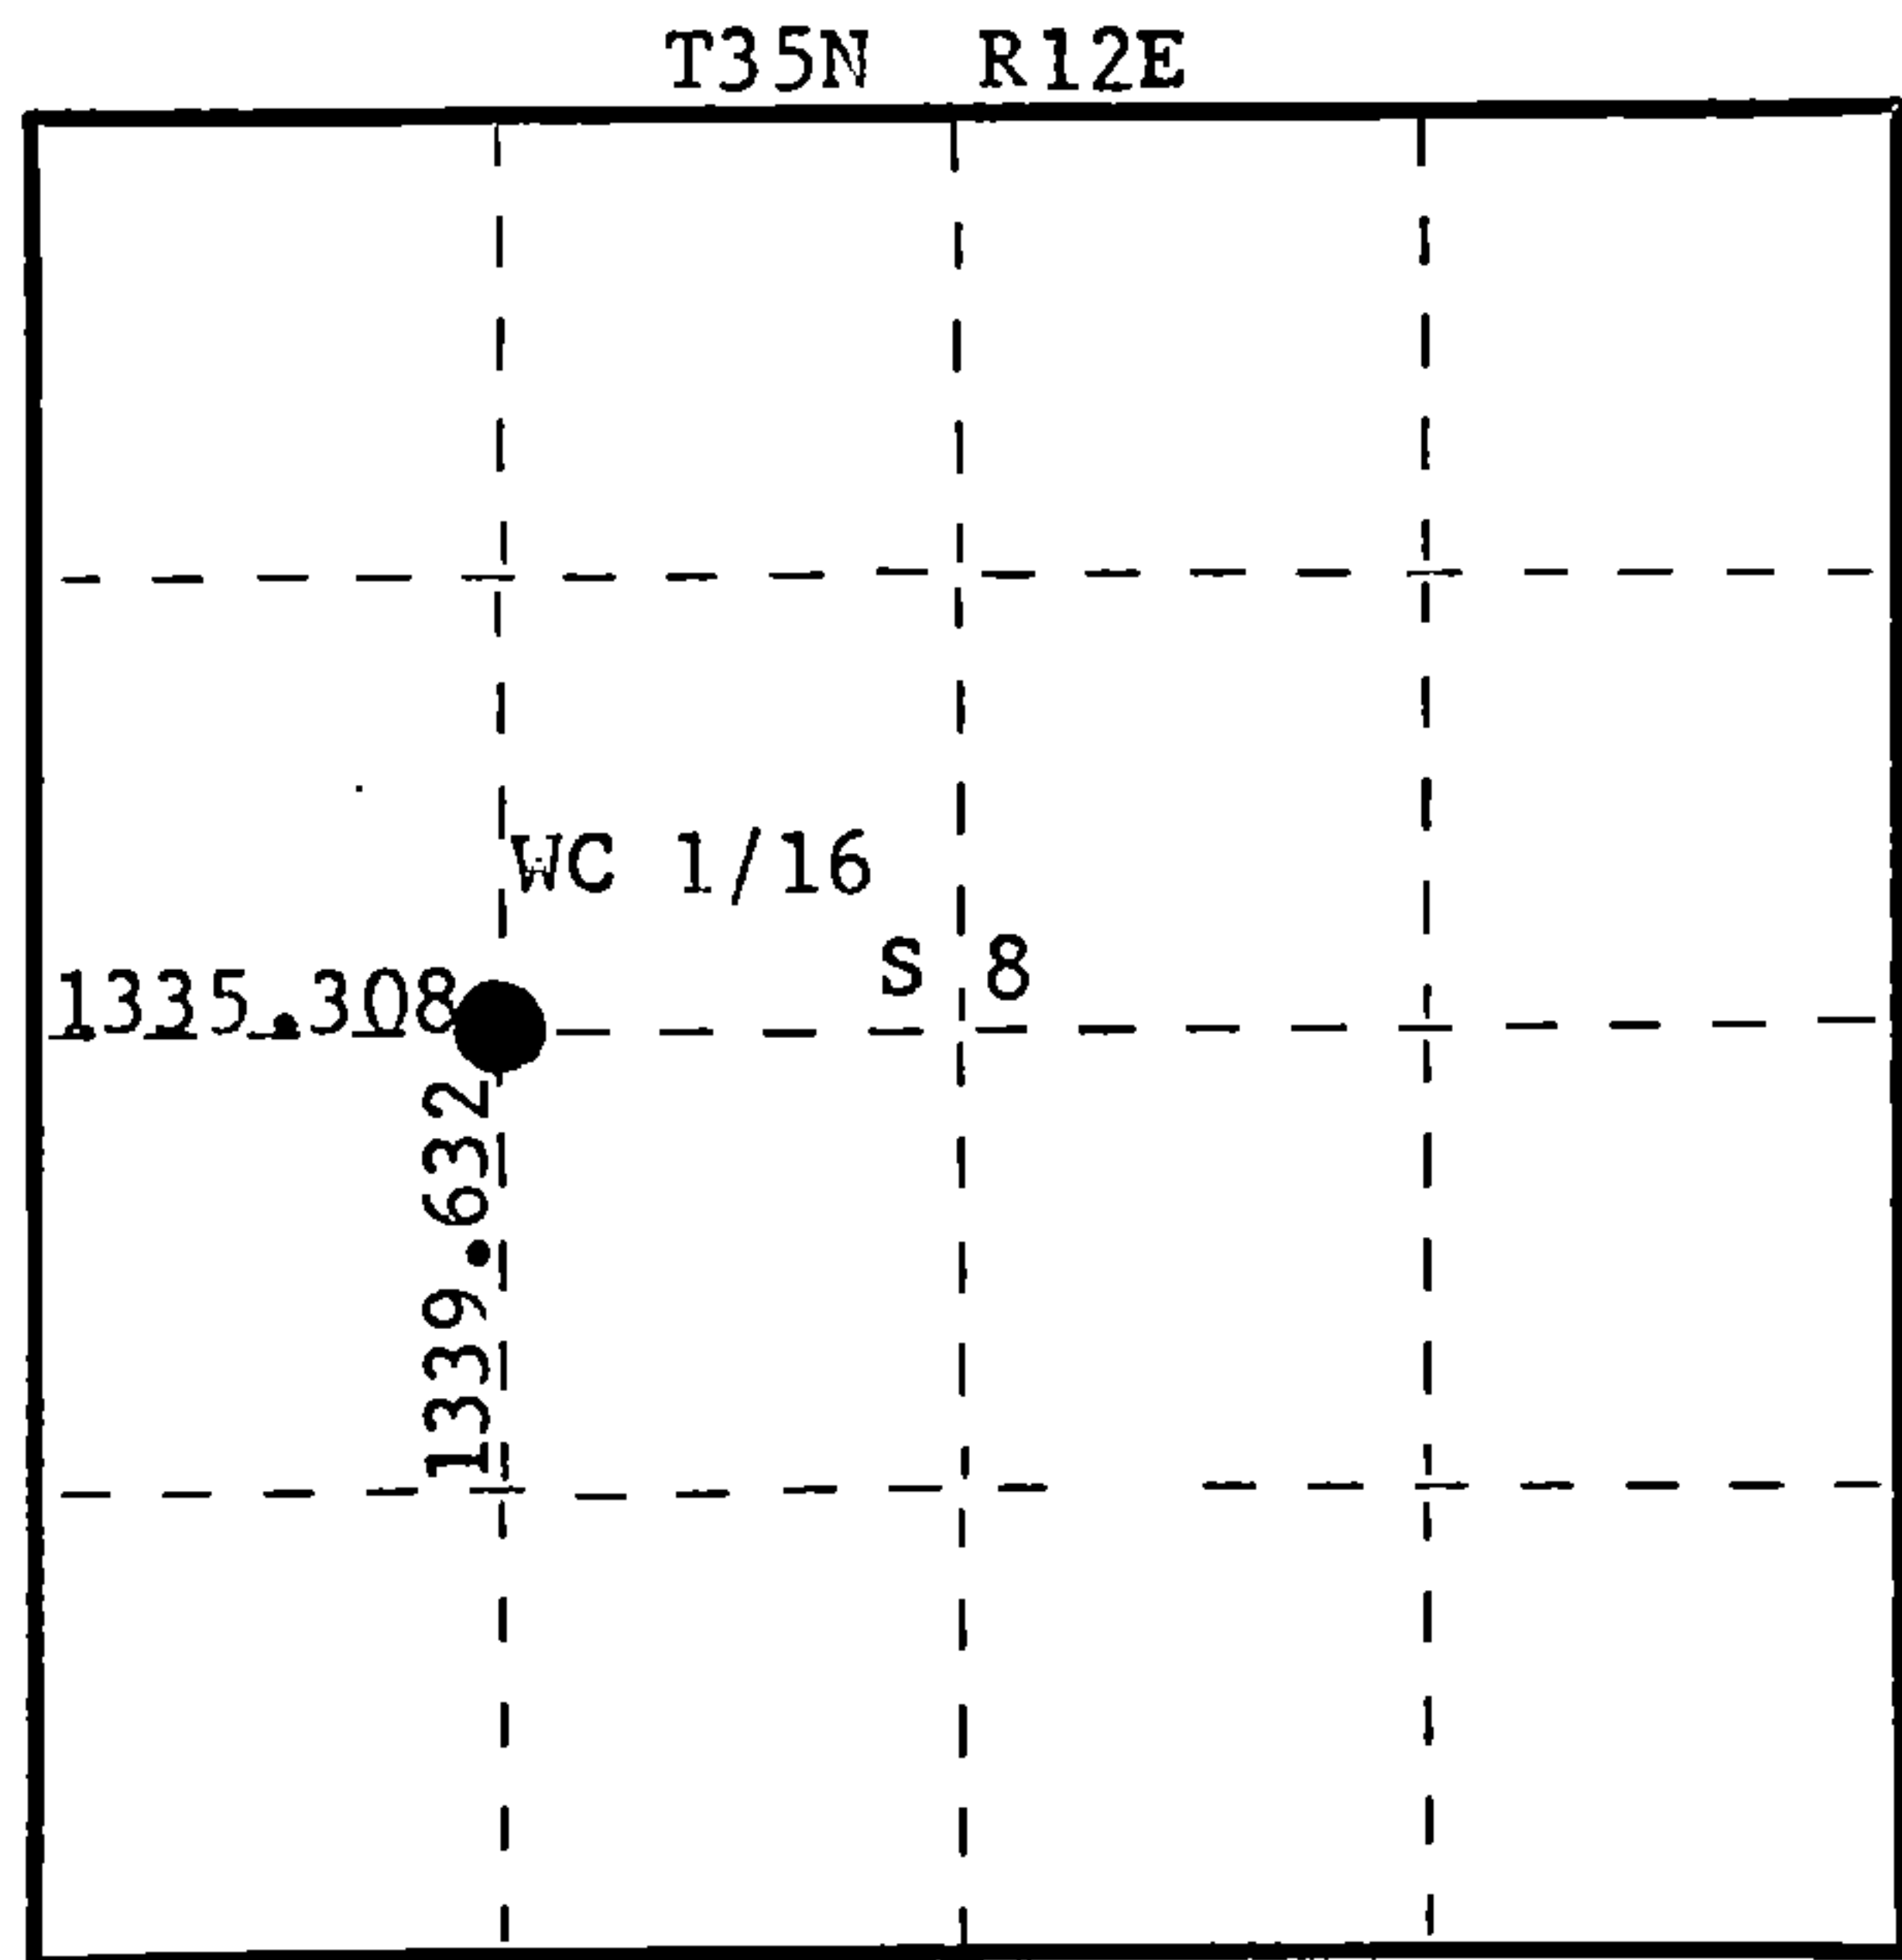

○ = Corner monument restored.

History of original corner establishment:

No record of any previous survey.

Description of corner evidence found:

No evidence of any corner recovered.

Corner established by traverse and computation. Established section and 1/4 corners.  
Computed the C 1/4 corner. Set the WC 1/16 corner at 1335.308 ft. N 87° 12' 49" E of  
W 1/4 corner, intermediate.

Description of monument and accessories I established to perpetuate the original location of this corner.

Set 1½" iron pipe with 2" brass cap, stamped:

Monument projects 24" above ground.

Marked NBT - Maple 7" S88°E, 65.15 links.

Maple 5" S49°W, 96.06 links, scribed 1/16 BT.

S498  
T35N R12E  
WC 1/16 S + 8  
CPI-1977

Dated at Rhinelander, Wis., this 12th day of December, 1977

Signature *Philip T. Hansen* Title Registered Land Surveyor Registration No. S-498  
(County Surveyor, Registered Land Surveyor, or other duly authorized official)

Office of Register of Deeds, County of Forest, I hereby certify that the within  
instrument was filed in this office for record on the 11th day of December, 1977  
at 3:00 o'clock P. M.

*Eugene Stutzman*  
(Register of Deeds)

DOCUMENT NUMBER --- 112965

By Deputy

43512.082030