

CERTIFIED LAND CORNER RESTORATION

Index No. G-17

State of Wisconsin }  
County of Forest } ss.


I Philip T. Hansen, do hereby certify that on the 28th day of September, 19 77, I found evidence of the Quarter corner of Section 10 & 11 Township 35, North, Range 12 East, Fourth Principal Meridian, as described hereon; and that from this evidence I established a new monument and accessories as described hereon to perpetuate the original location of this corner.

Resident witnesses:


Glen Barker

Jim Claflin

Herb Wagoner

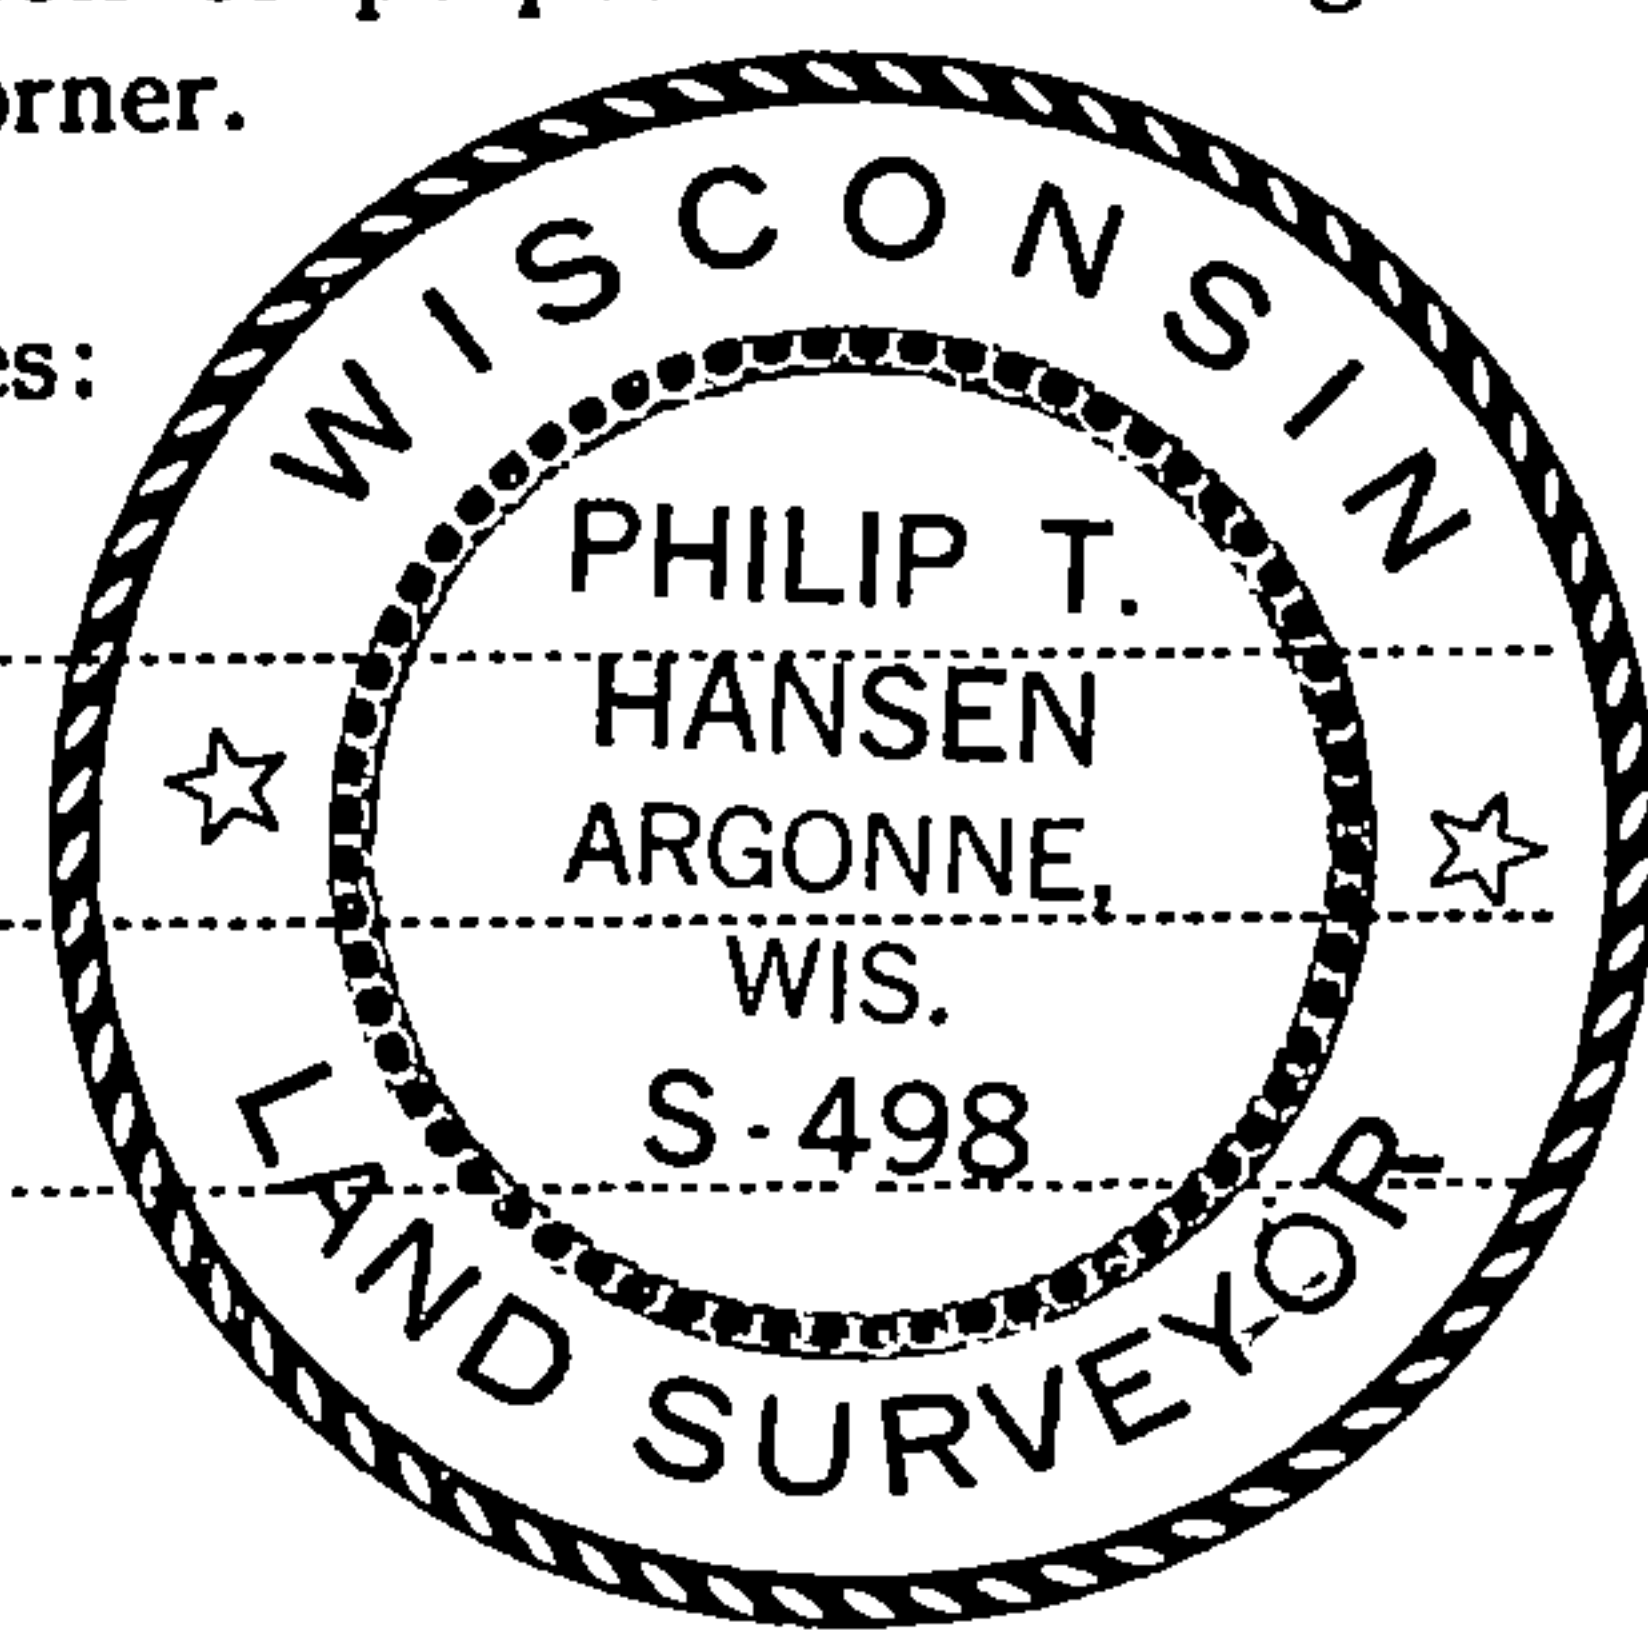

FORM 985 R. C. MILLER CO., MILWAUKEE

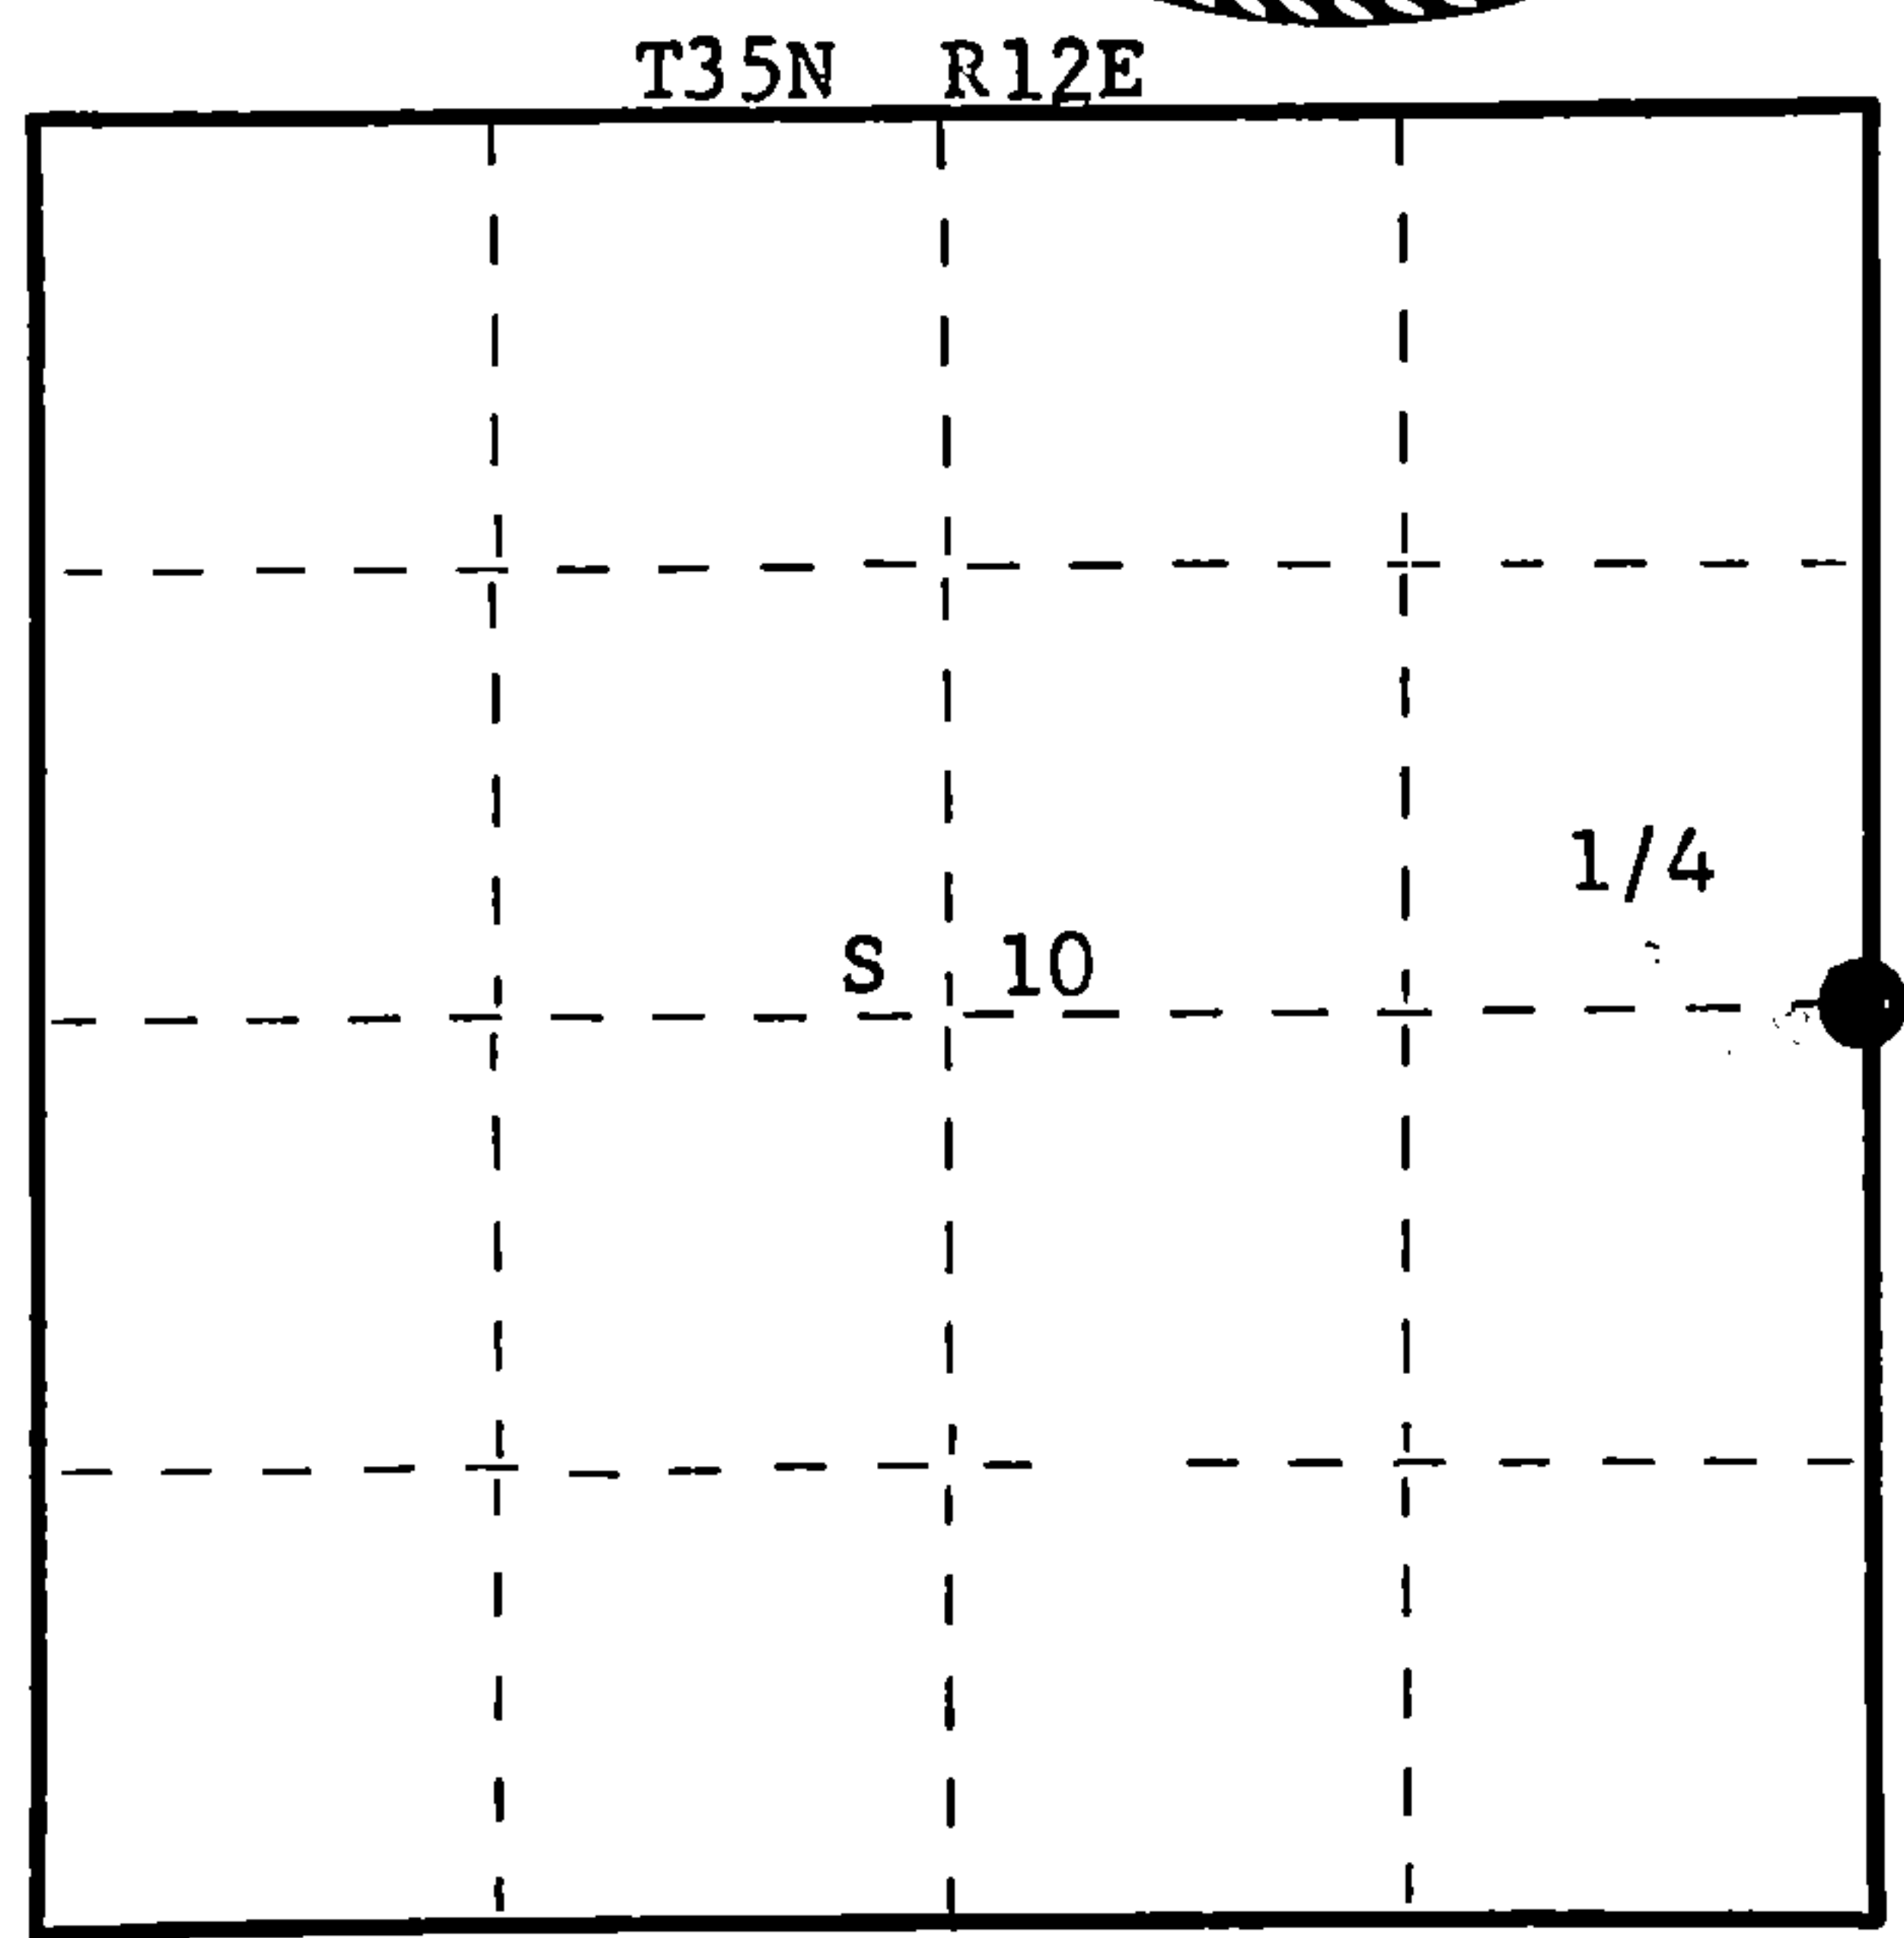

○ = Corner monument restored.

History of original corner establishment:

Original corner established by Hiram Fellows, Deputy Surveyor, in 1859, from which Birch 12" bears N 71° E, 15 links and Birch 18" bears S25°W, 20 links.

No records of any subsequent survey.

Description of corner evidence found:

Recovered very old 1 1/2" x 3" iron pipe projecting 1 1/2' above ground. No evidence of any of the old BTs. Timber type now small aspen and balsam. Corner sets approximately 16 chains north of County Trunk B.

Description of monument and accessories I established to perpetuate the original location of this corner.

Replaced iron pipe with 2 1/2" Berntsen A-1 Federal Monument, aluminum with magnet in cap and base. Monument projects 2' above ground. Cap stamped:  
Marked NBTs - Maple 6" S36°W, 51.6 links  
Maple 8" S69°W, 68.8 links  
Yellow Birch 8" N70°E, 77.5 links, all scribed 1/4 BT.

T35N R12E  
1/4 10 | 11  
S498 - 1977

43512102000

Dated at Rhineland, Wis., this 3rd day of October, 19 77

Signature Philip T. Hansen Title Registered Land Surveyor Registration No. S-498  
(County Surveyor, Registered Land Surveyor, or other duly authorized official)

Office of Register of Deeds, County of Forest, I hereby certify that the within instrument was filed in this office for record on the 7th day of October, 19 77 at 2:45 o'clock P. M.

Eugene Staszny  
(Register of Deeds)  
By \_\_\_\_\_ Deputy

DOCUMENT NUMBER **112528**