

CERTIFIED LAND CORNER RESTORATION

Index No. J-11

State of Wisconsin }
County of Forest } ss.

I, Thomas R. Arnott, do hereby certify that on the 17th day of September, 19 75, I found evidence of the section corner of 7, 12, 13 & 18 Township 35, North, Range 12 & 13 E, Fourth Principal Meridian, as described hereon; and that from this evidence I established a new monument and accessories as described hereon to perpetuate the original location of this corner.

Resident witnesses:

Herbert Wagoner

History of original corner establishment:

Hemlock	14	N70E	55 Lks.
W. Birch	10	N50W	9 Lks.
Hemlock	20	S57E	51 Lks.
Hemlock	14	S46W	47 Lks.

Description of corner evidence found:

R.R. Spike found




Description of monument and accessories I established to perpetuate the original location of this corner.

Left R.R. Spike found in place

Ties:

New Forest County aluminum monument $S89^{\circ}45'E$ 29.31 feet
Nothing else in area to tie to.

FORM 985 M. C. MILLER CO., MILWAUKEE

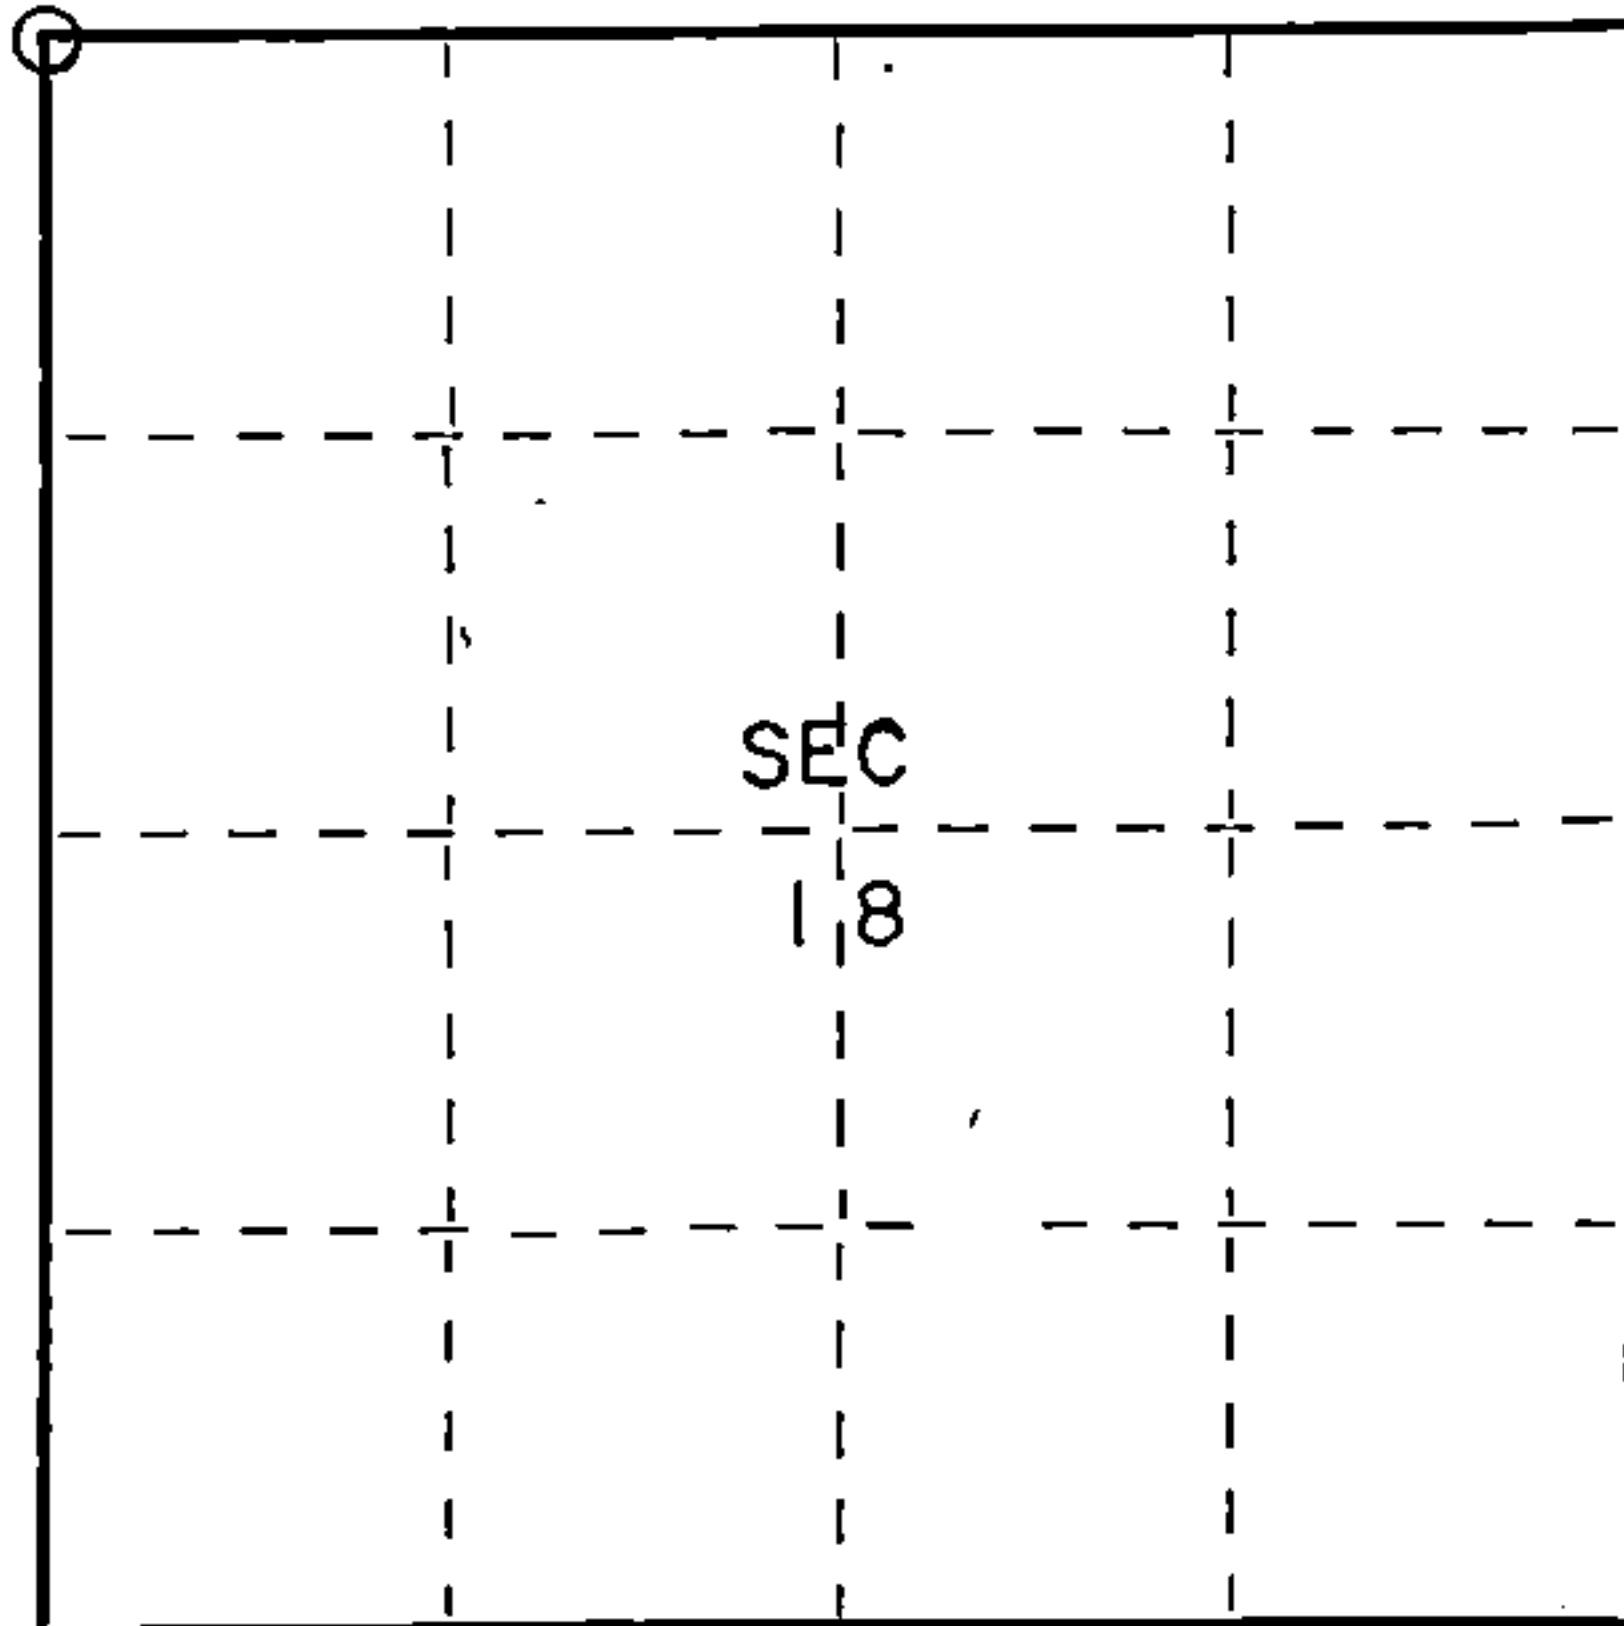

○ = Corner monument restored.

Dated at Crandon, Wis., this 10th day of November, 19 75.

Signature: Thomas R. Arnott Title Land Surveyor Registration No. S-887
(County Surveyor, Registered Land Surveyor, or other duly authorized official)

Office of Register of Deeds, County of Forest, I hereby certify that the within instrument was filed in this office for record on the 10th day of November, 19 75 at 3 o'clock P. M.

EUGENE STATEZNY Document Number 108179
(Register of Deeds)

By Eileen Schmidt Deputy

43512120000