

CERTIFIED LAND CORNER RESTORATION

Index No. **R21**

State of Wisconsin }  
County of Forest } ss.

I Stuart L. Foltz, do hereby certify that on the 10th day of January, 1977, I found evidence of the Section corner of Sections 23, 24, 25 & 26 Township 35, North, Range 12 East, Fourth Principal Meridian, as described hereon; and that from this evidence I established a new monument and accessories as described hereon to perpetuate the original location of this corner.

Resident witnesses:

.....  
.....  
.....

History of original corner establishment:

Date of original survey: June 26th, 1865 to July 7th, 1865  
Original surveyor: James L. Nowlin  
Original monument: Wood post  
Original bearing trees: 6" spruce N67°E 15 lks. (9.90')  
7" tamarac N25°W 20 lks. (13.20')


Description of corner evidence found:

Old wood post found; very old broken off cedar ram pike bears N72°W, + 7.3'; ram pike is faced off on side toward wood post and a scribed "B" is visible just above the location where it was broken; a scribed "23" is visible on the facing about 1-1/2' higher, and an "x" still higher apparently made with a cruiser's axe; a stump with visible scribing was found bearing N67°E, 9.9 feet; this stump is probably the remains of the original 6" spruce bearing tree.


Description of monument and accessories I established to perpetuate the original location of this corner.  
Set Forest County aluminum monument (2" aluminum pipe with cast aluminum cap)

New bearing trees: 14" cedar S25°W 16.1'  
7" spruce N46°E 16.9'

FORM 985 H. C. MILLER CO., MILWAUKEE

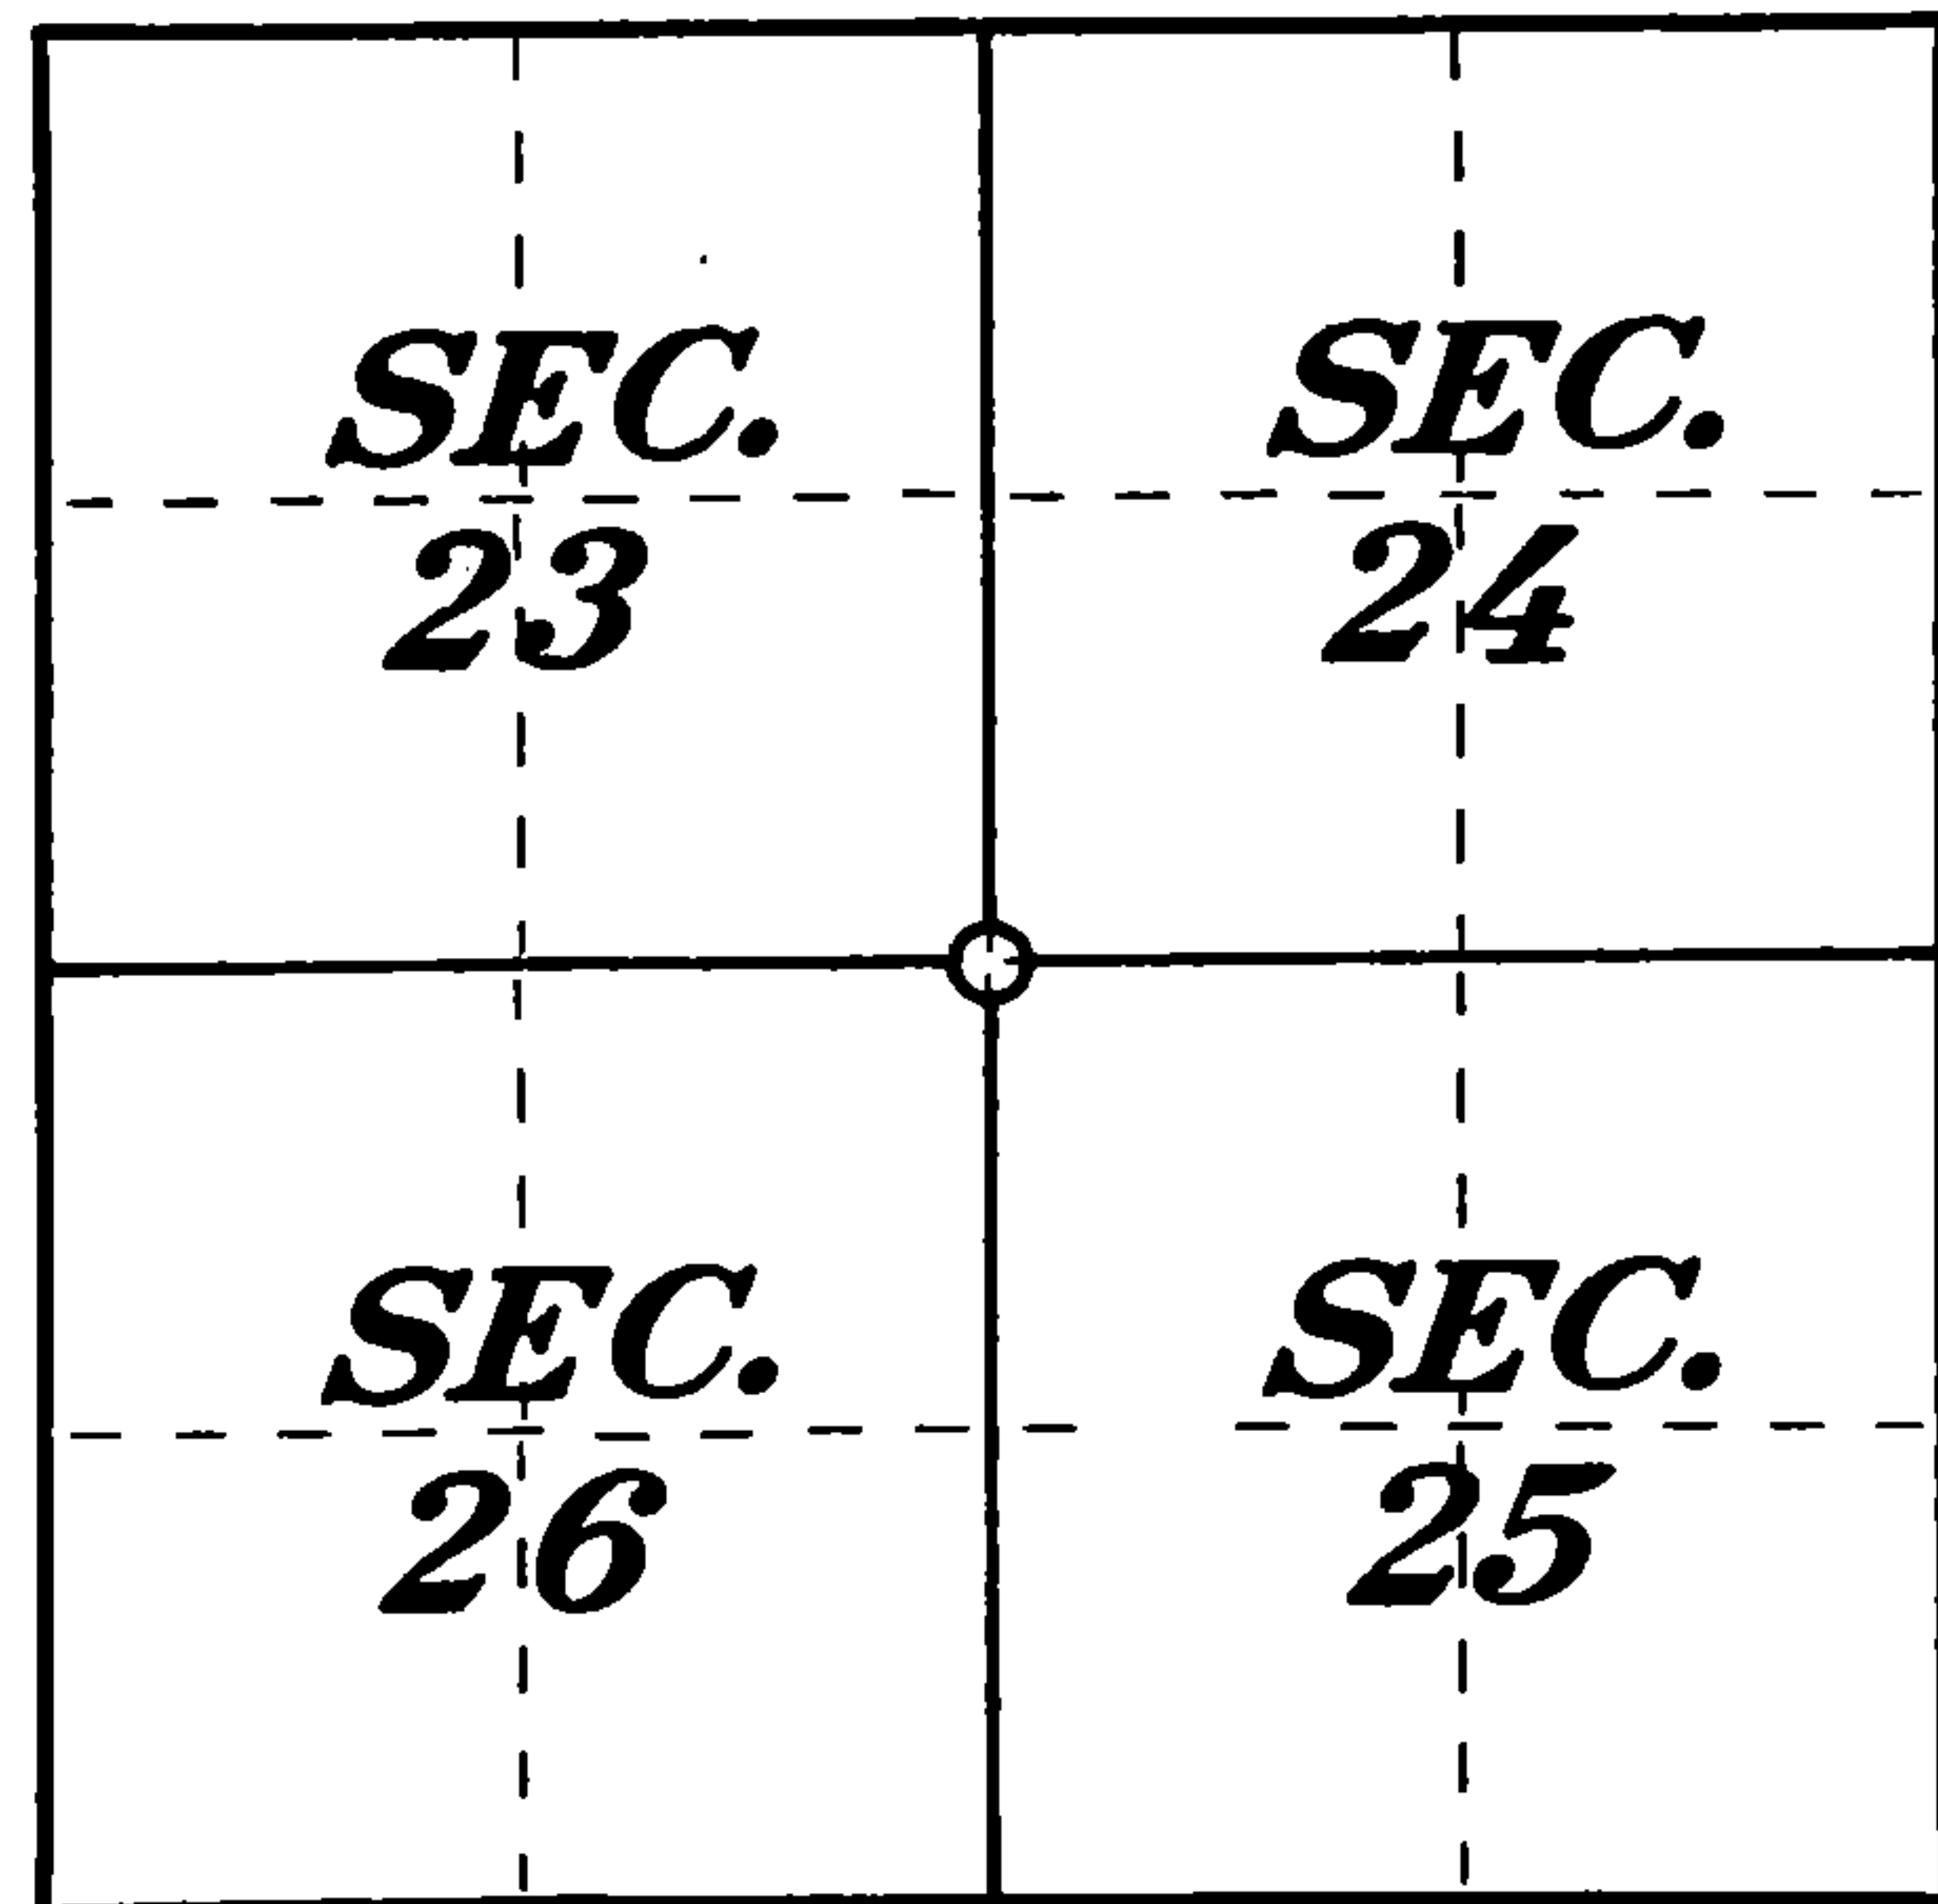

○ = Corner monument restored.

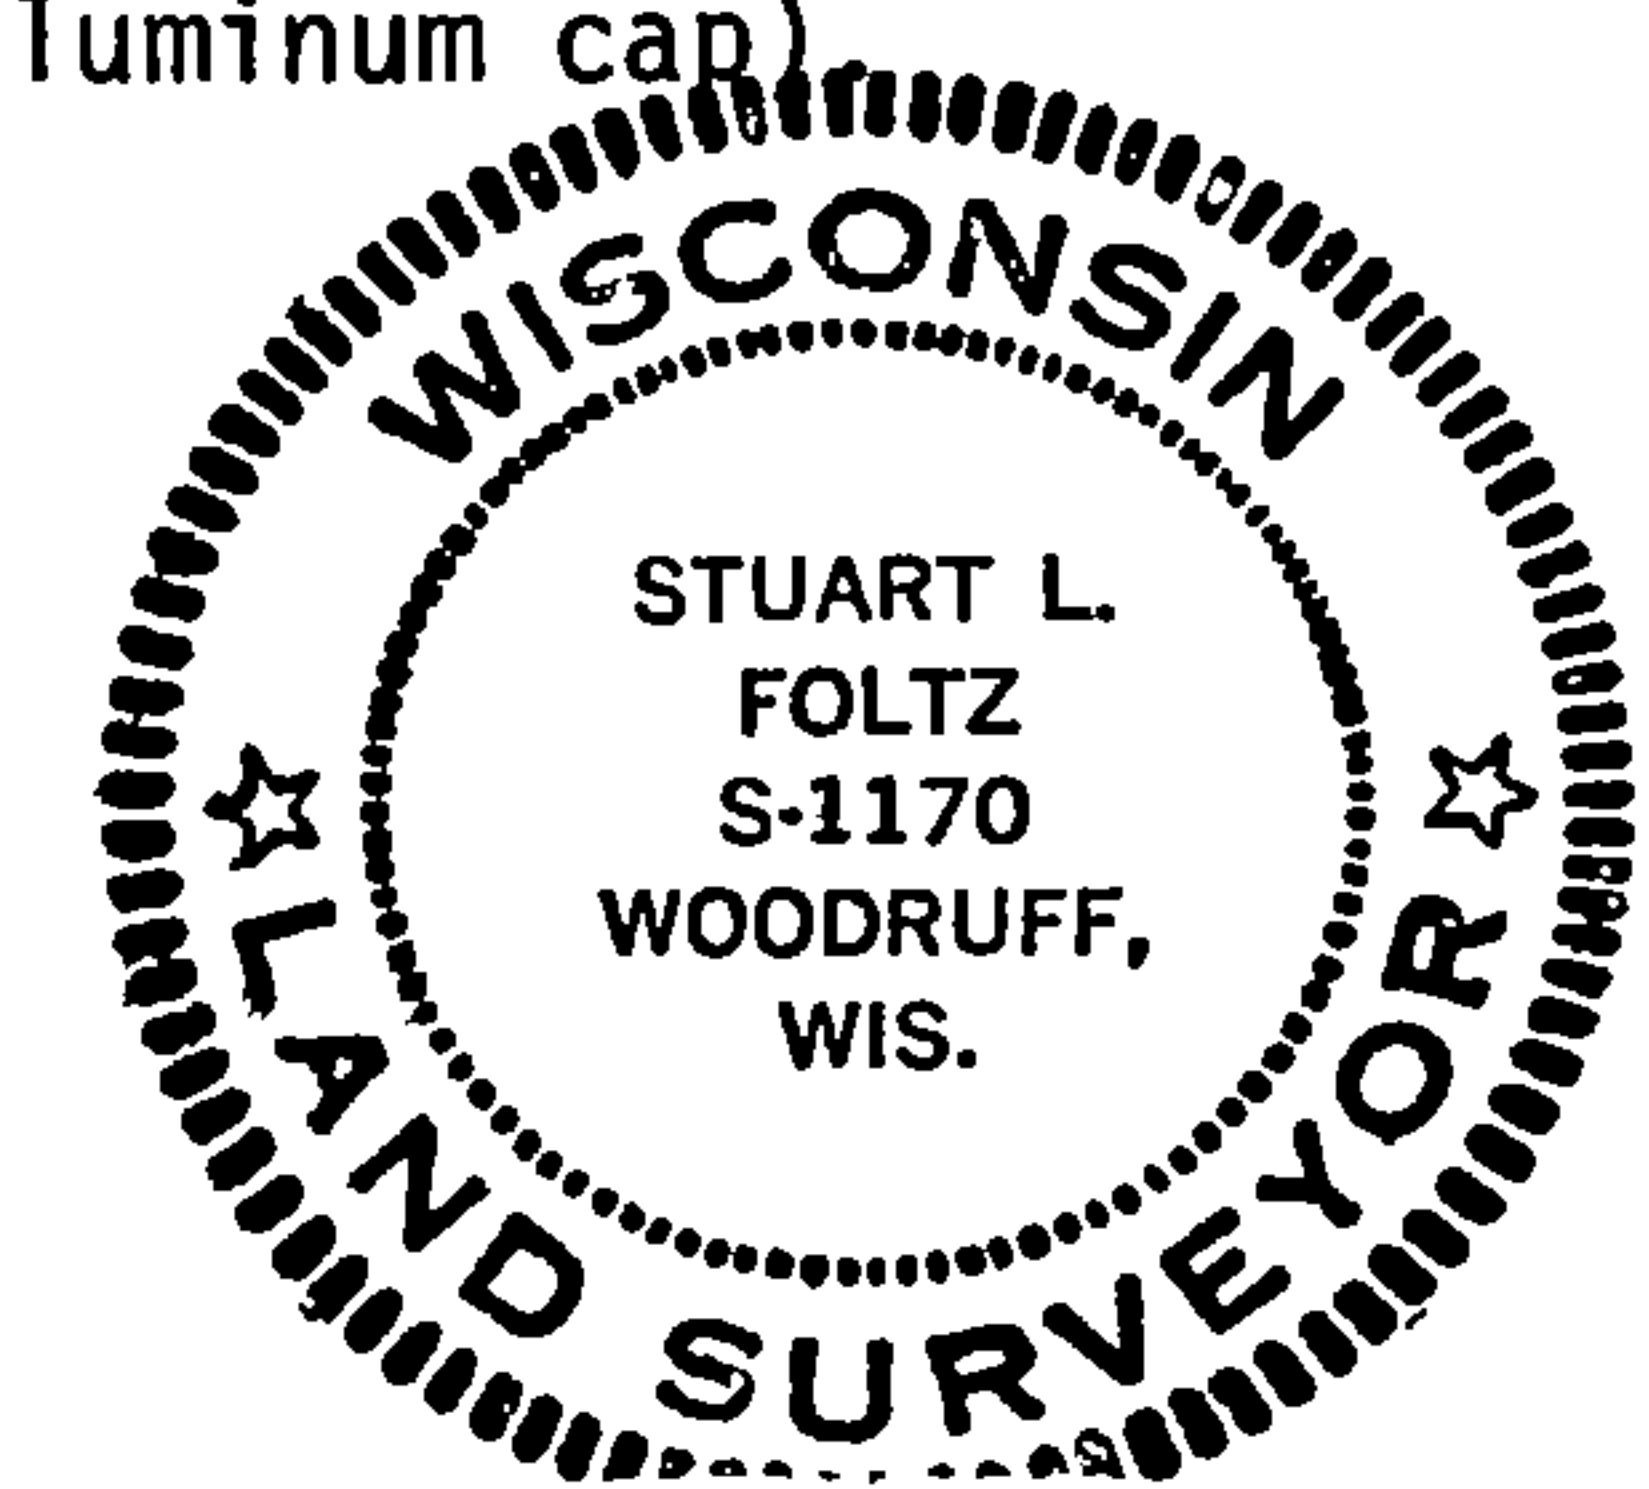

Dated at Minocqua, Wis., this 23rd day of February, 1977

Signature Stuart L. Foltz Title Registered Land Surveyor Registration No. S-1170  
(County Surveyor, Registered Land Surveyor, or other duly authorized official)

Office of Register of Deeds, County of Forest, I hereby certify that the within instrument was filed in this office for record on the 21st day of April, 1977 at 9:30 o'clock A. M.

Eugene Staszny  
(Register of Deeds)  
By \_\_\_\_\_ Deputy

DOCUMENT NUMBER  
**111266**

H3512230000