

CERTIFIED LAND CORNER RESTORATION


Index No. **R23**

State of Wisconsin }
County of Forest } ss.

I Stuart L. Foltz do hereby certify that on the 10th day of January, 1977, I found evidence of the one quarter corner corner of Sections 24 and 25 Township 35 North, Range 12 East, Fourth Principal Meridian, as described hereon; and that from this evidence I established a new monument and accessories as described hereon to perpetuate the original location of this corner.

Resident witnesses:

FORM 985 H. C. MILLER CO., MILWAUKEE

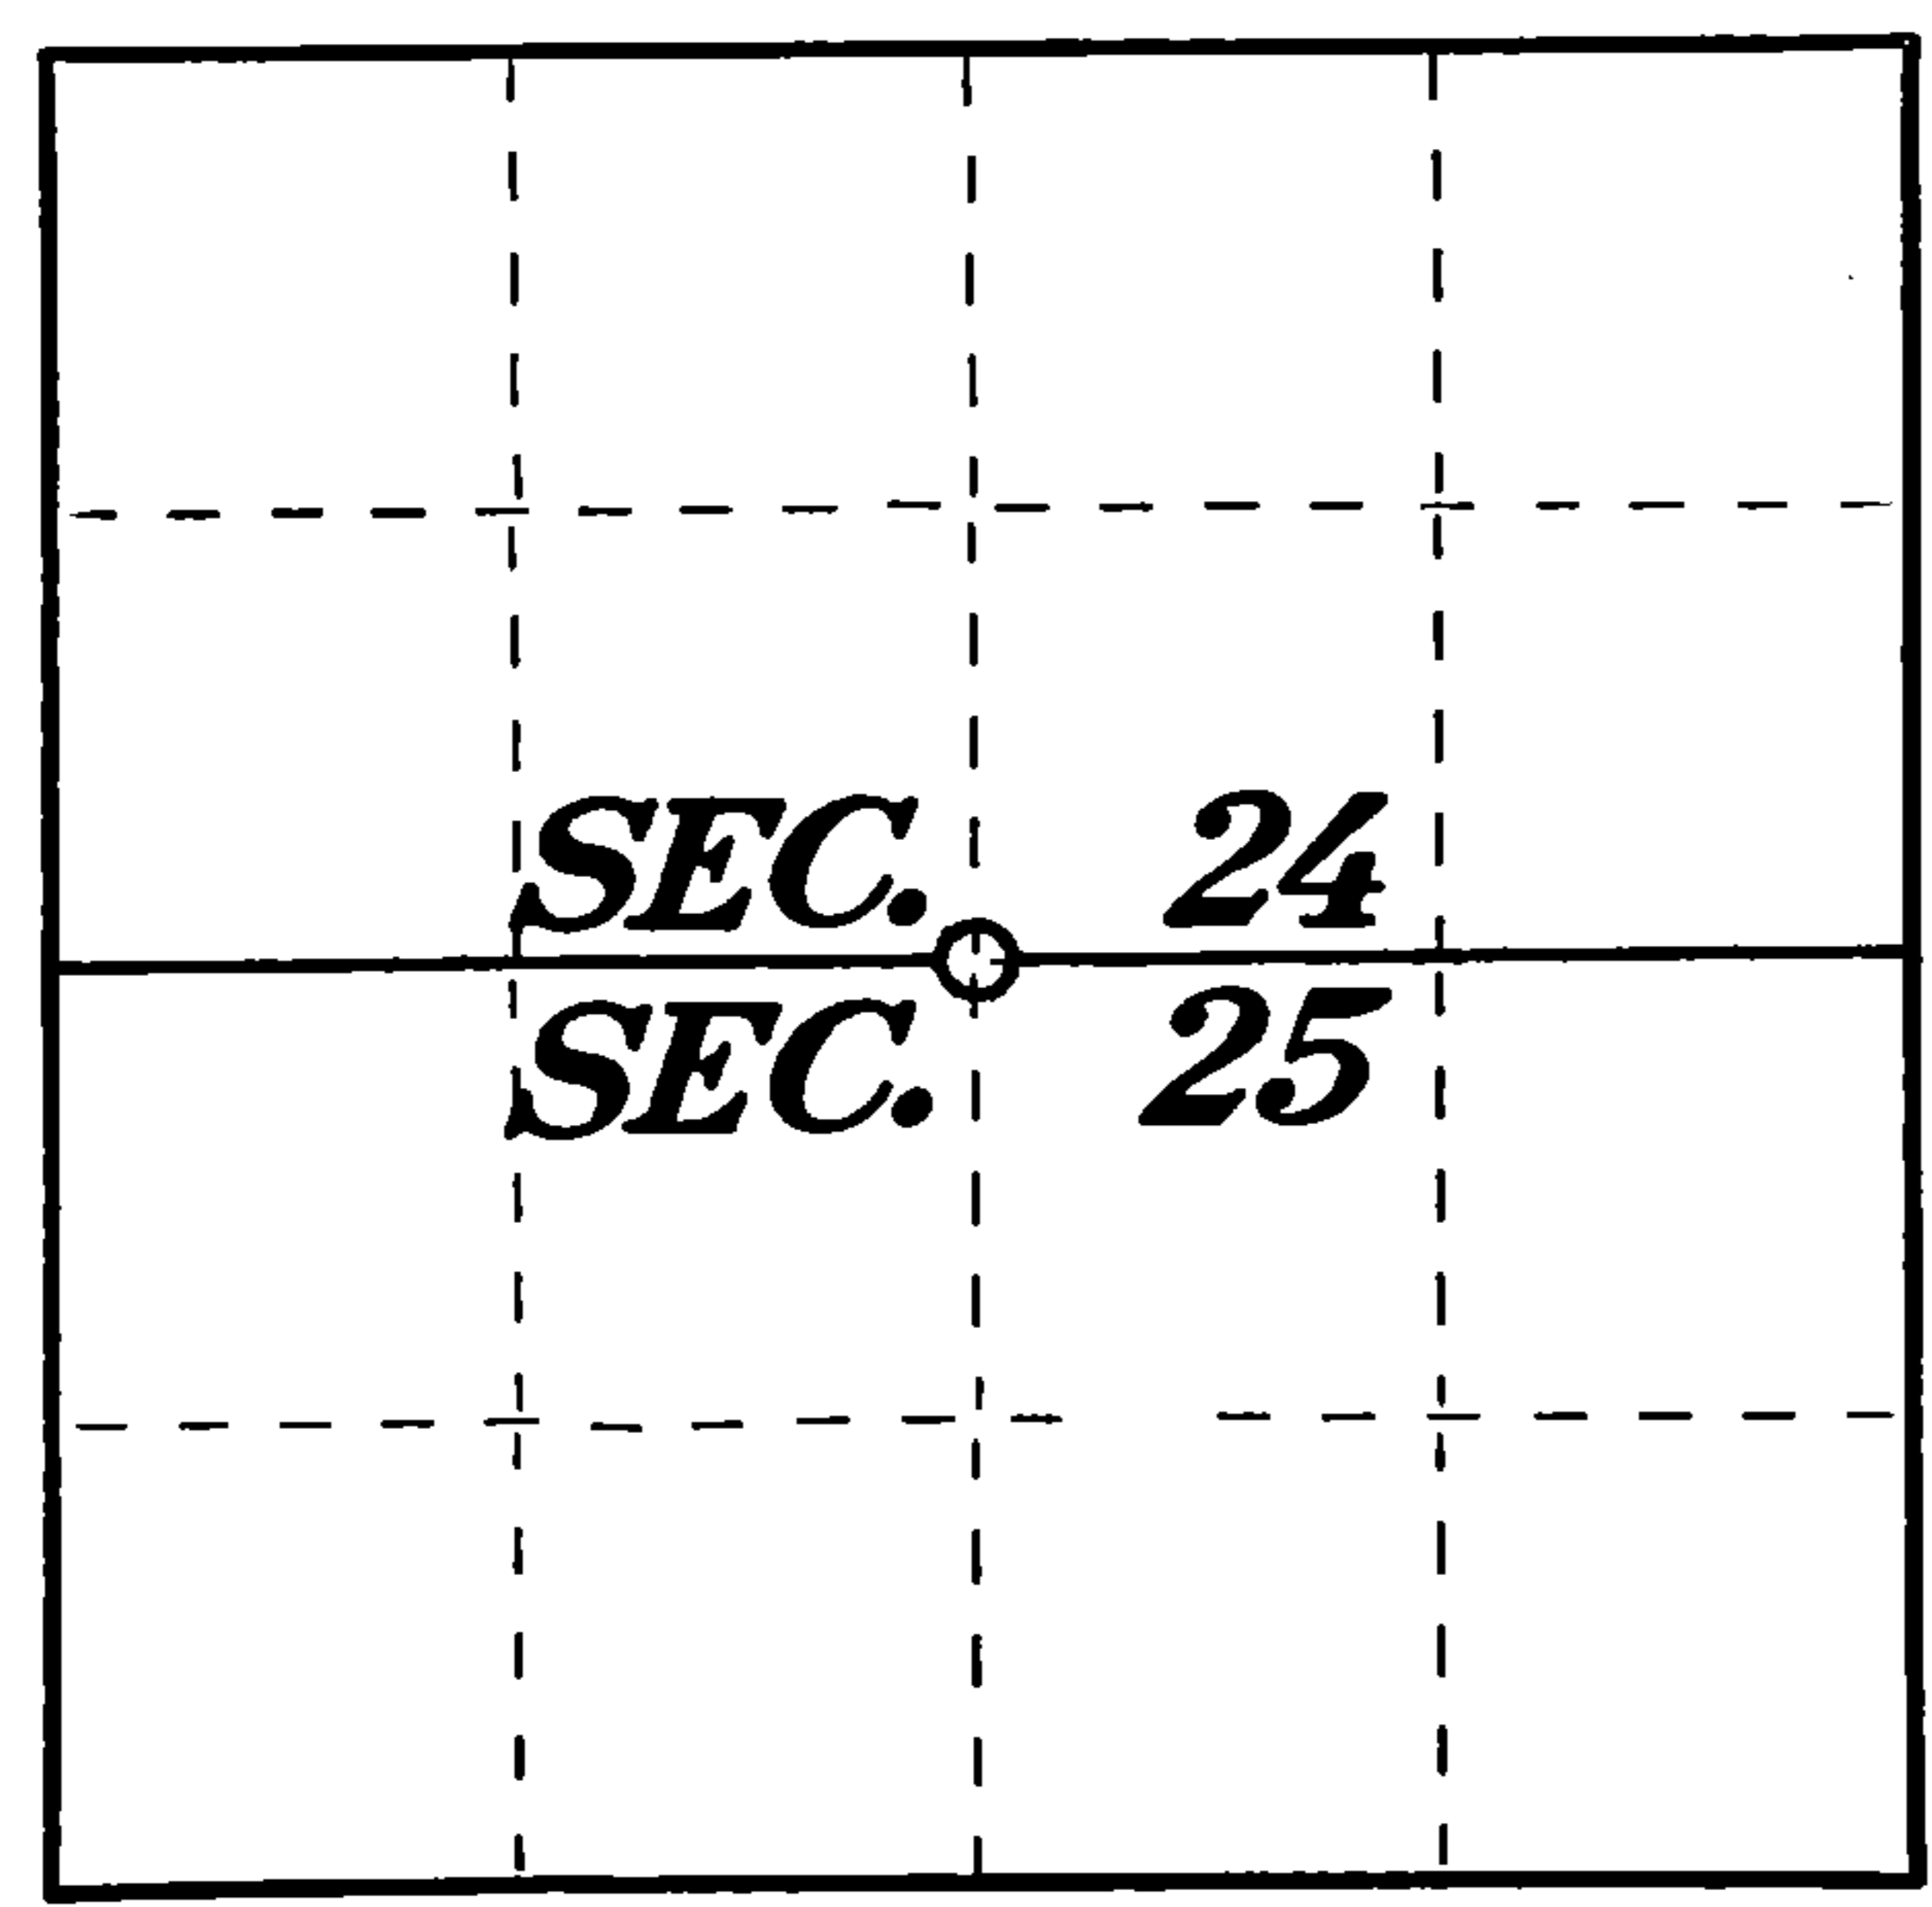


○ = Corner monument restored.

History of original corner establishment:
Date of original survey: June 26th, 1865 to July 7th, 1865
Original surveyor: James L. Nowlin
Original monument: Wood post
Original bearing trees: 15" white pine N65°E, 20 lks. (13.20')
12" white pine S58°W, 25 lks. (16.50')

Description of corner evidence found:
Fallen tree scribed "1/4S" found S68°W, + 15.5', probably original 12" white pine: rotted stump N65°E, 13.2' fits location of original 15" white pine: 16" norway pine bearing S50°W, 7.0' has 2 sided blaze and possible grown over axe marks on north side of tree facing corner location; 17" white pine bearing S20°E, 4.85 feet has very ancient blaze facing corner location; these two trees are the only living trees over 6" to 8" in size in this area, and were possibly not cut because of the blazes on them marking the corner location; 5" balsam about 3' northwesterly has blaze facing corner location; blue painted line (+10 years old?) goes south.

Description of monument and accessories I established to perpetuate the original location of this corner.
Set Forest County aluminum monument (2" aluminum pipe with cast aluminum cap)
New bearing trees: P.K. nail with disc in 17" white pine S20°E 4.85'
P.K. nail with disc in 16" norway pine S50°W 7.0'
P.K. nail with disc in 5" white birch N22°E 13.85'

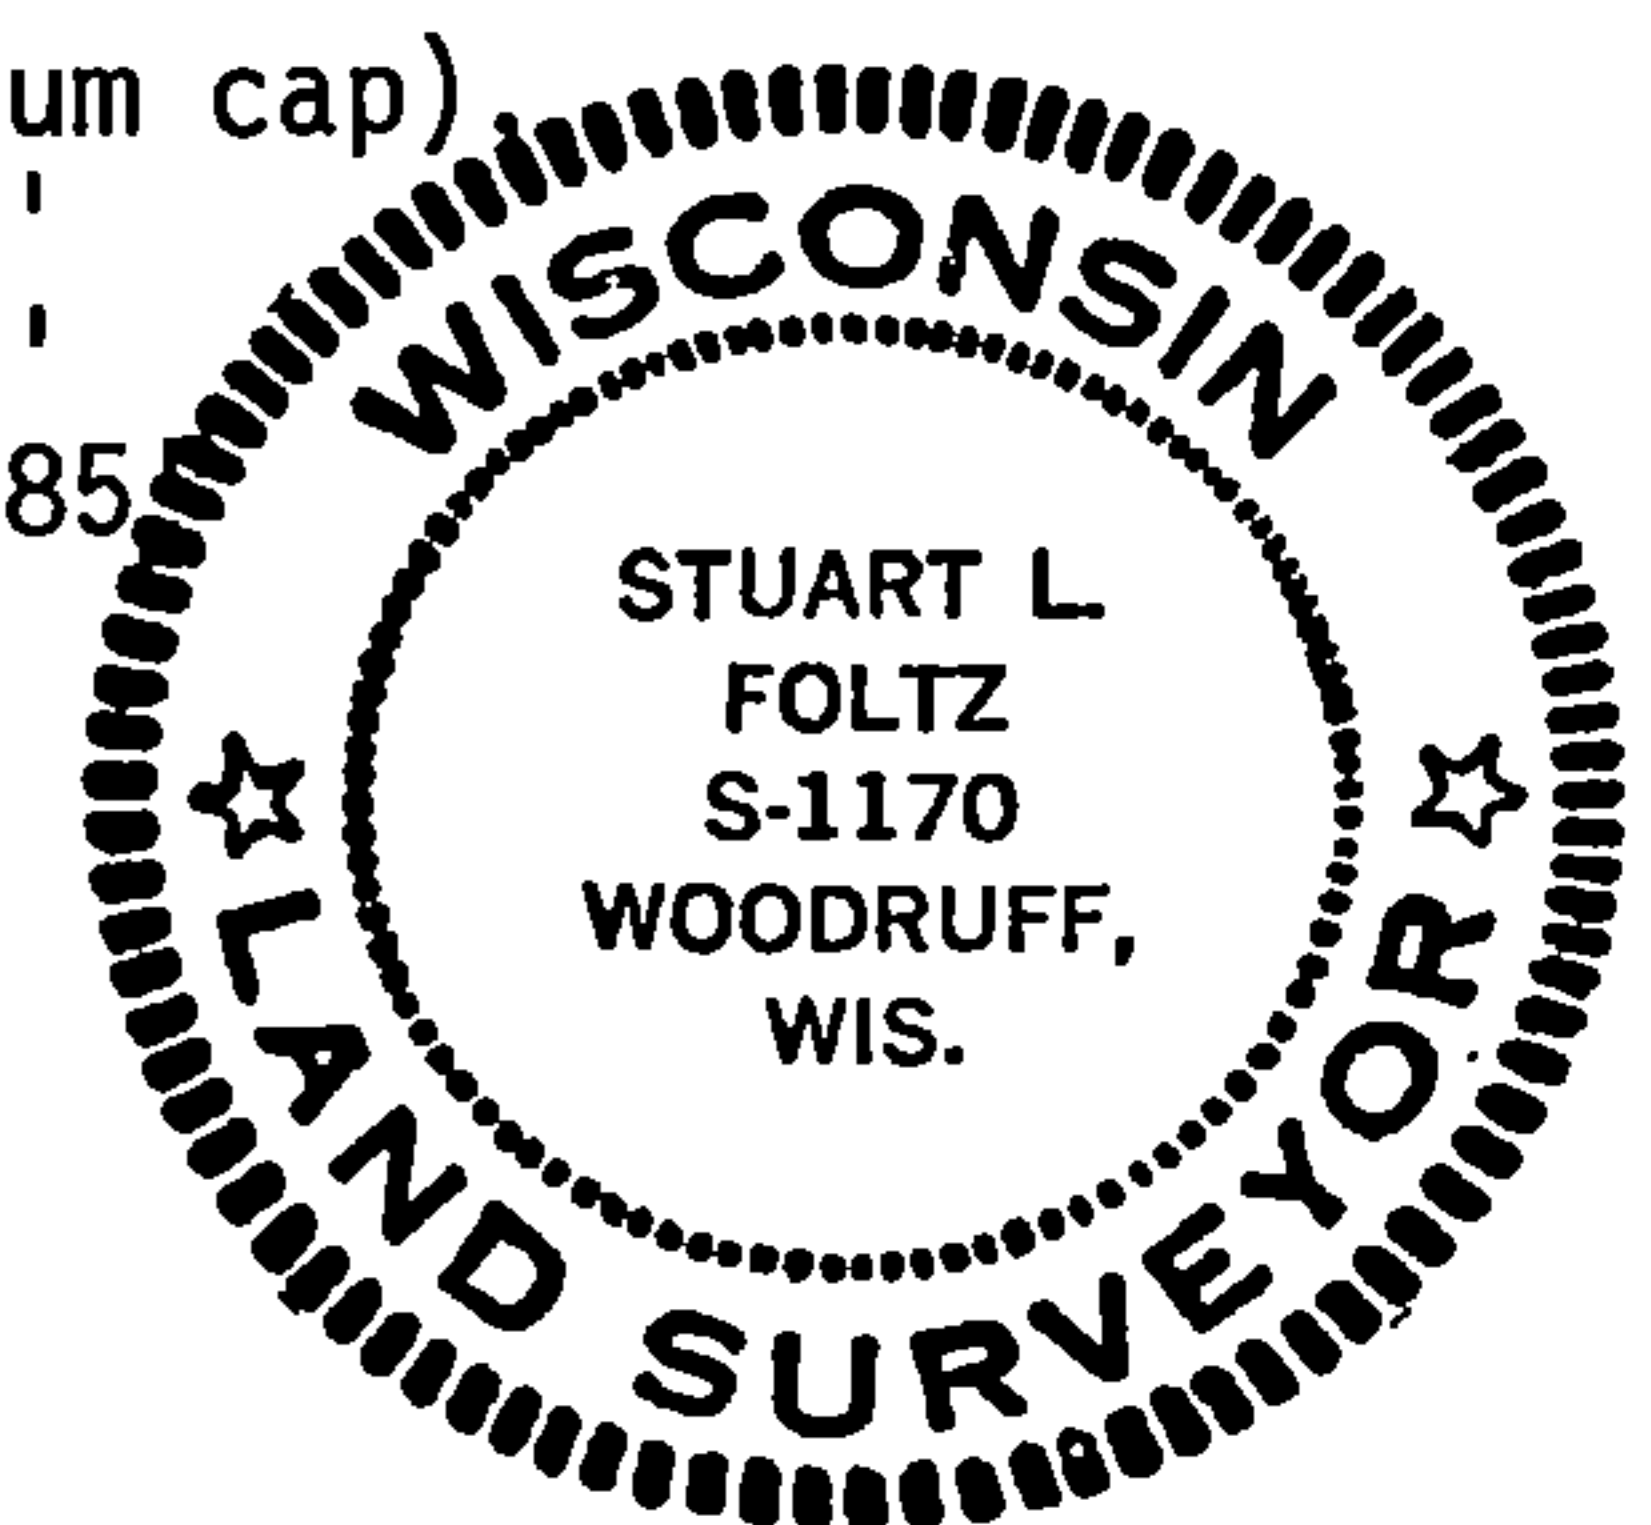

Dated at Minocqua, Wis., this 23rd day of February, 1977

Signature: *Stuart L. Foltz* Title Registered Land Surveyor Registration No. S-1170
(County Surveyor, Registered Land Surveyor, or other duly authorized official)

Office of Register of Deeds, County of Forest, I hereby certify that the within instrument was filed in this office for record on the 21st day of April, 1977 at 9:30 o'clock A.M.

Eugene Stegny
(Register of Deeds)
By _____ Deputy

DOCUMENT NUMBER
111267

43512240020