

CERTIFIED LAND CORNER RESTORATION

Index No.


P25

State of Wisconsin }
County of Forest } ss.

I Charles E. Winkler, do hereby certify that on the 3rd day of December, 19 80, I found evidence of the East 1/4 corner of Section 24 Township 35, North, Range 12 East, Fourth Principal Meridian, as described hereon; and that from this evidence I established a new monument and accessories as described hereon to perpetuate the original location of this corner.

Resident witnesses:
.....
.....
.....

FORM 985 H. C. MILLER CO., MILWAUKEE

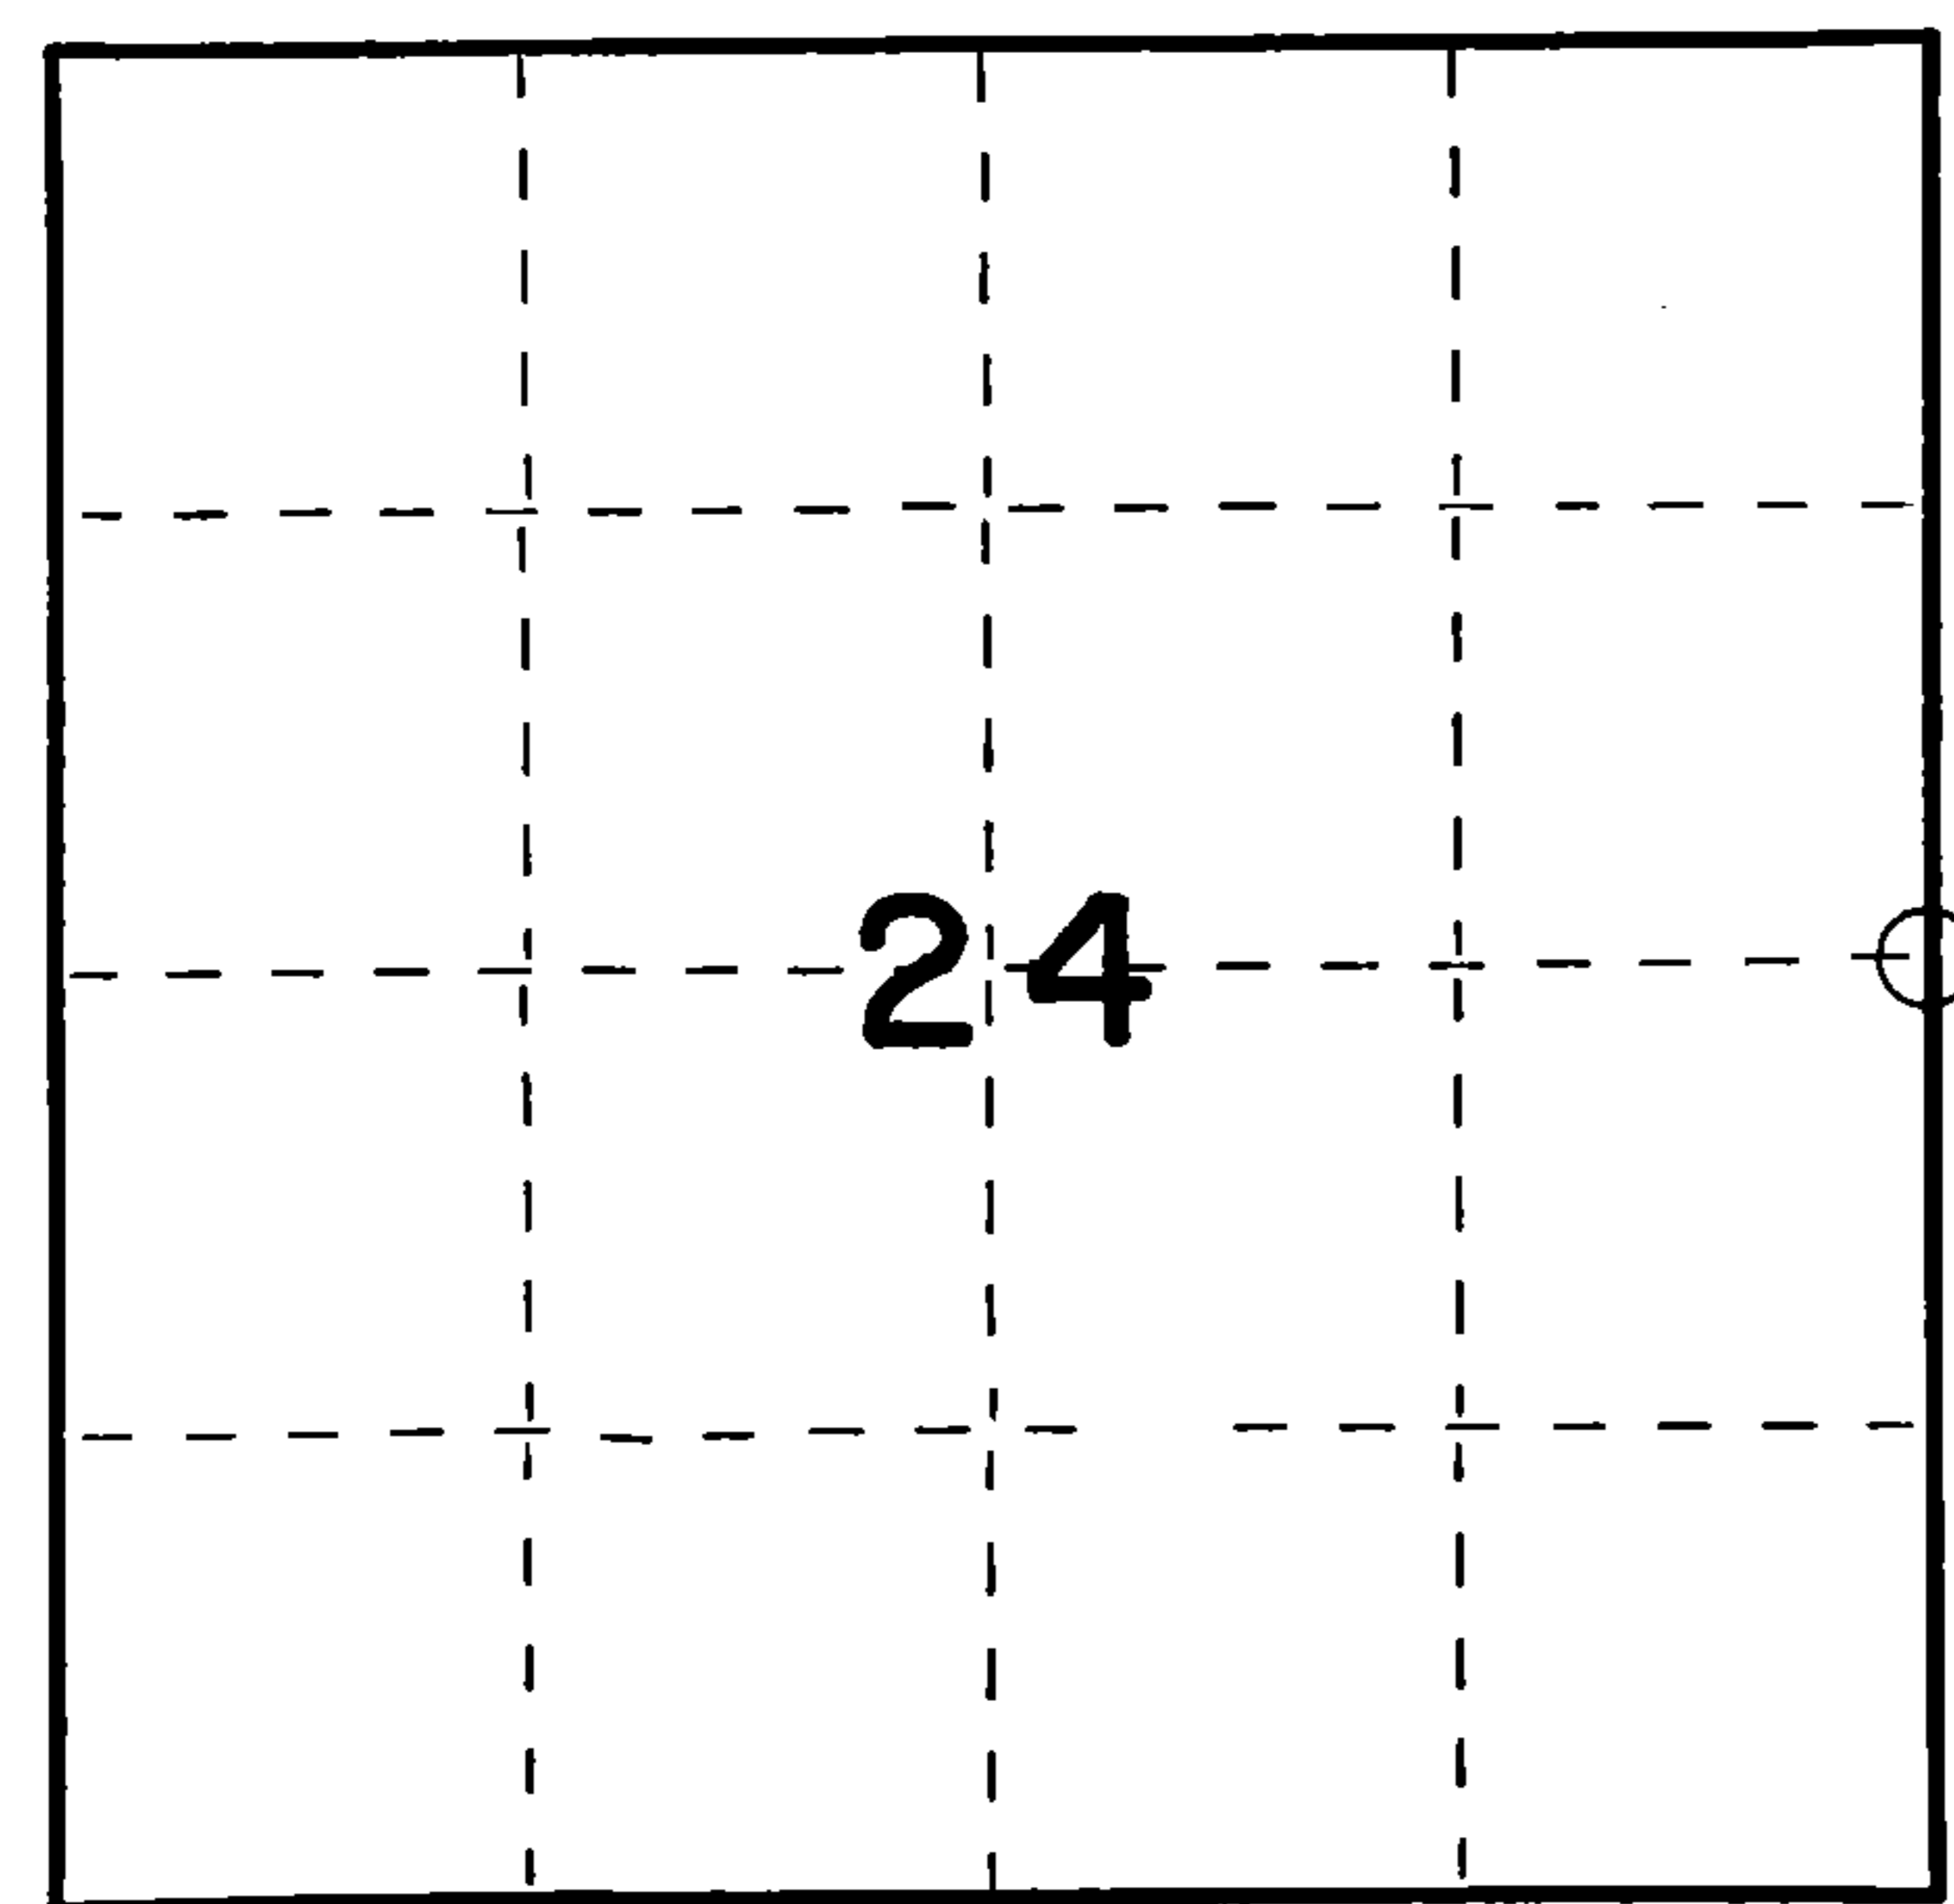

○ = Corner monument restored.

History of original corner establishment:

Wood post set by original surveyor, with the following bearing trees:

- White Pine 10", N20°E, 18 links.
- White Pine 12", S26°W, 12 links.


Description of corner evidence found:

1-1/2" well point (painted orange) plumbed over base of broken wood post; upper portion of broken post lying next to well point scribed "1/4" on one side and "24" on the opposite side. No bearing trees found.

Description of monument and accessories I established to perpetuate the original location of this corner.

Replaced well point and broken post with new Forest County aluminum monument. New bearing trees:

- 11" Spruce, S73°W, 16.5 feet.
- 6" Spruce, S36°E, 3.0 feet.
- 8" Spruce, N55°E, 12.1 feet.

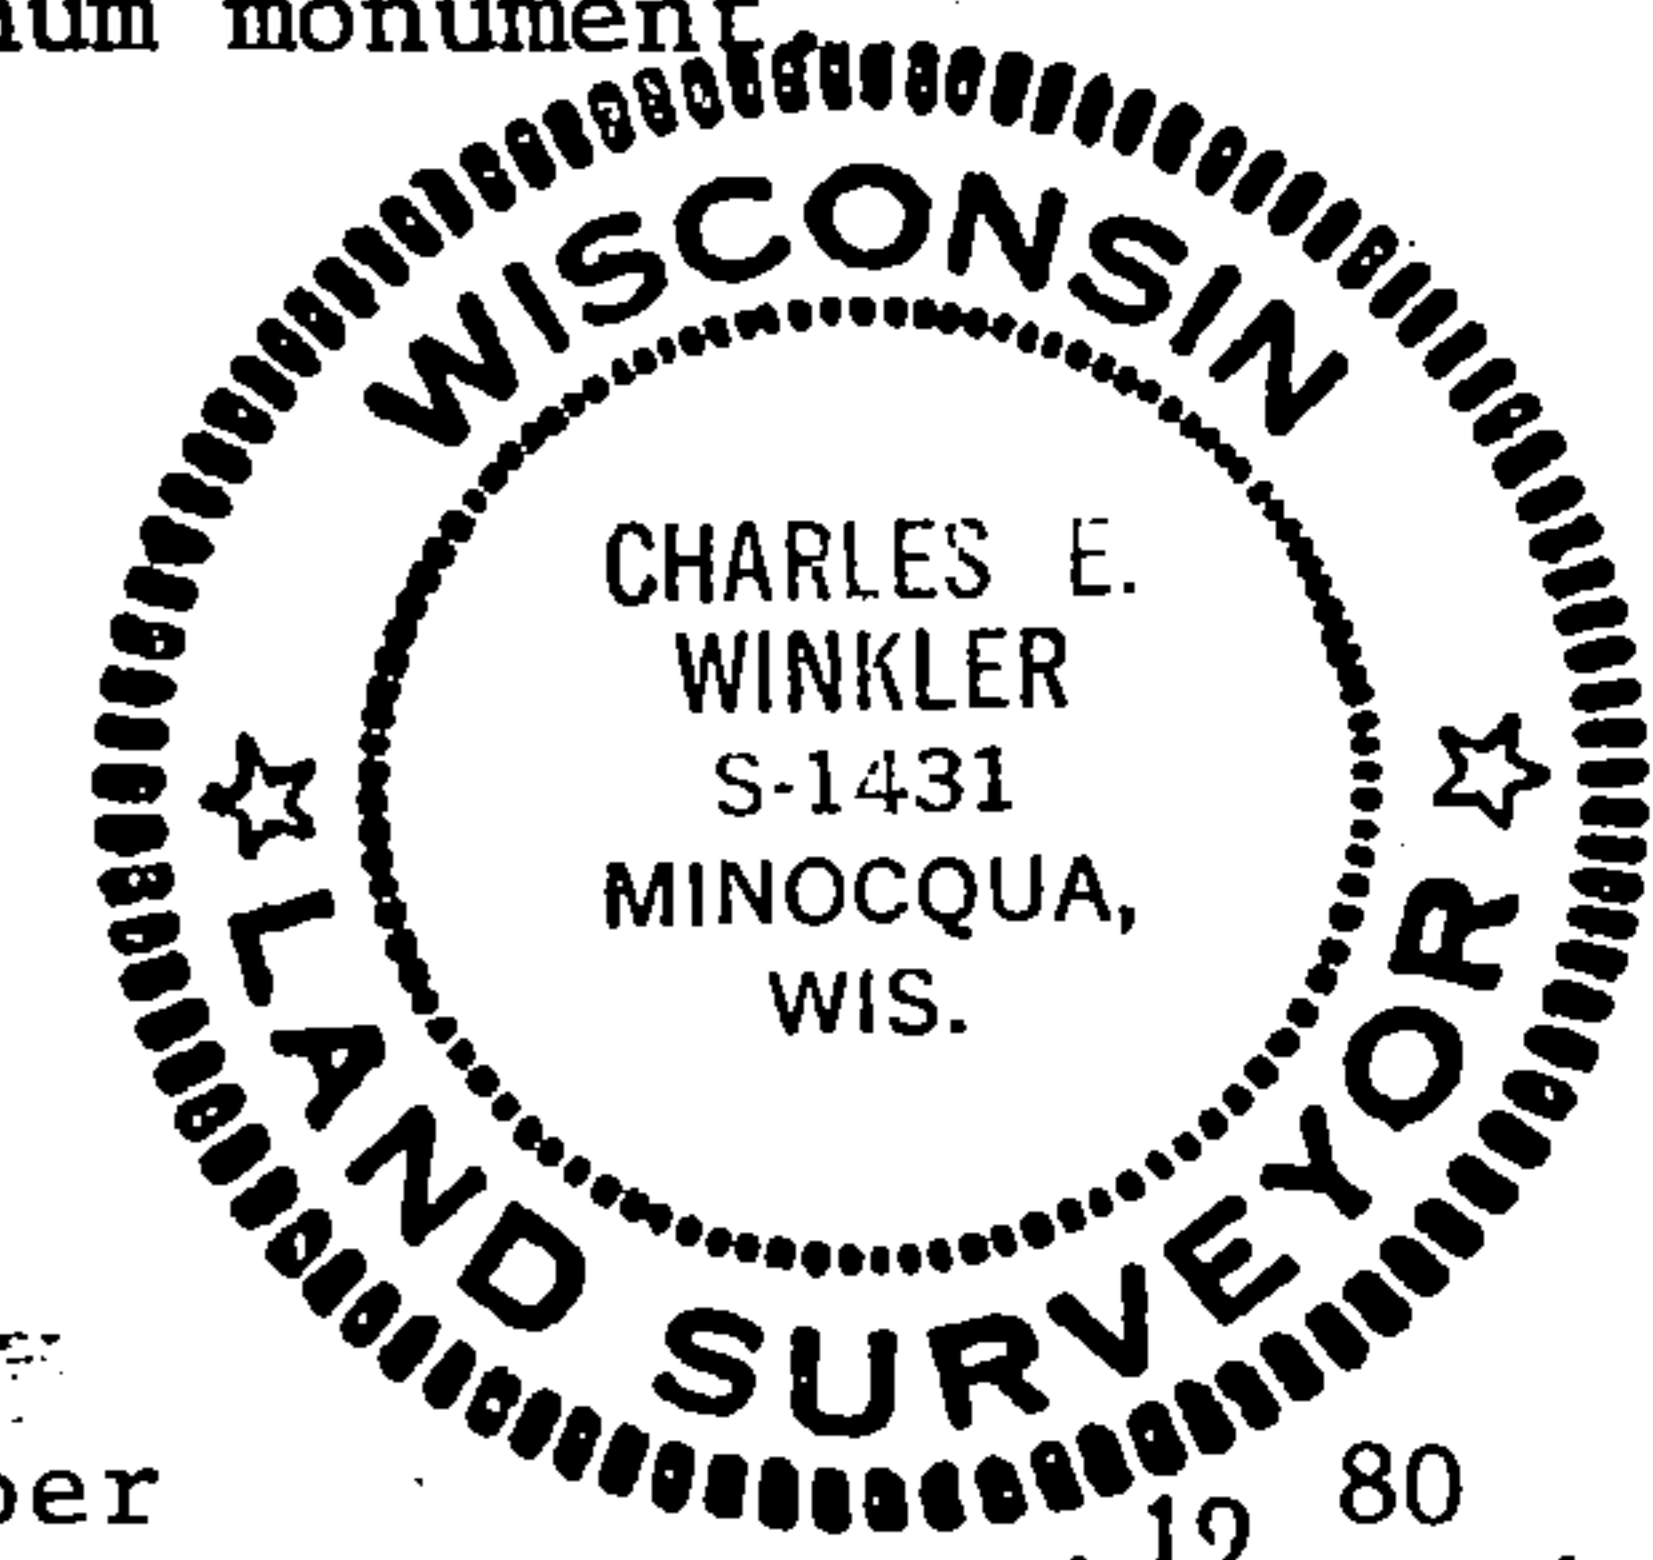

Dated at Minocqua, Wis., this 15th day of December, 19 80.

Signature Charles E. Winkler Title Registered Land Surveyor Registration No. S-1431
(County Surveyor, Registered Land Surveyor, or other duly authorized official)

Office of Register of Deeds, County of Forest, I hereby certify that the within instrument was filed in this office for record on the 17th day of December, 19 80. at 10:30 o'clock A. M.

Eugene Statelyny (Register of Deeds)
By Deputy

DOCUMENT NO. 119126

43512-242000