

CERTIFIED LAND CORNER RESTORATION

Index No.


123

State of Wisconsin }
County of Forest } ss.

I Stuart L. Foltz, do hereby certify that on the 31st day of January, 1977, I found evidence of the one quarter corner of Sections 25 and 36 Township 35 North, Range 12 East, Fourth Principal Meridian, as described hereon; and that from this evidence I established a new monument and accessories as described hereon to perpetuate the original location of this corner.

Resident witnesses:

.....
.....
.....

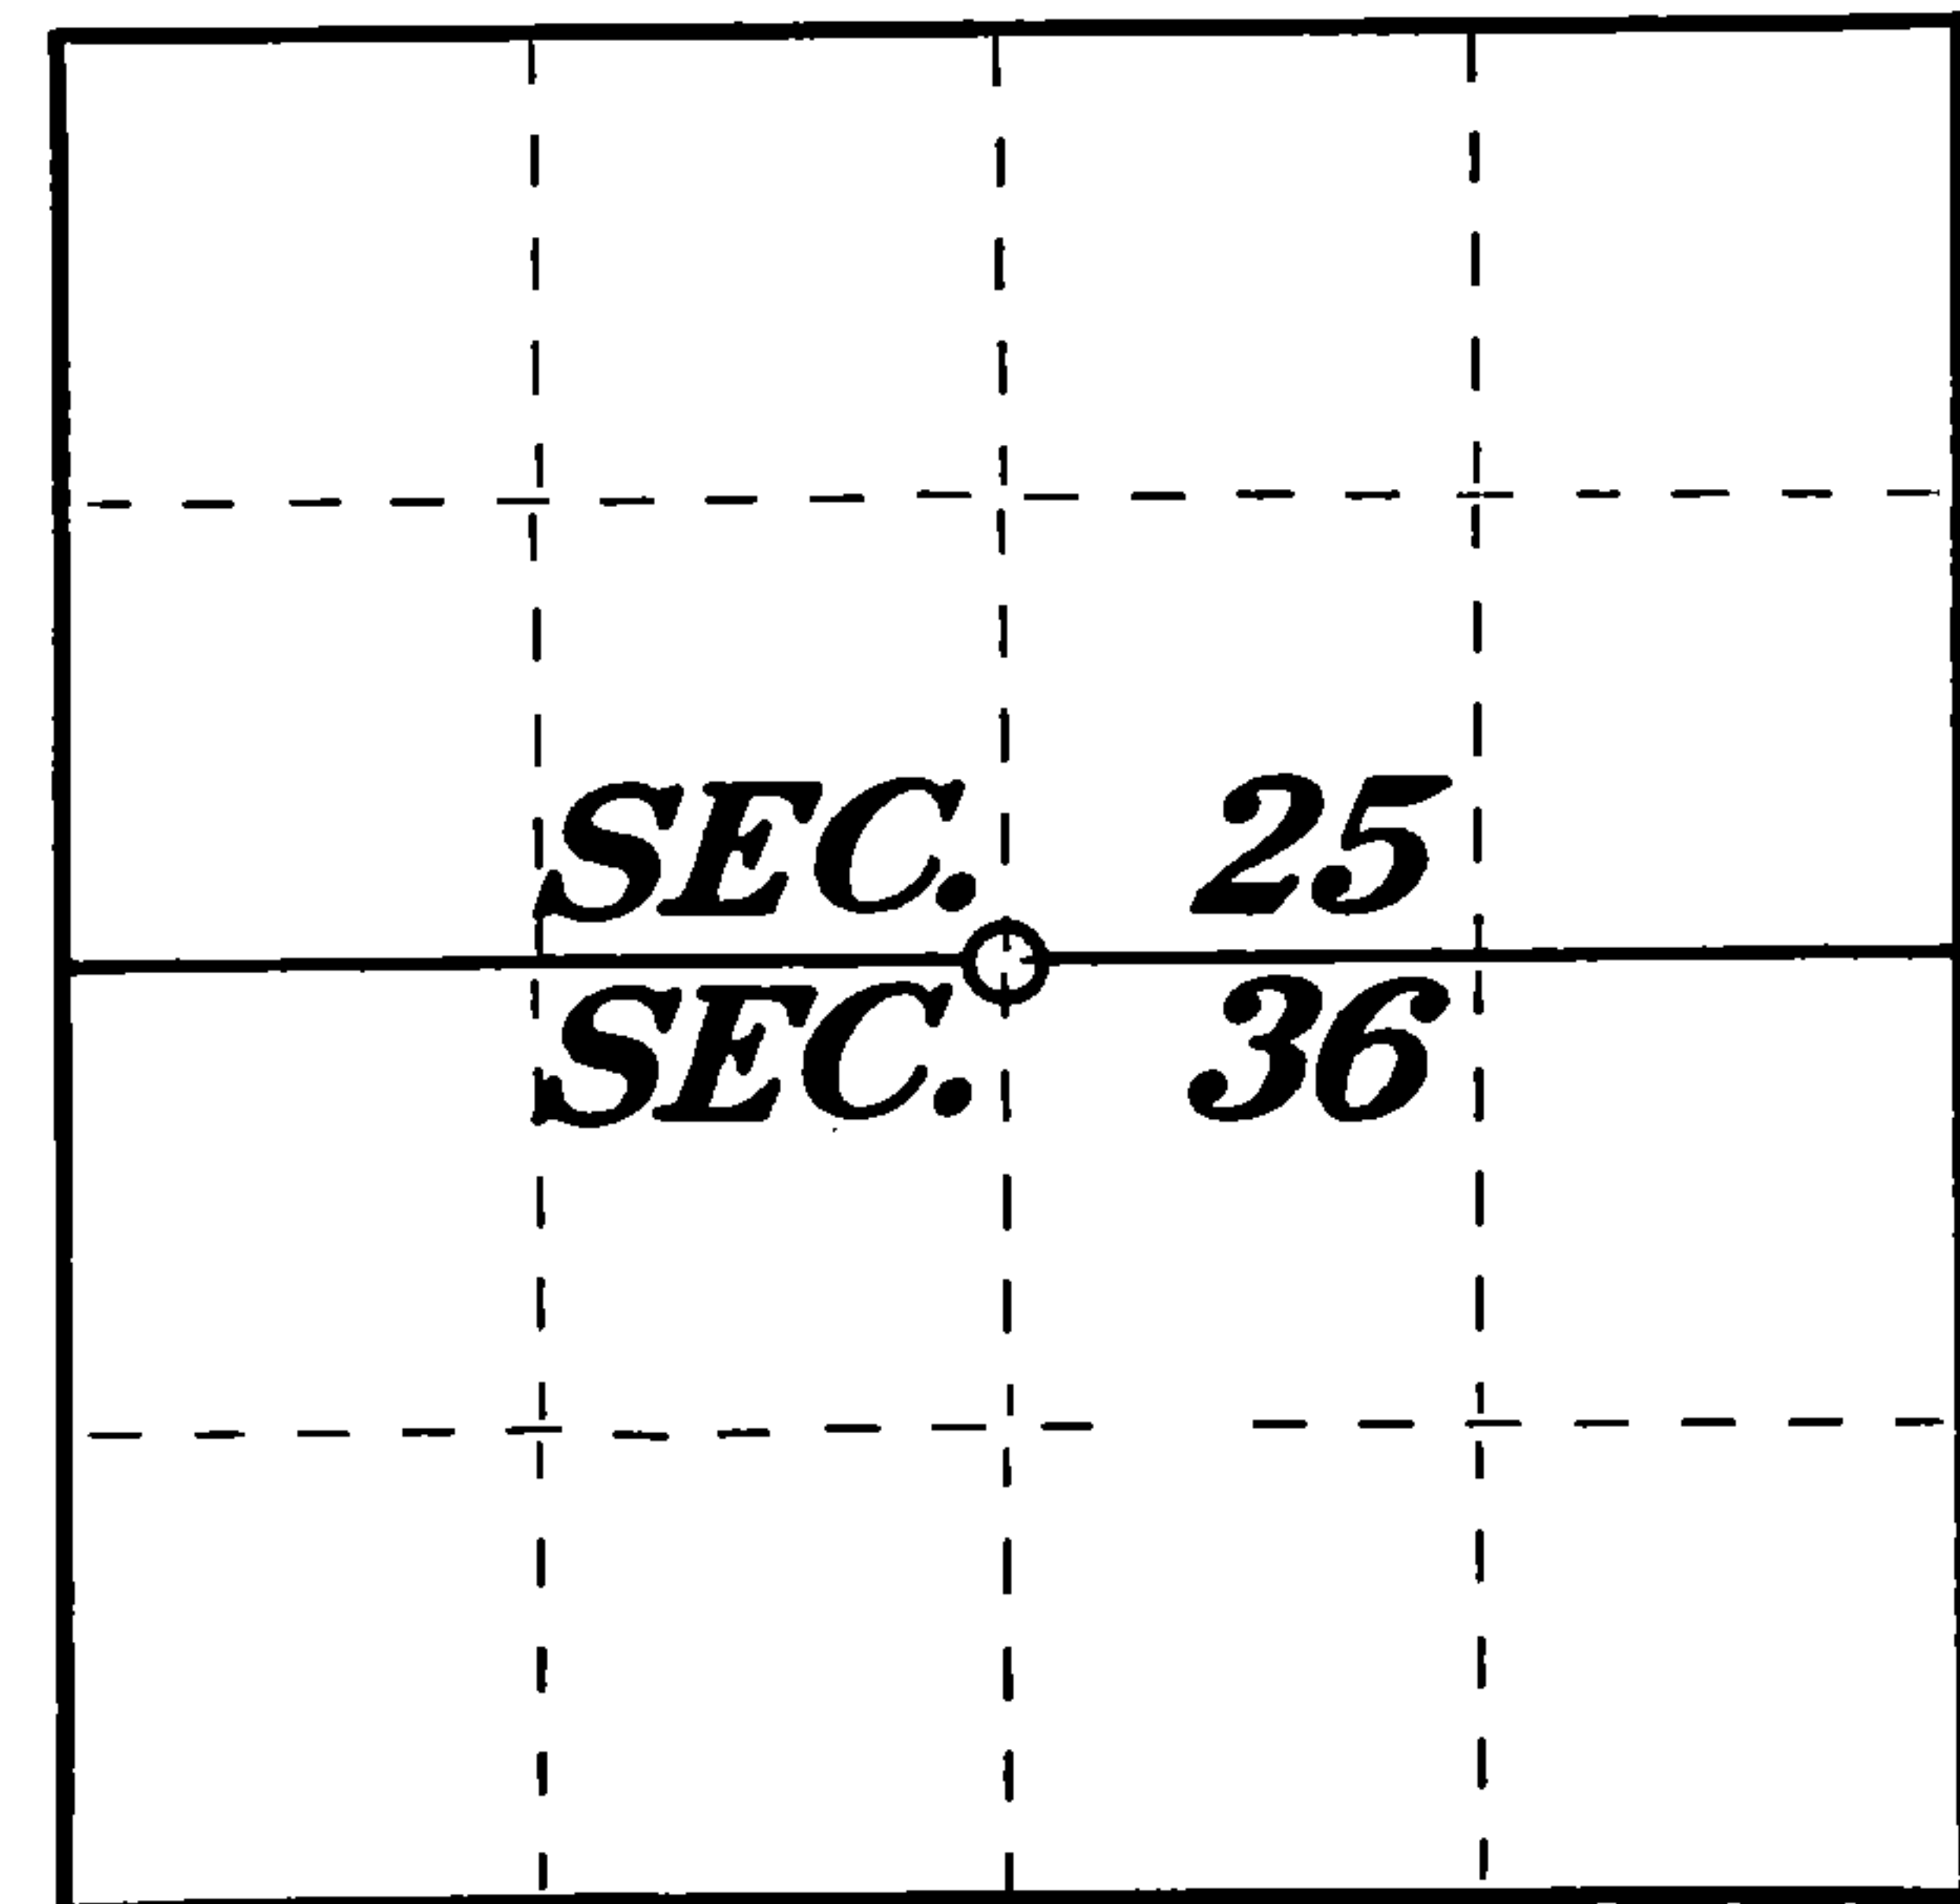

○ = Corner monument restored.

History of original corner establishment:

Date of original survey: June 26th, 1865 to July 7th, 1865
Original surveyor: James L. Nowlin
Original monument: Wood post
Original bearing trees: 6" sugar S18°W 18 lks. (11.88')
12" birch N47°E 20 lks. (13.20')


Description of corner evidence found:

A diligent search revealed no evidence of the corner except an old down fence line (+ 40 years old?) running north and south in the approximate corner location. Proportioning the corner between the SE and SW section corners resulted in a one quarter corner location which fell in this old fence line. This corner was therefore set at a position established by single proportionate measure.

Description of monument and accessories I established to perpetuate the original location of this corner.

Set Forest County aluminum monument (2" aluminum pipe with east aluminum cap) at proportioned location in old fence line.

New bearing trees: P.K. nail with disc in 8" oak N52°E 18.40'
P.K. nail with disc in 8" oak S88°W 15.83'
P.K. nail with disc in 8" oak S24°W 23.11'

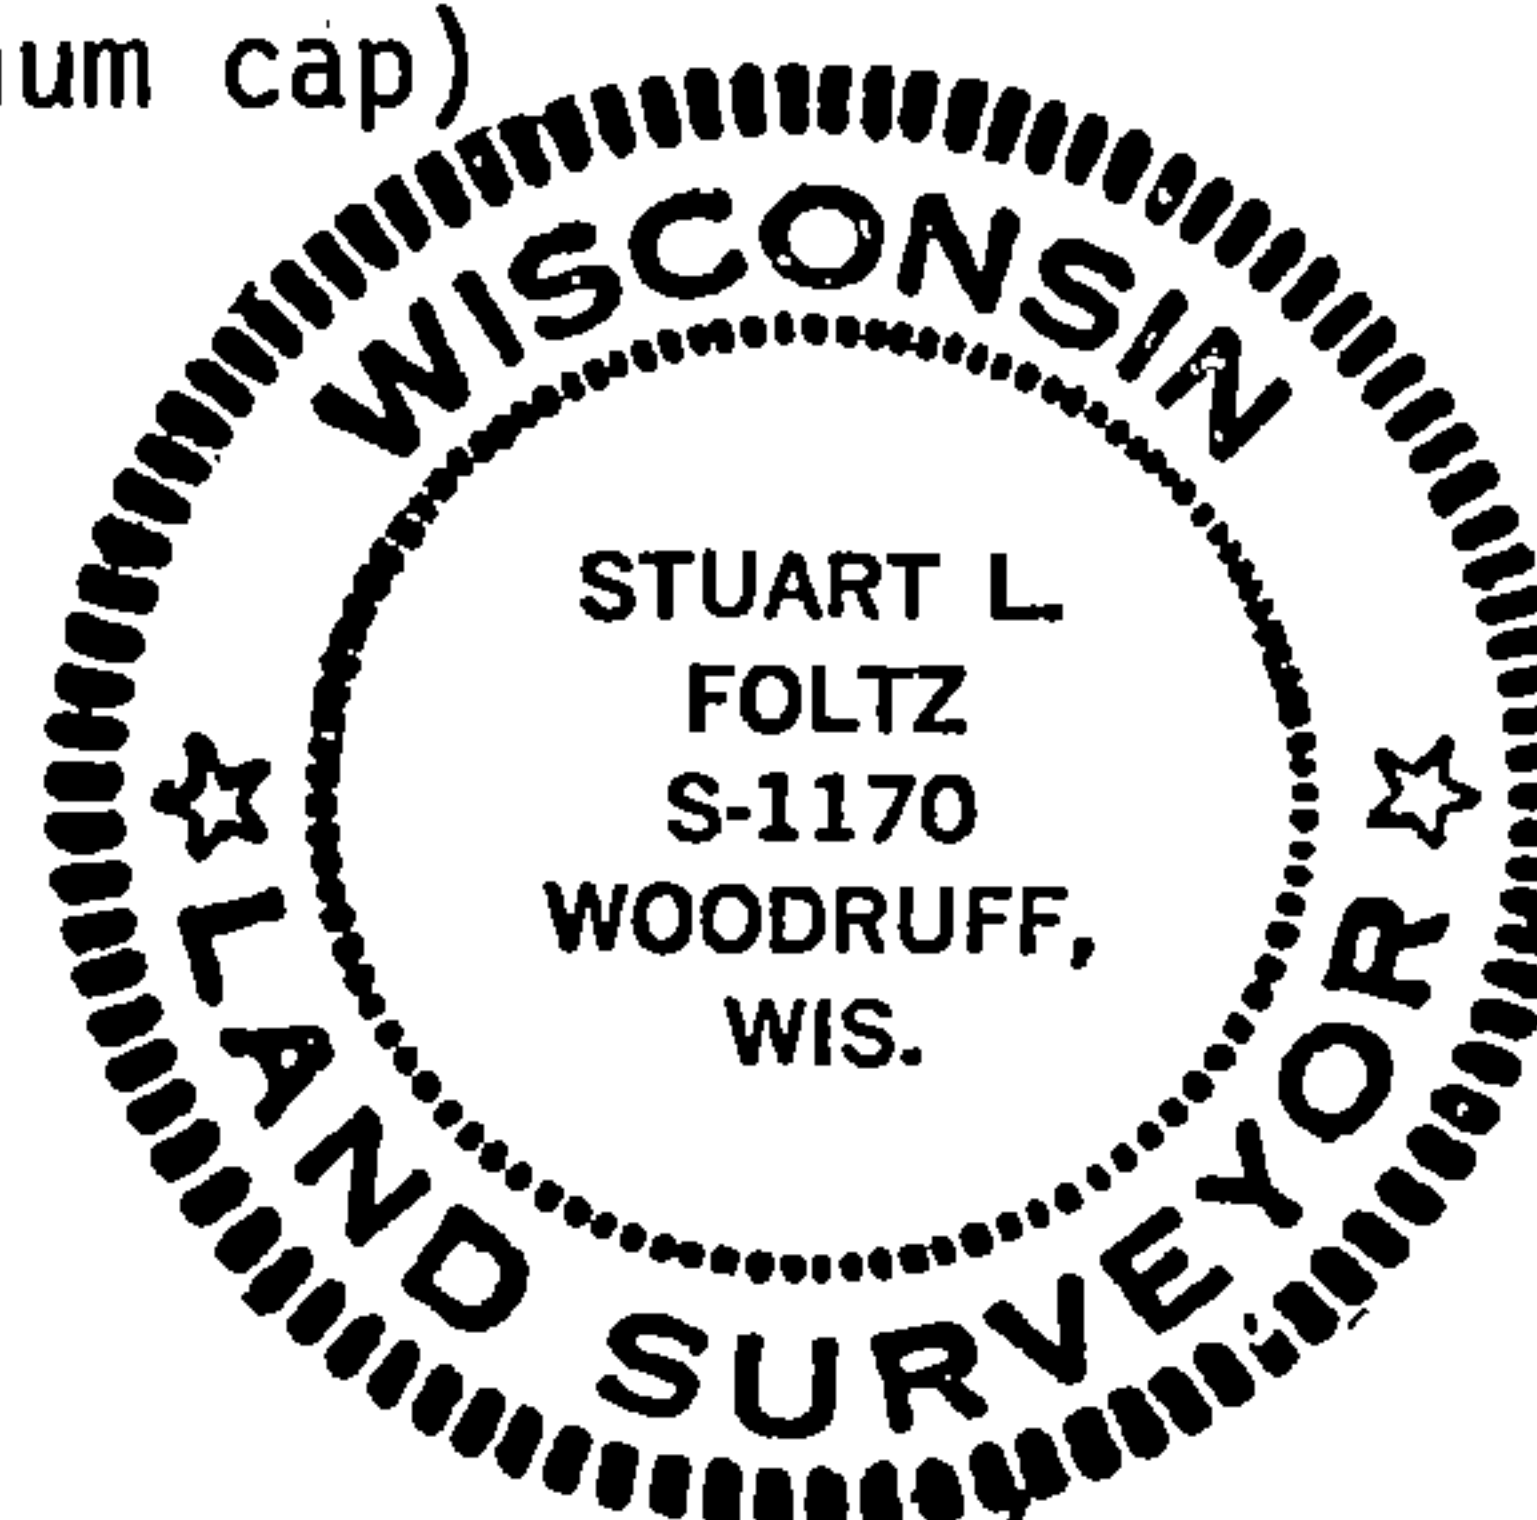

Dated at Minocqua, Wis., this 23rd day of February, 1977

Signature: *Stuart L. Foltz* Title: Registered Land Surveyor Registration No. S-1170
(County Surveyor, Registered Land Surveyor, or other duly authorized official)

Office of Register of Deeds, County of Forest, I hereby certify that the within instrument was filed in this office for record on the 21st day of April, 1977 at 9:30 o'clock A.M.

Eugen Stetson
(Register of Deeds)
By _____ Deputy

DOCUMENT NUMBER

111268

FORM 985 R. C. MILLER CO., MILWAUKEE

43512250020