

CERTIFIED LAND CORNER RESTORATION


Index No. **V21**

State of Wisconsin }
County of Forest } ss.

I Thomas R. Arnott, do hereby
certify that on the 22 nd day
of September, 19 75, I found
evidence of the section
corner of sections 25, 26, 35 & 36
Township 35, North, Range
12 E, Fourth Principal Meridian,
as described hereon; and that from this evidence
I established a new monument and accessories
as described hereon to perpetuate the original
location of this corner.

Resident witnesses:

Herbert Wagoner

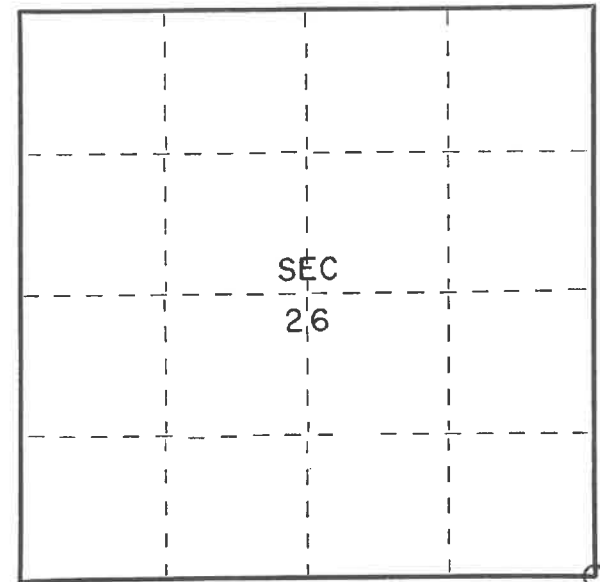

○ = Corner monument restored.

History of original corner establishment:

Original subdivision by James L. Nowlin June 26 - July 7, 1865

W. Pine	15	S75E	300 Lks.
Aspen	8	N60W	150 Lks.

Description of corner evidence found:


2" iron pipe found
wood post found

Description of monument and accessories I established to perpetuate the original location of this corner.

Reset iron pipe with new Forest County aluminum monument

Ties:

J. Pine	8"	N48E	2.50 feet
J. Pine	6"	S11W	11.65 feet
J. Pine	8"	S84W	16.83 feet

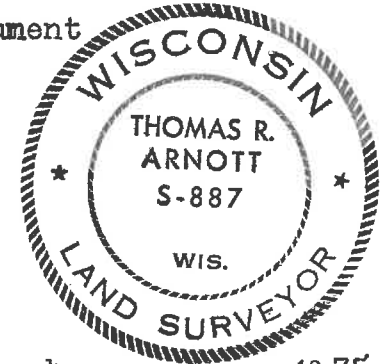

Dated at Crandon, Wis., this 10th day of November, 19 75

Signature Thomas R. Arnott Title Land Surveyor Registration No. S-887
(County Surveyor, Registered Land Surveyor, or other duly authorized official)

Office of Register of Deeds, County of Forest, I hereby certify that the within
instrument was filed in this office for record on the 10th day of November, 19 75
at 3 o'clock P. M.

EUGENE STATEZNY
(Register of Deeds)

Document Number 108186

By Eileen Schmidt Deputy