

CERTIFIED LAND CORNER RESTORATION


Index No. **225**

State of Wisconsin }
County of Forest } ss.

I, Stuart L. Foltz, do hereby certify that on the 18th day of January, 1977, I found evidence of the Meander corner of South line, Section 36 Township 35, North, Range 12 East, Fourth Principal Meridian, as described hereon; and that from this evidence I established a new monument and accessories as described hereon to perpetuate the original location of this corner.

Resident witnesses:

FORM 985 H. C. MILLER CO., MILWAUKEE

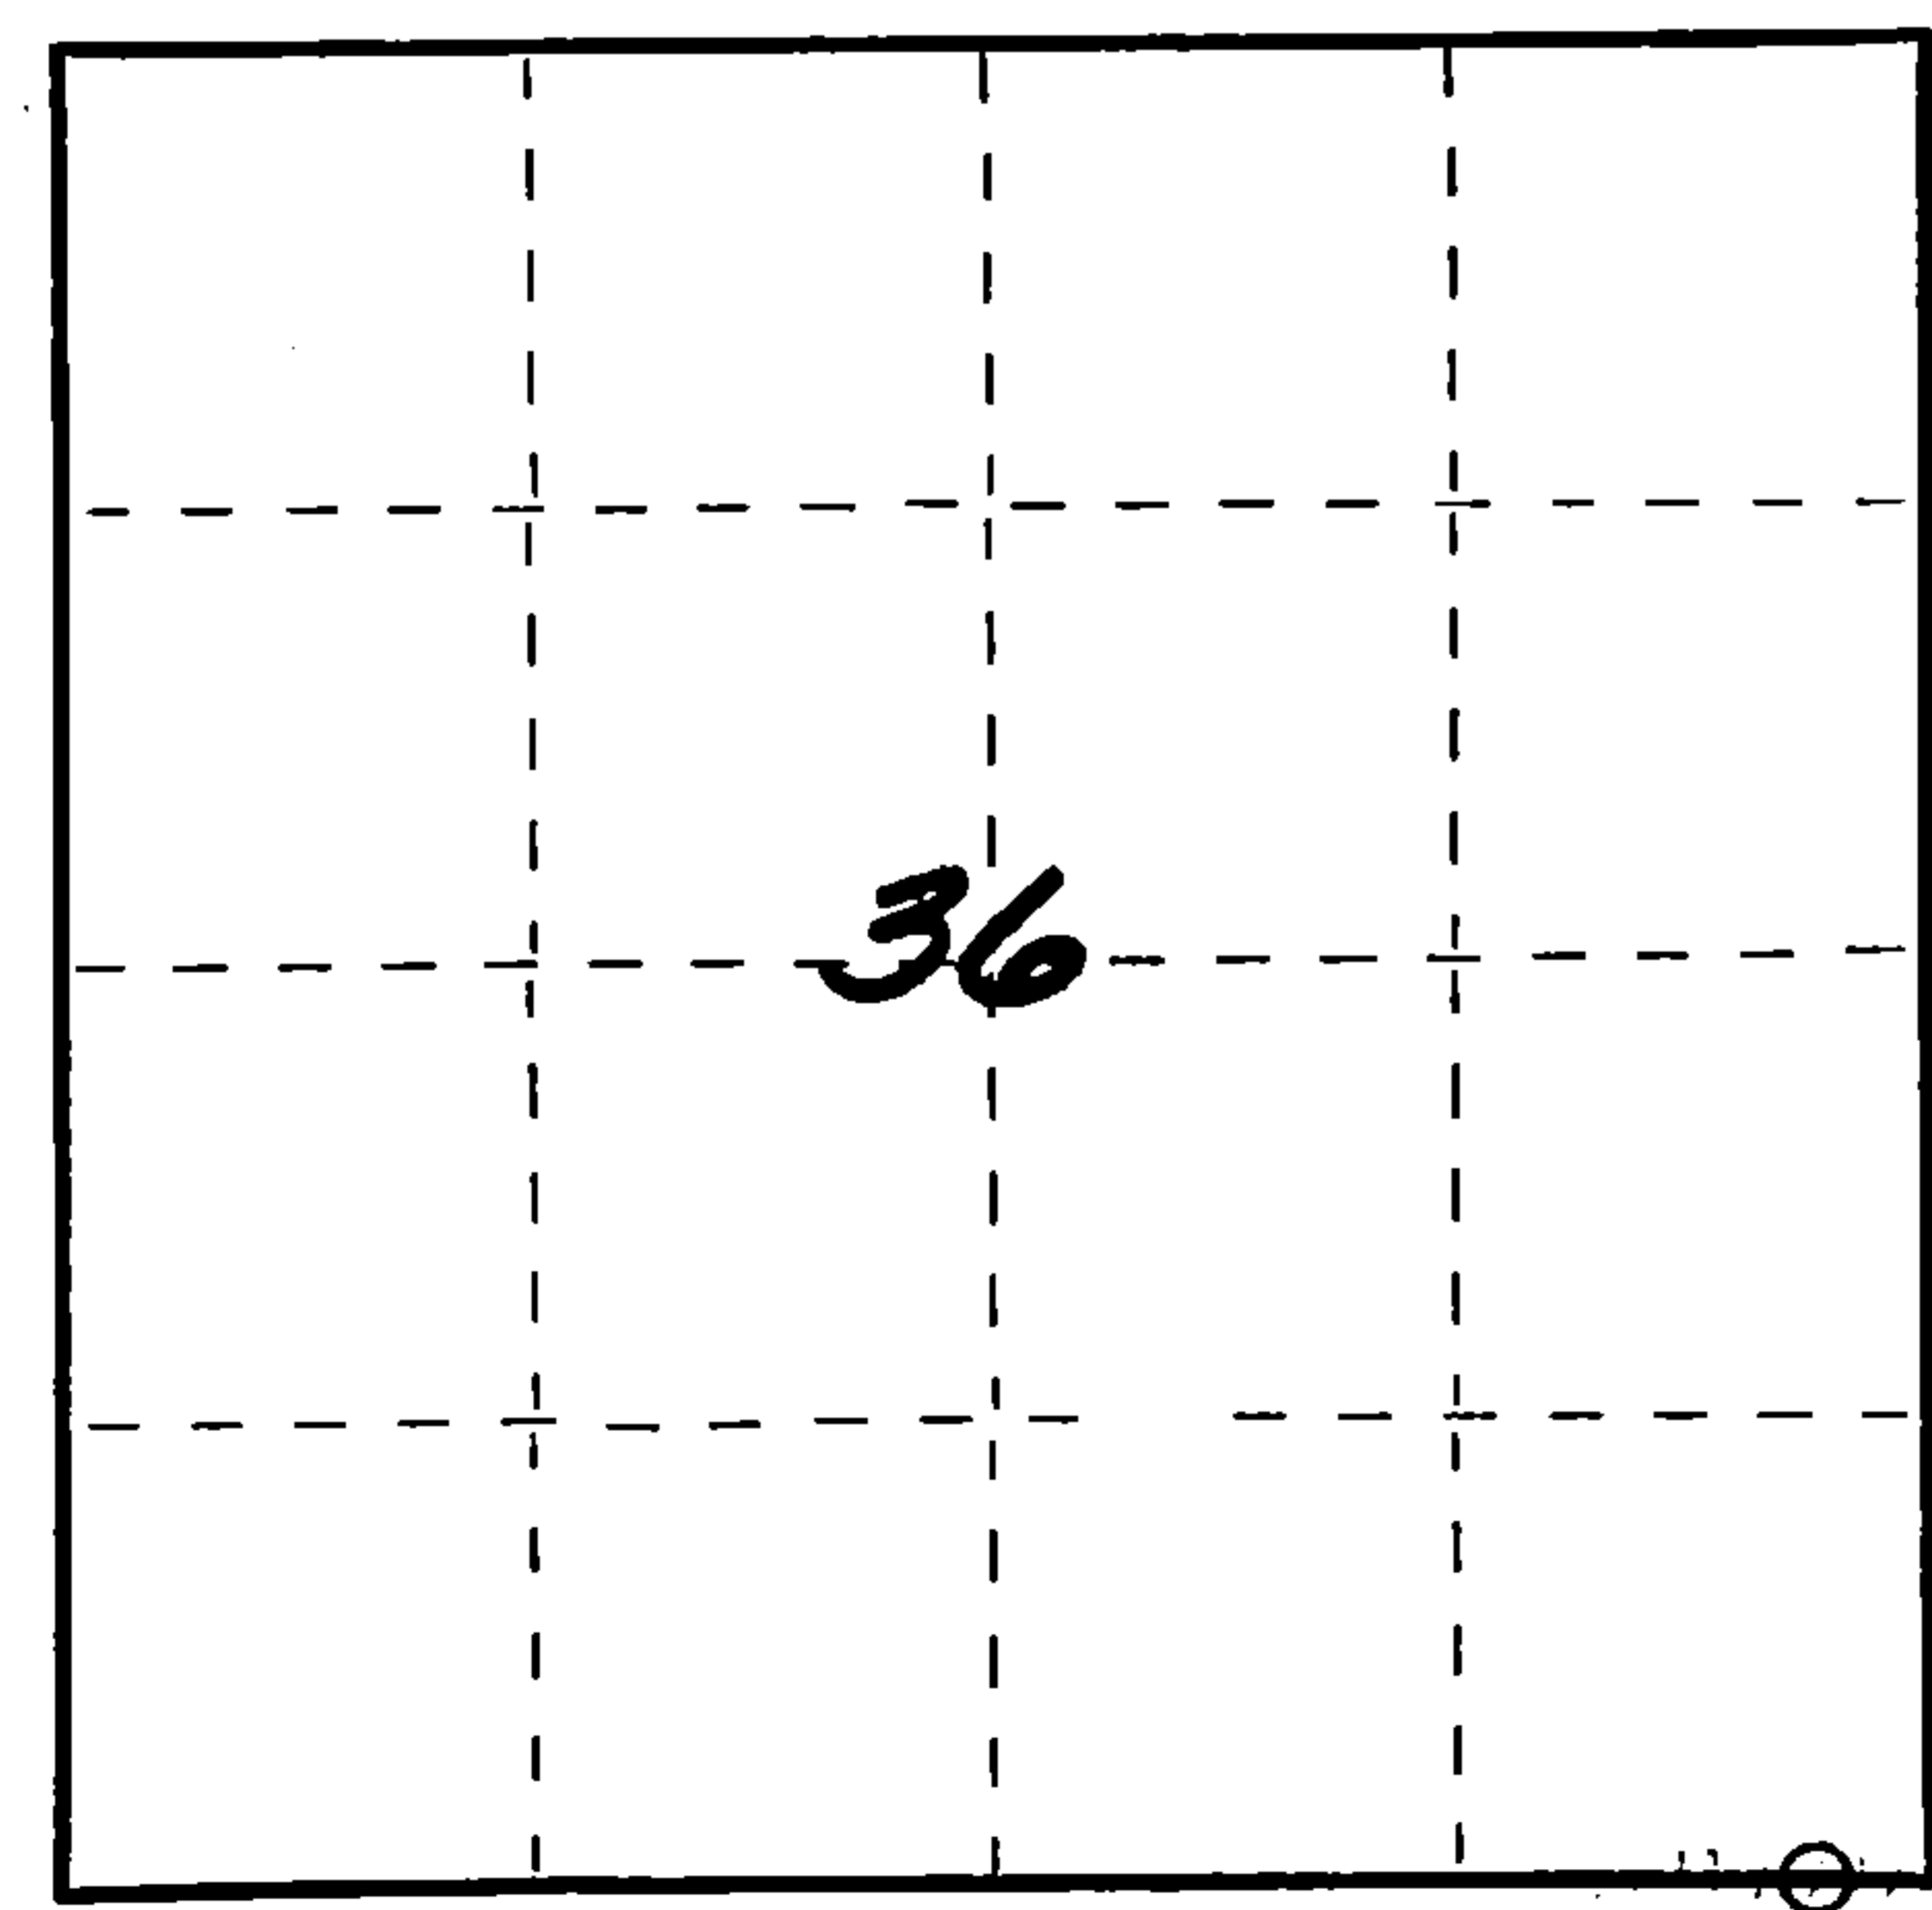

○ = Corner monument restored.

History of original corner establishment:

Date of original survey: September, 1857
Original monument: Wood post
Original bearing trees: 18" White Pine S66°W 40 lks. (26.40')
12" Maple N68°W 57 lks. (37.62')

Description of corner evidence found:


2" Iron pipe found in place
Scribed 12" Maple N6°W 20.3'
Distance west to S1/4 Section 36 measured electronically is 2296.35', which compares very well with original measurement of 34.75 chains (2293.50').

Description of monument and accessories I established to perpetuate the original location of this corner:

Set Forest County aluminum monument
(2" aluminum pipe with cast aluminum cap)

New bearing trees:

P.K. Nail with disc in 7" Maple, S44°E, 12.07'
P.K. Nail with disc in 6" Maple, N65°E, 19.14'

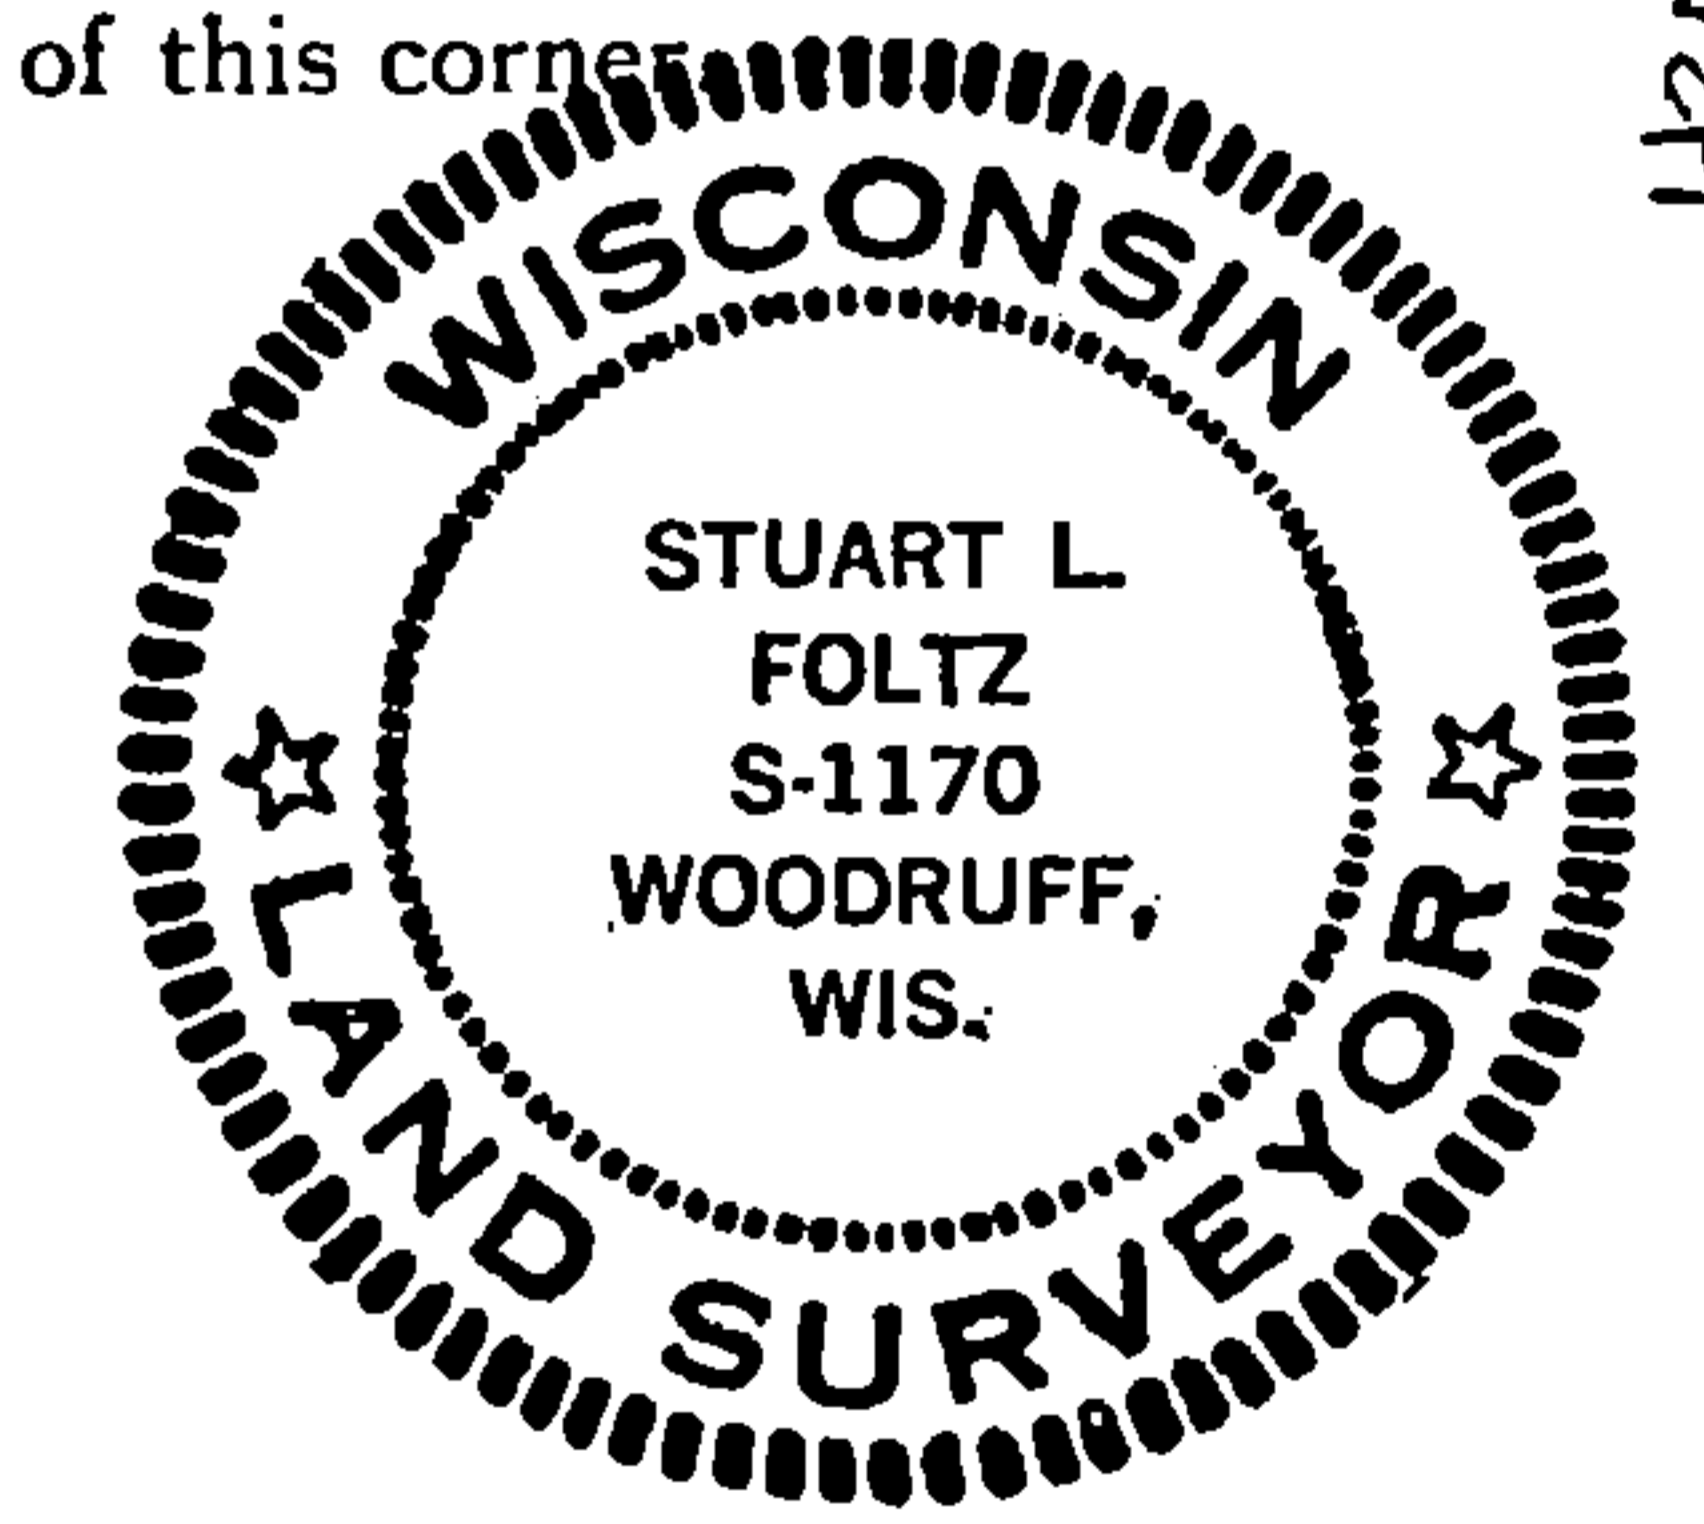

Dated at Minocqua, Wis., this 30th day of June, 19 77.

Signature Stuart L. Foltz Title Registered Land Surveyor Registration No. S-1170
(County Surveyor, Registered Land Surveyor, or other duly authorized official)

Office of Register of Deeds, County of Forest, I hereby certify that the within instrument was filed in this office for record on the 6th day of July, 19 77 at 9:30 o'clock A. M.

Eugene Staszny
(Register of Deeds)

By _____ Deputy

DOCUMENT NUMBER
111806

42517-360003