

CERTIFIED LAND CORNER RESTORATION

State of Wisconsin }
County of Forest } ss.

History of original corner establishment:

Original subdivision by James Nowlin Sept. 11 - Sept. 21, 1865

Fir 7 N34E 12 Lks.
Sugar 40 S66W 10 Lks.

I Thomas R. Arnott, do hereby certify that on the 22nd day of January, 1976, I found evidence of the 1/4 corner of sections 1 & 2 Township 35, North, Range 13 E, Fourth Principal Meridian, as described hereon; and that from this evidence I established a new monument and accessories as described hereon to perpetuate the original location of this corner.

Description of corner evidence found:

2" iron pipe 5' long with brass cap set by G.E. Walker in 1940

Resident witnesses:


.....
.....
.....

Description of monument and accessories I established to perpetuate the original location of this corner.

Left monument set by Walker

Ties:

Maple 6 S67W 16.07 feet
Maple 10 S71E 40.60 feet

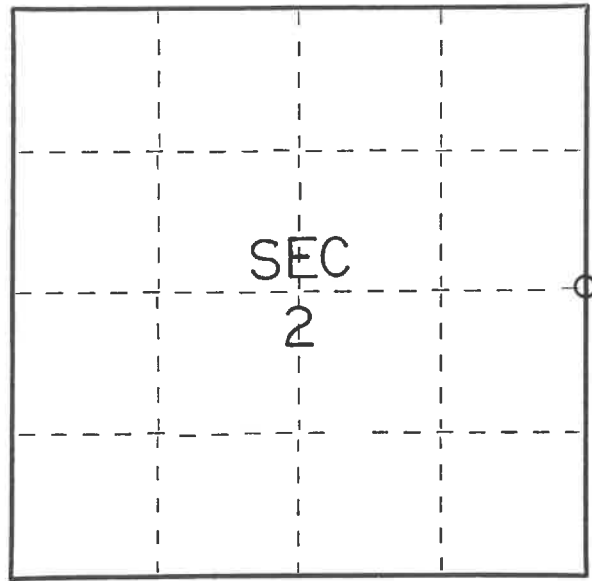

○ = Corner monument restored.

Dated at Crandon, Wis., this 26th day of January, 1976.

Signature Thomas R. Arnott Title Surveyor Registration No. S-887
(County Surveyor, Registered Land Surveyor, or other duly authorized official)

Office of Register of Deeds, County of Forest, I hereby certify that the within instrument was filed in this office for record on the 26th day of January, 1976 at 11 o'clock A. M.

Eugene Staszny Document Number 108648
(Register of Deeds)

By..... Deputy

FORM 985 K. C. MILLER CO., MILWAUKEE

43513022000