

CERTIFIED LAND CORNER RESTORATION

Index No. E-117


State of Wisconsin }
County of Forest } ss.

I Thomas R. Arnott, do hereby certify that on the 19th day of December, 1975, I found evidence of the section corner of sections 2, 3, 10 & 11 Township 35, North, Range 13 E, Fourth Principal Meridian, as described hereon; and that from this evidence I established a new monument and accessories as described hereon to perpetuate the original location of this corner.

Resident witnesses:

.....
.....
.....

FORM 985 W. C. MILLER CO., MILWAUKEE

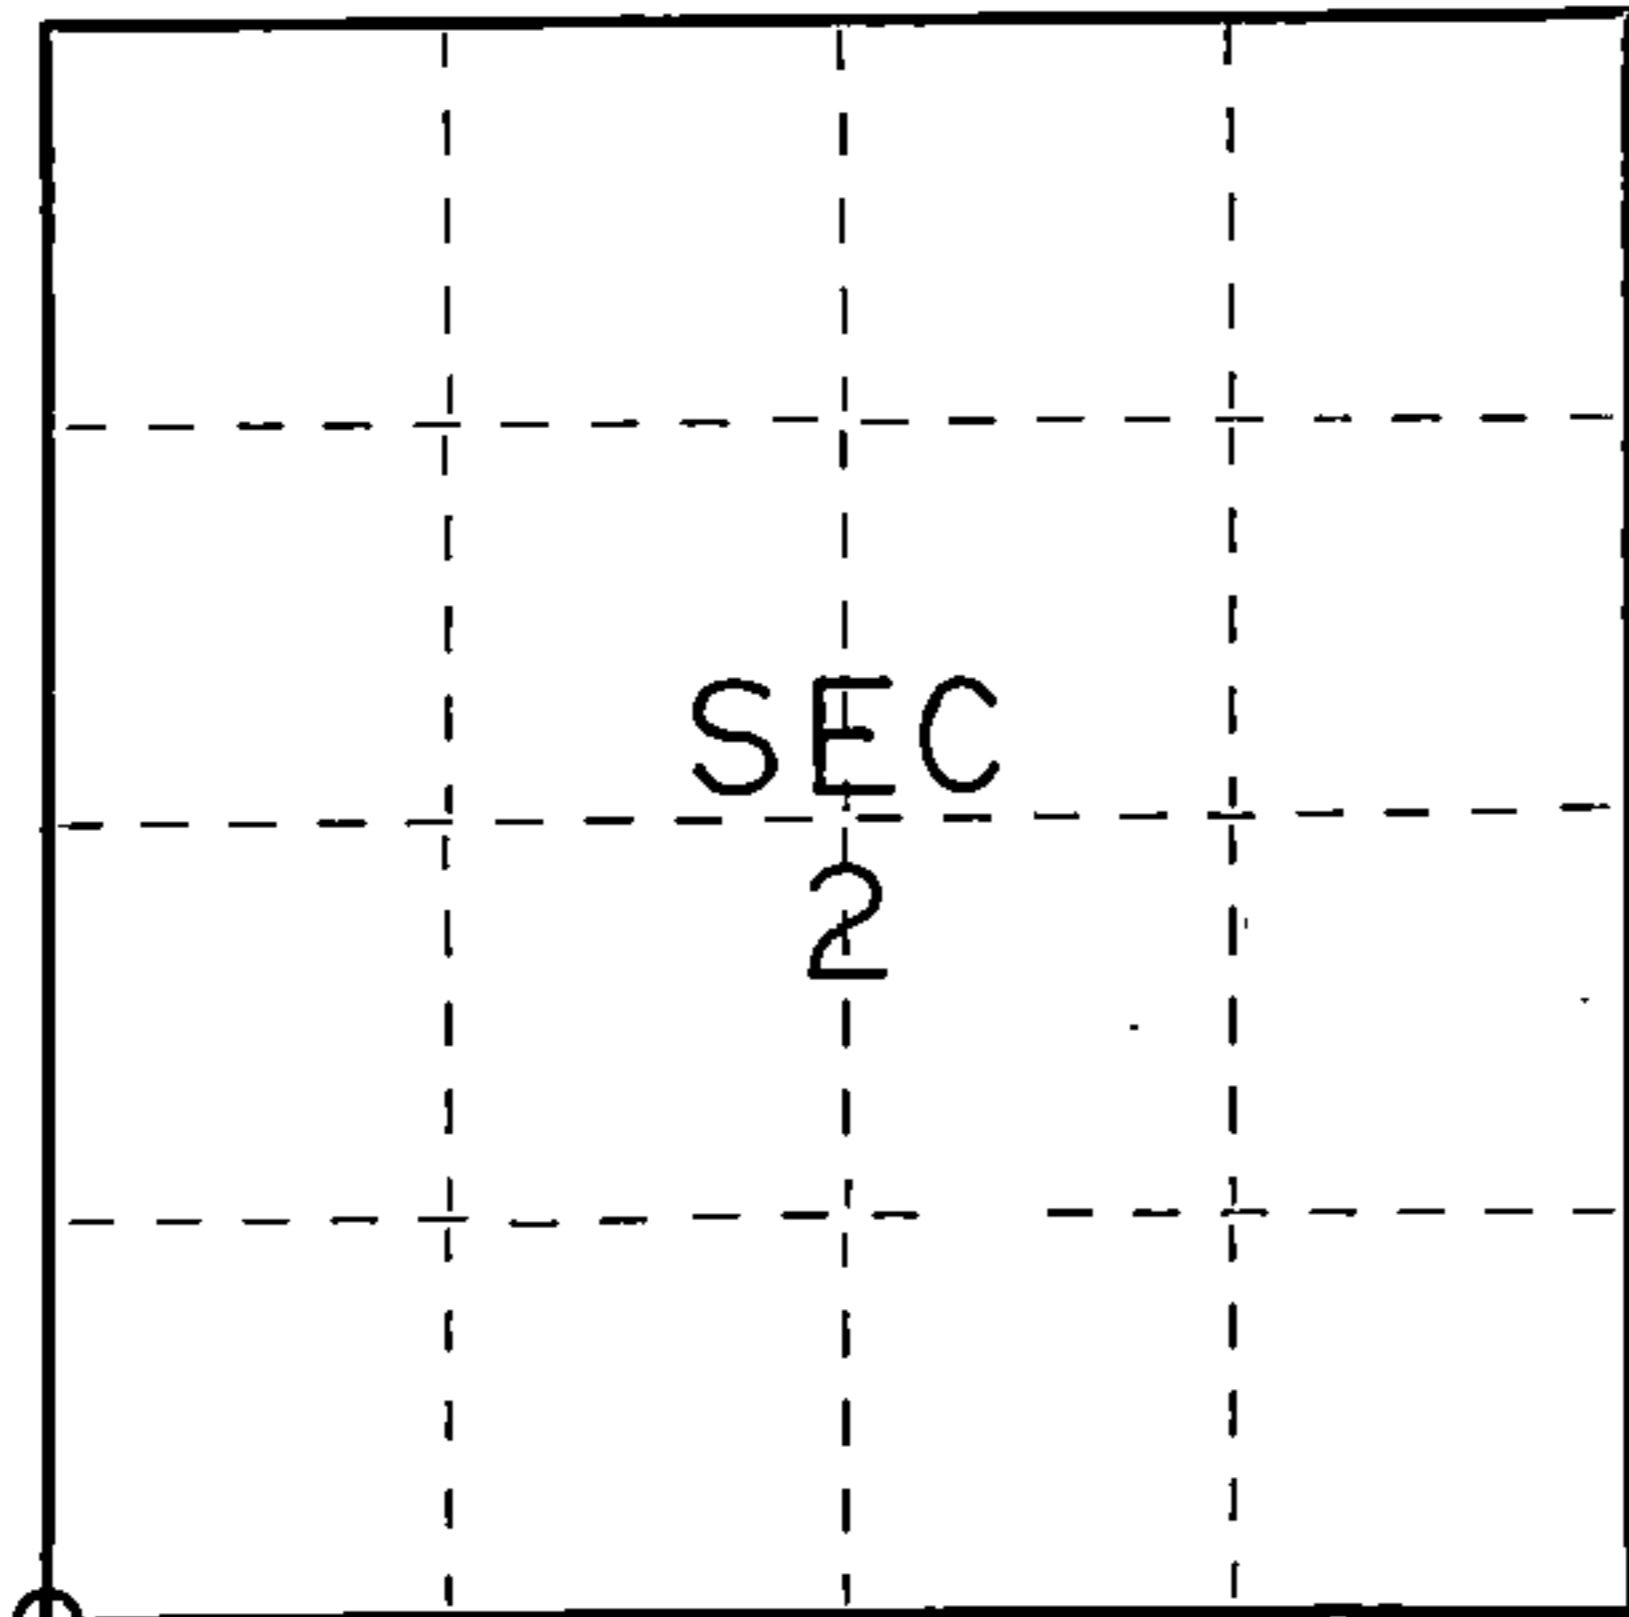

○ = Corner monument restored.

History of original corner establishment:

Original subdivision by James Nowlin Sept. 11 - Sept. 21, 1865

Hemlock 12 N59E 23 Lks.
Sugar 14 N9W 30 Lks.

Description of corner evidence found:


2" iron pipe 5' long set by C.E. Walker in 1940 has brass cap

Description of monument and accessories I established to perpetuate the original location of this corner.

Left monument set by Walker

Ties:

Maple 10 S56E 10.72 feet
Maple 12 S20W 8.67 feet
Hemlock 10 S77W 23.05 feet

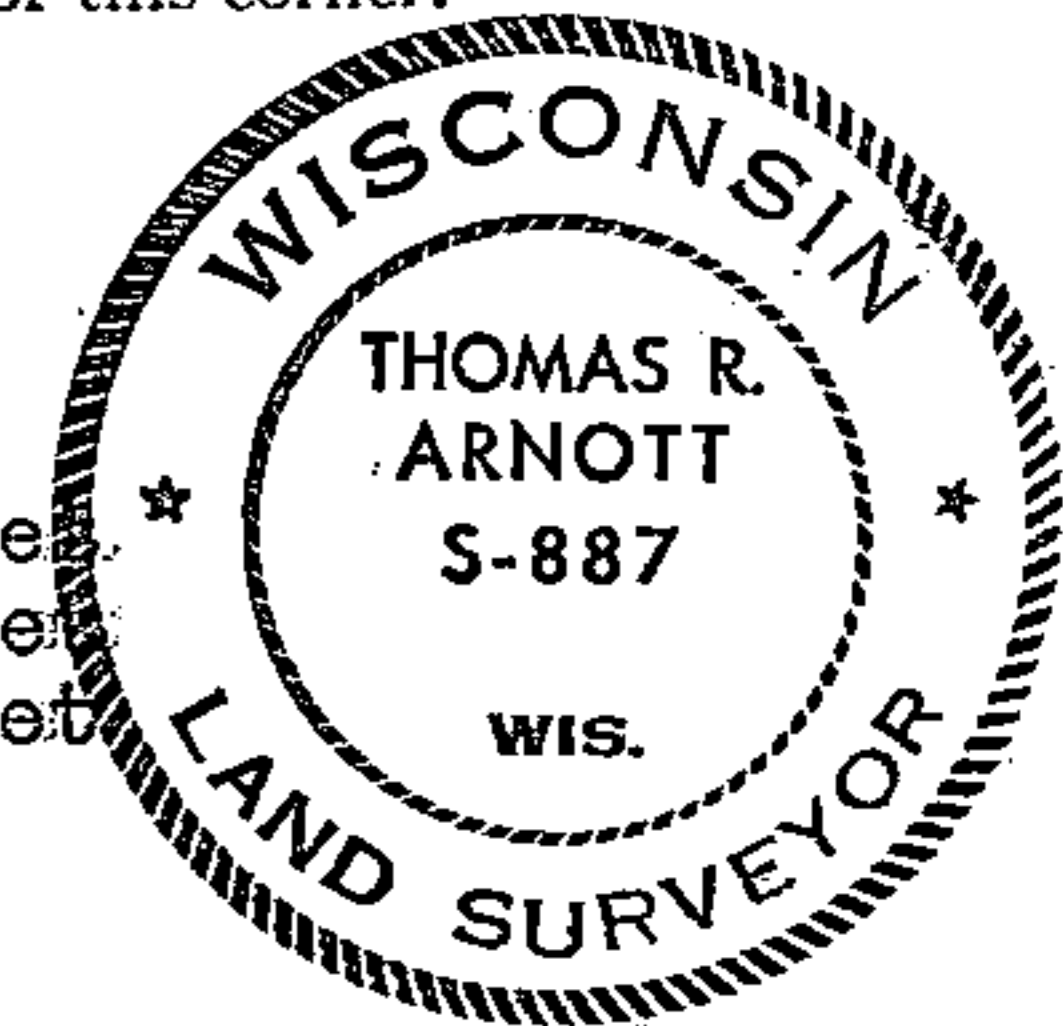

435 13030000

Dated at Crandon, Wis., this 8th day of January, 1976.

Signature Thomas Arnott Title Surveyor Registration No. S-887
(County Surveyor, Registered Land Surveyor, or other duly authorized official)

Office of Register of Deeds, County of Forest, I hereby certify that the within instrument was filed in this office for record on the 8th day of January, 1976 at 11 o'clock A M.

Eugene Stutzman Document Number 108522
(Register of Deeds)

By _____ Deputy