

CERTIFIED LAND CORNER RESTORATION

State of Wisconsin }
County of Forest } ss.

History of original corner establishment:

Original subdivsion by James Nowlin Sept. 11 - Sept. 21, 1865


I Thomas R. Arnett, do hereby certify that on the 23rd day of December, 1975, I found evidence of the M.C. East side Lake Lucerne corner of sections 3 & 10 Township 35, North, Range 13 E, Fourth Principal Meridian, as described hereon; and that from this evidence I established a new monument and accessories as described hereon to perpetuate the original location of this corner.

Hemlock 12 N37W 8 Lks.
W. Pine 15 S4E 14 Lks.

Description of corner evidence found:

2" iron pipe 5' long with brass cap set by C.E. Walker in 1940

Resident witnesses:

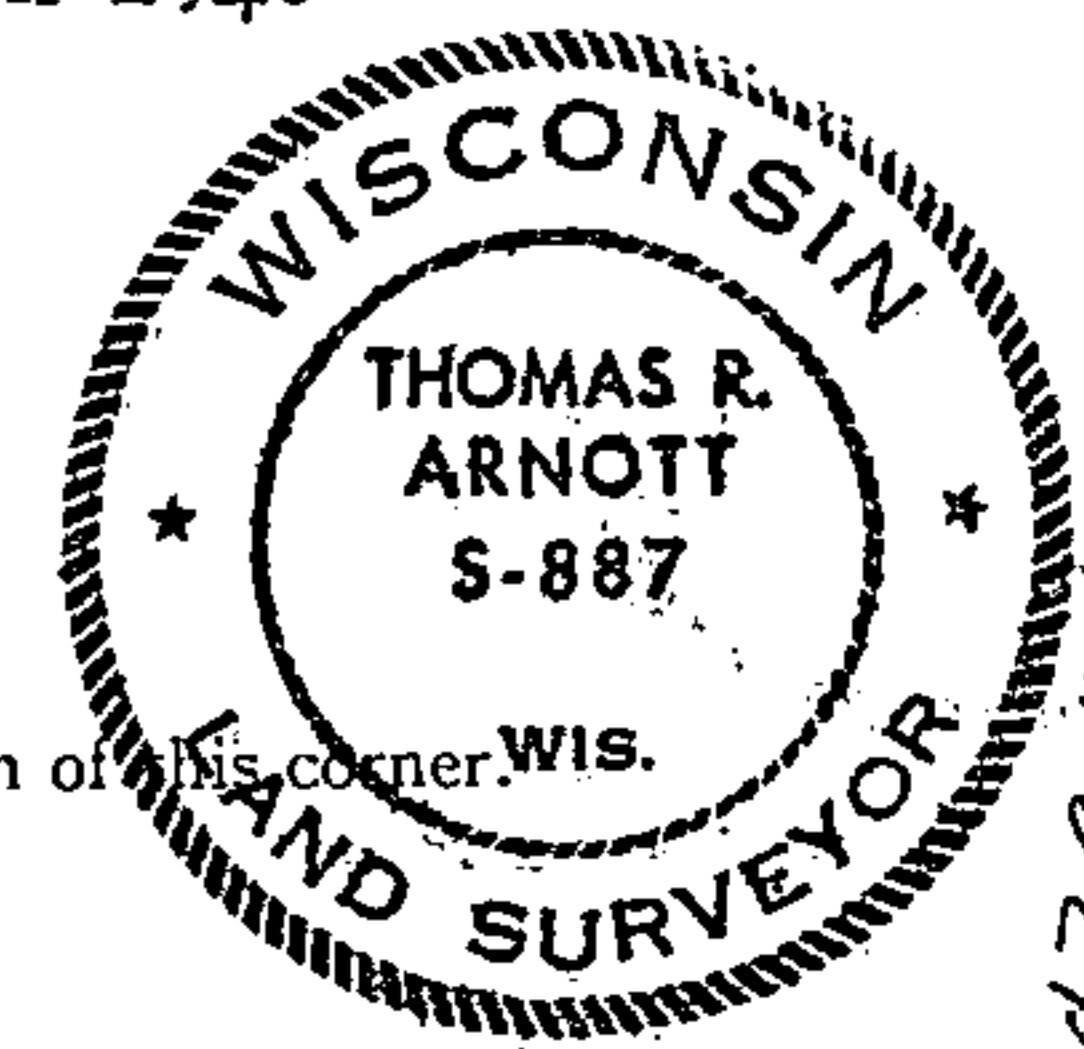


Description of monument and accessories I established to perpetuate the original location of this corner. Wis.

Left monument set by Walker

Ties:

Cedar 8 N15W 12.90 feet
NW cor. boathouse S5W 28.70 feet

FORM 985 W. C. MILLER CO., MILWAUKEE

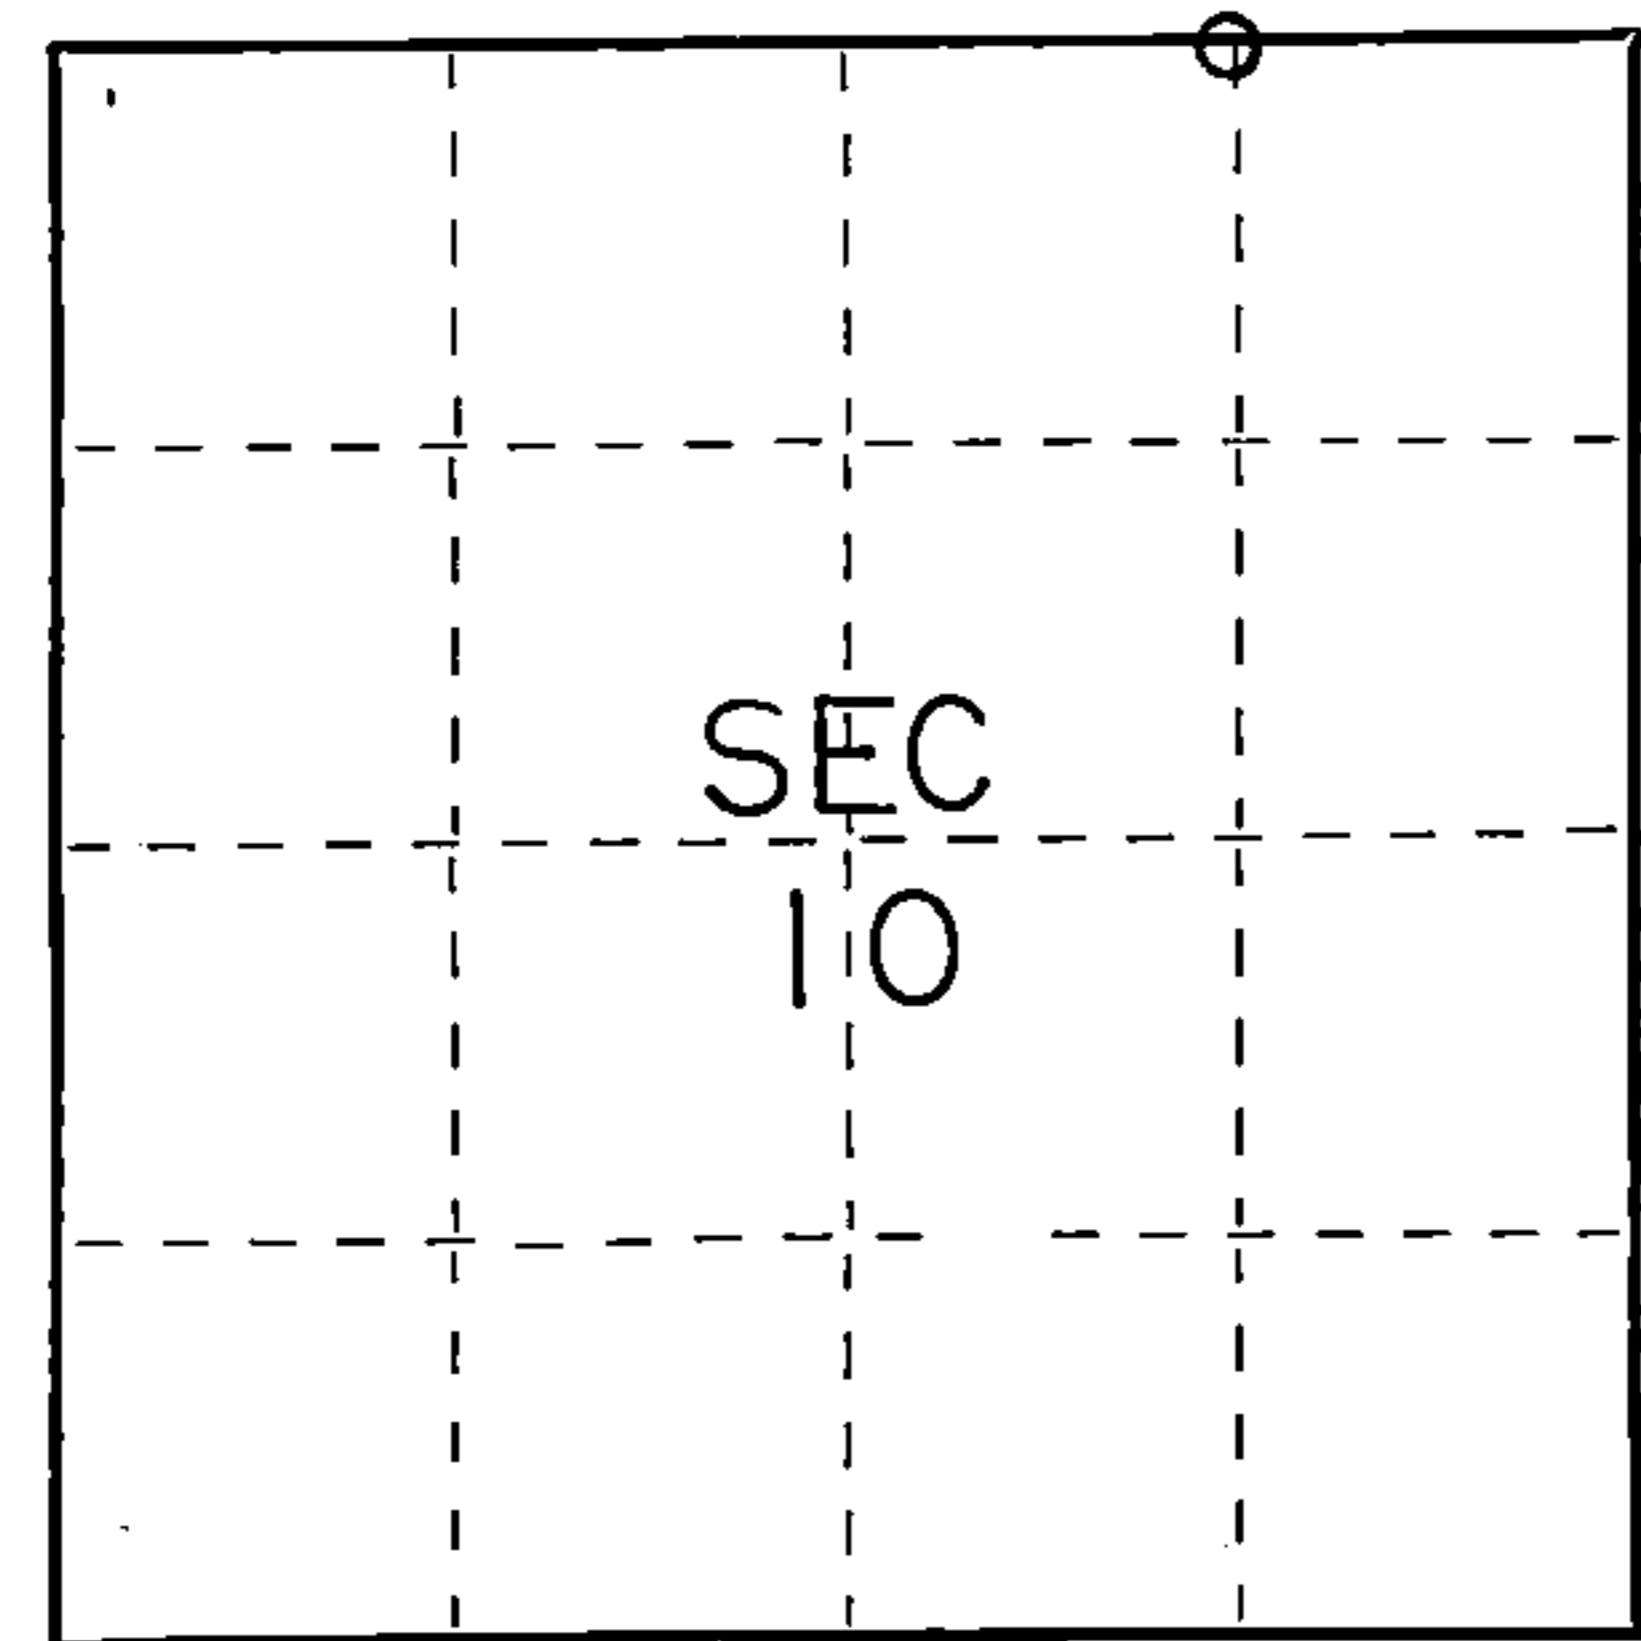

○ = Corner monument restored.

Dated at Crandon, Wis., this 9th day of January, 1976

Signature Thomas Arnett Title Surveyor Registration No. S-887
(County Surveyor, Registered Land Surveyor, or other duly authorized official)

Office of Register of Deeds, County of Forest, I hereby certify that the within instrument was filed in this office for record on the 9th day of January, 1976 at 11 o'clock A M.

Eugene Stutzman Document Number 108531
(Register of Deeds)

By _____ Deputy

43513030010