

State of Wisconsin }
County of FOREST } ss.

I NEAL SPERHAKE, do hereby certify that on the TWENTIETH day of OCTOBER, 19 64, I established ~~the~~ a MEANDER CORNER ON THE EAST SIDE OF LAKE METONGA ON THE SOUTH SIXTEENTH LINE OF SECTION 5, TOWNSHIP 35 NORTH, RANGE 13 EAST, Fourth Principal Meridian, as described hereon.

History: There is no record of this corner having ever been previously established.

Description of monument and accessories I established to perpetuate the location of this corner:


At the point determined for the location of the corner I emplaced a:

GALVANIZED IRON PIPE, THREE FEET LONG, ONE INCH IN DIAMETER, WITH ALUMINUM CAP DENOTED AS, "KIMBERLY CLARK CORP. T35N SURVEY MARKER S 1/16 LINE R13E SPERHAKE RLS 463 10/20/64."

The pipe is witnessed by:

Elm 9 S 74°E 35 links. (SCRIBED S 5 WC BT).
Maple 4 N 36°E 26½ links. (SCRIBED S 5 WC BT).

Description as to how corner was located: It has been previously determined that the section line between sections 5 and 8 is parallel to the town line between sections 32 and 5. Therefore, the south sixteenth line of section 5 would also be parallel to the north and south section line. A survey line was started at the south sixteenth corner between sections 4 and 5 and run west, parallel to the town line and the line between sections 5 and 8, until the high water mark of Lake Metonga was reached. At this point a new meander corner, or survey corner, was set. The distance between the south sixteenth corner between sections 4 and 5 and the meander or survey corner is 33.67 chains.

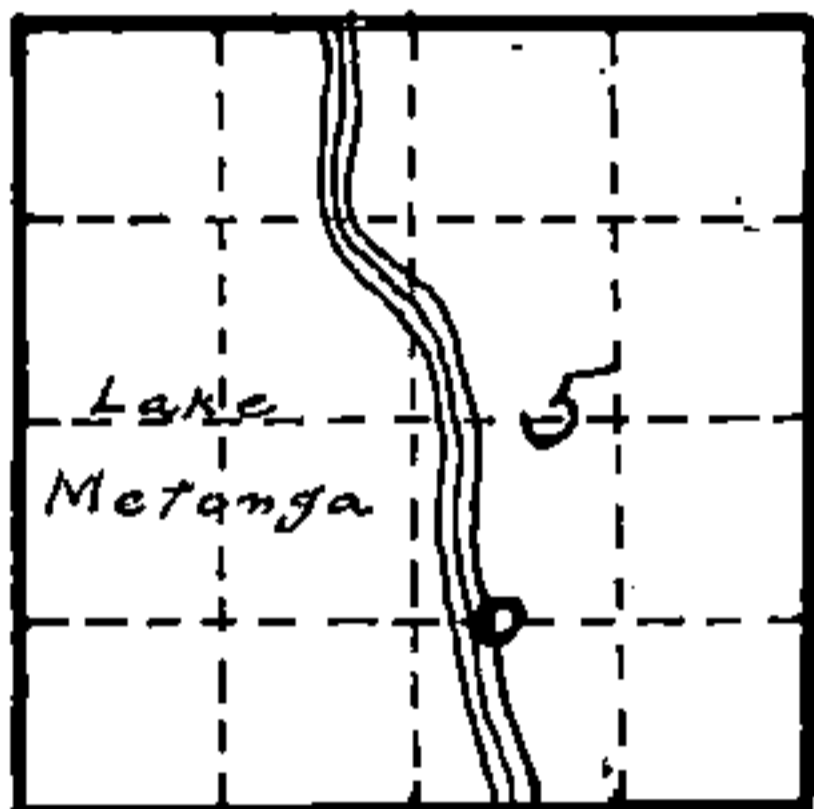

O = Corner monument restored

89583

NOTARY PUBLIC OFFICE
FOREST COUNTY, WIS.

JAN 12 1965

10 AM
Anna Peterson

Resident witnesses _____

Dated at Crandon, Wisconsin, this 12th day of January, 19 65.

Signature Neal Sperhake

Title Registered Land Surveyor Registration No. 463

~~Office of~~ Forest County ~~of~~ Wisconsin

I hereby certify that the within instrument was ~~filed in the~~ office for record on the 12th day of January 1965, and was ~~filed in the~~ signed and ~~Page No.~~ sworn to of ~~County Records.~~ before me.

Surveyor's Seal

Signature Anna Peterson Title Notary Public

4351305 1016

Index No. 02