

State of Wisconsin

County of FOREST

ss. RESTORATION OF LOST ORIGINAL GOVERNMENT SURVEY CORNER.

I NEAL SPERHAKE, do hereby certify that on the SECOND day of SEPTEMBER, 1964, I established the QUARTER SECTION CORNER BETWEEN SECTIONS 4 AND 5, TOWNSHIP 35 NORTH, RANGE 13 EAST, Fourth Principal Meridian, as described hereon.

**History:** This corner was established during the original survey of this township, as noted in the original field notes for the original survey of T35N-R13E, 4th. p.m.

**Description of monument and accessories I established to perpetuate the location of this corner:**


At the point determined for the location of the corner I emplaced a:

GALVANIZED IRON PIPE, THREE FEET LONG, ONE INCH IN DIAMETER, WITH ALUMINUM CAP DENOTED AS, "KIMBERLY CLARK CORP. T35N 1/4 BTWN. 5 & 4 R13E SPERHAKE RLS 463 9/2/64."

The pipe is witnessed by:


- Oak 9 N 48°E 19 links. (SCRIBED 1/4 S 4 NBT).
- W. Birch 9 S 58°W 24 links. (SCRIBED 1/4 S 5 NBT).

**Description as to how corner was located:** No evidence of the original corner is present. Thus, set by proportionate measurement. The section corners 1/2 mile north and south, respectively, have been previously established with a distance between them of 75.03 chains. The original length of the line between 4 and 5 was 75.60 chains. The original length of the line between the corner of 4, 5, 8, 9 and the quarter corner between 4 and 5 was 40 chains. Thus, set the quarter corner 39.71 chains north of the corner of 4, 5, 8, 9, 35.32 chains south of the corner of 32, 33, 4, 5, and on a straight line between them.

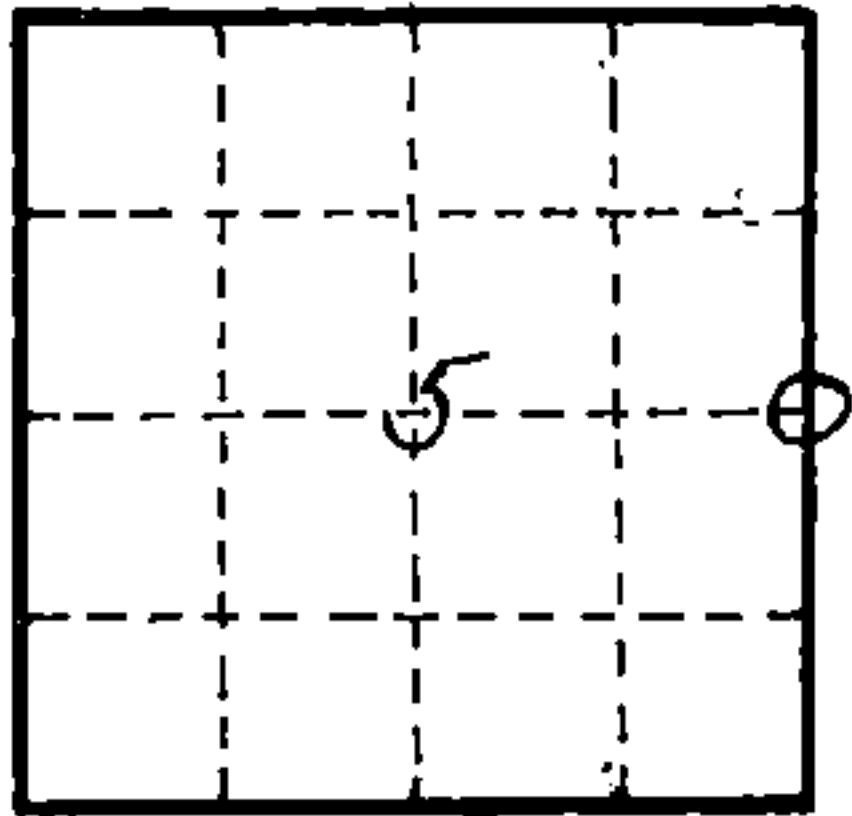

O = Corner monument restored

89576

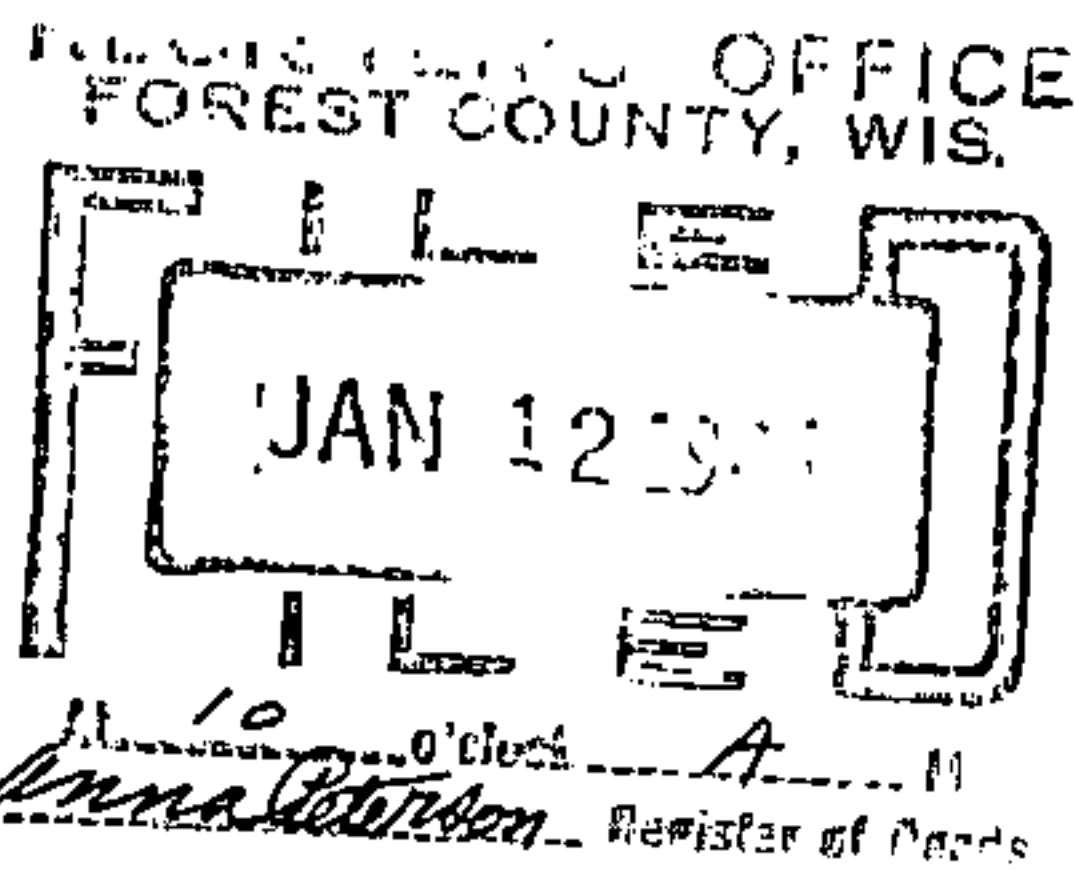

Resident witnesses \_\_\_\_\_

Dated at Crandon, Wisconsin, this 12th day of January, 1965.

Signature Neal Sperhake

Title Registered Land Surveyor Registration No. 463

Office of Forest County of Wisconsin, I hereby certify that the within instrument was ~~filed in this~~ ~~signed and sworn to~~ ~~on the~~ 12th day of January 1965, and was ~~filed in Book No.~~ ~~signed and~~ ~~Page No.~~ sworn to of County Records. before me.

Surveyor's Seal

Signature Anna Peterson Title Notary Public

4351305 2000

Index No. 69