

CERTIFIED LAND CORNER RESTORATION

Index No. E-2

State of Wisconsin }
County of Forest } ss.

History of original corner establishment:

Original Subdivision by James Nowlin Sept. 11 - Sept. 21, 1865

W. Birch 12 N30 W 15 Lks.
Hemlock 10 S69W 35 Lks.

Description of corner evidence found:

1 3/4" iron pipe found

I Thomas R. Arnott, do hereby certify that on the 18th day of September, 1975, I found evidence of the M.C. corner of sections 6 & 7 Township 35, North, Range 13 E, Fourth Principal Meridian, as described hereon; and that from this evidence I established a new monument and accessories as described hereon to perpetuate the original location of this corner.

Resident witnesses:


Herbert Wagoner

Description of monument and accessories I established to perpetuate the original location of this corner.


Set new Forest County aluminum monument

Ties:

W. Birch 16" N3W 8.26 feet
SE cor cottage N52W 19.48 feet
W. Birch 12" S39 1/2 W 5.66 feet

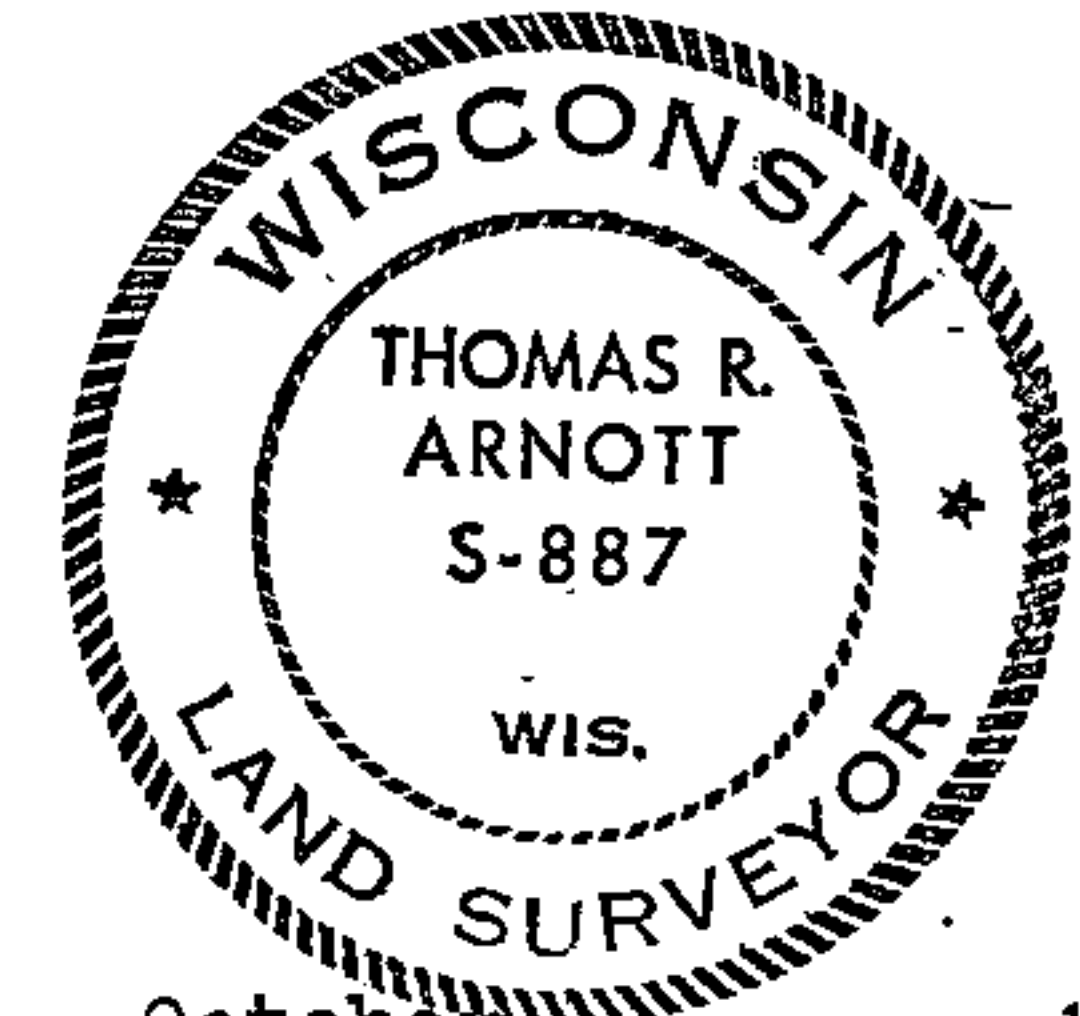

FORM 985 H. C. MILLER CO., MILWAUKEE

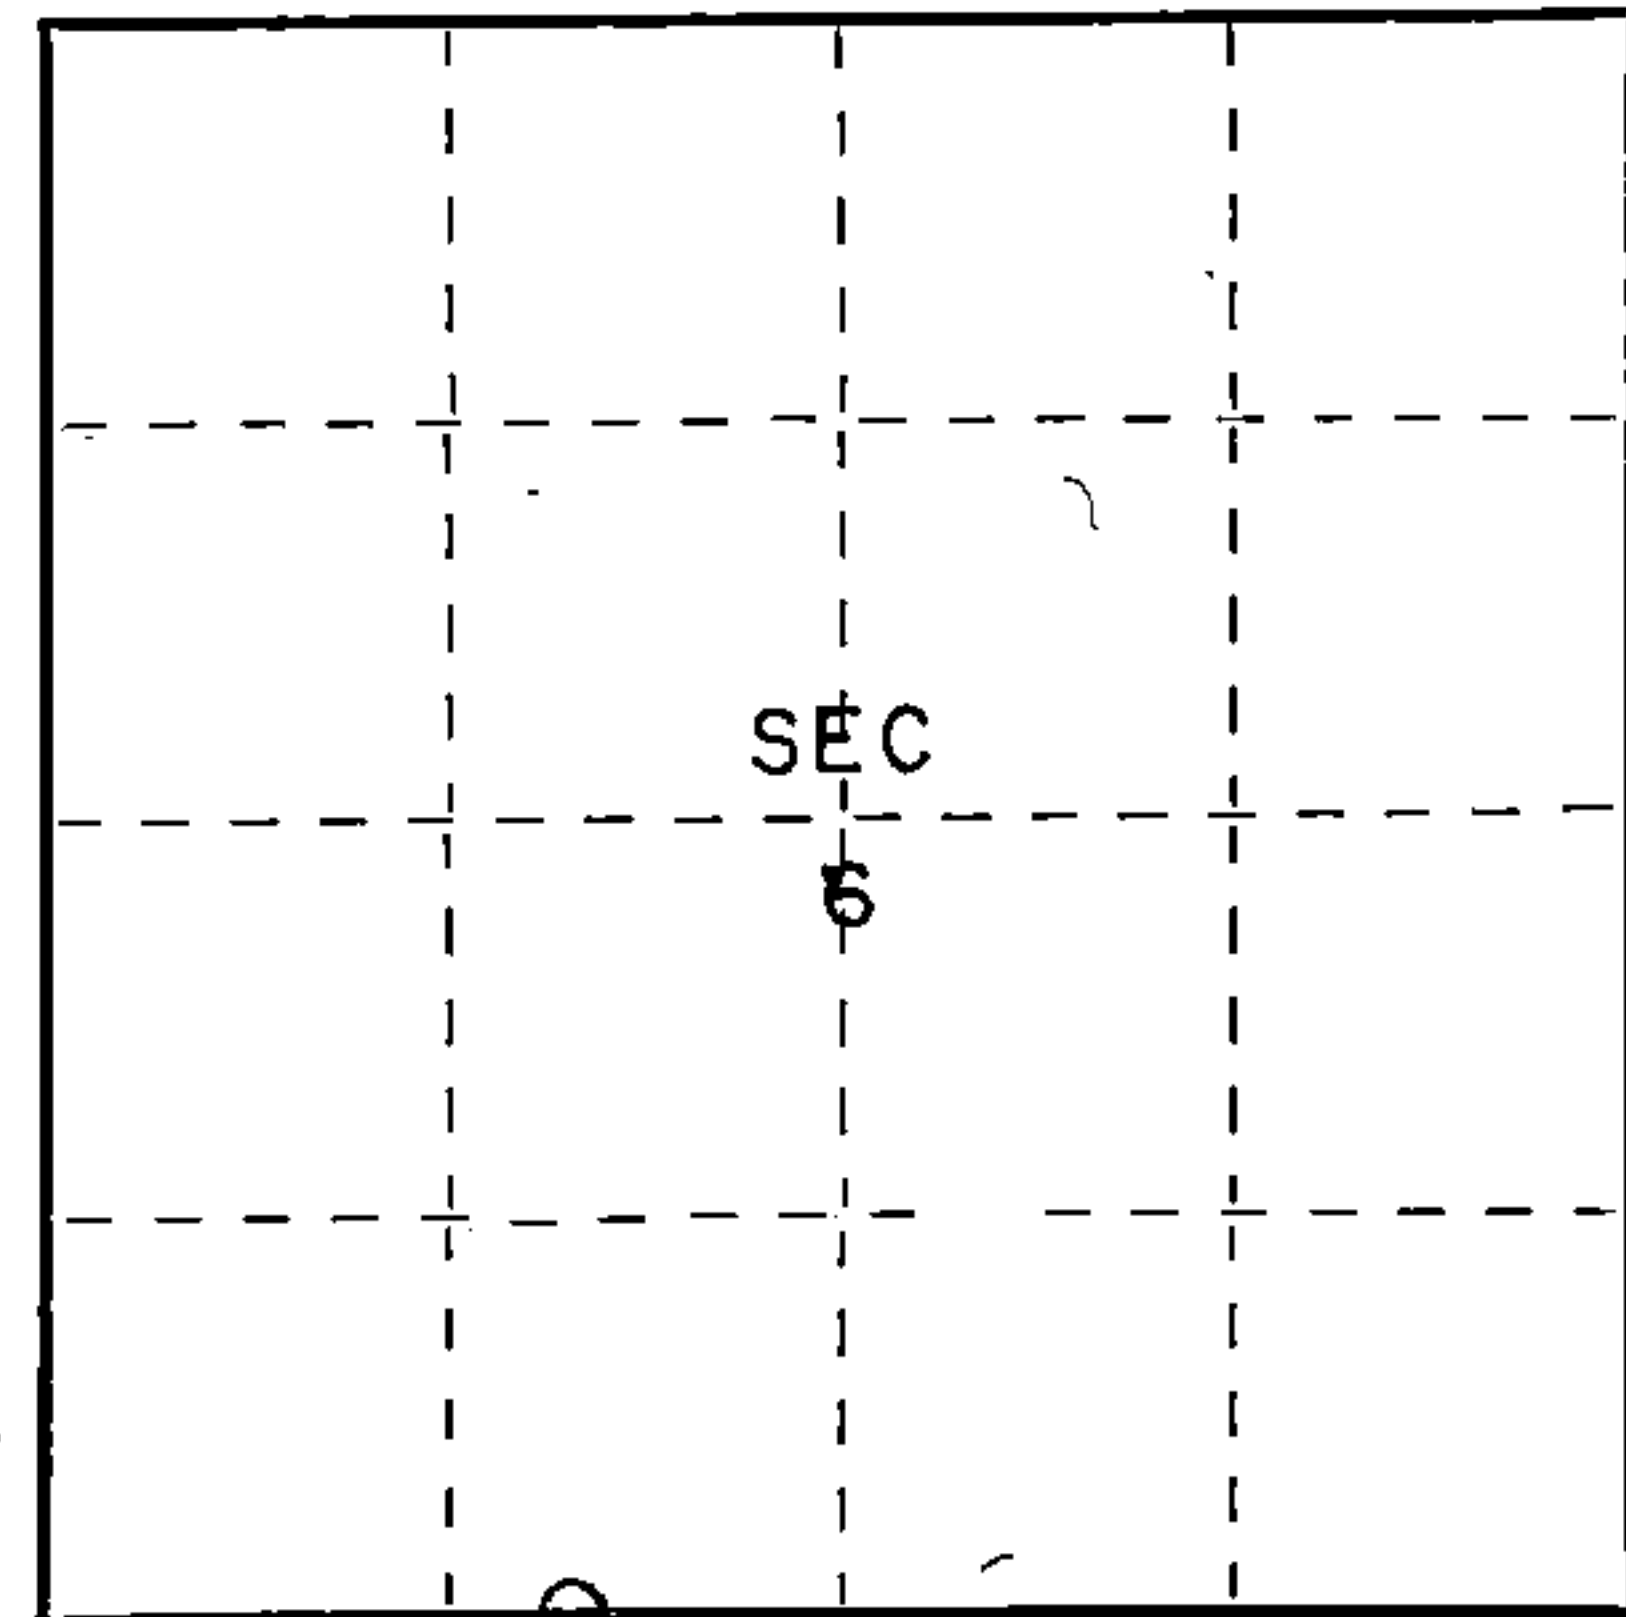

○ = Corner monument restored.

Dated at Crandon, Wis., this 30th day of October, 1975.

Signature Thomas R. Arnott Title Land Surveyor Registration No. S-887
(County Surveyor, Registered Land Surveyor, or other duly authorized official)

Office of Register of Deeds, County of Forest, I hereby certify that the within instrument was filed in this office for record on the 30th day of October, 1975 at 3 o'clock P. M.

Eugene Stutzman (Register of Deeds) Document Number 108121

By _____ Deputy

435 13060028