

State of Wisconsin

County of FOREST

ss. RESTORATION OF LOST ORIGINAL GOVERNMENT SURVEY CORNER.

I NEAL SPERHAKE, do hereby certify that on the SEVENTH day of OCTOBER, 1964, I ~~established~~ ^{found} located the NORTHWEST SECTION CORNER OF SECTION 13, TOWNSHIP 35 NORTH, RANGE 13 EAST, Fourth Principal Meridian, as described hereon.

History: This corner was established during the original survey of this township, as noted in the original field notes for the original survey of T35N-R13E, 4th. p.m. and apparently was relocated by C. E. Walker, Forest County Surveyor, in 1940. However, no record of Walker's survey was obtainable.

Description of monument and accessories I established to perpetuate the location of this corner:


At the point determined for the location of the corner I ^{found} ~~established~~ a:

GALVANIZED IRON PIPE, FIVE FEET LONG, TWO INS. IN DIAMETER, WITH BRASS CAP DENOTED AS, "FOREST CO. FOREST CROP SURVEY T35N-R13E 11, 12, 13, 14 C. E. WALKER 8/8/1940."

The pipe is witnessed by:

- W. Birch 4 N 64°W 45½ links. (SCRIBED S11 NBT).
- W. Birch 5 N 52°E 62 links. (SCRIBED S12 NBT).
- W. Birch 5 S 70°E 136 links. (SCRIBED S13 NBT).
- W. Birch 3 S 61°W 36 links. (SCRIBED S14 NBT).


Description as to how corner was located: The measured distance between the established corner of 13, 14, 23, 24 (as witnessed by a witness corner on the south shore of Wyman Lake), and Walker's pipe and cap noted above as designating the corner of 11, 12, 13, 14, is 80.05 chains. The original distance was 80.00 chains. The distance between the quarter section corner between 11 and 14, which is also monumented by Walker, and the corner of 11, 12, 13, 14, as designated by Walker, is 40.31 chains. The original distance was 40.00 chains. I have not done any more retracement work than that described above to determine any further how accurately Walker set both the section and quarter section corners referred to above, but since the two measured distances compared to the original distances correspond fairly well with other retracement work I've done in this vicinity, I have accepted Walker's pipe and cap as marking the site of the original section corner, and have witnessed it as noted above.

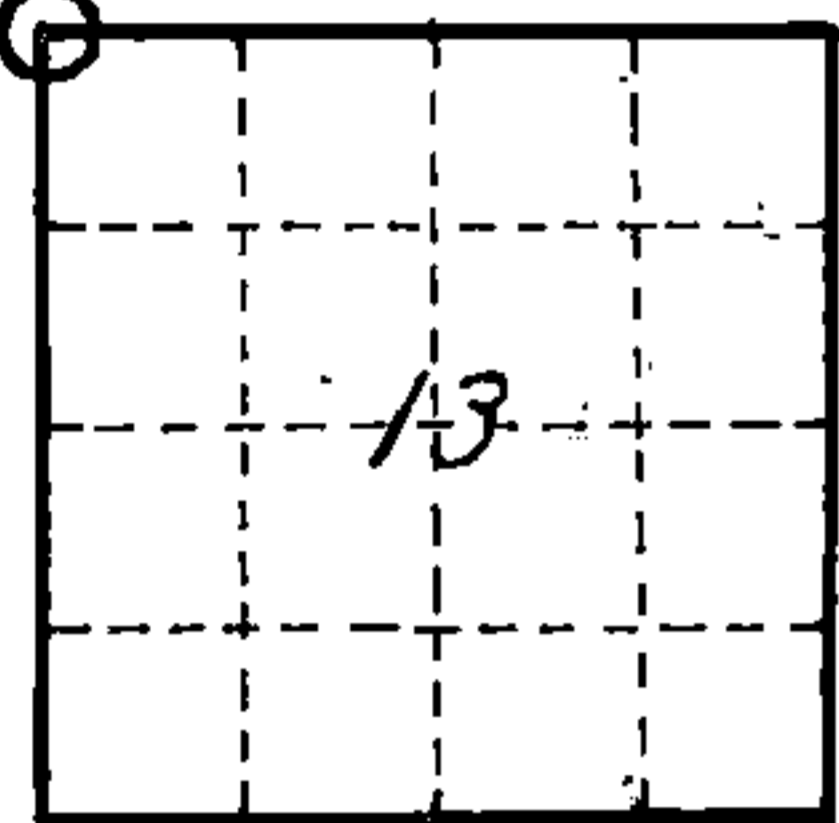

0 = Corner monument restored

89587

REGISTRAR'S OFFICE
FOREST COUNTY, WIS.

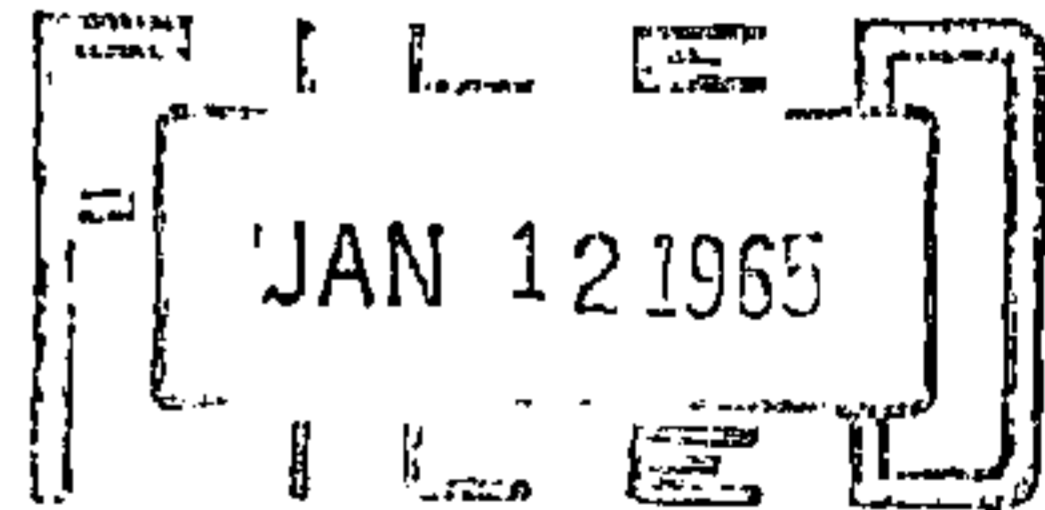

Anna Peterson Register of Deeds

Resident witnesses _____

Dated at Crandon, Wisconsin, this 12th day of January, 1965.

Signature *Neal Sperhake*

Title Registered Land Surveyor Registration No. 463

Office of Forest County of Wisconsin

I hereby certify that the within instrument was ~~filed~~ ~~for record~~ on the 12th day of January 1965, and was ~~filed~~ ~~in Book No.~~ signed and ~~page No.~~ sworn to ~~in County Records.~~ before me.

Surveyor's Seal

Signature *Anna Peterson* Title Notary Public

43513110000

Index No. 121