

State of Wisconsin
County of FOREST

} ss. ESTABLISHMENT OF QUARTER - QUARTER SECTION CORNER BETWEEN ORIGINAL GOVERNMENT SURVEY CORNERS.

I NEAL SPERHAKE, do hereby certify that on the SEVENTH day of AUGUST, 1964, I established the EAST ONE SIXTEENTH CORNER BETWEEN SECTIONS 11 AND 14, TOWNSHIP 35 NORTH, RANGE 13 EAST, Fourth Principal Meridian, as described hereon.

History: There is no record of this corner having ever been previously established.

Description of monument and accessories I established to perpetuate the location of this corner:


At the point determined for the location of the corner I emplaced a:

GALVANIZED IRON PIPE, THREE FEET LONG, ONE INCH IN DIAMETER, WITH ALUMINUM CAP DENOTED AS, "KIMBERLY CLARK CORP. T35N E 1/16 BTWN. 11 & 14 R13E SPERHAKE RLS 463 8/7/64."

The pipe is witnessed by:

- W. Birch 7 N 55°W 8 links. (SCRIBED S 11 BT).
- W. Birch 7 S 44°W 32 links. (SCRIBED S 14 BT).


Description as to how corner was located: Since both the section corner 1/4 mile east and the quarter corner 1/4 mile west have been previously established with a distance between them of 40.31 chains, the 1/16th. corner was set 20.15 1/2 chains from either corner and on a straight line between them.

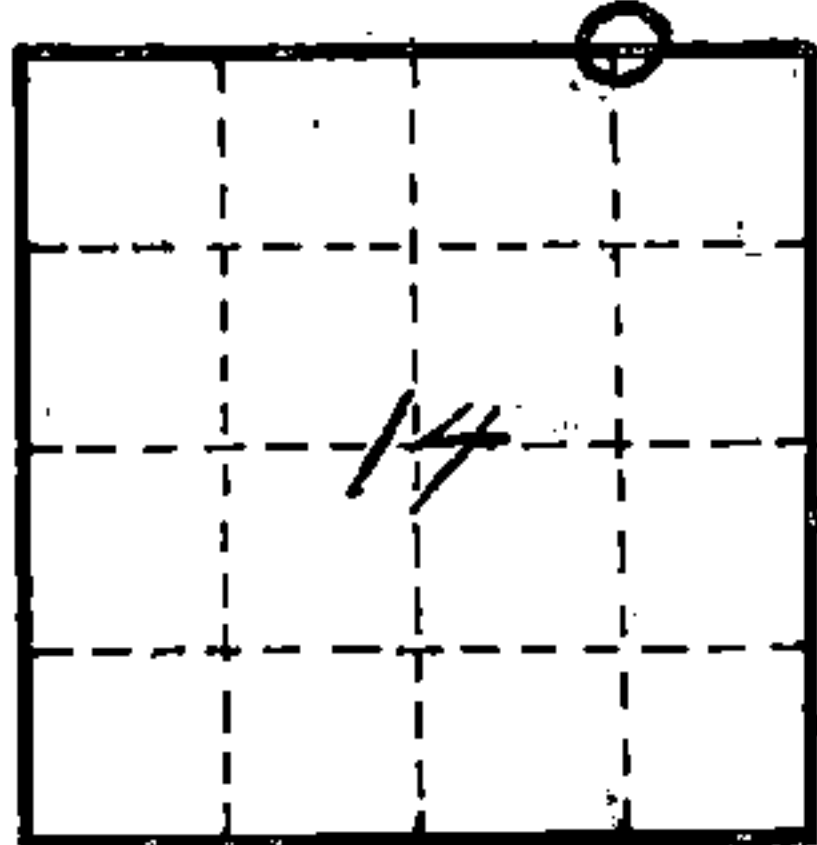

O = Corner monument restored

89586

REGISTRAR'S OFFICE
FOREST COUNTY, WIS.

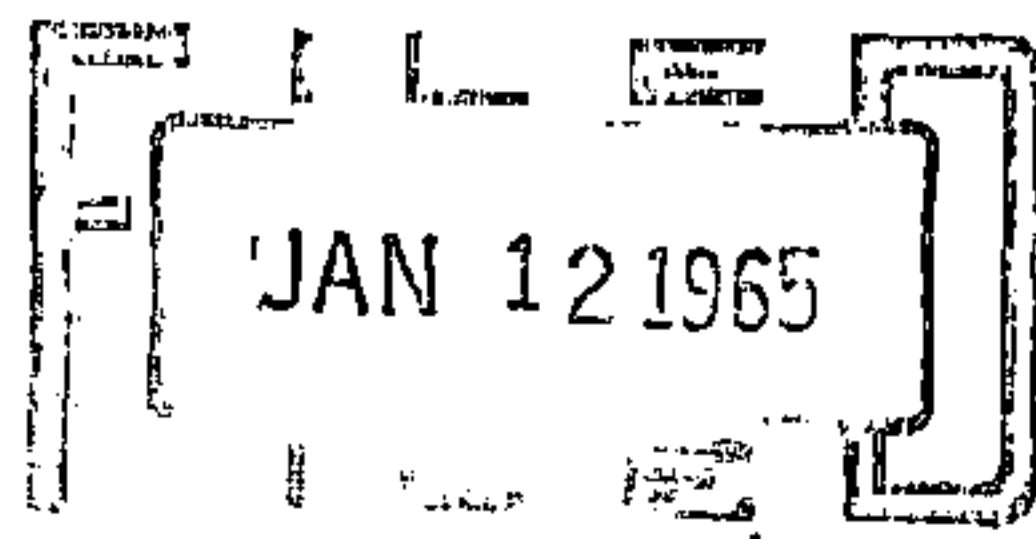

Resident witnesses _____

Dated at Crandon, Wisconsin, this 12th day of January, 1965

Signature Neal Sperhake

Title Registered Land Surveyor Registration No. 463

~~Office of Forest~~ County of Wisconsin,

I hereby certify that the within instrument was ~~filed in this~~ ~~office for record~~ on the 12th day of January 1965, and was ~~filed in~~ ~~Books No.~~ signed and ~~Page No.~~ sworn to ~~of County Records.~~ before me.

Surveyor's Seal

Signature Anna Peterson Title Notary Public

43513110010

Index No. 720