


State of Wisconsin }
County of Forest } ss.

I Thomas R. Arnott, do hereby
certify that on the 23rd day
of December, 1975, I found
evidence of the M.C.
corner of sections 11 & 14
Township 35, North, Range
13 E, Fourth Principal Meridian,
as described hereon; and that from this evidence
I established a new monument and accessories
as described hereon to perpetuate the original
location of this corner.

Resident witnesses:

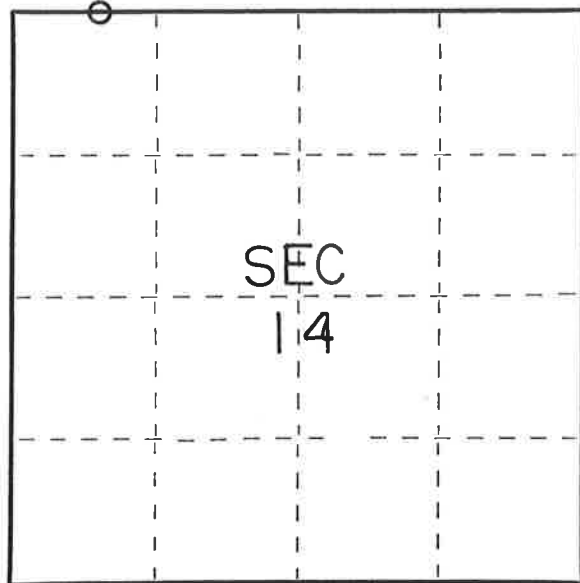

○ = Corner monument restored.

CERTIFIED LAND CORNER RESTORATION

Index No. 17-18

History of original corner establishment:

Original subdivision by James Nowlin Sept. 11 - Sept. 21, 1865

Bl. Oak	6	N23W	25 Lks.
Birch	8	S57E	35 Lks.

Description of corner evidence found:


2" iron pipe 5' long with brass cap set by C.E. Walker in 1940

Description of monument and accessories I established to perpetuate the original location of this corner.

Left monument set by Walker

Ties:

Oak	12	N58W	21.25 feet
Maple	8	N36E	8.53 feet

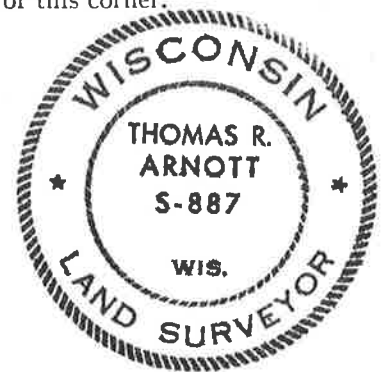

Dated at Crandon, Wis., this 9th day of January, 1976

Signature Thomas R. Arnott Title Surveyor Registration No. S-887
(County Surveyor, Registered Land Surveyor, or other duly authorized official)

Office of Register of Deeds, County of Forest, I hereby certify that the within
instrument was filed in this office for record on the 9th day of January, 1976
at 11 o'clock A. M.

Eugene Staszny Document Number 108533
(Register of Deeds)

By _____ Deputy

43513110026