

CERTIFIED LAND CORNER RESTORATION

Index No. **J 23**


State of Wisconsin }  
County of Forest } ss.

I Thomas R. Arnott, do hereby certify that on the 20th day of January, 1976, I found evidence of the 1/4 corner of sections 12 & 13 Township 35, North, Range 13 E, Fourth Principal Meridian, as described hereon; and that from this evidence I established a new monument and accessories as described hereon to perpetuate the original location of this corner.

Resident witnesses:

.....  
.....  
.....

FORM 985 M. C. MILLER CO., MILWAUKEE

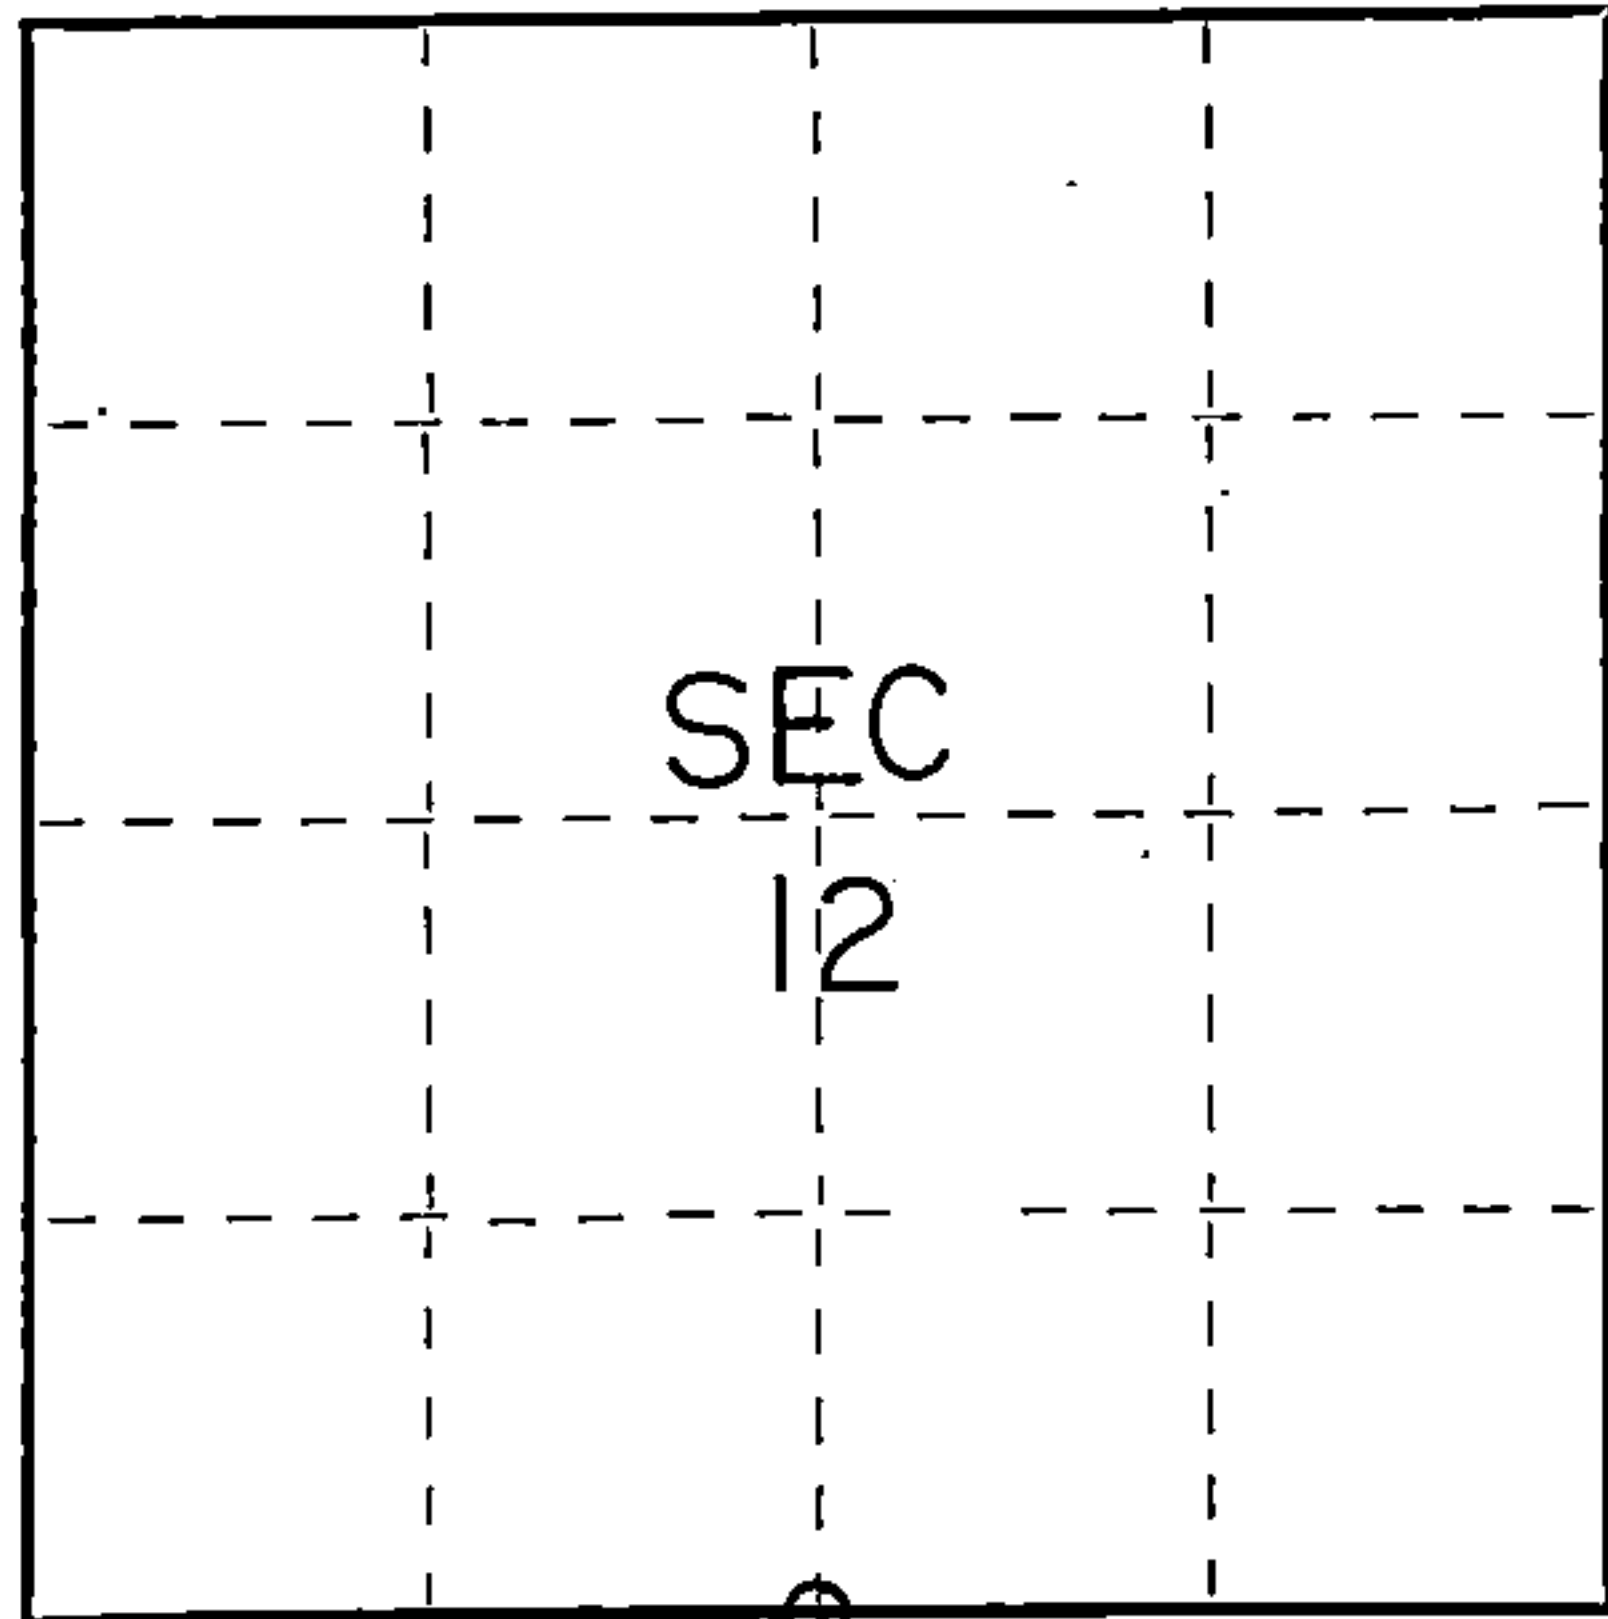

○ = Corner monument restored.

History of original corner establishment:

Original Subdivision by James Nowlin Sept 11 - Sept 21, 1865

Hemlock 40 N35W 6 Lks.  
Birck 30 S55E 25 Lks.

Description of corner evidence found:


2" iron pipe 5' long with brass cap set by C. E. Walker in 1940

Description of monument and accessories I established to perpetuate the original location of this corner.

Left monument set by Walker

Ties:

Hemlock 8 S38E 19.43 feet  
Maple 14 S65W 23.82 feet

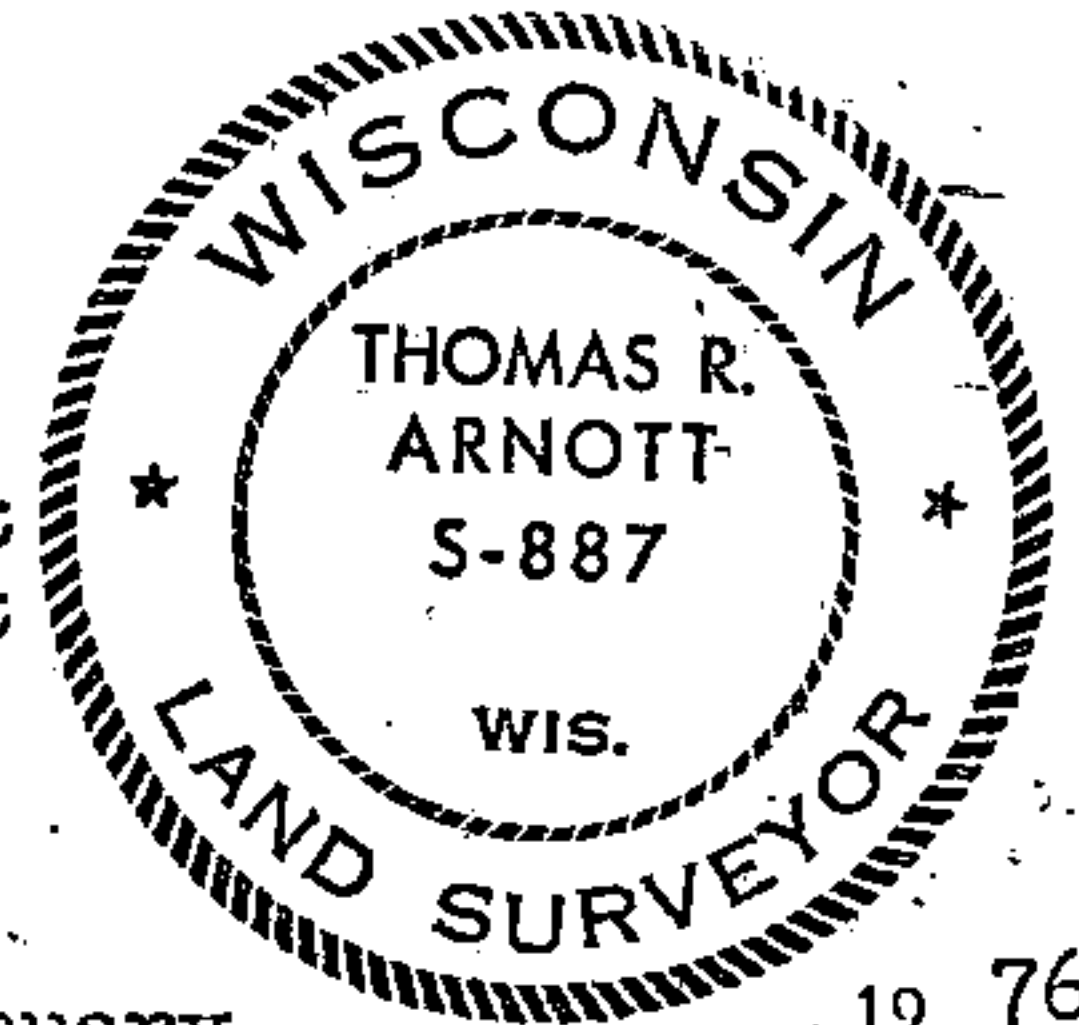

Dated at Crandon, Wis., this 23rd day of January, 1976.

Signature Thomas R. Arnott Title Surveyor Registration No. S-887  
(County Surveyor, Registered Land Surveyor, or other duly authorized official)

Office of Register of Deeds, County of Forest, I hereby certify that the within instrument was filed in this office for record on the 23rd day of January, 1976 at 3 o'clock P. M.

Eugene Staszny Document Number 108639  
(Register of Deeds)

By..... Deputy

43513120020