

State of Wisconsin

County of FOREST

ss. RESTORATION OF LOST ORIGINAL GOVERNMENT SURVEY CORNER.

I NEAL SPERHAKE, do hereby certify that on the TWENTY-NINTH day of JULY, 19 64, I established the SOUTH QUARTER SECTION CORNER OF SECTION 13, TOWNSHIP 35 NORTH, RANGE 13 EAST, Fourth Principal Meridian, as described hereon.

History: This corner was established during the original survey of this township, as noted in the original field notes for the original survey of T35N-R13E, 4th. p.m.

Description of monument and accessories I established to perpetuate the location of this corner:


At the point determined for the location of the corner I emplaced a:

GALVANIZED IRON PIPE, THREE FEET LONG, ONE INCH IN DIAMETER, WITH ALUMINUM CAP DENOTED AS, "KIMBERLY CLARK CORP. T35N 1/4 BTWN. 13 & 24 R13E SPERHAKE RLS 463 7/29/64."

The pipe is witnessed by:

- W. Birch 4 N 49°W 23 links. (SCRIBED 1/4S 13 NBT).
- Balsam 9 S 11°E 40 links. (SCRIBED 1/4S 24 NBT).

Description as to how corner was located: No evidence of the original corner was present. Thus, set by proportionate measurement. Since both the section corners 1/2 mile east and west, respectively, have been previously established with a distance between them of 79.26 chains, the quarter corner was set 39.63 chains from either corner and on a straight line between them.

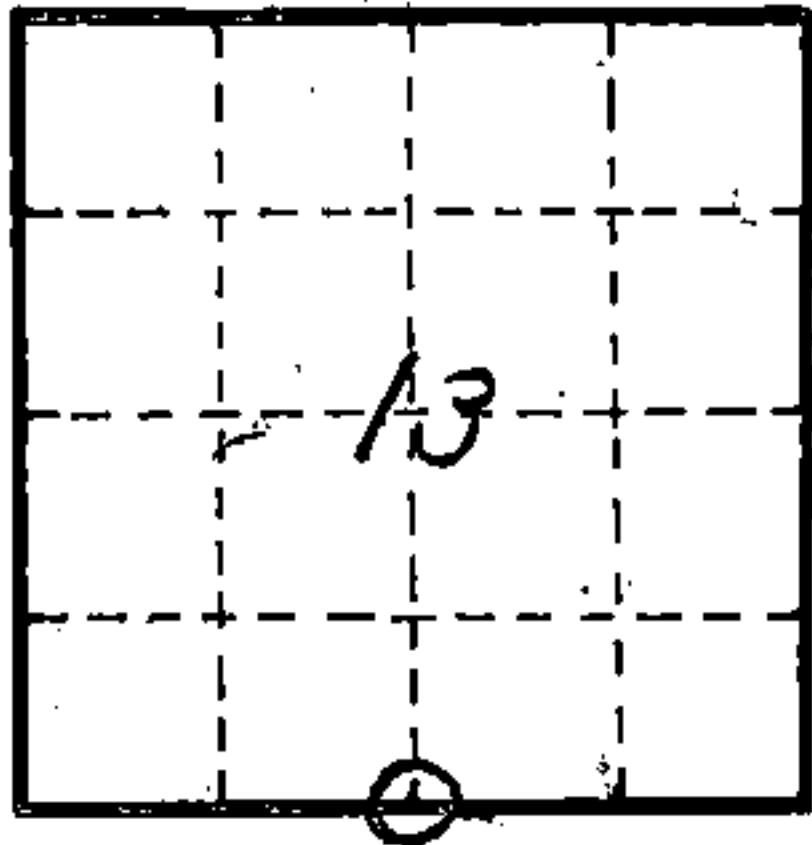

O = Corner monument restored

89588

REGISTRAR'S OFFICE
FOREST COUNTY, WIS.
JAN 12 1965
Anna Peterson Register of Deeds

Resident witnesses _____

Dated at Crandon, Wisconsin, this 12th day of January, 19 65.

Signature Neal Sperhake

Title Registered Land Surveyor Registration No. 463

~~Office of~~ Forest County of Wisconsin

I hereby certify that the within instrument was ~~filed in this~~ office for record on the 12th day of January 19 65, and was ~~filed in Book No.~~ signed and ~~Page No.~~ sworn to ~~in County Records~~ before me.

Surveyor's Seal

Signature Anna Peterson Title Notary Public

43513130020

Index No. M23