

CERTIFIED LAND CORNER RESTORATION

Index No. 101
L 25


State of Wisconsin }
County of FOREST } ss.

I NEAL SPERHAKE, do hereby certify that on the EIGHTH day of OCTOBER, 1962, I found evidence of the EAST QUARTER SECTION corner of SECTION 13 Township 35, North, Range 13 EAST, Fourth Principal Meridian, as described hereon; and that from this evidence I established a new monument and accessories as described hereon to perpetuate the original location of this corner.

Resident witnesses:
Richard Piontek - Waubesa

David Pichotta - Waubesa

FORM 985 H. C. MILLER CO., MILWAUKEE

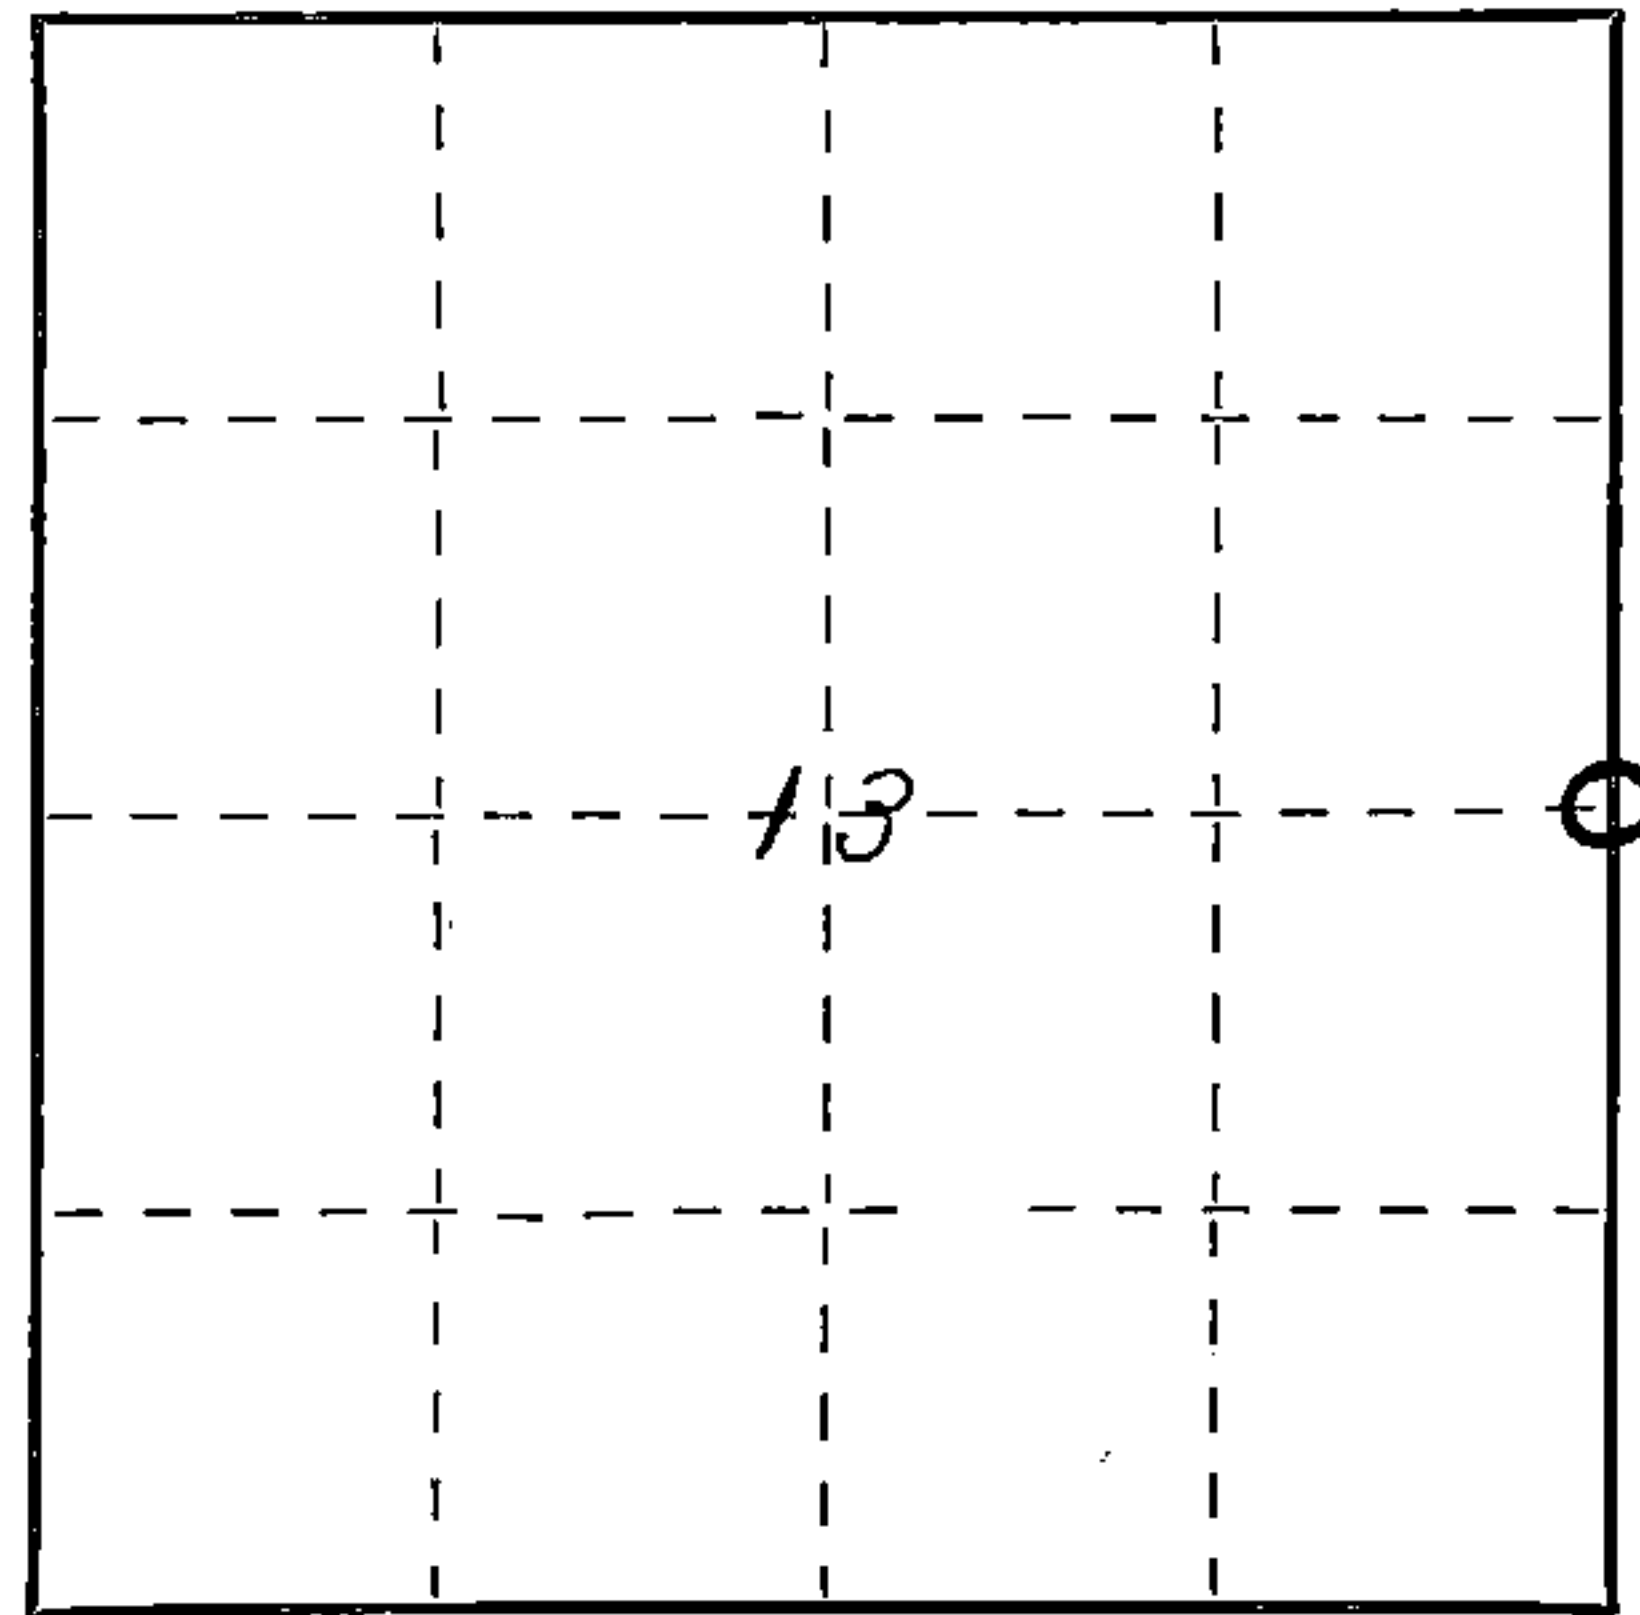

○ = Corner monument restored.

History of original corner establishment:

This corner can also be described as: THE QUARTER SECTION CORNER BETWEEN SECTIONS 13, T35N-R13E, AND 18, T35N-R14E, 4TH P. M.

This corner was established during the original survey of this township, as noted in the Original Field Notes for the Original Survey of T35N-R13E, 4th p.m.

Description of corner evidence found:

The stump of the original bearing tree, described in the original field notes as,

"Y. Pine 14 S85W 216 links"

is still present at this date, with a portion of the original scribe marks still visible.

Description of monument and accessories I established to perpetuate the original location of this corner.

At the site of the original post, as determined from the existing original bearing tree noted above, I emplaced a "GALVANIZED IRON PIPE, THREE FEET LONG, ONE INCH IN DIAMETER, WITH AN ALUMINUM CAP DENOTED AS, 'KIMBERLY-CLARK CORP T35N 1/4 BTWN 13 & 18 R13-14E SPERHAKE RLS 463 10-8-62'".

The pipe is witnessed by:
Hemlock 14 N62°E 208 links. (Scribed S18 NBT).
Spruce 3 N74°W 22½ links. (Scribed S13 NBT).

Dated at Crandon, Wis., Wis., this 11th day of February, 1963

Signature Neal Spershake Title Registered Land Surveyor Registration No. S-463
(County Surveyor, Registered Land Surveyor, or other duly authorized official)

Office of Register of Deeds, County of Forest, I hereby certify that the within instrument was filed in this office for record on the 11th day of February, 1963 at 10 o'clock A. M. 86830

Anna Peterson
(Register of Deeds)

By..... Deputy

Subscribed & sworn to before me this 11th day of Feb. 1963.
Anna Peterson
Notary Public, Forest Co., Wis.
Commission expires Oct. 31, 1965

43513132000
Surveyor's Seal