

CERTIFIED LAND CORNER RESTORATION

Index No. **R-23**

State of Wisconsin }
County of Forest } ss.

I, Glen Barker, do hereby certify that on the 13th day of September, 1984, I ~~found~~ ^{established} evidence of the NC 1/16 corner of Section 13 Township 35, North, Range 13 East, Fourth Principal Meridian, as described hereon; and that from this evidence I established a new monument and accessories as described hereon to perpetuate the original location of this corner.

Resident witnesses:

N. Spiess

H. Wagone



History of original corner establishment:

3"x3" wood post set by Kimberly Clark Corp in 1964. Post set by compass and is not of record.

Description of corner evidence found:

Total distance from 1/4 corner between Section 12 & 13 to C 1/4 Section 13 is 2,601.47'.
Set NC 1/16 1300.74' intermediate.


3"x3" wood post bears S85W 9.0'

Description of monument and accessories I established to perpetuate the original location of this corner.

Set a 1" iron pipe with 2" diameter alloy cap stamped: S1682
Monument projects 18" above ground T35N
Marked NBTs: NC 1/16 S 13
Sugar 7" N31W 18.06' R 13E
Sugar 6" N86W 22.06' CPI - 1984

FORM 985 H. C. MILLER CO., MILWAUKEE

T35N R13E

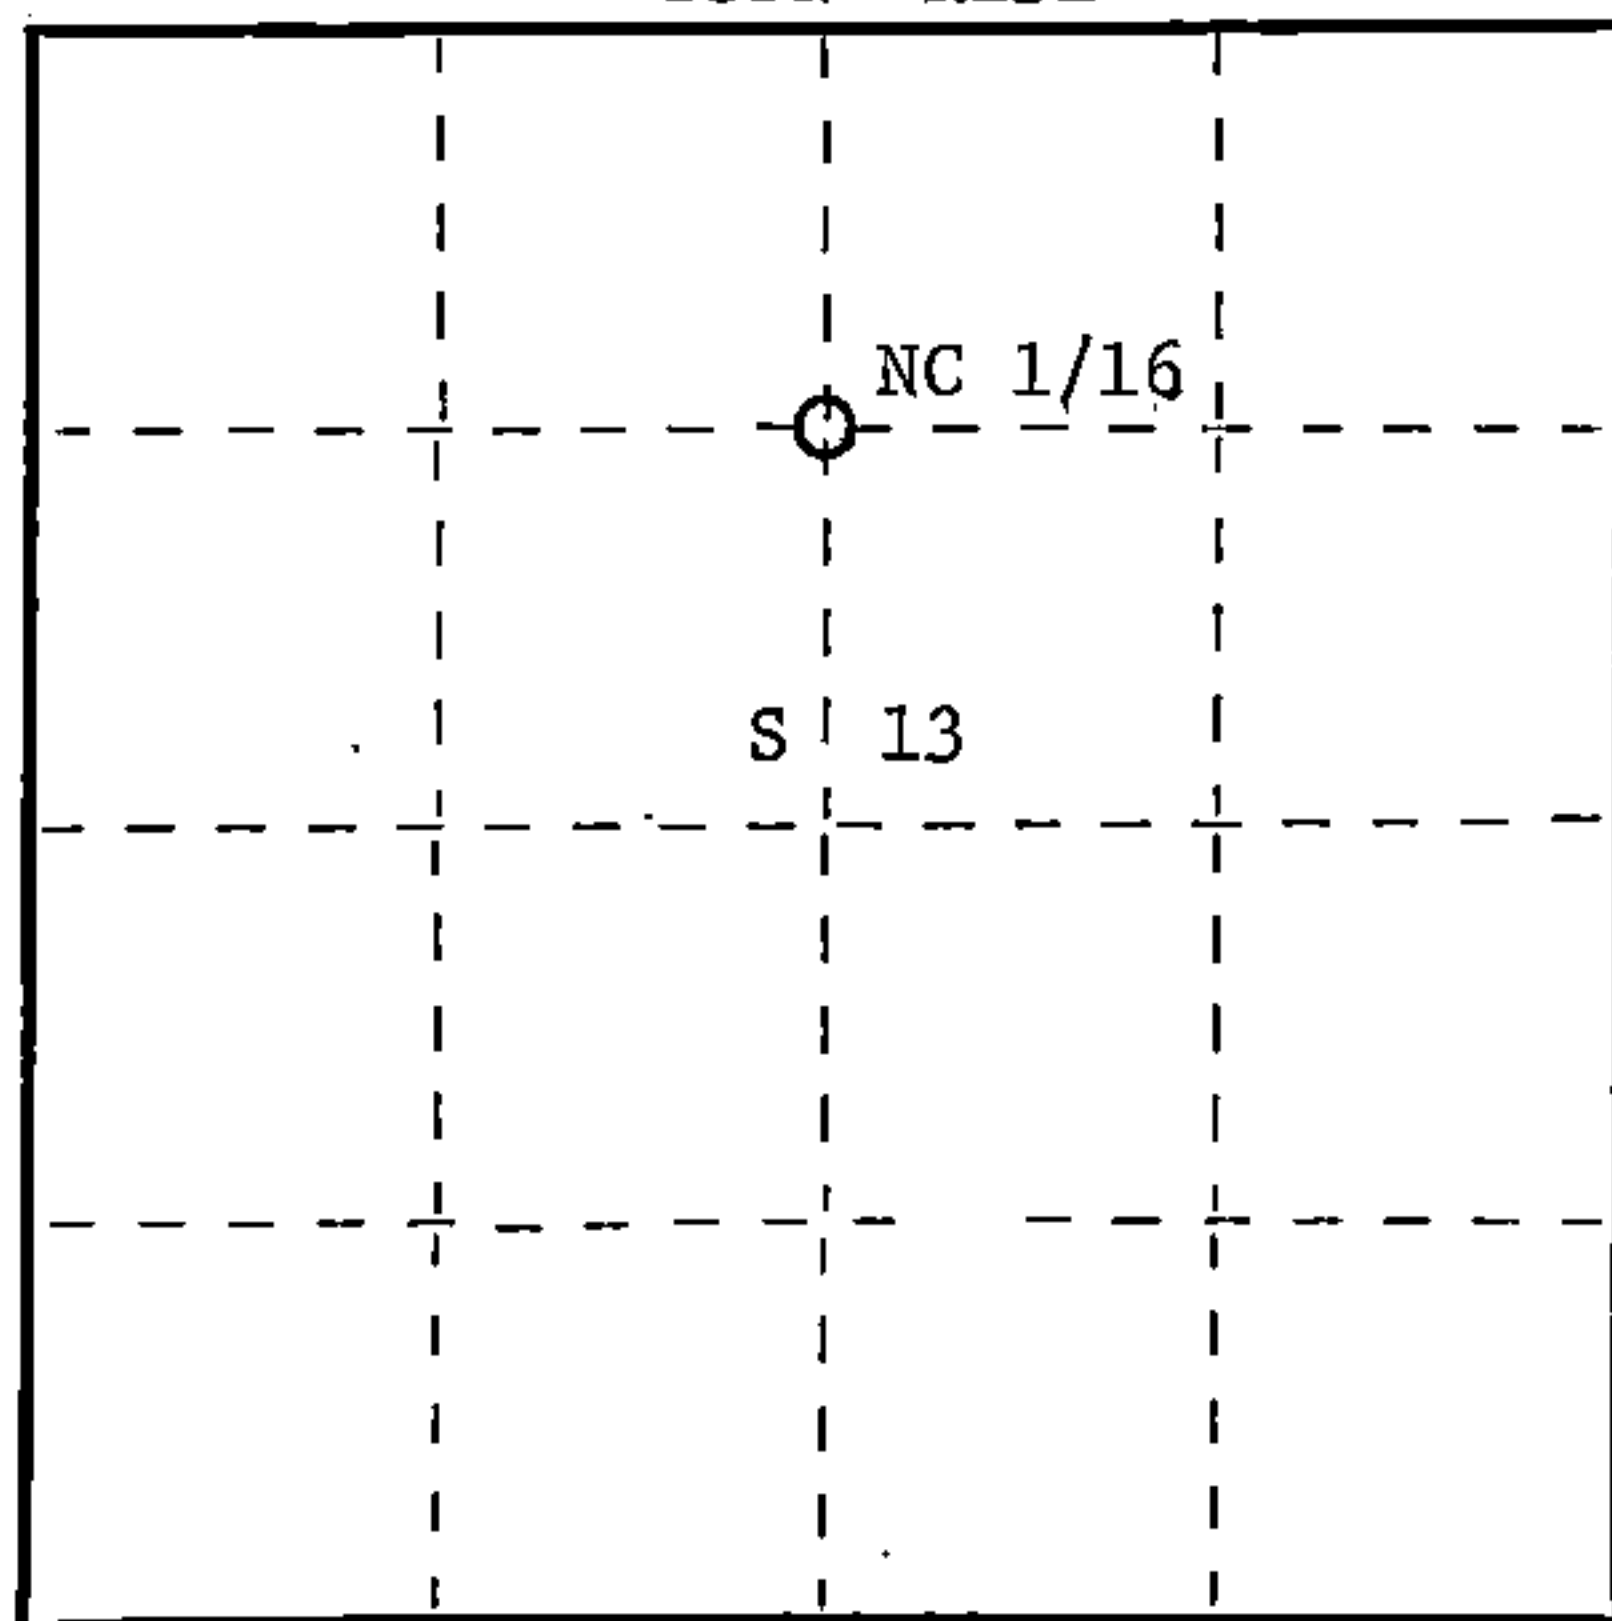

○ = Corner monument restored.

Dated at Rhineland, Wis., this 12th day of October, 1984

Signature Glen Barker Title Registered Land Surveyor Registration No. 1682
(County Surveyor, Registered Land Surveyor, or other duly authorized official)

Office of Register of Deeds, County of Forest, I hereby certify that the within instrument was filed in this office for record on the 20th day of December, 1984 at 1:15 o'clock P. M.

Eugene Staszny
(Register of Deeds) Document Number **126951**

By _____ Deputy

43513133020