

State of Wisconsin

County of FOREST

ss. RESTORATION OF LOST ORIGINAL GOVERNMENT SURVEY CORNER.

I NEAL SPERHAKE, do hereby certify that on the TWENTY-NINTH day of JULY, 1964, I established the EAST QUARTER SECTION CORNER OF SECTION 14, TOWNSHIP 35 NORTH, RANGE 13 EAST, Fourth Principal Meridian, as described hereon.

History: This corner was established during the original survey of this township, as noted in the original field notes for the original survey of T35N-R13E, 4th. p.m.

Description of monument and accessories I established to perpetuate the location of this corner:


At the point determined for the location of the corner I emplaced a:

GALVANIZED IRON PIPE, THREE FEET LONG, ONE INCH IN DIAMETER, WITH ALUMINUM CAP DENOTED AS, "KIMBERLY CLARK CORP. T35N 1/4 BTWN. 14 & 13 R13E SPERHAKE RLS 463 7/29/64."

The pipe is witnessed by:

- Poplar 11 S 88°W 60 links. (SCRIBED 1/4 S 14 NBT).
- Maple 9 N 52°E 29 links. (SCRIBED 1/4 S 13 NBT).


Description as to how corner was located: No evidence of the original corner was present. Thus, set by proportionate measurement. Since both the section corners 1/2 mile north and south, respectively, have been previously established with a distance of 80.05 chains between them, the quarter corner was set 40.02 1/2 chains from either corner and on a straight line between them.

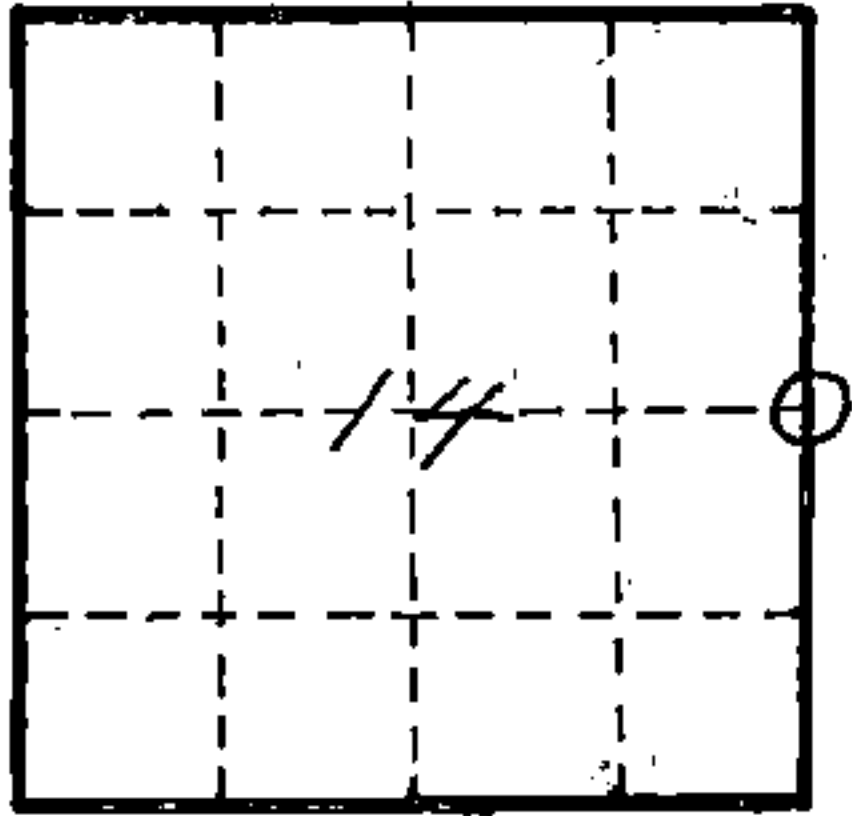

0 = Corner monument restored

89593

NOTARY PUBLIC OFFICE
FOREST COUNTY, WIS.

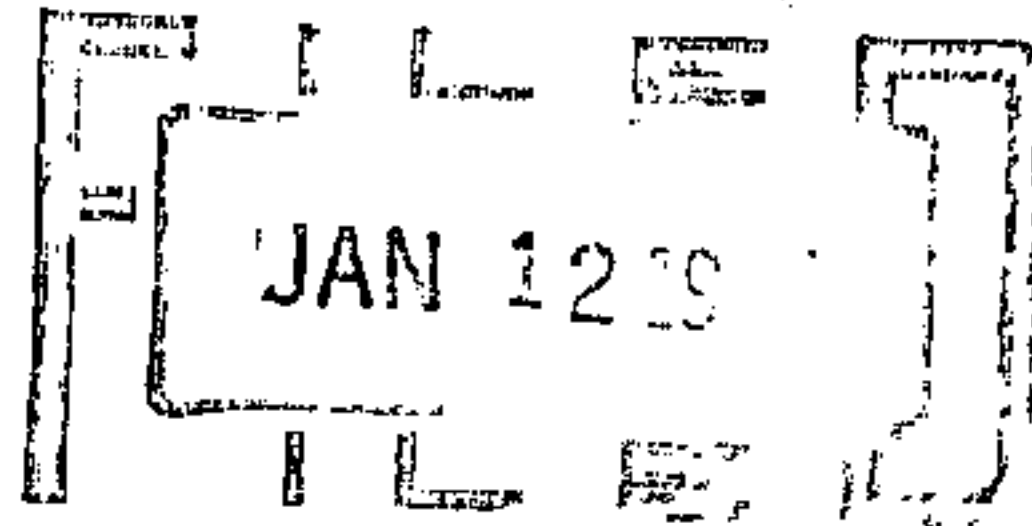

Anna Peterson Registrar

Resident witnesses _____

Dated at Crandon, Wisconsin, this 12th day of January, 19 65.

Signature *Neal Sperhake*

Title Registered Land Surveyor Registration No. 463

~~Office of~~ Forest County ~~of~~ Wisconsin, I hereby certify that the within instrument was ~~filed in the~~ ~~office of records~~ on the 12th day of January 19 65, and was ~~filed in the~~ ~~Book No.~~ signed and ~~Page No.~~ sworn to ~~of County Records.~~ before me.

Surveyor's Seal

Signature *Anna Peterson* Title Notary Public

4351314 2000

Index No. 621