

State of Wisconsin
County of FOREST

ss. ESTABLISHMENT OF QUARTER - QUARTER SECTION CORNER BETWEEN ORIGINAL GOVERNMENT SURVEY CORNERS.

I NEAL SPERHAKE, do hereby certify that on the TWENTY-NINTH day of JULY, 19 64, I established the NORTH ONE SIXTEENTH CORNER BETWEEN SECTIONS 14 AND 13, TOWNSHIP 35, NORTH, RANGE 13 EAST, Fourth Principal Meridian, as described hereon.

History: There is no record of this corner having ever been previously established.

Description of monument and accessories I established to perpetuate the location of this corner:


At the point determined for the location of the corner I emplaced a:

GALVANIZED IRON PIPE, THREE FEET LONG, ONE INCH IN DIAMETER, WITH ALUMINUM CAP DENOTED AS, "KIMBERLY CLARK CORP. T35N N 1/16 BTWN. 14 & 13 R13E SPERHAKE RLS 463 7/29/64."

The pipe is witnessed by:

- W. Birch 10 S 46°E 11 links. (SCRIBED S 13 BT).
- Hemlock 11 S 40°W 44 links. (SCRIBED S 14 BT).


Description as to how corner was located: Since both the section corner 1/4 mile north and the quarter corner 1/4 mile south have been previously established with a distance between them of 40.02 1/2 chains, the N 1/16 corner was set 20.01 1/4 chains from either corner and on a straight line between them.

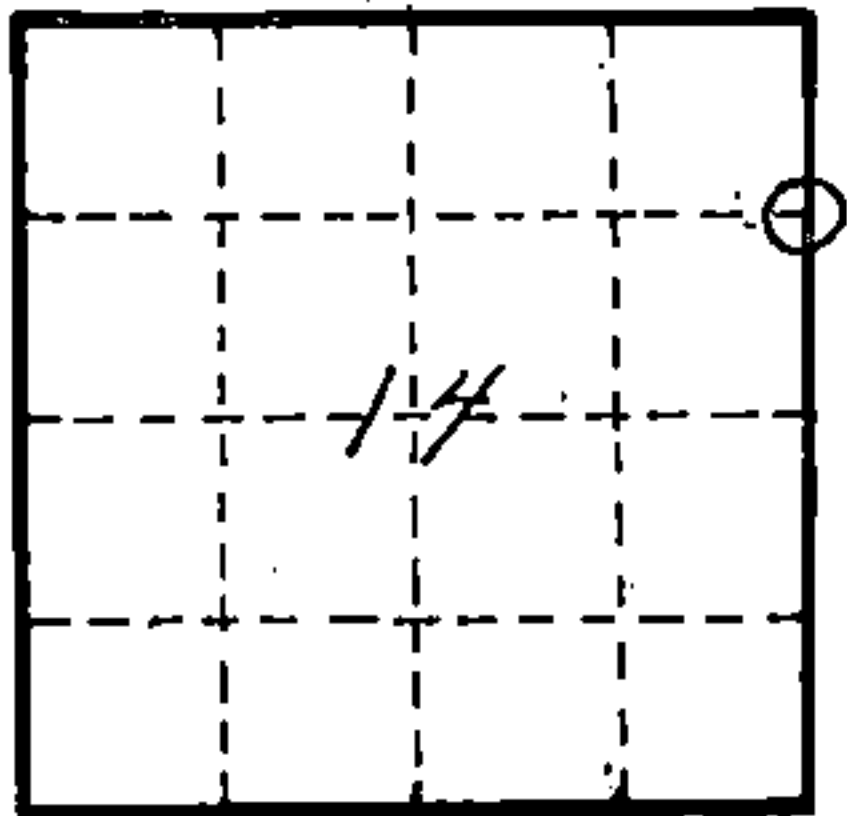

O = Corner monument restored

89590

REGISTERED OFFICE
FOREST COUNTY, WIS.

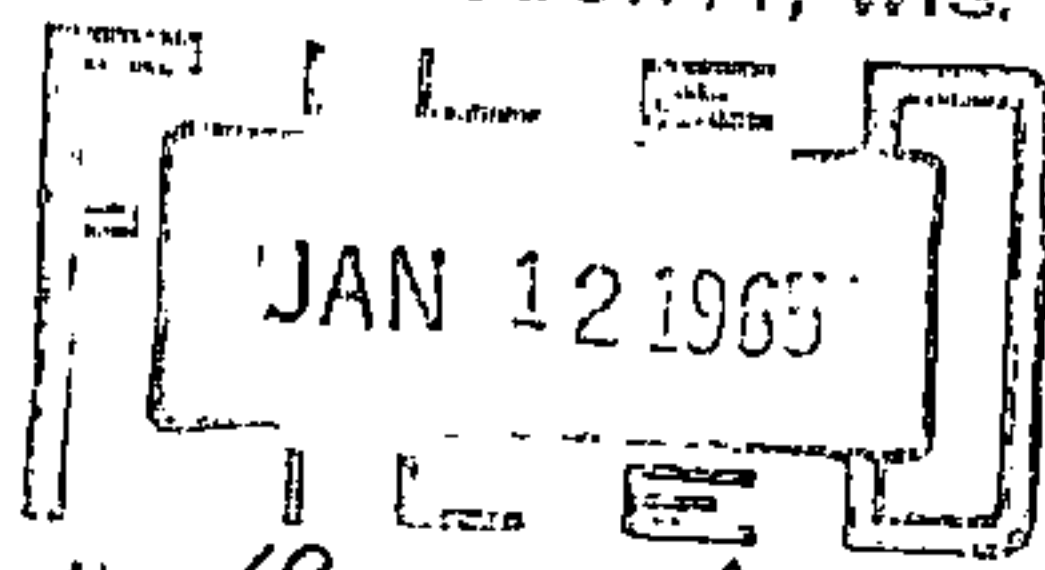

11 10 o'clock A M
Anna Peterson... Register of Deeds

Resident witnesses _____

Dated at Crandon, Wisconsin, this 12th day of January, 19 65.

Signature Neal Sperhake

Title Registered Land Surveyor Registration No. 463

~~Office of~~ Forest County ~~of~~ Wisconsin, I hereby certify that the within instrument was ~~filed in this office for record~~ on the 12th day of January 1965, and was ~~filed in Book No.~~ signed and ~~Page No.~~ sworn to ~~of County Records~~ before me.

Surveyor's Seal

Signature Anna Peterson Title Notary Public

4351314 3000

Index No.

K 21